

Kleinburg Glen - 76 - 1 - 38-6 Elev.B WYNDHAM

Inv.756	1 - MASTER ENSUITE: UPGRADE TO FREE STANDING TUB - UPG1 ONLY
Line13853	Note:
17Aug16 / 11Nov16	

GLASS AND MIRROR

Inv.756	1 - MASTER ENSUITE: CONVERT FRAMED SHOWER TO 10MM FRAMLESS SHOWER ENCLOSURE WITH DOOR AND 10MM SIDE PANEL
Line10192	Note:
17Aug16 / 11Nov16	

HVAC

Inv.756	1 - KITCHEN: GAS LINE ROUGH - FOR FUTURE COOKTOP
Line10201	Note:
17Aug16 / 11Nov16	

INTERIOR TRIM AND DOORS

Inv.756	3 - MAIN FLOOR: EXTENDED HEIGHT ARCHWAY (PRICE PER DOORWAY) - INCLUDE FRAMING NOTE
Line10204	Note: Extra arch at Den entrance
17Aug16 / 11Nov16	
Inv.756	5 - MAIN FLOOR: STANDARD DOOR EXTENDED HEIGHT 96 INCH (PRICE PER DOOR) - GROUND FLOOR 2 STOREY MODELS
Line10205	Note:
17Aug16 / 11Nov16	

MISC.

Inv.756	1 - Purchaser has attended a Structural appointment at the Decor Centre & has DECLINED any additional upgrades and accepts and acknowledges that there will be no further structural changes/additions/deletions to be made upon signing on August 17, 2016.
Line10212	Note:
17Aug16 / 11Nov16	
Inv.756	1 - Purchasers are aware & accepts that ANY changes made to upgrades after signing this Purchasers Extra Form are subject to a minimum administration fee of \$500. PLUS a 10% holdback fee.
Line10213	Note:
17Aug16 / 11Nov16	
Inv.756	1 - BONUS PACKAGE: \$7,500.00 (INCLUDING TAXES) WORTH OF UPGRADES FROM GOLD PARK HOMES DÉCOR CENTRE IS BEING APPLIED TOWARD THE STRUCTURAL APPOINTMENT. PURCHASER HAS A REMAINING AMOUNT OF \$00 (INCLUDING TAXES) TO BE USED TOWARD THE COLOUR APPOINTMENT.
Line10214	Note:
17Aug16 / 11Nov16	
Inv.756	1 - Purchaser request that all upgrades from this purchaser's extras form to be added to the purchase price. Purchaser is aware that upgrades will be processed only after the builder receives approval letter from the bank.
Line10215	Note:
17Aug16 / 11Nov16	
Inv.756	1 - BALANCE AFTER CREDIT: \$11,546.15 50% DEPOSIT BY CHEQUE: \$5,773.08 50% BALANCE ON CLOSING: \$5,773.08
Line10216	Note:
17Aug16 / 11Nov16	

PLUMBING

Kleinburg Glen - 76 - 1 - 38-6 Elev.B WYNDHAM


Inv.756	1 - KITCHEN: ROUGH - IN - WATERLINE FOR FRIDGE
Line10199	Note:
17Aug16 / 11Nov16	
Inv.756	1 - EXTERIOR: REAR OF HOUSE - HOSE BIB - STANDARD TO UPGRADED WITH HOT AND COLD WATER VALVE
Line10206	Note:
17Aug16 / 11Nov16	
Inv.756	1 - MASTER ENSUITE: UPGRADE TO FREE STANDING TUB - UPG1 ONLY
Line10207	Note:
17Aug16 / 11Nov16	

WINDOWS - BASEMENT


Inv.756	1 - BASEMENT WINDOWS - UPGRADE EXISTING BASEMENT WINDOW TO 53 INCH X 16 INCH - MAY REQUIRE INSTALLATION OF WINDOW WELL
Line10190	Note:
17Aug16 / 11Nov16	
Inv.756	3 - BASEMENT WINDOWS - UPGRADE EXISTING BASEMENT WINDOW TO 30 INCH X 16 INCH
Line10191	Note:
17Aug16 / 11Nov16	

Elevation A • 2,951 sq.ft.

Elevation B • 2,954 sq.ft.

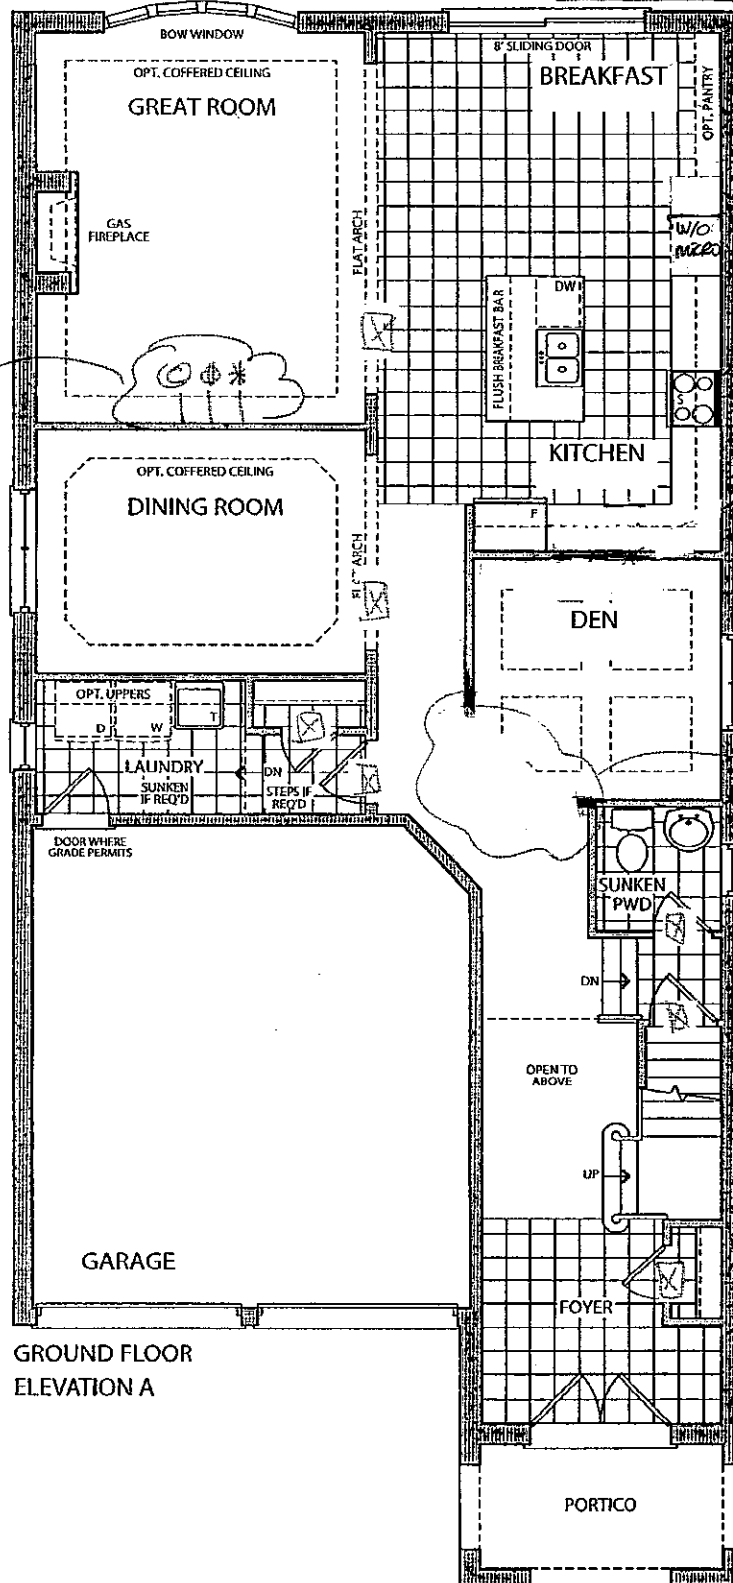

GROUND FLOOR
ELEVATION A

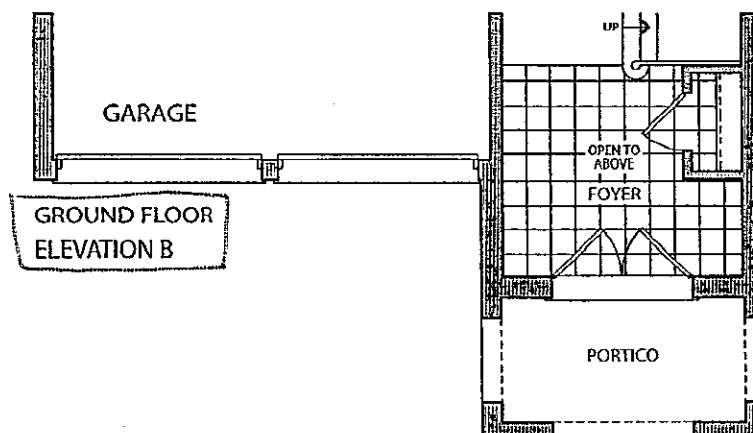

GROUND FLOOR
ELEVATION B

110V DEDICATED REC.
FOR MICROWAVE
220V DEDICATED
REC. FOR W/O.




110V DED. REC
GAS LINE

DELETE DOOR +
OPEN ENTRYWAY
TO DEN. EXTEND
ARCHWAY

LOT 76

LP


SEPT. 6. 2016

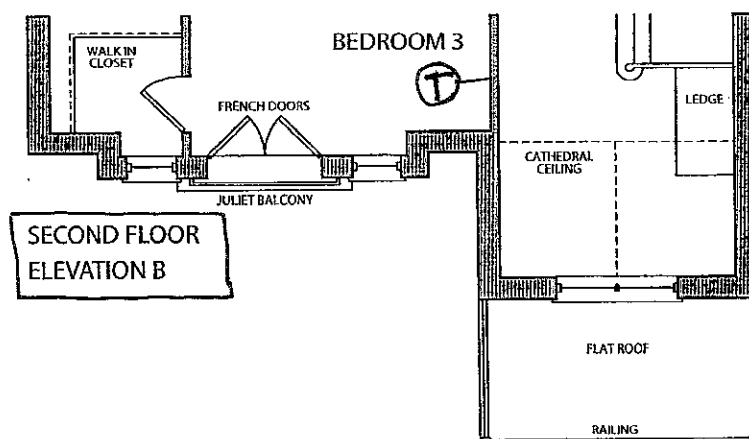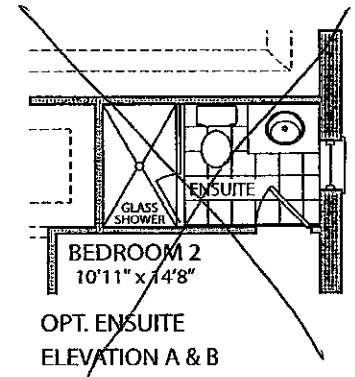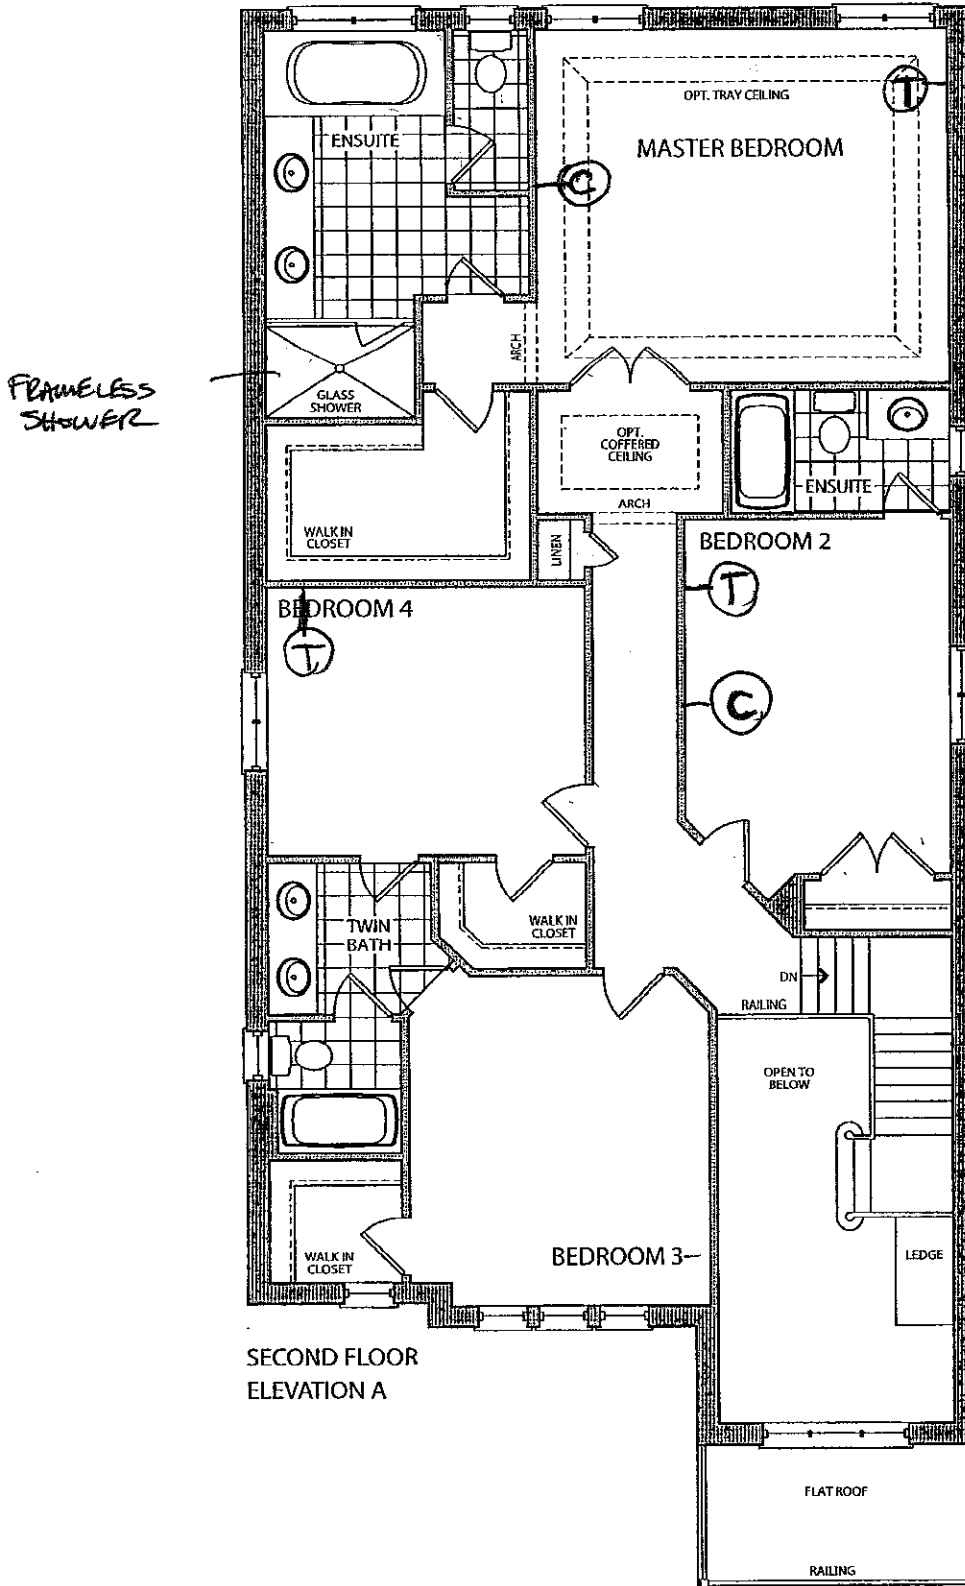

LOT 76

RR

AUG. 17. 2016

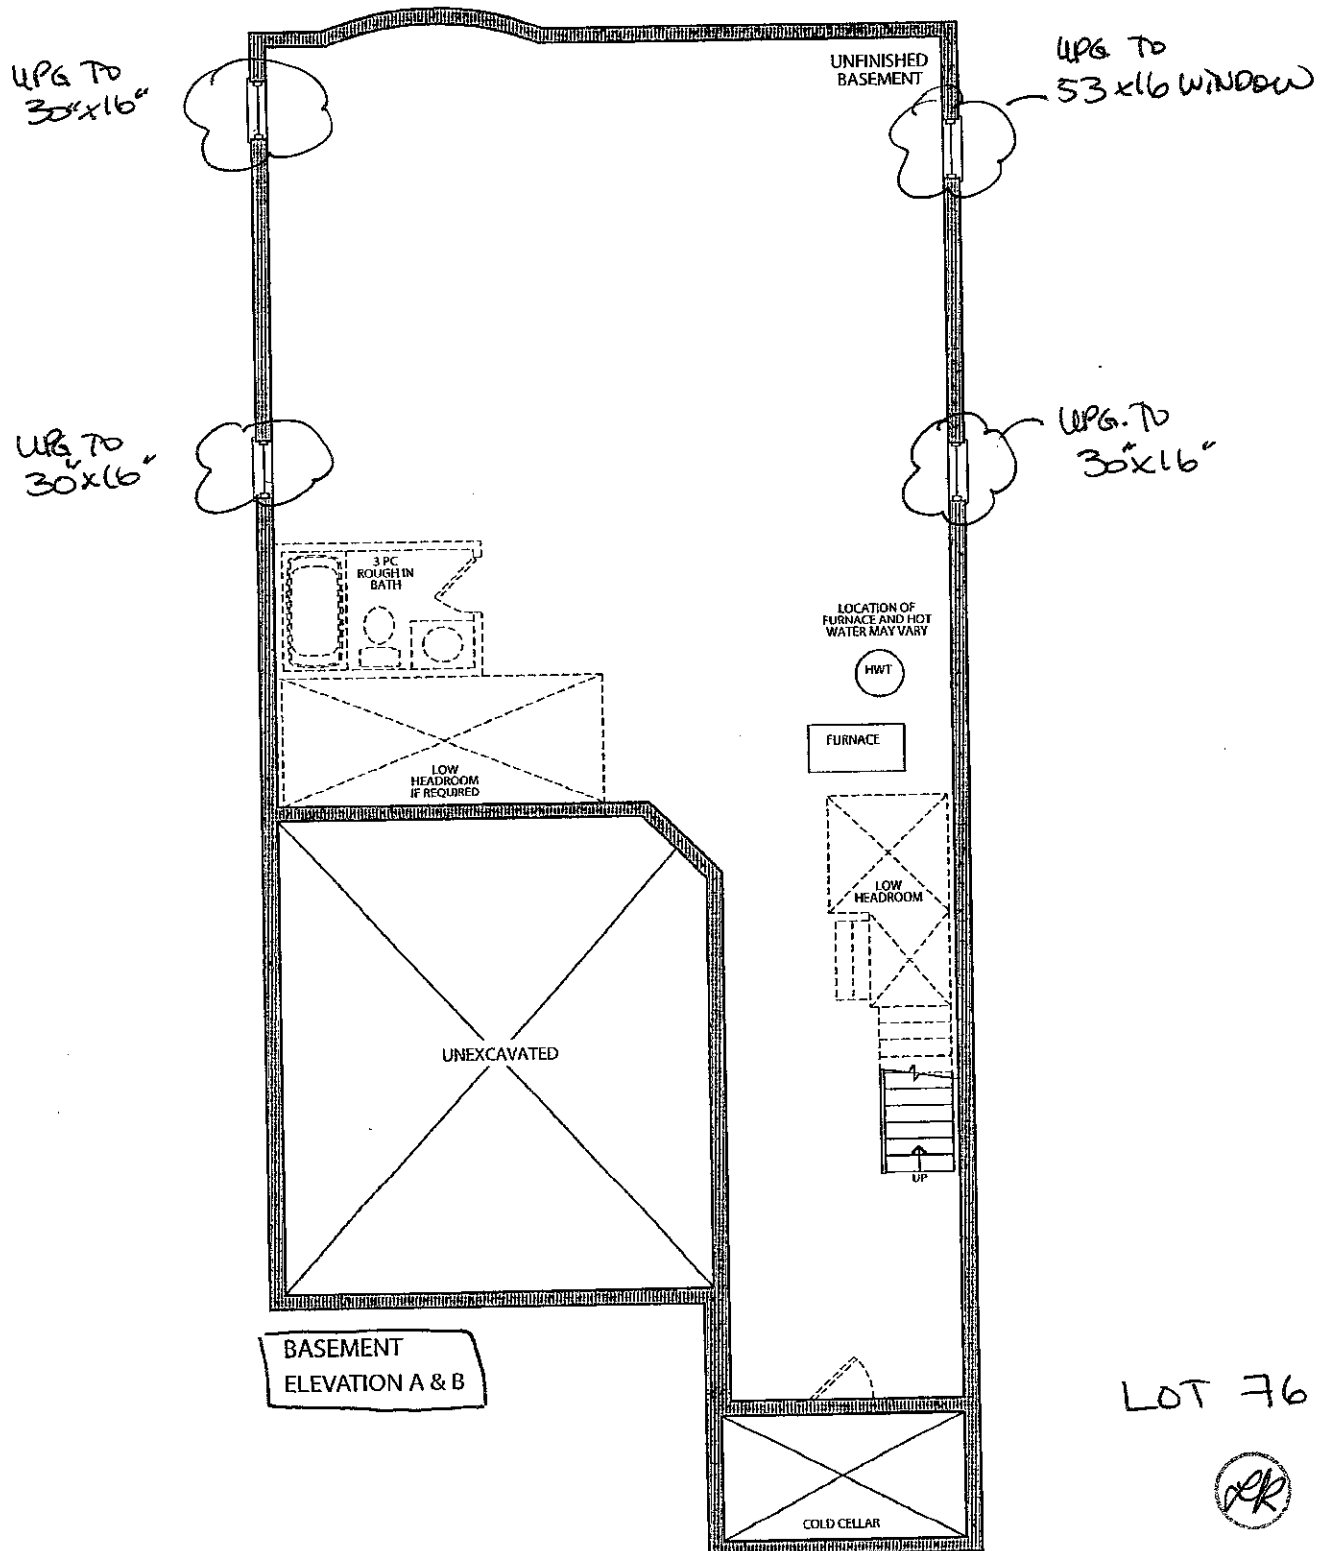

LOT 76

PK

Aug. 17, 2016



Stacey Carlete
Project Coordinator



Claude Azzopardi
Contracts Manager



Nancy Martini
Corporate Controller



38.1 The Hampton			
Elevation	Circle One	A	2339.9 Square Feet
		B	2327.8 Square Feet
Taller Ceilings	Circle All that Apply	GFTC	9' Ceilings Ground Floor
		MFTC	10' Ceilings Main Floor
		SFTC	9' Ceilings Second Floor
Optional Layouts	Circle All that Apply		

38.2 The Kingston			
Elevation	Circle One	A	2445.9 Square Feet
		B	2445.9 Square Feet
Taller Ceilings	Circle All that Apply	GFTC	9' Ceilings Ground Floor
		MFTC	10' Ceilings Main Floor
		SFTC	9' Ceilings Second Floor
Optional Layouts	Circle All that Apply	SFA1	SECOND FLOOR Shower in Lieu of Tub (Bedroom 2)

38.3 The Birkdale			
Elevation	Circle One	A	2574.1 Square Feet
		B	2575.5 Square Feet
Taller Ceilings	Circle All that Apply	GFTC	9' Ceilings Ground Floor
		MFTC	10' Ceilings Main Floor
		SFTC	9' Ceilings Second Floor
Optional Layouts	Circle All that Apply	SFA1	SECOND FLOOR Shower in Lieu of Tub (Bedroom 2)

38.4 The Bridgeport			
Elevation	Circle One	A	2723.2 Square Feet
		B	2762.0 Square Feet
Taller Ceilings	Circle All that Apply	GFTC	9' Ceilings Ground Floor
		MFTC	10' Ceilings Main Floor
		SFTC	9' Ceilings Second Floor
Optional Layouts	Circle All that Apply	SFA3	SECOND FLOOR Shower in Lieu of Tub (Twin Bath)

38.5 The Rosemont			
Elevation	Circle One	A	2804.9 Square Feet
		B	2804.5 Square Feet
Taller Ceilings	Circle All that Apply	GFTC	9' Ceilings Ground Floor
		MFTC	10' Ceilings Main Floor
		SFTC	9' Ceilings Second Floor
Optional Layouts	Circle All that Apply	SFA1	SECOND FLOOR Shower in Lieu of Tub (Bedroom 2)
		SFA3	SECOND FLOOR Shower in Lieu of Tub (Twin Bath)
		SFA5	SECOND FLOOR Additional Bedroom

38.6 The Wyndham			
Elevation	Circle One	A	2893.5 Square Feet
		B	2896.0 Square Feet
Taller Ceilings	Circle All that Apply	GFTC	9' Ceilings Ground Floor
		MFTC	10' Ceilings Main Floor
		SFTC	9' Ceilings Second Floor
Optional Layouts	Circle All that Apply	SFA1	SECOND FLOOR Shower in Lieu of Tub (Bedroom 2)
		SFA3	SECOND FLOOR Shower in Lieu of Tub (Twin Bath)
		SFA5	SECOND FLOOR Additional Bedroom

LOT 76



AUG. 17. 2016