

Kleinburg Glen - 78 - 1 - 38-4 Elev.A BRIDGEPORT
CENTRAL VAC AND WIRING

Inv.809	2 - GARAGE ENTRANCE & MASTER BEDROOM: ROUGH - IN FOR EXTRA SECURITY KEY PAD
Line11075	Note:
8Sep16 / 28Nov16	
Inv.809	1 - GREAT ROOM: CONDUIT PIPE - FOR TELEVISION - Locate approx. 66" A.F.F. above tv, terminating right of fireplace beside cable. See plan for location.
Line11076	Note:
8Sep16 / 28Nov16	

DRYWALL

Inv.809	1 - 2ND FLOOR: SMOOTH CEILINGS - (2 - Story Design) 2ND FLOOR
Line11099	Note:
8Sep16 / 28Nov16	

ELECTRICAL

Inv.809	1 - GREAT ROOM: 110V WALL RECEPTACLE ON NORMAL CIRCUIT - Locate approx. 66" A.F.F. for future tv. See plan for location.
Line11077	Note:
8Sep16 / 28Nov16	
Inv.809	1 - KITCHEN: ROUGH - IN CEILING OUTLET ON SAME SWITCH - DOES NOT INCLUDE FIXTURE - Locate above island, use same switch as standard light. See plan for location.
Line11079	Note:
8Sep16 / 28Nov16	
Inv.809	1 - KITCHEN: RELOCATE STANDARD FIXTURE - Move to above island. See plan for location.
Line11078	Note:
8Sep16 / 28Nov16	
Inv.809	1 - KITCHEN: 110V WALL RECEPTACLE ON DEDICATED CIRCUIT - FOR MICROWAVE - MICROWAVE NOT INCLUDED. See plan for location (built-in above wall oven)
Line11080	Note:
8Sep16 / 28Nov16	
Inv.809	1 - KITCHEN: 220V WALL RECEPTICAL ON DEDICATED CIRCUIT - FOR 4 WIRE BUILT - IN WALL OVEN - See plan for location.
Line11081	Note:
8Sep16 / 28Nov16	
Inv.809	1 - KITCHEN CABINET STRIP VALANCE LIGHTS (UNDER CABINETS) - ROUGH - IN - DOES NOT INCLUDE (AND REQUIRES) KITCHEN UPGRADE PRICING
Line11092	Note:
8Sep16 / 28Nov16	
Inv.809	2 - KITCHEN CABINET INTERIOR CABINET LIGHT - EACH PUCK LIGHT - DOES NOT INCLUDE (AND REQUIRES) KITCHEN UPGRADE PRICING - Switched with valance lights
Line11093	Note:
8Sep16 / 28Nov16	
Inv.809	2 - MASTER ENSUITE: ROUGH - IN WALL OUTLET ON SAME SWITCH - DOES NOT INCLUDE FIXTURE - In addition to builder's standard vanity light, add 2 additional lights - 1 on either end of vanity. See plan for location.
Line11097	Note:
8Sep16 / 28Nov16	
Inv.809	1 - EXTERIOR REAR: ADDITIONAL EXTERIOR COACH LIGHT ON SAME SWITCH (BUILDER STANDARD FIXTURE) - In additon to builders standard coach light, add 1 on opposite side of sliding door.
Line11098	Note:
8Sep16 / 28Nov16	

Kleinburg Glen - 78 - 1 - 38-4 Elev.A BRIDGEPORT

EXTERIOR COLOURS

Inv.809	1 - EXTERIOR COLOUR PACKAGE 10
Line14712	Note:
8Sep16 / 28Nov16	

FRAMING

Inv.809	1 - KITCHEN: *REDUCE* KITCHEN BULK - HEAD - MUST BE APPROVED BY H.O. TO ALLOW FOR CROWN AND FURRING PANEL CABINETRY TO CEILING.
Line11094	Note:
8Sep16 / 28Nov16	

Inv.809	5 - MAIN FLOOR & 2ND FLOOR: FRAME MAIN & 2ND FLOOR ARCHES AT 96 INCH -
Line11101	Note:
8Sep16 / 28Nov16	

Inv.809	1 - MASTER ENSUITE: UPGRADE TO FREE STANDING TUB - UPG1 ONLY
Line14713	Note:
8Sep16 / 28Nov16	

INTERIOR TRIM AND DOORS

Inv.809	5 - MAIN & 2ND FLOOR: EXTENDED HEIGHT ARCHWAY (PRICE PER DOORWAY) - 96"
Line11103	Note:
8Sep16 / 28Nov16	

MISC.

Inv.809	1 - Purchaser has attended a Structural appointment at the Decor Centre & has DECLINED any additional upgrades and accepts and acknowledges that there will be no further structural changes/additions/deletions to be made upon signing on September 8, 2016
Line11104	Note:
8Sep16 / 28Nov16	

Inv.809	1 - Purchasers are aware & accepts that ANY changes made to upgrades after signing this Purchasers Extra Form are subject to a minimum administration fee of \$500. PLUS a 10% holdback fee.
Line11105	Note:
8Sep16 / 28Nov16	


Inv.809	1 - BONUS PACKAGE: \$7,500.00 (INCLUDING TAXES) WORTH OF UPGRADES FROM GOLD PARK HOMES DÉCOR CENTRE IS BEING APPLIED TOWARD THE STRUCTURAL APPOINTMENT. PURCHASER HAS A REMAINING AMOUNT OF \$00 (INCLUDING TAXES) TO BE USED TOWARD THE COLOUR APPOINTMENT
Line11106	Note:
8Sep16 / 28Nov16	

PLUMBING

Inv.809	1 - MASTER ENSUITE: UPGRADE TO FREE STANDING TUB - UPG1 ONLY
Line11109	Note:
8Sep16 / 28Nov16	



Elevation B • 2,817 sq.ft.

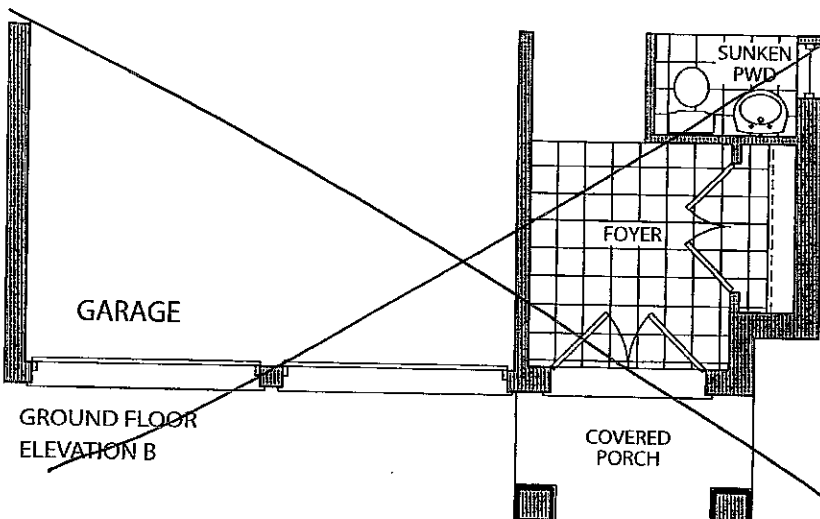

Lot 78

GOLDPARK
HOMES



the Bridgeport

✓Elevation A • 2,778 sq.ft.


~~Elevation B • 2,817 sq.ft.~~

SEPT 8 2x6
(REVISED)

LOT 78

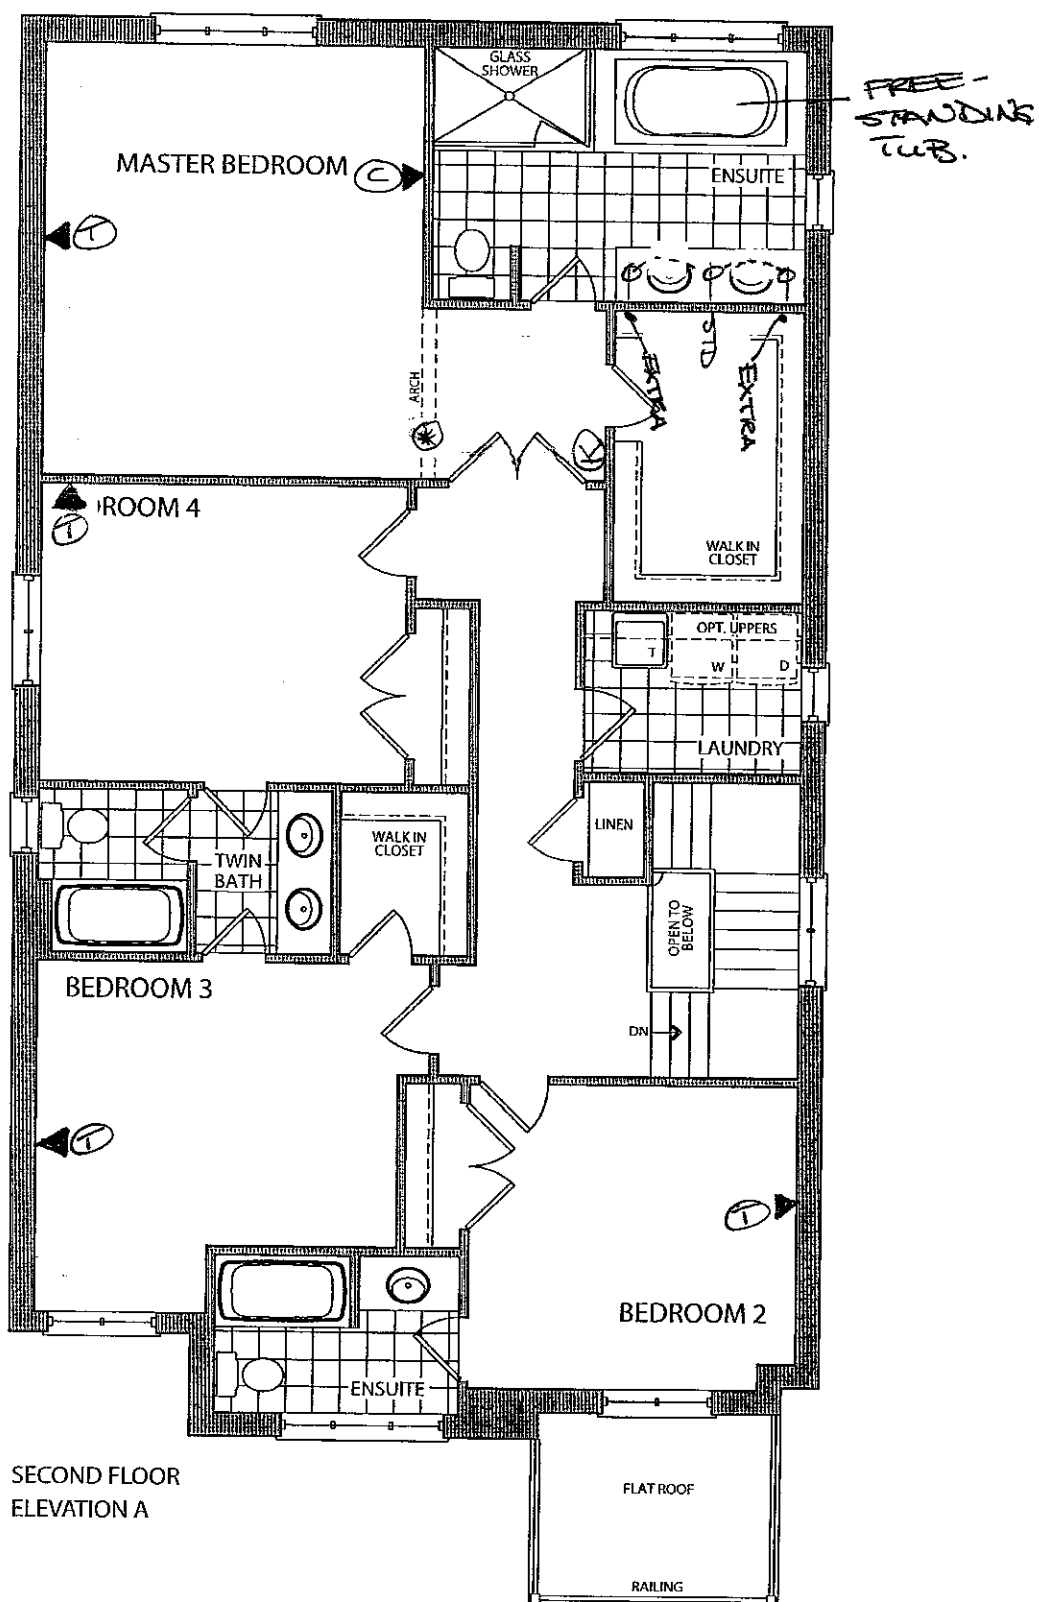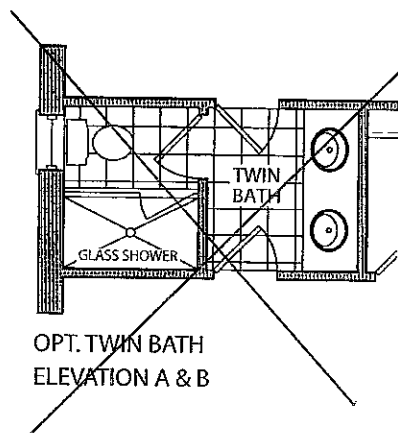




SECOND FLOOR
ELEVATION A

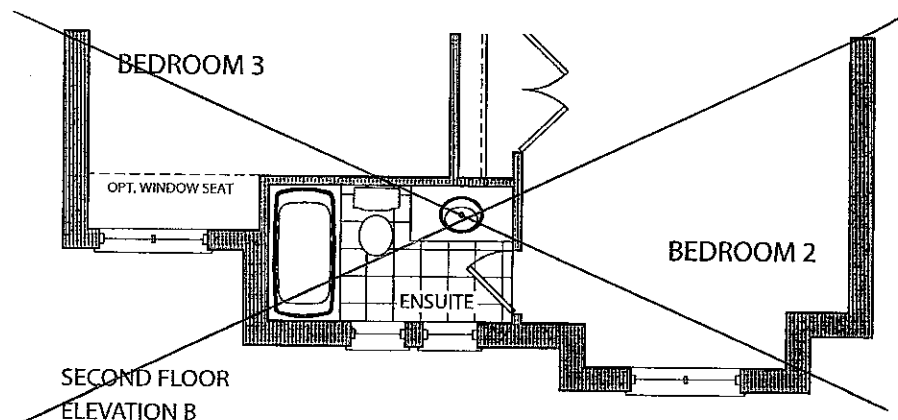



SEPT 8 2016
(REVISED)

LOT 78

CA [Signature]

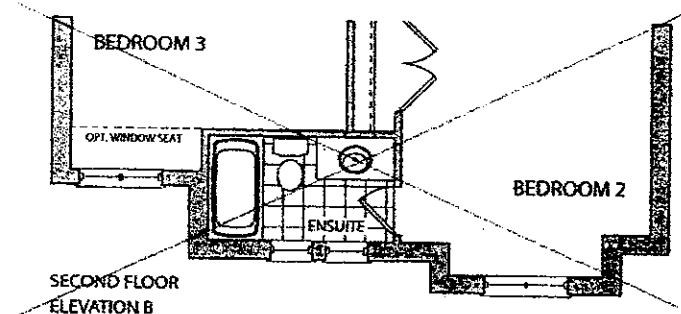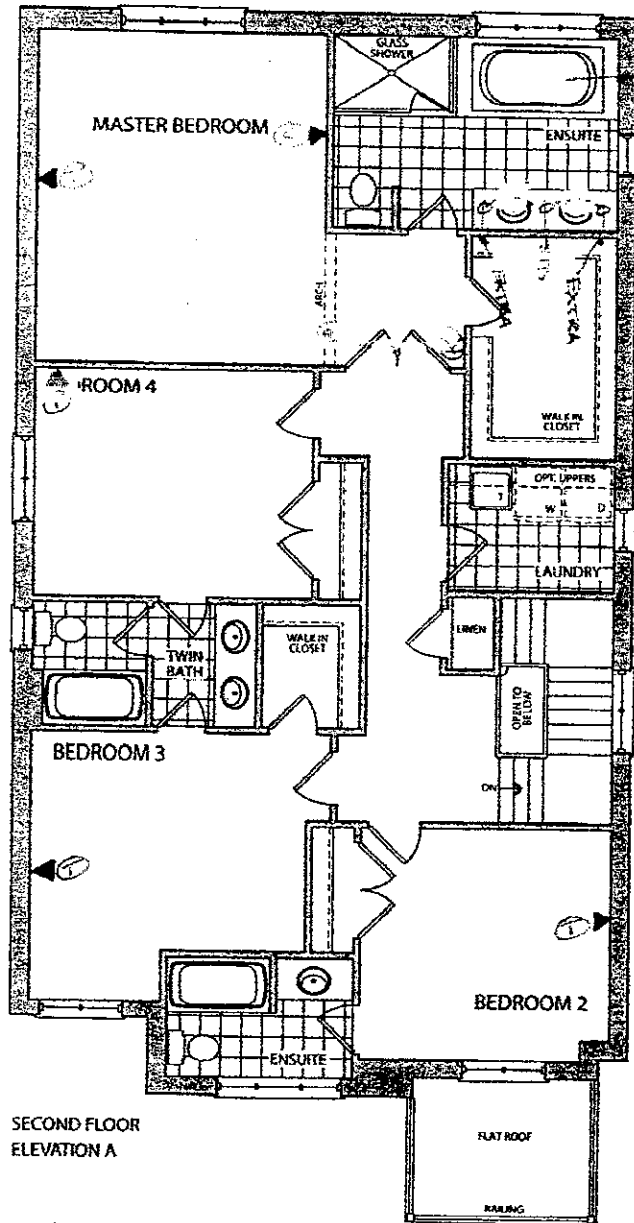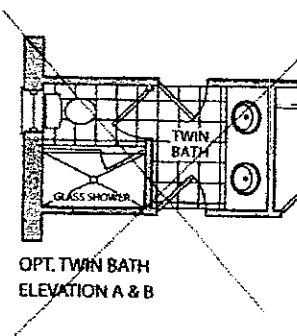

Prices, figures, illustrations, sizes, features and finishes are subject to change without notice. E & OE. Areas and dimensions are approximate and actual usable floor space may vary from the stated area. Layout may be reverse of the unit purchased. I & OE

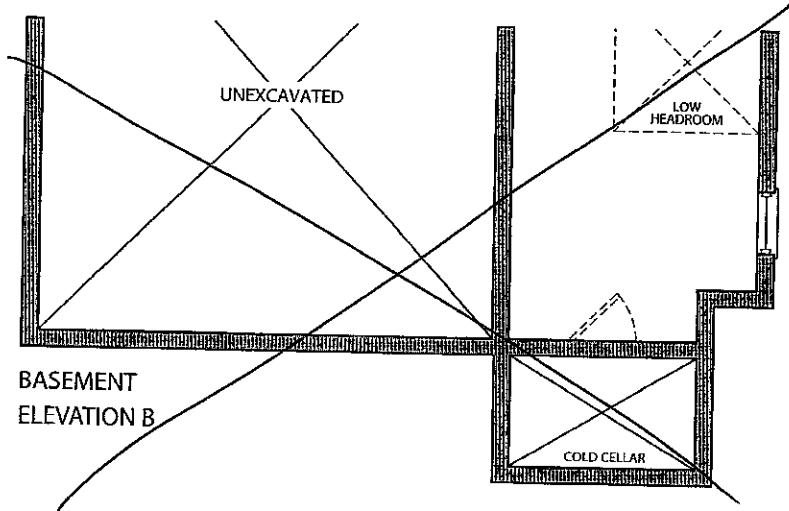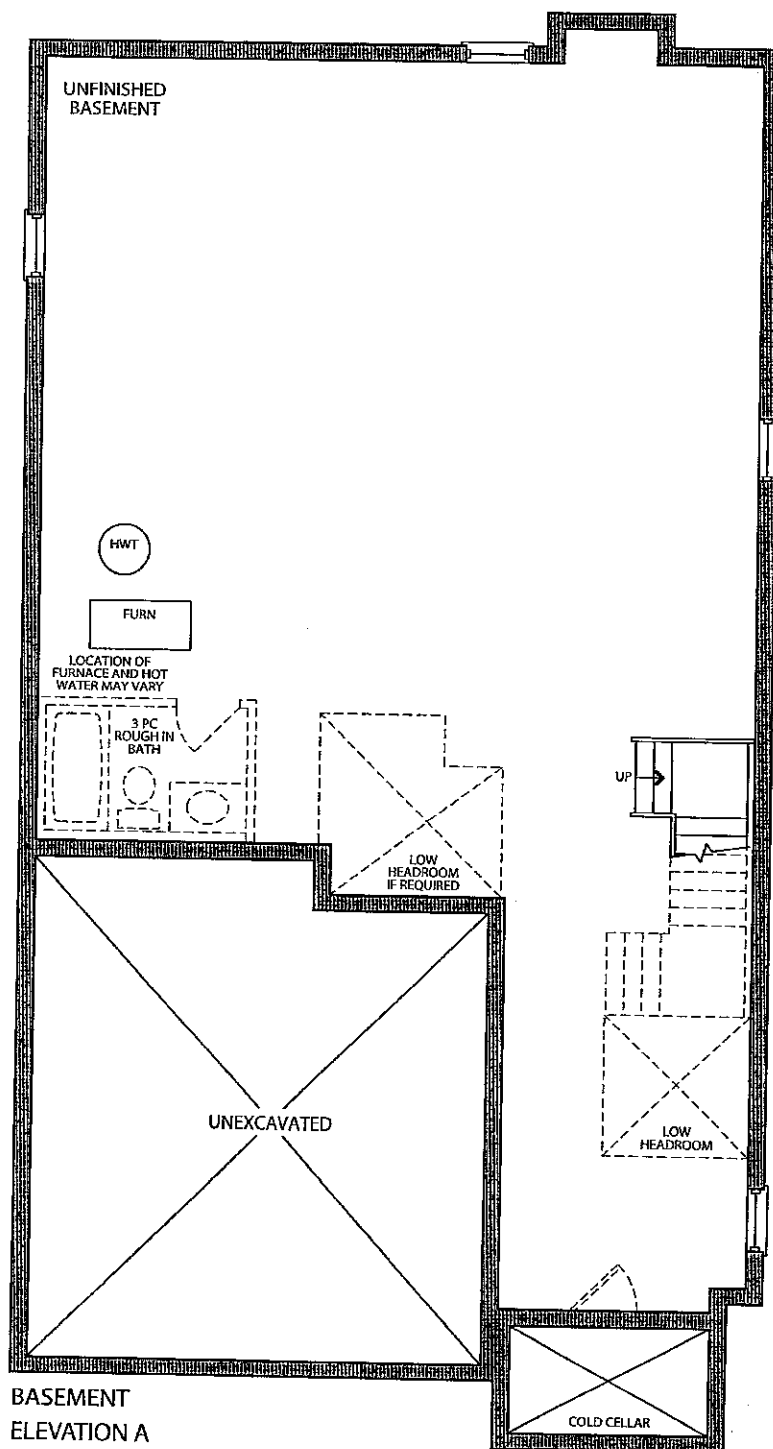


SEPT. 8 2016

LOT 78

CC

MV

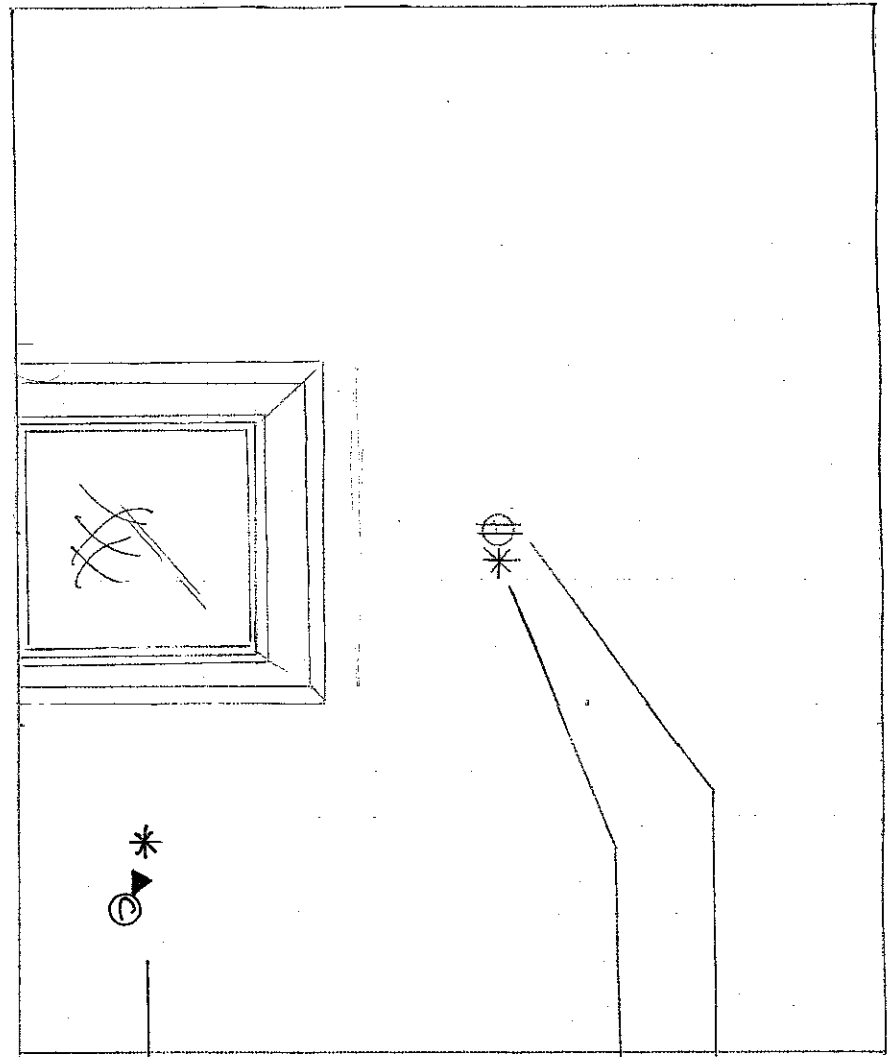

ADD ELECTRICAL (FEATURE TV).

2" CONDUIT (ABOVE FIREPLACE
to LEFT of FIREPLACE
by CABLE)

66" AFF
APPROX.

CONDUIT TERMINATED
CABLE.

LOT 78
GREAT ROOM - FIREPLACE ELIMINATED.
SEPT. 8 2016



Stacey Carlete
Project Coordinator



Claude Azzopardi
Contracts Manager



Nancy Martini
Corporate Controller



38.1 The Hampton			
Elevation	Circle One	A	2339.9 Square Feet
		B	2327.8 Square Feet
Taller Ceilings	Circle All that Apply	GFTC	9' Ceilings Ground Floor
		MFTC	10' Ceilings Main Floor
		SFTC	9' Ceilings Second Floor
Optional Layouts	Circle All that Apply		

38.2 The Kingston			
Elevation	Circle One	A	2445.9 Square Feet
		B	2445.9 Square Feet
Taller Ceilings	Circle All that Apply	GFTC	9' Ceilings Ground Floor
		MFTC	10' Ceilings Main Floor
		SFTC	9' Ceilings Second Floor
Optional Layouts	Circle All that Apply	SFA1	SECOND FLOOR Shower in Lieu of Tub (Bedroom 2)

38.3 The Birkdale			
Elevation	Circle One	A	2574.1 Square Feet
		B	2575.5 Square Feet
Taller Ceilings	Circle All that Apply	GFTC	9' Ceilings Ground Floor
		MFTC	10' Ceilings Main Floor
		SFTC	9' Ceilings Second Floor
Optional Layouts	Circle All that Apply	SFA1	SECOND FLOOR Shower in Lieu of Tub (Bedroom 2)

38.4 The Bridgeport			
Elevation	Circle One	A	2723.2 Square Feet
		B	2762.0 Square Feet
Taller Ceilings	Circle All that Apply	GFTC	9' Ceilings Ground Floor
		MFTC	10' Ceilings Main Floor
		SFTC	9' Ceilings Second Floor
Optional Layouts	Circle All that Apply	SFA3	SECOND FLOOR Shower in Lieu of Tub (Twin Bath)

38.5 The Rosemont			
Elevation	Circle One	A	2804.9 Square Feet
		B	2804.5 Square Feet
Taller Ceilings	Circle All that Apply	GFTC	9' Ceilings Ground Floor
		MFTC	10' Ceilings Main Floor
		SFTC	9' Ceilings Second Floor
Optional Layouts	Circle All that Apply	SFA1	SECOND FLOOR Shower in Lieu of Tub (Bedroom 2)
		SFA3	SECOND FLOOR Shower in Lieu of Tub (Twin Bath)
		SFA5	SECOND FLOOR Additional Bedroom

38.6 The Wyndham			
Elevation	Circle One	A	2893.5 Square Feet
		B	2896.0 Square Feet
Taller Ceilings	Circle All that Apply	GFTC	9' Ceilings Ground Floor
		MFTC	10' Ceilings Main Floor
		SFTC	9' Ceilings Second Floor
Optional Layouts	Circle All that Apply	SFA1	SECOND FLOOR Shower in Lieu of Tub (Bedroom 2)
		SFA3	SECOND FLOOR Shower in Lieu of Tub (Twin Bath)
		SFA5	SECOND FLOOR Additional Bedroom

SEPT. 8 2016
LOT 78

