

Kleinburg Glen - 85R - 1 - 25-1 Elev.B RIVERSTONE

ELECTRICAL

Inv.820	1 - KITCHEN: ADD 110V WALL DEDICATED WALL RECEPTICAL OVER THE RANGE FOR FUTURE (OTR) MIRCOWAVE. PLEASE SEE FLOORPLAN FOR LOCATION
Line11406	Note:
15Sep16 / 14Nov16	
Inv.820	1 - 110V WALL RECEPTACLE ON NORMAL CIRCUIT - MUST SPECIFY LOCATION - UNDER BREAKFAST BAR BEHIND DISHWASHER
Line11667	Note:
15Sep16 / 14Nov16	

EXTERIOR COLOURS

Inv.820	1 - EXTERIOR COLOUR PACKAGE 10
Line13907	Note:
15Sep16 / 14Nov16	

FORMING

Inv.820	1 - FAMILY ROOM. *****DELETE STANDARD FIREPLACE*****
Line13905	Note: Client requested not to delete std fireplace as per email 11/21/2016 and convo with Bruno- construction ok'd change- INSTALL STD FIREPLACE
15Sep16 / 14Nov16	

FRAMING

Inv.820	1 - MAIN FLOOR: STANDARD DOOR EXTENDED HEIGHT 96 INCH (PRICE PER DOOR) - GROUND FLOOR 2 STOREY MODELS. SEE FLOORPLAN FOR LOCATION
Line13902	Note:
15Sep16 / 14Nov16	
Inv.820	1 - FAMILY ROOM. *****DELETE STANDARD FIREPLACE*****
Line13904	Note: Client requested not to delete std fireplace as per email 11/21/2016 and convo with Bruno- construction ok'd change INSTALL STD FIREPLACE
15Sep16 / 14Nov16	
Inv.820	1 - MASTER ENSUITE: EXTEND SHOWER BACK INTO WALK-IN CLOSET & MOVE TOILET BACK APPROX 2.5FT. PLEASE SEE FLOORPLAN FOR DETAILS
Line11408	Note: PRICE INCLUDED ABOVE
15Sep16 / 14Nov16	
Inv.820	1 - MAIN FLOOR: EXTEND HEIGHT OF ARCHWAYS (PRICE PER DOORWAY). PLEASE SEE FLOORPLAN FOR LOCATIONS
Line13903	Note:
15Sep16 / 14Nov16	

GLASS AND MIRROR

Inv.820	1 - MASTER ENSUITE: UPGRADE FROM FRAMED SHOWER TO FRAMELESS SHOWER. STRAIGHT "L" SHAPED GLASS IN STEAD OF NEO-ANGLED.
Line11409	Note:
15Sep16 / 14Nov16	

HVAC

Inv.820	1 - FAMILY ROOM. *****DELETE STANDARD FIREPLACE*****
Line11397	Note: No credit applied. Client requested not to delete std fireplace as per email 11/21/2016 and convo with Bruno- construction ok'd change- INSTALL STD FIREPLACE
15Sep16 / 14Nov16	

INTERIOR TRIM AND DOORS

Kleinburg Glen - 85R - 1 - 25-1 Elev.B RIVERSTONE

Inv.820	5 - MAIN FLOOR: STANDARD DOOR EXTENDED HEIGHT 96 INCH (PRICE PER DOOR) - GROUND FLOOR 2 STOREY MODELS. SEE FLOORPLAN FOR LOCATION
Line11400	Note:
15Sep16 / 14Nov16	
Inv.820	2 - MAIN FLOOR: EXTEND HEIGHT OF ARCHWAYS (PRICE PER DOORWAY). PLEASE SEE FLOORPLAN FOR LOCATIONS
Line11407	Note:
15Sep16 / 14Nov16	

MISC.


Inv.820	1 - Purchasers are aware & accepts that ANY changes made to upgrades after signing this Purchasers Extra Form are subject to a minimum administration fee of \$500. PLUS a 10% holdback fee.
Line11402	Note:
15Sep16 / 14Nov16	
Inv.820	1 - Purchaser has attended a Structural appointment at the Decor Centre & has DECLINED any additional upgrades and accepts and acknowledges that there will be no further structural changes/additions/deletions to be made upon signing on September 15, 2016.
Line11401	Note:
15Sep16 / 14Nov16	
Inv.820	1 - BONUS PACKAGE: \$5,000.00 (INCLUDING TAXES) WORTH OF UPGRADES FROM GOLD PARK HOMES DÉCOR CENTRE IS BEING APPLIED TOWARD THE STRUCTURAL APPOINTMENT. PURCHASER HAS A REMAINING AMOUNT OF \$00 (INCLUDING TAXES) TO BE USED TOWARD THE COLOUR APPOINTMENT.
Line11403	Note:
15Sep16 / 14Nov16	


PLUMBING

Inv.820	1 - MASTER ENSUITE: EXTEND SHOWER BACK INTO WALK-IN CLOSET & MOVE TOILET BACK APPROX 2.5FT. PLEASE SEE FLOORPLAN FOR DETAILS
Line11405	Note:
15Sep16 / 14Nov16	

Elevation A • 1,849 sq.ft.

Elevation B • 1,849 sq.ft.

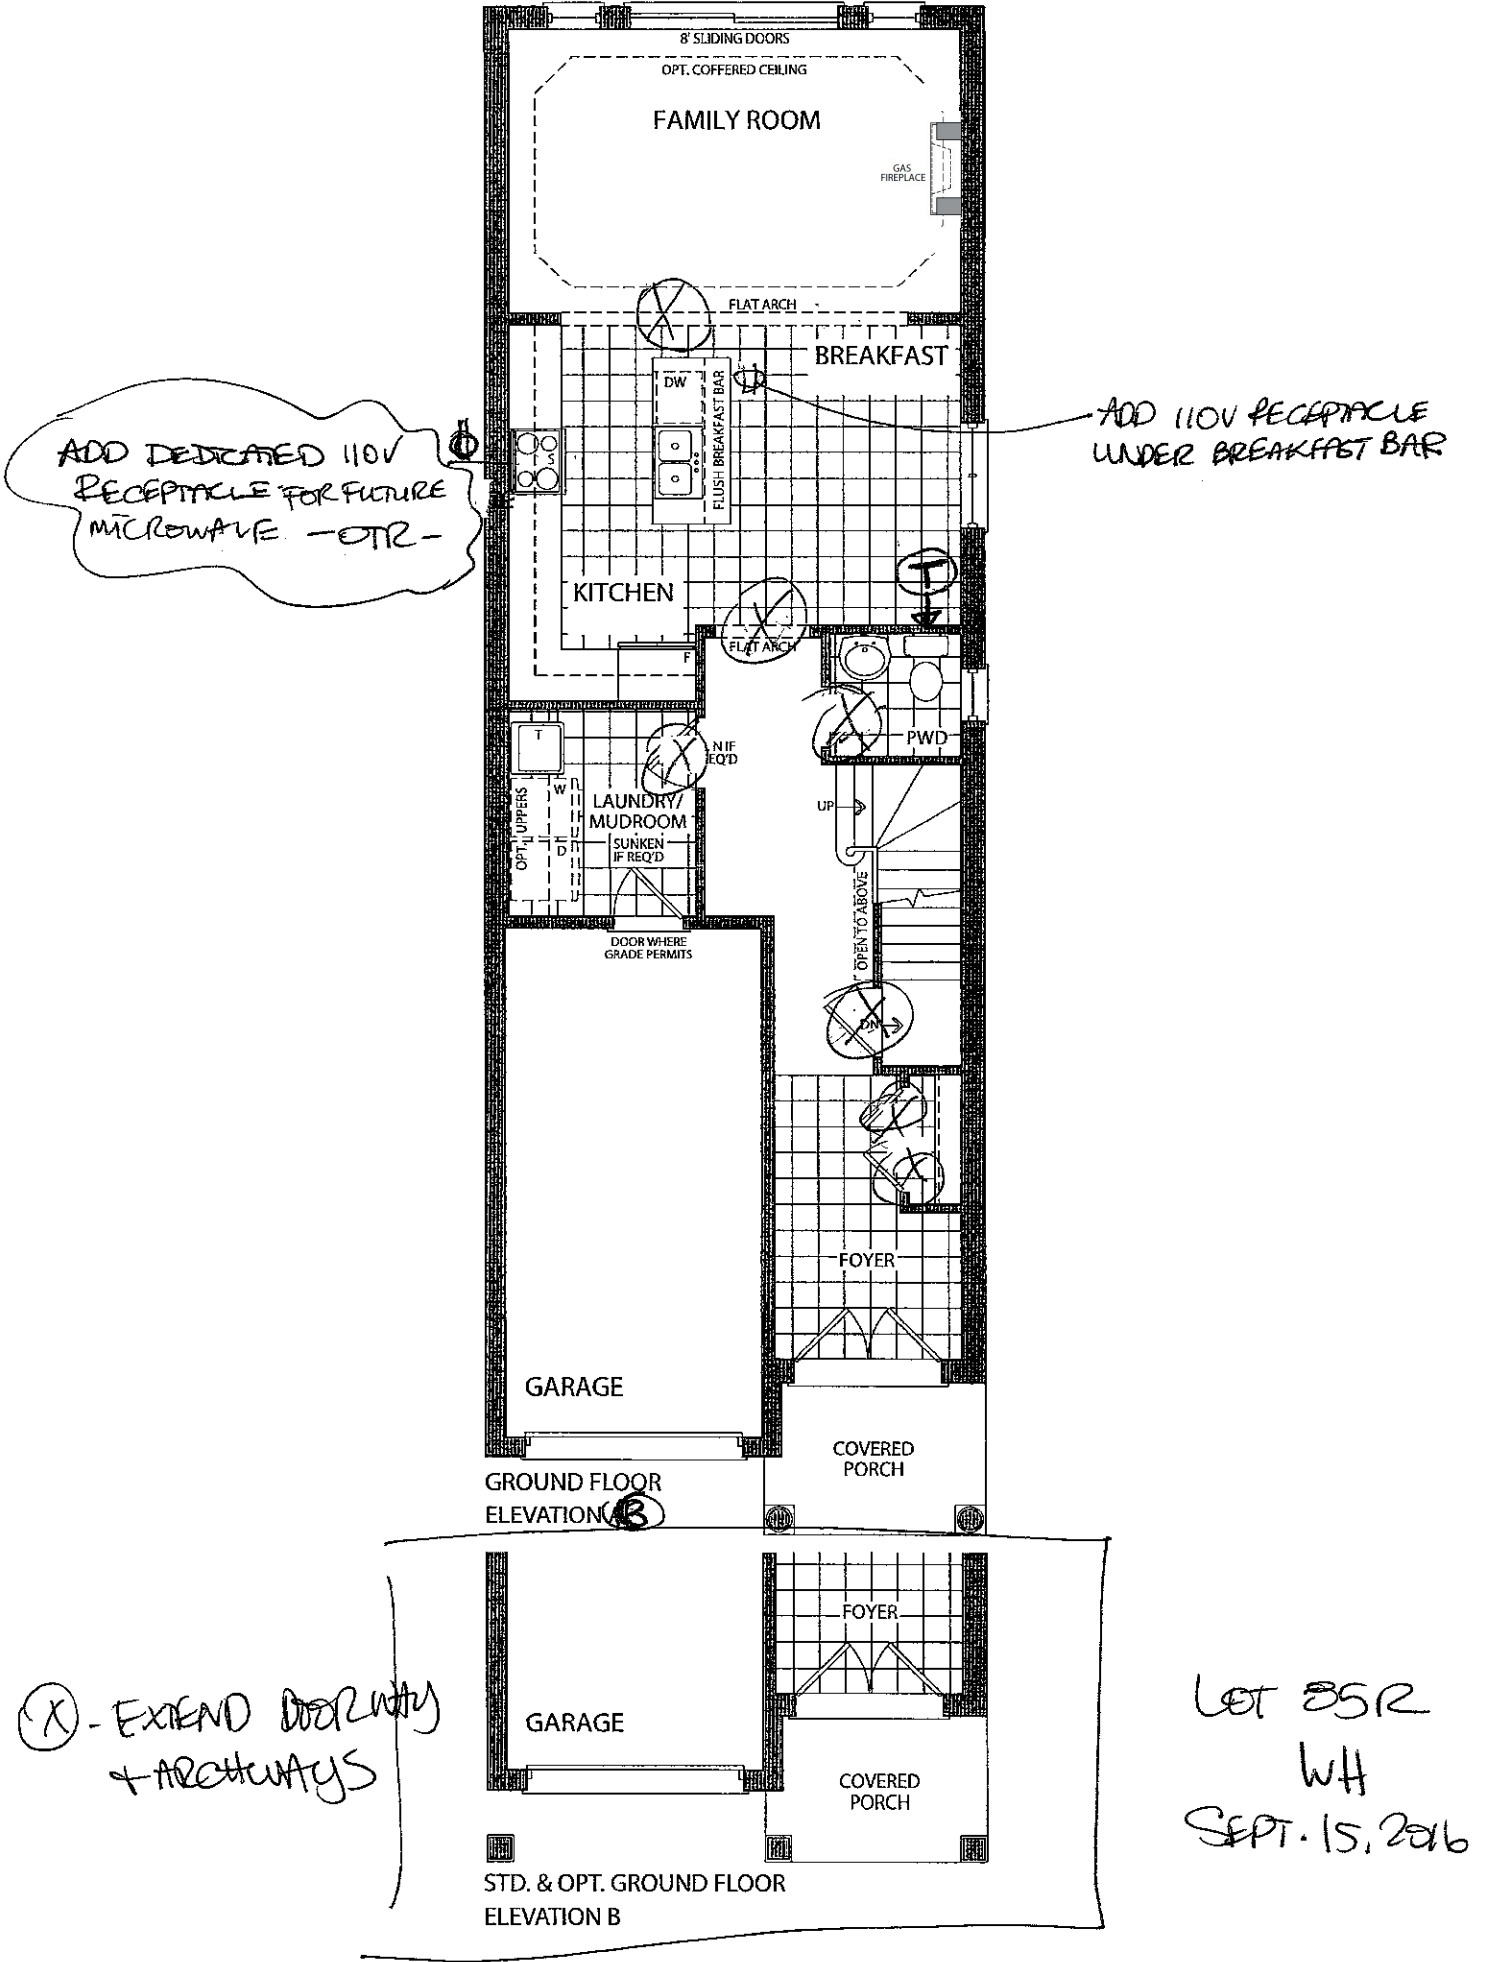


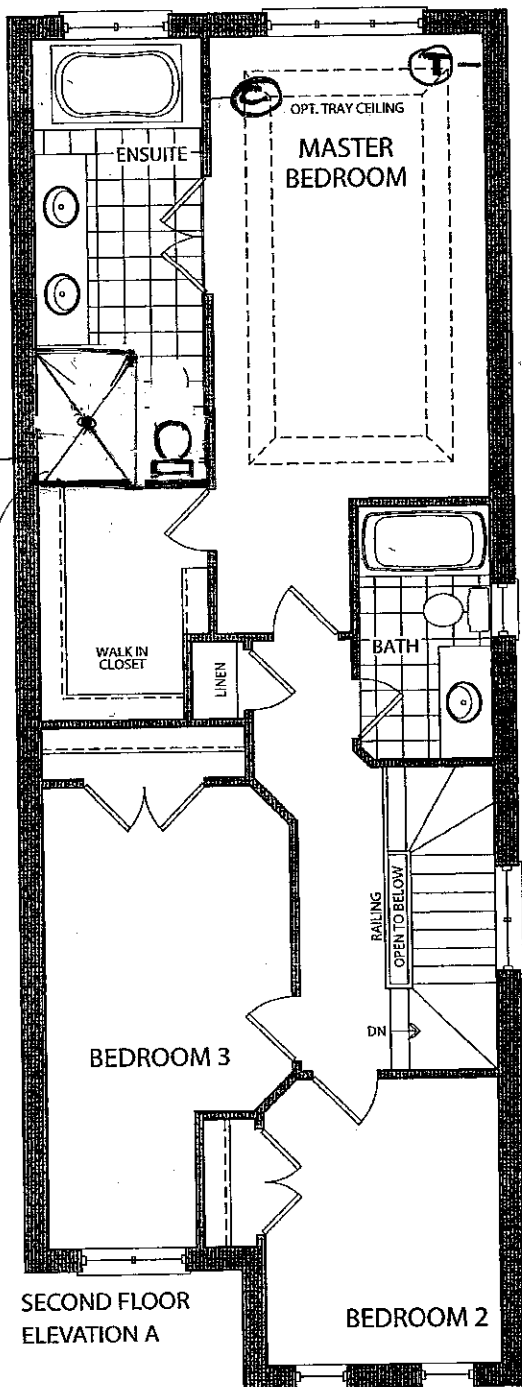

PUMPING + FRAMING.

EXTEND SHOWER
INTO W.I.C. APPROX
2.5 FT. PUSH
TOILET BACK
IN LINE

FRAMELESS
GLASS SHOWER

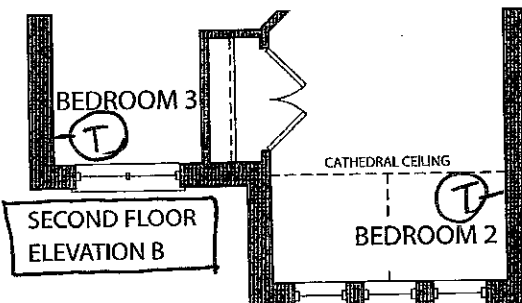



LOT 85R

W/H

SEP. 15. 2016

Elevation A • 1,849 sq.ft.

Elevation B • 1,849 sq.ft.

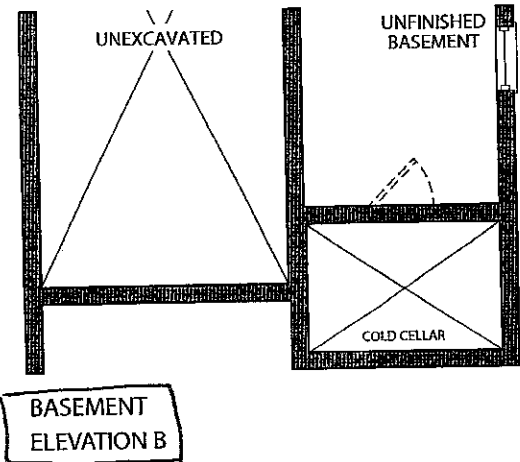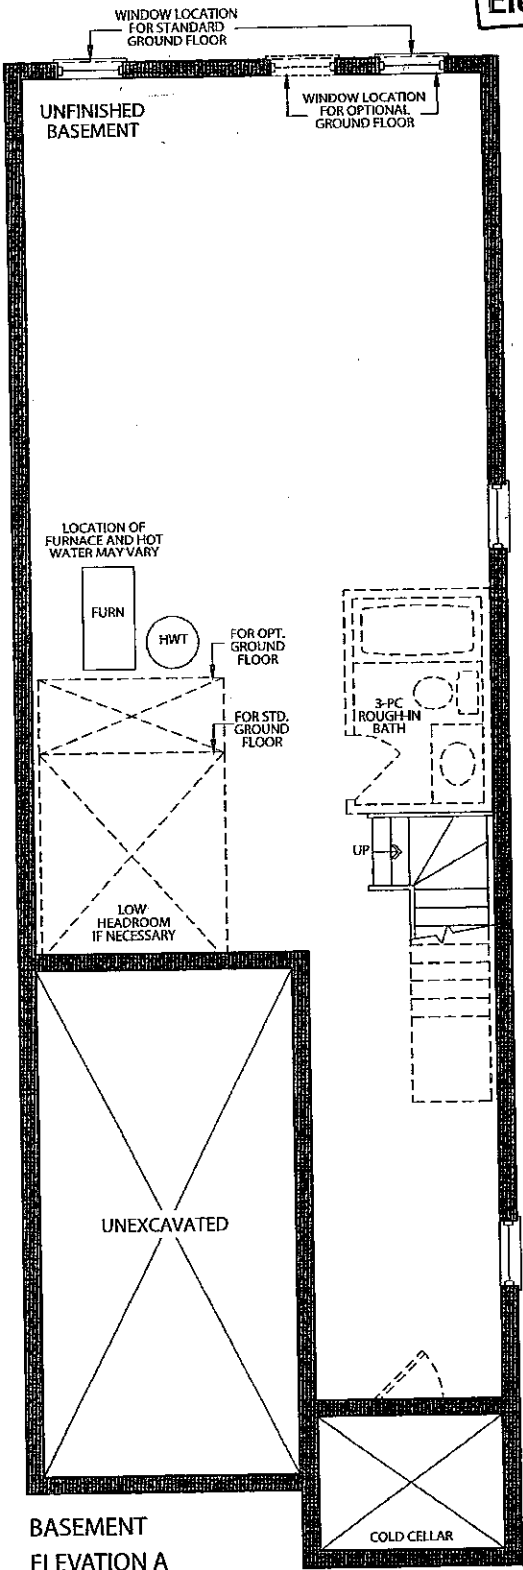

LOT 8SR

WH

SEPT 15, 2016



Stacey Carlete
Project Coordinator



Claude Azzopardi
Contracts Manager



Nancy Martini
Corporate Controller



25.1 The Riverstone			
Elevation	Circle One	A	1812.7 Square Feet
		B	1812.7 Square Feet
Taller Ceilings	Circle All that Apply	GFTC	9' Ceilings Ground Floor
		MFTC	10' Ceilings Main Floor
		SFTC	9' Ceilings Second Floor
Optional Layouts	Circle All that Apply	GFA1	GROUND FLOOR Alternative Layout Kitchen/Family Room

25.2 The Hudson			
Elevation	Circle One	A	1860.8 Square Feet
		B	1858.6 Square Feet
Taller Ceilings	Circle All that Apply	GFTC	9' Ceilings Ground Floor
		MFTC	10' Ceilings Main Floor
		SFTC	9' Ceilings Second Floor
Optional Layouts	Circle All that Apply	GFA1	GROUND FLOOR Alternative Layout Kitchen/Family Room

25.3 The Oakmount			
Elevation	Circle One	A	2013.0 Square Feet
		B	2013.0 Square Feet
Taller Ceilings	Circle All that Apply	GFTC	9' Ceilings Ground Floor
		MFTC	10' Ceilings Main Floor
		SFTC	9' Ceilings Second Floor
Optional Layouts	Circle All that Apply	GFA1	GROUND FLOOR Alternative Layout Kitchen/Family Room
		SFA4	SECOND FLOOR Alternative Layout Laundry Room
		SFA5	SECOND FLOOR Additional Bedroom

25.4 The Stanford			
Elevation	Circle One	A	2665.6 Square Feet
		B	2665.6 Square Feet
Taller Ceilings	Circle All that Apply	GFTC	9' Ceilings Ground Floor
		MFTC	10' Ceilings Main Floor
		SFTC	9' Ceilings Second Floor
Optional Layouts	Circle All that Apply	GFA2	GROUND FLOOR Optional Piece Bathroom
		MFA1	MAIN FLOOR Alternative Layout Kitchen/Family Room
		SFA2	SECOND FLOOR Shower in Lieu of Tub (Master Ens.)
		SFA5	SECOND FLOOR Additional Bedroom

25.5 The Regency			
Elevation	Circle One	A	2924.0 Square Feet
		B	2924.0 Square Feet
Taller Ceilings	Circle All that Apply	GFTC	9' Ceilings Ground Floor
		MFTC	10' Ceilings Main Floor
		SFTC	9' Ceilings Second Floor
Optional Layouts	Circle All that Apply	GFA2	GROUND FLOOR Optional Piece Bathroom
		MFA1	MAIN FLOOR Alternative Layout Kitchen/Family Room
		SFA2	SECOND FLOOR Shower in Lieu of Tub (Master Ens.)
		SFA5	SECOND FLOOR Additional Bedroom

25.6 The Lincoln			
Elevation	Circle One	A	3021.0 Square Feet
		B	3014.0 Square Feet
Taller Ceilings	Circle All that Apply	GFTC	9' Ceilings Ground Floor
		MFTC	10' Ceilings Main Floor
		SFTC	9' Ceilings Second Floor
Optional Layouts	Circle All that Apply	GFA2	GROUND FLOOR Optional Piece Bathroom
		MFA1	MAIN FLOOR Alternative Layout Kitchen/Family Room

25.7 The Carnegie			
Elevation	Circle One	A	3150.8 Square Feet
		B	3150.8 Square Feet
Taller Ceilings	Circle All that Apply	GFTC	9' Ceilings Ground Floor
		MFTC	10' Ceilings Main Floor
		SFTC	9' Ceilings Second Floor
Optional Layouts	Circle All that Apply	GFA2	GROUND FLOOR Optional Piece Bathroom
		MFA1	MAIN FLOOR Alternative Layout Kitchen/Family Room
		SFA1	SECOND FLOOR Shower in Lieu of Tub (Bedroom 2)

25.8 The Biltmore			
Elevation	Circle One	A	1980.8 Square Feet
		B	1989.3 Square Feet
Taller Ceilings	Circle All that Apply	GFTC	9' Ceilings Ground Floor
		MFTC	10' Ceilings Main Floor
		SFTC	9' Ceilings Second Floor
Optional Layouts	Circle All that Apply		

Elevation	Circle One		
Taller Ceilings	Circle All that Apply		
Optional Layouts	Circle All that Apply		

Elevation	Circle One		
Taller Ceilings	Circle All that Apply		
Optional Layouts	Circle All that Apply		

LBT 85R

WA

SEPT 15, 2016