

Kleinburg Glen - 89 - 1 - 38-5 Elev.B ROSEMONT

ELECTRICAL

Inv.597	1 - FAMILY ROOM: Install a 110V WALL RECEPTACLE ON NORMAL CIRCUIT - Locate approx. 60" A.F.F. above fireplace (NOTE: conduit NOT purchased)
Line7324	Note:
21Jun16 / 11Nov16	
Inv.597	1 - KITCHEN: Install a 110V WALL RECEPTACLE ON DEDICATED CIRCUIT - FOR MICROWAVE - MICROWAVE NOT INCLUDED. Cabinetry customization to be purchased at colour appointment. See plan for location.
Line7325	Note:
21Jun16 / 11Nov16	
Inv.597	1 - KITCHEN: Install a 220V WALL RECEPTICAL ON DEDICATED CIRCUIT - FOR 4 WIRE BUILT - IN WALL OVEN. Cabinetry customization to be purchased at colour appointment. See plan for location.
Line7327	Note:
21Jun16 / 11Nov16	
Inv.597	1 - **REQUEST** Electrical panel to be located near furnace, if possible.
Line7336	Note:
21Jun16 / 11Nov16	

EXTERIOR COLOURS

Inv.597	1 - EXTERIOR COLOUR PACKAGE 2
Line13836	Note:
21Jun16 / 11Nov16	

FORMING

Inv.597	1 - WALK-UP BASEMENT
Line7323	Note:
21Jun16 / 11Nov16	

FRAMING

Inv.597	1 - WALK-UP BASEMENT
Line13834	Note:
21Jun16 / 11Nov16	
Inv.597	1 - MANDOOR - GARAGE TO HOUSE - AS PER PLAN AND GRADE PERMITING
Line13838	Note: AS PER APS
21Jun16 / 11Nov16	

HVAC

Inv.597	1 - KITCHEN: Install a GAS LINE ROUGH - GROUND FLOOR for future gas cook top
Line7329	Note:
21Jun16 / 11Nov16	
Inv.597	1 - KITCHEN: UPGRADE VENTING FOR STOVE TO 8 INCH PIPE EXTERIOR WALL
Line7330	Note:
21Jun16 / 11Nov16	
Inv.597	1 - HUMIDIFIER: WB3 - 17 (UP TO 3,000 SQ.FT.)
Line7331	Note:
21Jun16 / 11Nov16	

MISC.

Kleinburg Glen - 89 - 1 - 38-5 Elev.B ROSEMONT

Inv.597	1 - Purchasers are aware & accepts that ANY changes made to upgrades after signing this Purchasers Extra Form are subject to a minimum administration fee of \$500. PLUS a 10% holdback fee.
Line7334	Note:
21Jun16 / 11Nov16	
Inv.597	1 - Purchaser has attended a Structural appointment at the Decor Centre & has DECLINED any additional upgrades and accepts and acknowledges that there will be no further structural changes/additions/deletions to be made upon signing on June 21, 2016.
Line7333	Note:
21Jun16 / 11Nov16	
Inv.597	1 - BONUS PACKAGE: \$7500.00 (INCLUDING TAXES) WORTH OF UPGRADES FROM GOLD PARK HOMES DÉCOR CENTRE IS BEING APPLIED TOWARD THE STRUCTURAL APPOINTMENT. PURCHASER HAS A REMAINING AMOUNT OF \$00 (INCLUDING TAXES) TO BE USED TOWARD THE COLOUR APPOINTMENT.
Line7335	Note:
21Jun16 / 11Nov16	

PLUMBING

Inv.597	1 - KITCHEN: Install a ROUGH - IN - WATERLINE FOR FRIDGE
Line7332	Note:
21Jun16 / 11Nov16	

WINDOWS AND DOORS

Inv.597	1 - WALK-UP BASEMENT
Line13835	Note:
21Jun16 / 11Nov16	
Inv.597	1 - MAN DOOR GARAGE TO HOUSE - OPTIONAL - IF GRADE PERMITS
Line13837	Note: AS PER APS
21Jun16 / 11Nov16	

Elevation A • 2,861 sq.ft.


Elevation B • 2,861 sq.ft.

LOT 89
JUNE 21 2016


Aut (i.a)

8" DUCT
+ GAS LINE

MICRO
Wall oven.


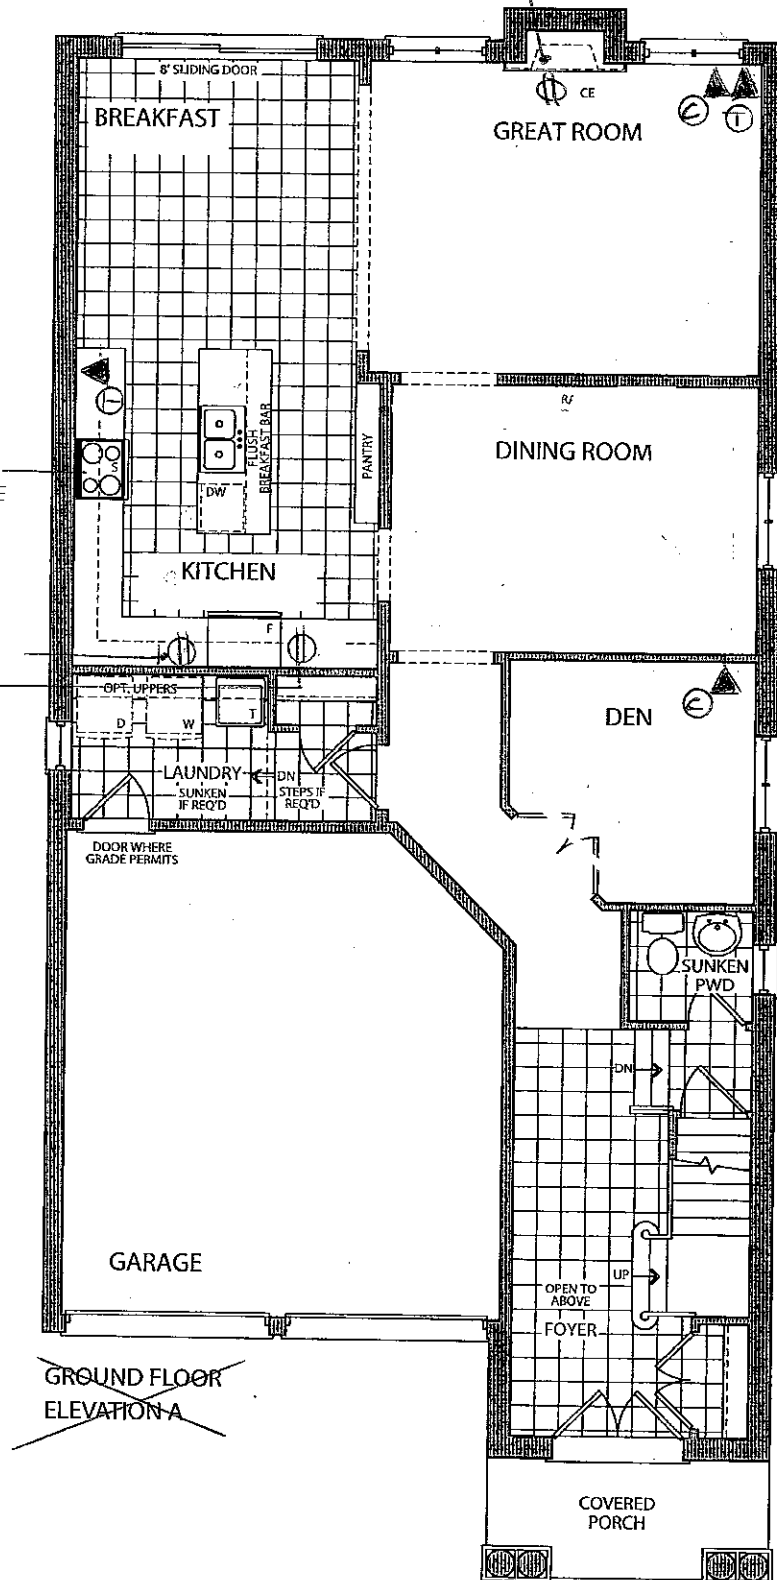


~~GROUND FLOOR
ELEVATION A~~

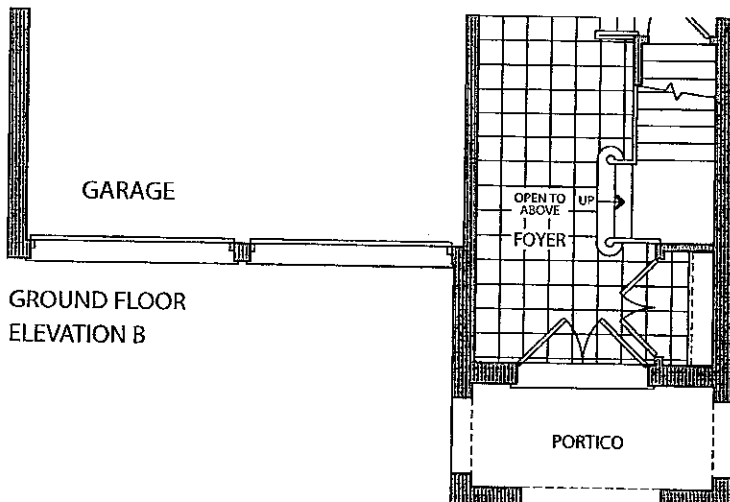



* GROUND FLOOR
ELEVATION B

Elevation A • 2,861 sq.ft.
Elevation B • 2,861 sq.ft.

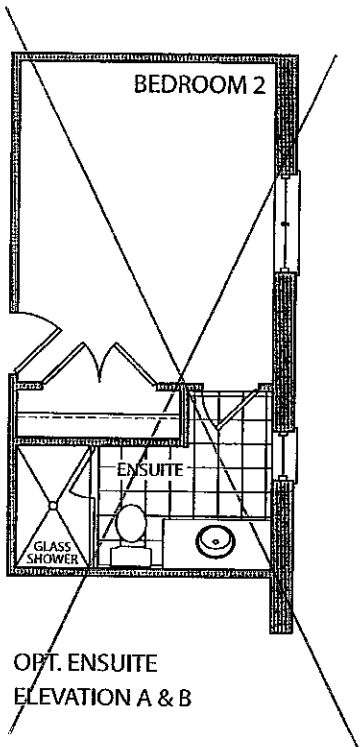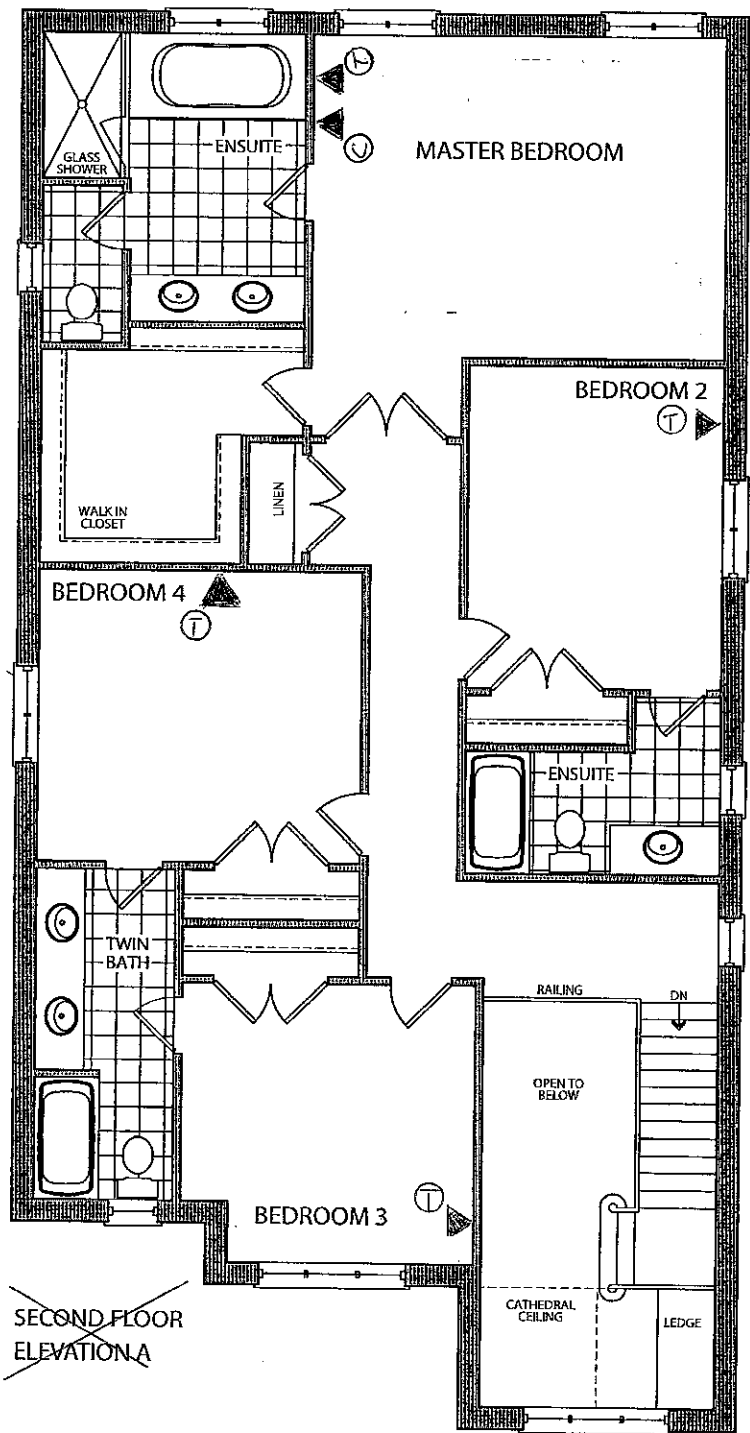

Lot 89
June 21 2016
(A4) (iA)

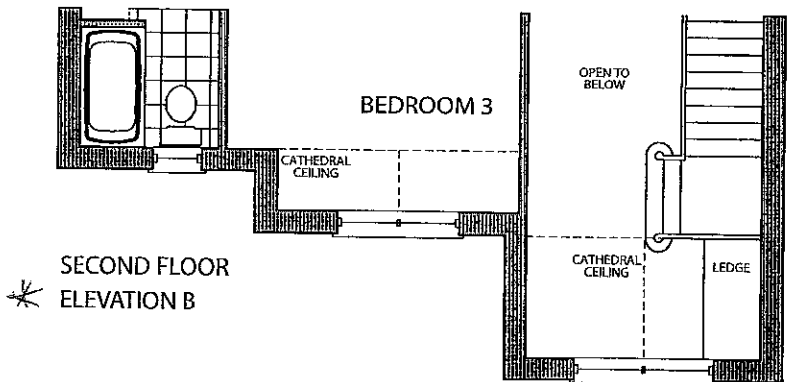

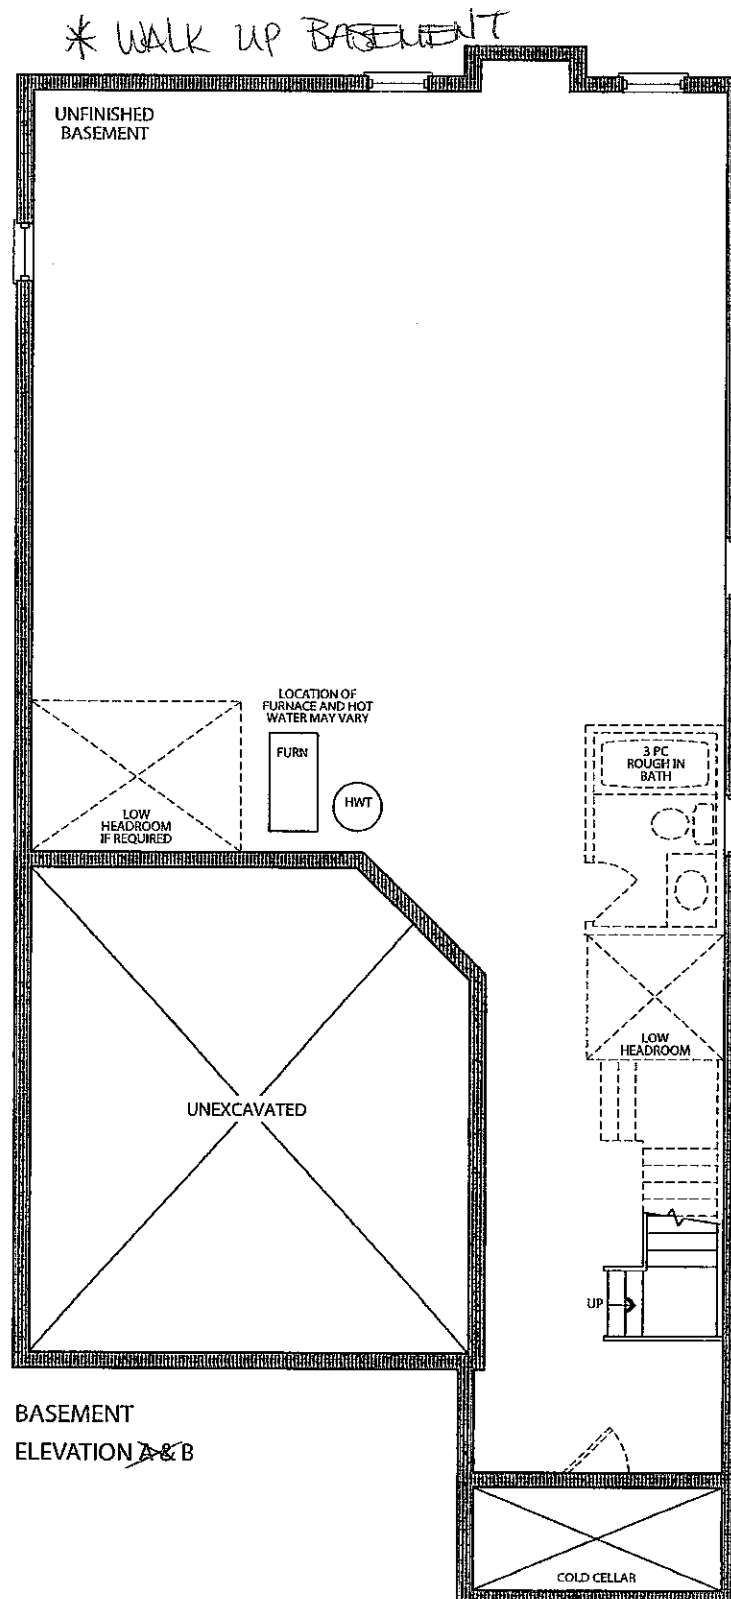

LOT 89

JUNE 21 2016

(A.A) (L.A)

Model	38.1 The Hampton		
Elevation	Circle One	A	2339.9 Square Feet
		B	2327.8 Square Feet
Taller Ceilings	Circle All that Apply	GFTC	9' Ceilings Ground Floor
		MFTC	10' Ceilings Main Floor
		SFTC	9' Ceilings Second Floor
Optional Layouts	Circle All that Apply		

Model	38.2 The Kingston		
Elevation	Circle One	A	2445.9 Square Feet
		B	2445.9 Square Feet
Taller Ceilings	Circle All that Apply	GFTC	9' Ceilings Ground Floor
		MFTC	10' Ceilings Main Floor
		SFTC	9' Ceilings Second Floor
Optional Layouts	Circle All that Apply	SFA1	SECOND FLOOR Shower in Lieu of Tub (Bedroom 2)

Model	38.3 The Birkdale		
Elevation	Circle One	A	2574.1 Square Feet
		B	2575.5 Square Feet
Taller Ceilings	Circle All that Apply	GFTC	9' Ceilings Ground Floor
		MFTC	10' Ceilings Main Floor
		SFTC	9' Ceilings Second Floor
Optional Layouts	Circle All that Apply	SFA1	SECOND FLOOR Shower in Lieu of Tub (Bedroom 2)

Model	38.4 The Bridgeport		
Elevation	Circle One	A	2723.2 Square Feet
		B	2762.0 Square Feet
Taller Ceilings	Circle All that Apply	GFTC	9' Ceilings Ground Floor
		MFTC	10' Ceilings Main Floor
		SFTC	9' Ceilings Second Floor
Optional Layouts	Circle All that Apply	SFA3	SECOND FLOOR Shower in Lieu of Tub (Twin Bath)

Model	38.5 The Rosemont		
Elevation	Circle One	A	2804.9 Square Feet
		B	2804.5 Square Feet
Taller Ceilings	Circle All that Apply	GFTC	9' Ceilings Ground Floor
		MFTC	10' Ceilings Main Floor
		SFTC	9' Ceilings Second Floor
Optional Layouts	Circle All that Apply	SFA1	SECOND FLOOR Shower in Lieu of Tub (Bedroom 2)
		SFA3	SECOND FLOOR Shower in Lieu of Tub (Twin Bath)
		SFA5	SECOND FLOOR Additional Bedroom

Model	38.6 The Wyndham		
Elevation	Circle One	A	2893.5 Square Feet
		B	2896.0 Square Feet
Taller Ceilings	Circle All that Apply	GFTC	9' Ceilings Ground Floor
		MFTC	10' Ceilings Main Floor
		SFTC	9' Ceilings Second Floor
Optional Layouts	Circle All that Apply	SFA1	SECOND FLOOR Shower in Lieu of Tub (Bedroom 2)
		SFA3	SECOND FLOOR Shower in Lieu of Tub (Twin Bath)
		SFA5	SECOND FLOOR Additional Bedroom

✓ WALK-UP BASEMENT

LOT 89

JUNE 21 2016

AA (1-A)