

Kleinburg Glen - 90 - 1 - 38-5 Elev.A ROSEMONT
CENTRAL VAC AND WIRING

Inv.596	1 - LAUNDRY ROOM: Install a ROUGH - IN FOR EXTRA SECURITY KEY PAD from garage to house door. See plan for location.
Line7293	Note:
21Jun16 / 11Nov16	

ELECTRICAL

Inv.596	1 - KITCHEN: Install a 110V WALL RECEPTACLE ON DEDICATED CIRCUIT - FOR MICROWAVE - MICROWAVE NOT INCLUDED. Cabinetry customization to be upgraded at colour appointment. See plan for location.
Line7288	Note:
21Jun16 / 11Nov16	

Inv.596	1 - KITCHEN: Install a 110V WALL RECEPTACLE ON DEDICATED CIRCUIT - FOR future 600+CFM hood fan.
Line7289	Note:
21Jun16 / 11Nov16	

Inv.596	1 - **REQUEST** Electrical panel to be located near furnace, if possible.
Line7303	Note:
21Jun16 / 11Nov16	

EXTERIOR COLOURS

Inv.596	1 - EXTERIOR COLOUR PACKAGE 3
Line13840	Note:
21Jun16 / 11Nov16	

FORMING

Inv.596	1 - Walk-up Basement.
Line7287	Note:
21Jun16 / 11Nov16	

FRAMING

Inv.596	1 - MANDOOR - GARAGE TO HOUSE - AS PER PLAN AND GRADE PERMITING
Line13842	Note: AS PER APS
21Jun16 / 11Nov16	

HVAC

Inv.596	1 - KITCHEN: UPGRADE VENTING FOR STOVE TO 8 INCH PIPE EXTERIOR WALL
Line7290	Note:
21Jun16 / 11Nov16	

Inv.596	1 - HUMIDIFIER: WB3 - 17 (UP TO 3,000 SQ.FT.)
Line7291	Note:
21Jun16 / 11Nov16	

MISC.

Inv.596	1 - BONUS PACKAGE: \$7500.00 (INCLUDING TAXES) WORTH OF UPGRADES FROM GOLD PARK HOMES DÉCOR CENTRE IS BEING APPLIED TOWARD THE STRUCTURAL APPOINTMENT. PURCHASER HAS A REMAINING AMOUNT OF \$00 (INCLUDING TAXES) TO BE USED TOWARD THE COLOUR APPOINTMENT.
Line7296	Note:
21Jun16 / 11Nov16	

Kleinburg Glen - 90 - 1 - 38-5 Elev.A ROSEMONT

Inv.596	1 - Purchasers are aware & accepts that ANY changes made to upgrades after signing this Purchasers Extra Form are subject to a minimum administration fee of \$500. PLUS a 10% holdback fee.
Line7297	Note:
21Jun16 / 11Nov16	
Inv.596	1 - Purchaser has attended a Structural appointment at the Decor Centre & has DECLINED any additional upgrades and accepts and acknowledges that there will be no further structural changes/additions/deletions to be made upon signing on June 21, 2016.
Line7298	Note:
21Jun16 / 11Nov16	

PLUMBING

Inv.596	1 - KITCHEN: ROUGH - IN - WATERLINE FOR FRIDGE
Line7292	Note:
21Jun16 / 11Nov16	

WINDOWS AND DOORS

Inv.596	1 - Walk-up Basement.
Line13839	Note:
21Jun16 / 11Nov16	
Inv.596	1 - MAN DOOR GARAGE TO HOUSE - OPTIONAL - IF GRADE PERMITS
Line13841	Note: AS PER APS
21Jun16 / 11Nov16	


LOT 90

JUNE 21 2016


(N.A.) (G.A.)

DEDICATED
ELECT. for
HOOD FAN.
+ 8" DUCT.

DED. ELECT. for
FUTURE
MICRO SHELF

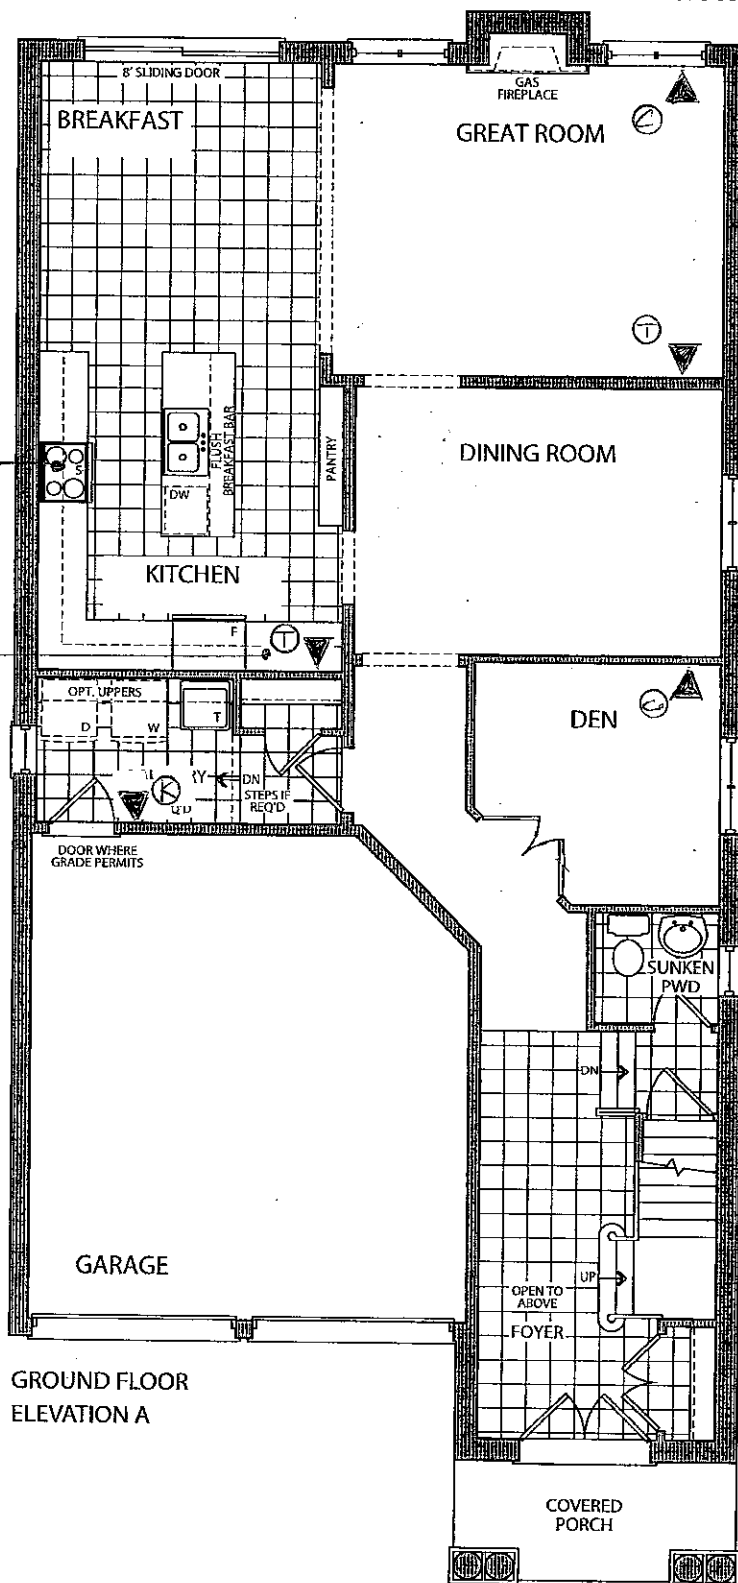

GROUND FLOOR
ELEVATION A

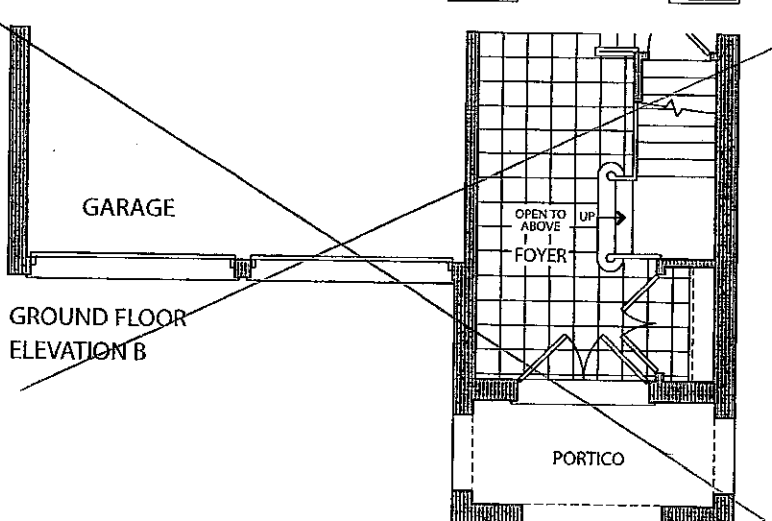



GROUND FLOOR
ELEVATION B

LEGEND


⬆️Ⓟ - PHONE


⬆️Ⓢ - CABLE

Ⓢ - DEDICATED
ELECTRICAL

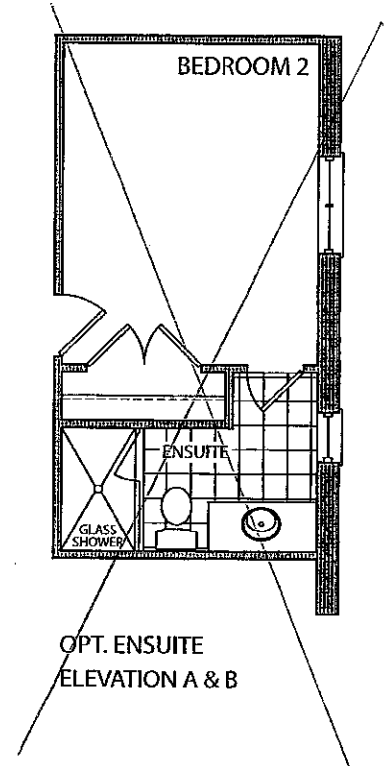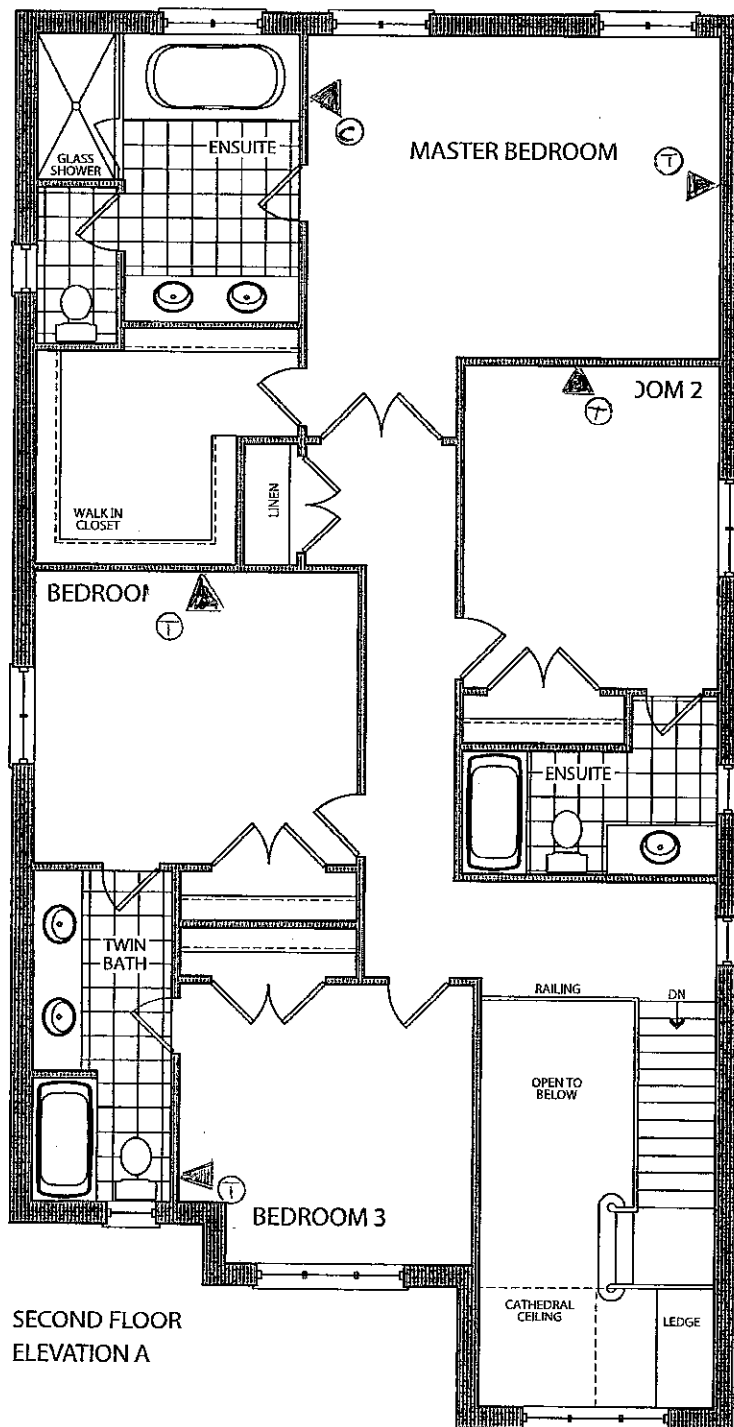

LOT 90
JUNE 21 2016
N/A GA

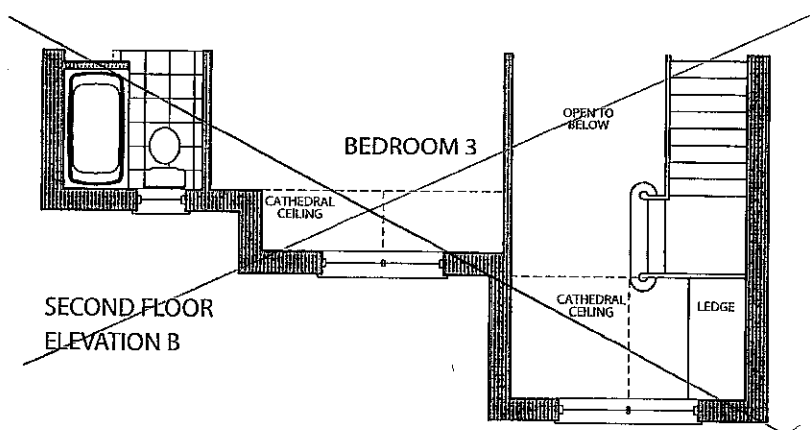

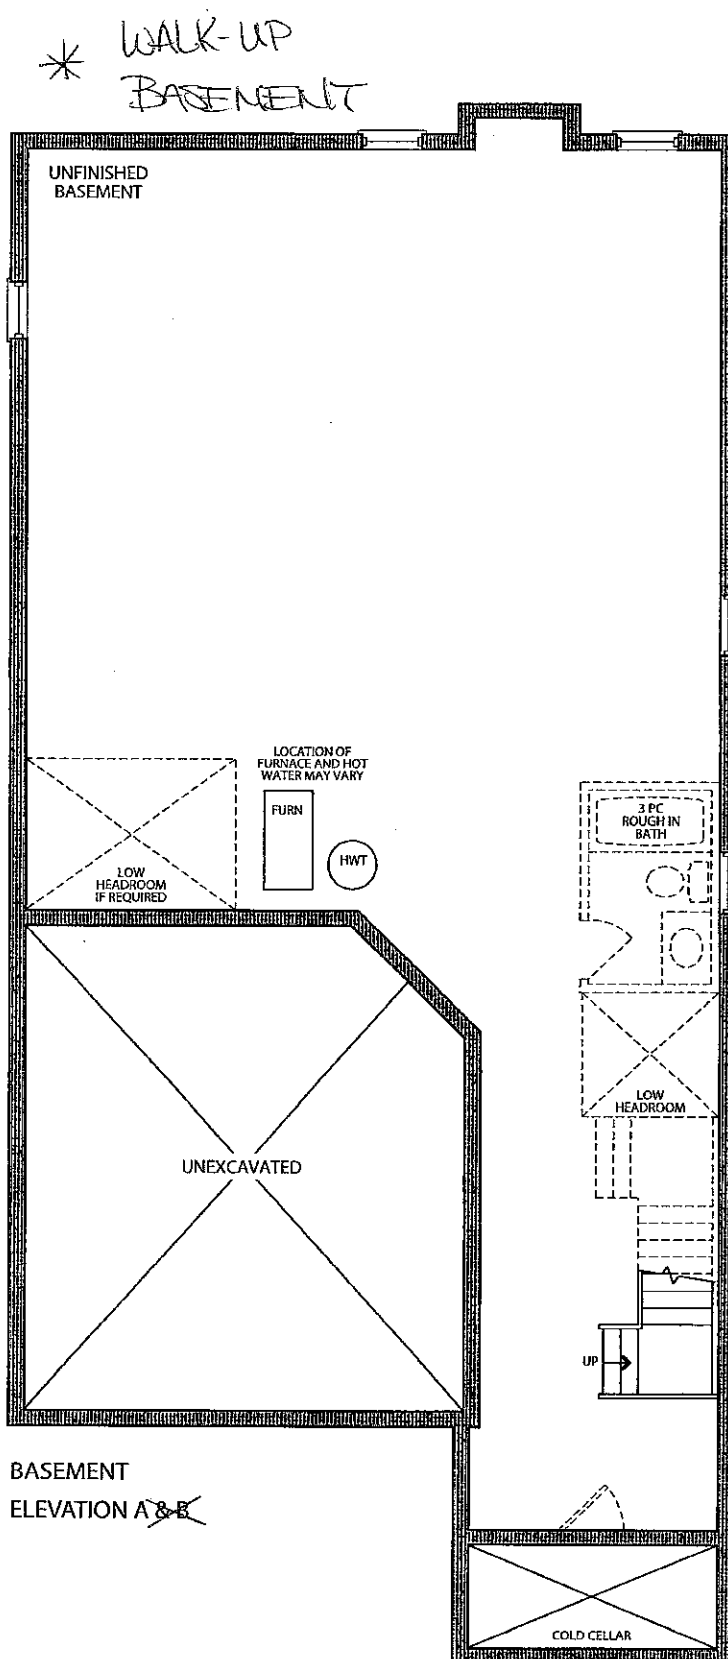

LOT 90
JUNE 2 2016
MA GA



Stacey Carlete
Project Coordinator



Claude Azzopardi
Contracts Manager



Nancy Martini
Corporate Controller



38.1 The Hampton			
Elevation	Circle One	A	2339.9 Square Feet
		B	2327.8 Square Feet
Taller Ceilings	Circle All that Apply	GFTC	9' Ceilings Ground Floor
		MFTC	10' Ceilings Main Floor
		SFTC	9' Ceilings Second Floor
Optional Layouts	Circle All that Apply		

38.2 The Kingston			
Elevation	Circle One	A	2445.9 Square Feet
		B	2445.9 Square Feet
Taller Ceilings	Circle All that Apply	GFTC	9' Ceilings Ground Floor
		MFTC	10' Ceilings Main Floor
		SFTC	9' Ceilings Second Floor
Optional Layouts	Circle All that Apply	SFA1	SECOND FLOOR Shower in Lieu of Tub (Bedroom 2)

38.3 The Birkdale			
Elevation	Circle One	A	2574.1 Square Feet
		B	2575.5 Square Feet
Taller Ceilings	Circle All that Apply	GFTC	9' Ceilings Ground Floor
		MFTC	10' Ceilings Main Floor
		SFTC	9' Ceilings Second Floor
Optional Layouts	Circle All that Apply	SFA1	SECOND FLOOR Shower in Lieu of Tub (Bedroom 2)

38.4 The Bridgeport			
Elevation	Circle One	A	2723.2 Square Feet
		B	2762.0 Square Feet
Taller Ceilings	Circle All that Apply	GFTC	9' Ceilings Ground Floor
		MFTC	10' Ceilings Main Floor
		SFTC	9' Ceilings Second Floor
Optional Layouts	Circle All that Apply	SFA3	SECOND FLOOR Shower in Lieu of Tub (Twin Bath)

38.5 The Rosemont			
Elevation	Circle One	A	2804.9 Square Feet
		B	2804.5 Square Feet
Taller Ceilings	Circle All that Apply	GFTC	9' Ceilings Ground Floor
		MFTC	10' Ceilings Main Floor
		SFTC	9' Ceilings Second Floor
Optional Layouts	Circle All that Apply	SFA1	SECOND FLOOR Shower in Lieu of Tub (Bedroom 2)
		SFA3	SECOND FLOOR Shower in Lieu of Tub (Twin Bath)
		SFA5	SECOND FLOOR Additional Bedroom

38.6 The Wyndham			
Elevation	Circle One	A	2893.5 Square Feet
		B	2896.0 Square Feet
Taller Ceilings	Circle All that Apply	GFTC	9' Ceilings Ground Floor
		MFTC	10' Ceilings Main Floor
		SFTC	9' Ceilings Second Floor
Optional Layouts	Circle All that Apply	SFA1	SECOND FLOOR Shower in Lieu of Tub (Bedroom 2)
		SFA3	SECOND FLOOR Shower in Lieu of Tub (Twin Bath)
		SFA5	SECOND FLOOR Additional Bedroom

* WALK-UP
BASEMENT.

LOT 90

JUNE 21 2016

MA GA