

Kleinburg Glen - 82R - 1 - 25-9 Elev.B SOMERSET G1A1
CENTRAL VAC AND WIRING

Inv.781	1 - FAMILY ROOM: CONDUIT PIPE - FOR TELEVISION - Locate approx. 66" A.F.F. above fireplace, terminating left of fireplace. See plan for location.
Line10473	Note:
23Aug16 / 14Nov16	
Inv.781	1 - MASTER BEDROOM: CONDUIT PIPE - FOR TELEVISION - Locate on wall between wic/ensuite. Locate approx. 66" A.F.F. terminating directly below at cable location. See plan for location.
Line10478	Note:
23Aug16 / 14Nov16	
Inv.781	1 - MASTER BEDROOM: ROUGH - IN FOR EXTRA SECURITY KEY PAD. See plan for location.
Line10487	Note:
23Aug16 / 14Nov16	
Inv.781	1 - CONDUIT PIPE - FROM ATTIC TO ELECTRICAL PANEL - Terminating in center of attic.
Line10488	Note:
23Aug16 / 14Nov16	

CERAMIC

Inv.781	1 - THRU-OUT: DO *NOT* INSTALL ACCESSORIES OR MIRRORS!
Line13873	Note:
23Aug16 / 14Nov16	

ELECTRICAL

Inv.781	1 - KITCHEN:110V WALL RECEPTACLE ON DEDICATED CIRCUIT - for future 600+ cfm hood fan.
Line10470	Note:
23Aug16 / 14Nov16	
Inv.781	1 - FAMILY ROOM: 110V WALL RECEPTACLE ON NORMAL CIRCUIT - Locate approx. 66" A.F.F. above fireplace. See plan for location.
Line10474	Note:
23Aug16 / 14Nov16	
Inv.781	1 - MASTER BEDROOM: 110V WALL RECEPTACLE ON NORMAL CIRCUIT - Locate approx. 66" A.F.F. on wall between wic/ensuite. See plan for location.
Line10479	Note:
23Aug16 / 14Nov16	
Inv.781	1 - MASTER ENSUITE: RELOCATE STANDARD FIXTURE - Locate approx. center above 1 sink. See plan for location.
Line10481	Note:
23Aug16 / 14Nov16	
Inv.781	1 - MASTER ENSUITE: ROUGH - IN WALL OUTLET & SWITCH (WITH COVER PLATE) - DOES NOT INCLUDE FIXTURE - in addition to standard vanity light, add a rough-in above 2nd sink, use same switch as standard light. See plan for location.
Line10482	Note:
23Aug16 / 14Nov16	
Inv.781	1 - POWDER ROOM: *DELETE* STANDARD VANITY SCENCE, INSTALL A STANDARD CEILING FIXTURE, USING STANDARD SWITCH. See plan for location.
Line10483	Note:
23Aug16 / 14Nov16	
Inv.781	1 - KITCHEN CABINET STRIP VALANCE LIGHTS (UNDER CABINETS) - ROUGH - IN - DOES NOT INCLUDE (AND REQUIRES) KITCHEN UPGRADE PRICING. See plan for switch location.
Line10489	Note:
23Aug16 / 14Nov16	

Kleinburg Glen - 82R - 1 - 25-9 Elev.B SOMERSET GFA1

Inv.781	1 - KITCHEN: RELOCATE STANDARD FIXTURE - Move to approx. center above island. See plan for location.
Line10490	Note:
23Aug16 / 14Nov16	

EXTERIOR COLOURS

Inv.781	1 - EXTERIOR COLOUR PACKAGE 3
Line13874	Note:
23Aug16 / 14Nov16	

FRAMING

Inv.781	1 - MAIN FLOOR: FRAME MAIN FLOOR ARCH AT 96 INCH
Line10491	Note:
23Aug16 / 14Nov16	

Inv.781	1 - DELETE KITCHEN BULK - HEAD - MUST BE APPROVED BY H.O. - CABINENTRY CROWN AND FURRING PANEL ARE EXTRA AND NOT INCLUDED IN THIS PRICE.
Line10493	Note:
23Aug16 / 14Nov16	

Inv.781	1 - OPTIONAL GROUND FLOOR
Line13875	Note:
23Aug16 / 14Nov16	

GLASS AND MIRROR

Inv.781	1 - THRU-OUT: DO *NOT* INSTALL ACCESSORIES OR MIRRORS!
Line10472	Note:
23Aug16 / 14Nov16	

INTERIOR TRIM AND DOORS

Inv.781	1 - MAIN FLOOR: EXTENDED HEIGHT ARCHWAY (PRICE PER DOORWAY) - 96"
Line10492	Note:
23Aug16 / 14Nov16	

MISC.

Inv.781	1 - Purchaser has attended a Structural appointment at the Decor Centre & has DECLINED any additional upgrades and accepts and acknowledges that there will be no further structural changes/additions/deletions to be made upon signing on August 23, 2016.
Line10494	Note:
23Aug16 / 14Nov16	

Inv.781	1 - Purchasers are aware & accepts that ANY changes made to upgrades after signing this Purchasers Extra Form are subject to a minimum administration fee of \$500. PLUS a 10% holdback fee.
Line10495	Note:
23Aug16 / 14Nov16	

Inv.781	1 - BONUS PACKAGE: \$5,000.00 (INCLUDING TAXES) WORTH OF UPGRADES FROM GOLD PARK HOMES DÉCOR CENTRE IS BEING APPLIED TOWARD THE STRUCTURAL APPOINTMENT. PURCHASER HAS A REMAINING AMOUNT OF \$135.35 (INCLUDING TAXES) TO BE USED TOWARD THE COLOUR APPOINTMENT.
Line10496	Note:
23Aug16 / 14Nov16	

Elevation A • 1,794 sq.ft.


Elevation B • 1,794 sq.ft.

82R


AUGUST 23 2016

(Handwritten initials)

SWITCH for
VALANCE LIGHTS.

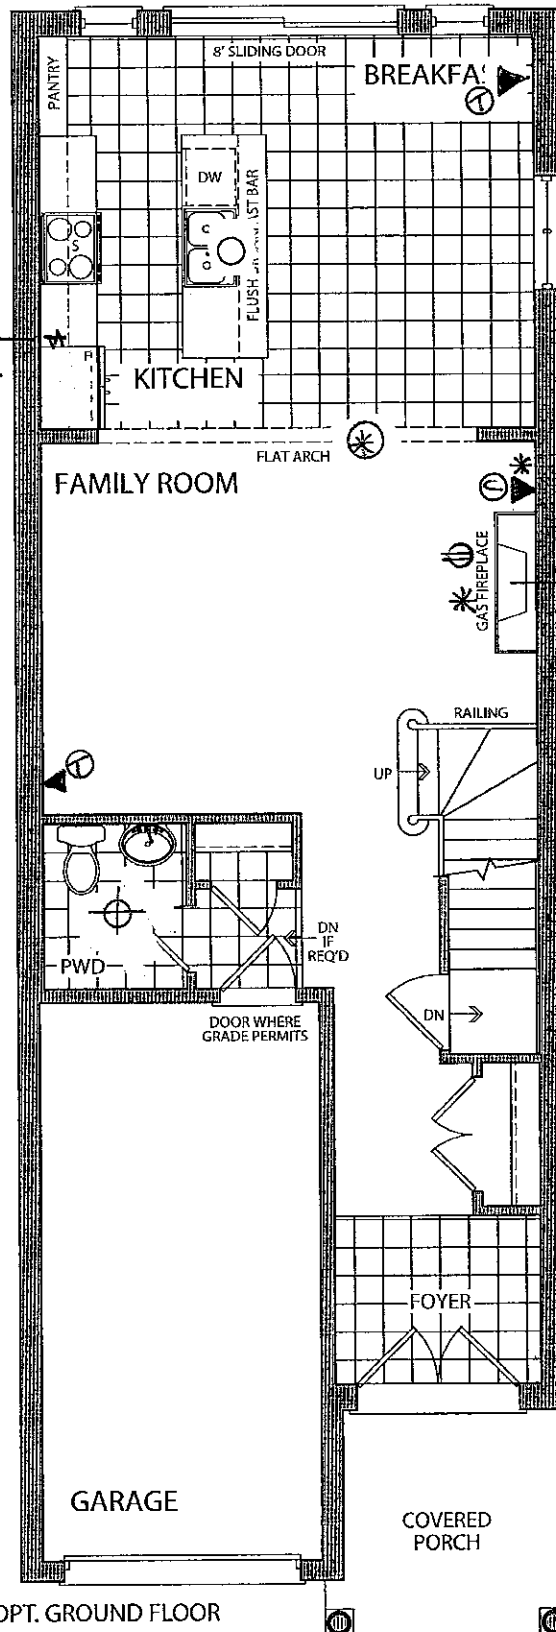

OPT. GROUND FLOOR
ELEVATION A

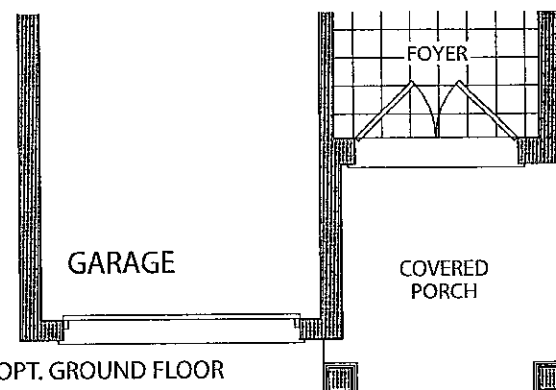

OPT. GROUND FLOOR
ELEVATION B

○ STD LIGHT

⊕ ELECT. OUTLET

* CONDUIT

▲ ⊕ CABLE

▲ ⊕ PHONE

⊕ CEILING LIGHT


Ⓚ KEY PAD ROUGH IN

⊗ 8' ARCH.

the Somerset


~~Elevation A • 1,794 sq.ft.~~

✓Elevation B • 1,794 sq.ft.

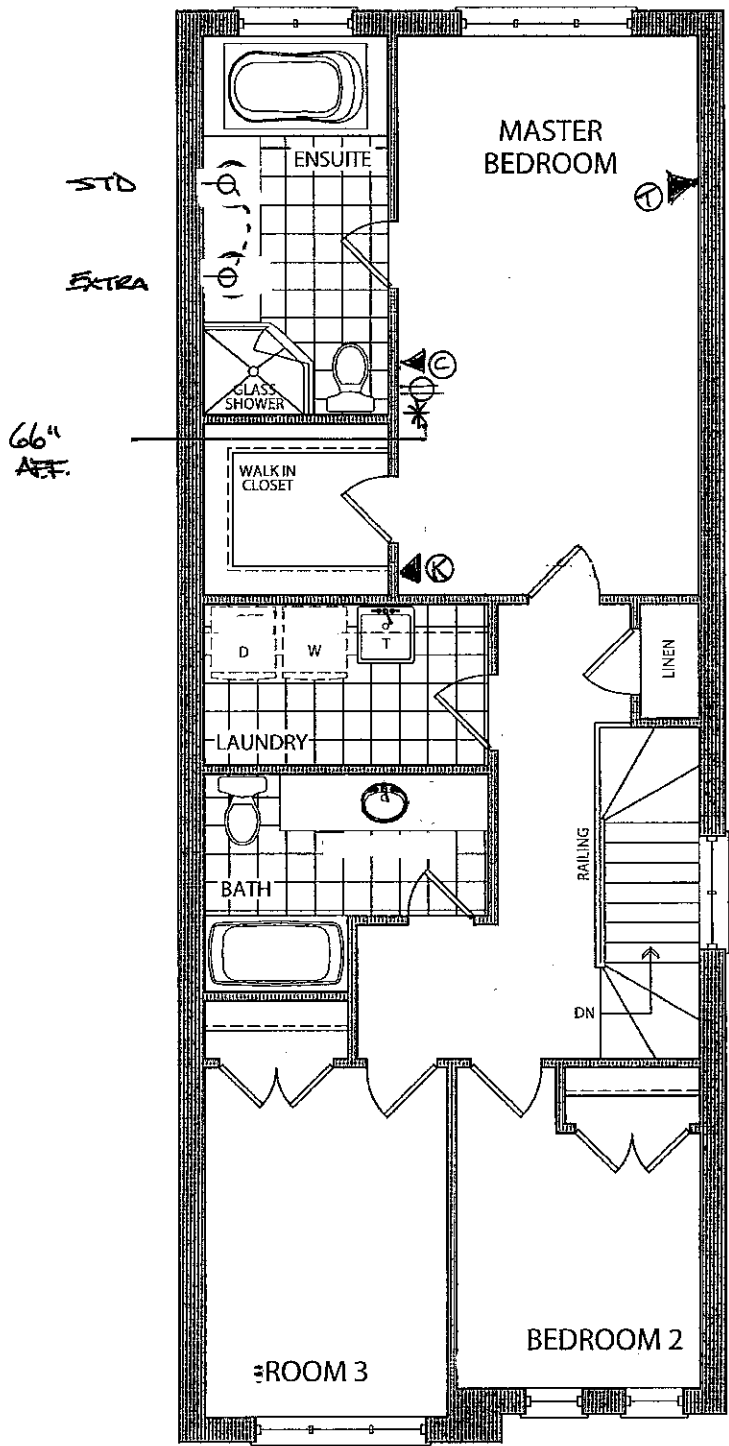

82R
August 23 2016
[Handwritten signatures]

~~SECOND FLOOR
ELEVATION A~~

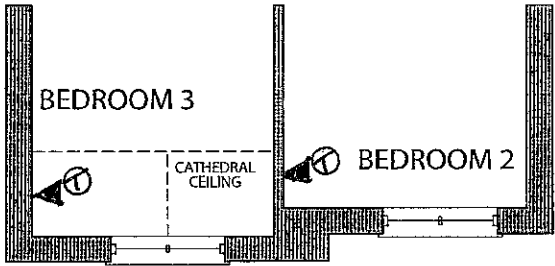


✓SECOND FLOOR
ELEVATION B

~~Elevation A • 1,794 sq.ft.~~

✓ Elevation B • 1,794 sq.ft.

82 R
AUGUST 23/16
⑧ ⑧

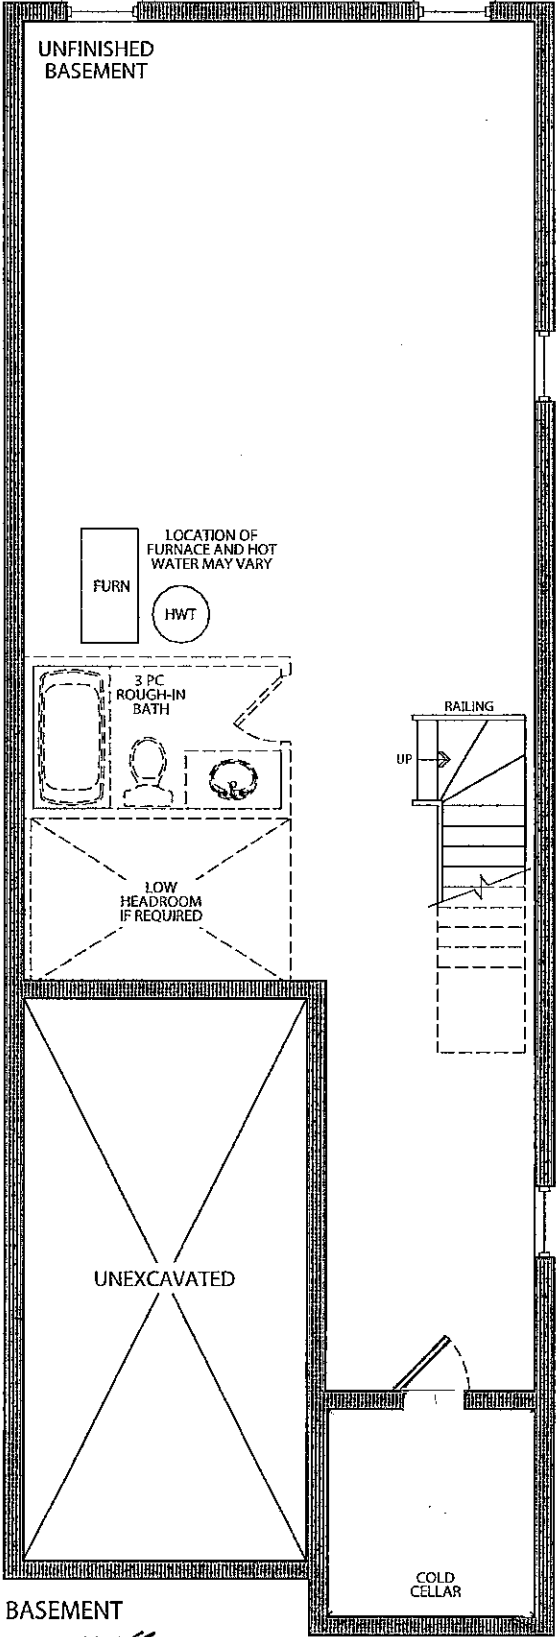

BASEMENT
ELEVATION ~~A~~ B



Stacey Carlete
Project Coordinator



Claude Azzopardi
Contracts Manager



Nancy Martini
Corporate Controller

Kleinburg
GLEN

Model 25.1 The Riverstone			
Elevation	Circle One	A	1812.7 Square Feet
		B	1812.7 Square Feet
Taller Ceilings	Circle All that Apply	GFTC	9' Ceilings Ground Floor
		MFTC	10' Ceilings Main Floor
		SFTC	9' Ceilings Second Floor
Optional Layouts	Circle All that Apply	GFA1	GROUND FLOOR Alternative Layout Kitchen/Family Room

Model 25.2 The Hudson			
Elevation	Circle One	A	1860.8 Square Feet
		B	1858.6 Square Feet
Taller Ceilings	Circle All that Apply	GFTC	9' Ceilings Ground Floor
		MFTC	10' Ceilings Main Floor
		SFTC	9' Ceilings Second Floor
Optional Layouts	Circle All that Apply	GFA1	GROUND FLOOR Alternative Layout Kitchen/Family Room

Model 25.3 The Oakmount			
Elevation	Circle One	A	2013.0 Square Feet
		B	2013.0 Square Feet
Taller Ceilings	Circle All that Apply	GFTC	9' Ceilings Ground Floor
		MFTC	10' Ceilings Main Floor
		SFTC	9' Ceilings Second Floor
Optional Layouts	Circle All that Apply	GFA1	GROUND FLOOR Alternative Layout Kitchen/Family Room
		SFA4	SECOND FLOOR Alternative Layout Laundry Room
		SFA5	SECOND FLOOR Additional Bedroom

Model 25.4 The Stanford			
Elevation	Circle One	A	2665.6 Square Feet
		B	2665.6 Square Feet
Taller Ceilings	Circle All that Apply	GFTC	9' Ceilings Ground Floor
		MFTC	10' Ceilings Main Floor
		SFTC	9' Ceilings Second Floor
Optional Layouts	Circle All that Apply	GFA2	GROUND FLOOR Optional Piece Bathroom
		MFA1	MAIN FLOOR Alternative Layout Kitchen/Family Room
		SFA2	SECOND FLOOR Shower in Lieu of Tub (Master Ens.)
		SFA5	SECOND FLOOR Additional Bedroom

Model 25.5 The Regency			
Elevation	Circle One	A	2924.0 Square Feet
		B	2924.0 Square Feet
Taller Ceilings	Circle All that Apply	GFTC	9' Ceilings Ground Floor
		MFTC	10' Ceilings Main Floor
		SFTC	9' Ceilings Second Floor
Optional Layouts	Circle All that Apply	GFA2	GROUND FLOOR Optional Piece Bathroom
		MFA1	MAIN FLOOR Alternative Layout Kitchen/Family Room
		SFA2	SECOND FLOOR Shower in Lieu of Tub (Master Ens.)
		SFA5	SECOND FLOOR Additional Bedroom

Model 25.6 The Lincoln			
Elevation	Circle One	A	3021.0 Square Feet
		B	3014.0 Square Feet
Taller Ceilings	Circle All that Apply	GFTC	9' Ceilings Ground Floor
		MFTC	10' Ceilings Main Floor
		SFTC	9' Ceilings Second Floor
Optional Layouts	Circle All that Apply	GFA2	GROUND FLOOR Optional Piece Bathroom
		MFA1	MAIN FLOOR Alternative Layout Kitchen/Family Room

Model 25.7 The Carnegie			
Elevation	Circle One	A	3150.8 Square Feet
		B	3150.8 Square Feet
Taller Ceilings	Circle All that Apply	GFTC	9' Ceilings Ground Floor
		MFTC	10' Ceilings Main Floor
		SFTC	9' Ceilings Second Floor
Optional Layouts	Circle All that Apply	GFA2	GROUND FLOOR Optional Piece Bathroom
		MFA1	MAIN FLOOR Alternative Layout Kitchen/Family Room
		SFA1	SECOND FLOOR Shower in Lieu of Tub (Bedroom 2)

Model 25.8 The Biltmore			
Elevation	Circle One	A	1980.8 Square Feet
		B	1980.3 Square Feet
Taller Ceilings	Circle All that Apply	GFTC	9' Ceilings Ground Floor
		MFTC	10' Ceilings Main Floor
		SFTC	9' Ceilings Second Floor
Optional Layouts	Circle All that Apply		

Model			
Elevation	Circle One		
Taller Ceilings	Circle All that Apply		
Optional Layouts	Circle All that Apply		

Model 25.9 Somerset			
Elevation	Circle One		
Taller Ceilings	Circle All that Apply		
Optional Layouts	Circle All that Apply		

Ⓟ

1794sq'

✓ OPT MAIN FLOOR

AUGUST 23 2016.
LOT 82R

Ⓟ Ⓟ