

Brampton Encore - 15 - 1 - 38-5 Elev.A HANDEL  
CENTRAL VAC AND WIRING

Inv.599	1 - TELEPHONE AND CABLE ROUGH-IN LOCATIONS
Line7341	Note:
22Jun16 / 21Sep16	
Inv.599	1 - FAMILY ROOM: INSTALL CONDUIT PIPE- FOR TELEVISION- IN FAMILY ROOM, 5 FEET ABOVE FINISHED FLOOR. TERMINATION POINT TO BE BELOW. SEE SKETCH
Line7342	Note:
22Jun16 / 21Sep16	

ELECTRICAL

Inv.599	1 - FAMILY ROOM: INSTALL 110V WALL RECEPTACLE ON DEDICATED CIRCUIT IN FAMILY ROOM,- 4'-5" ABOVE FINISHED FLOOR. TERMINATION POINT TO BE BELOW. SEE SKETCH
Line7343	Note:
22Jun16 / 21Sep16	
Inv.599	1 - BASEMENT: INSTALL 200 AMP ELECTRICAL SERVICE
Line7344	Note:
22Jun16 / 21Sep16	
Inv.954	1 - **NEW ADDITION**110V WALL RECEPTACLE ON DEDICATED CIRCUIT - FOR STOVE - STOVE NOT INCLUDED
Line13580	Note: 12/15/2016
8Nov16 / 15Dec16	
Inv.954	1 - **NEW ADDITION** KITCHEN: INSTALL 110V WALL RECEPTACLE ON DEDICATED CIRCUIT - FOR MICROWAVE - MICROWAVE NOT INCLUDED. FOR FUTURE WALL OVEN/ MICROWAVE UNIT. PURCHASER MUST BUY THE APPROPRIATE CABINETRY AT THE TIME OF COLOURS
Line13581	Note: 12/15/2016
8Nov16 / 15Dec16	
Inv.954	1 - **NEW ADDITION** KITCHEN: INSTALL 220V WALL RECEPTICAL ON DEDICATED CIRCUIT- FOR 4 WIRE BUILT-IN WALL OVEN - MUST SPECIFY LOCATION. FOR FUTURE WALL OVEN/ MICROWAVE UNIT. PURCHASER MUST BUY THE APPROPRIATE CABINETRY AT THE TIME OF COLOURS
Line13582	Note: 12/15/2016
8Nov16 / 15Dec16	

EXTERIOR COLOURS

Inv.599	1 - EXTERIOR COLOUR PACKAGE 6
Line11648	Note:
22Jun16 / 21Sep16	

FORMING

Inv.741	1 - EXTERIOR: INSTALL SIDE DOOR- HOME TO EXTERIOR- AS PER PLAN AND GRADE PERMITTING
Line10054	Note: GRADE PERMITS AS PER SITING AUGUST 2, 2016
11Aug16 / 21Sep16	

FRAMING

Inv.599	1 - GARAGE: INSTALL MANDOOR - GARAGE TO HOUSE- AS PER PLAN AND GRADE PERMITING
Line7345	Note: GIVEN IN AGREEMENT OF PURCHASE AND SALE
22Jun16 / 21Sep16	GRADING ALLOWS PER SITING DATED AUGUST 2, 2016

HVAC

Brampton Encore - 15 - 1 - 38-5 Elev.A HANDEL

Inv.954	1 - <b>**NEW ADDITION**</b> KITCHEN: INSTALL GAS LINE ROUGH - 2ND FLOOR- (3-STOREY MODELS). FOR STOVE
Line13579	Note: 12/15/2016
8Nov16 / 15Dec16	

MISC.

Inv.599	1 - BONUS PACKAGE: \$3186.60 (INCLUDING TAXES) WORTH OF UPGRADES FROM GOLD PARK HOMES DÉCOR CENTRE IS BEING APPLIED TOWARD THE STRUCTURAL APPOINTMENT. PURCHASER HAS A REMAINING AMOUNT OF \$6813.40 (INCLUDING TAXES) TO BE USED TOWARD THE COLOUR APPOINTMENT
Line7350	Note:
22Jun16 / 21Sep16	

Inv.599	1 - Purchaser has attended a Structural appointment at the Decor Centre & has DECLINED any additional upgrades and accepts and acknowledges that there will be no further structural changes/additions/deletions to be made upon signing on June 22, 2016
Line7351	Note:
22Jun16 / 21Sep16	

Inv.599	1 - Purchasers are aware & accepts that ANY changes made to upgrades after signing this Purchasers Extra Form are subject to a minimum administration fee of \$500. PLUS a 10% holdback fee
Line7352	Note:
22Jun16 / 21Sep16	

Inv.741	1 - ADMIN FEE TO REOPEN FILE
Line10056	Note:
11Aug16 / 21Sep16	

Inv.741	1 - BONUS PACKAGE: \$2825.00 (INCLUDING TAXES) WORTH OF UPGRADES FROM GOLD PARK HOMES DÉCOR CENTRE IS BEING APPLIED TOWARD THE STRUCTURAL APPOINTMENT. PURCHASER HAS A REMAINING AMOUNT OF \$3988.40 (INCLUDING TAXES) TO BE USED TOWARD THE COLOUR APPOINTMENT
Line10057	Note:
11Aug16 / 21Sep16	

Inv.741	1 - Purchasers are aware & accepts that ANY changes made to upgrades after signing this Purchasers Extra Form are subject to a minimum administration fee of \$500. PLUS a 10% holdback fee
Line10058	Note:
11Aug16 / 21Sep16	

Inv.954	1 - AMENDMENT FEE TO REOPEN THE FILE
Line13578	Note:
8Nov16 / 15Dec16	

Inv.954	1 - Purchasers are aware & accepts that ANY changes made to upgrades after signing this Purchasers Extra Form are subject to a minimum administration fee of \$500. PLUS a 10% holdback fee
Line13584	Note:
8Nov16 / 15Dec16	

Inv.954	1 - BONUS PACKAGE: \$2395.60 (INCLUDING TAXES) WORTH OF UPGRADES FROM GOLD PARK HOMES DÉCOR CENTRE IS BEING APPLIED TOWARD THE STRUCTURAL APPOINTMENT. PURCHASER HAS A REMAINING AMOUNT OF \$4417.80 (INCLUDING TAXES) TO BE USED TOWARD THE COLOUR APPOINTMENT
Line13587	Note:
8Nov16 / 15Dec16	

PLUMBING



Inv.599	1 - KITCHEN: INSTALL ROUGH-IN - WATERLINE FOR FRIDGE
Line7347	Note:
22Jun16 / 21Sep16	

Brampton Encore - 15 - 1 - 38-5 Elev.A HANDEL

WINDOWS - BASEMENT

Inv.599	2 - BASEMENT: INSTALL TWO (X2) BASEMENT WINDOWS - UPGRADE EXISTING BASEMENT WINDOW TO 30 INCH X 24 INCH - MAY REQUIRE INSTALLATION OF WINDOW WELL
Line7346	Note:
22Jun16 / 21Sep16	
Inv.599	1 - BASEMENT: INSTALL ONE (X1) BASEMENT WINDOWS - UPGRADE EXISTING BASEMENT WINDOW TO 30 INCH X 16 INCH. SEE SKETCH
Line7349	Note:
22Jun16 / 21Sep16	



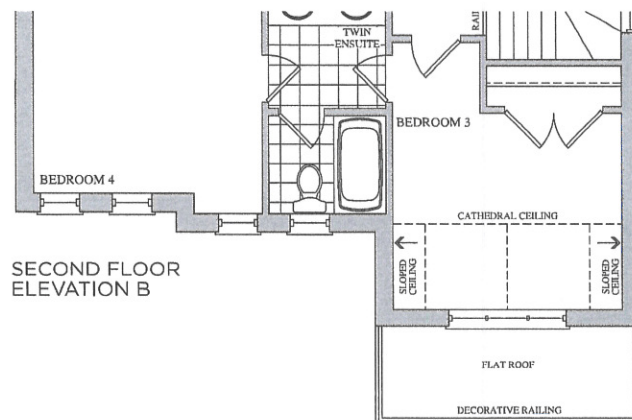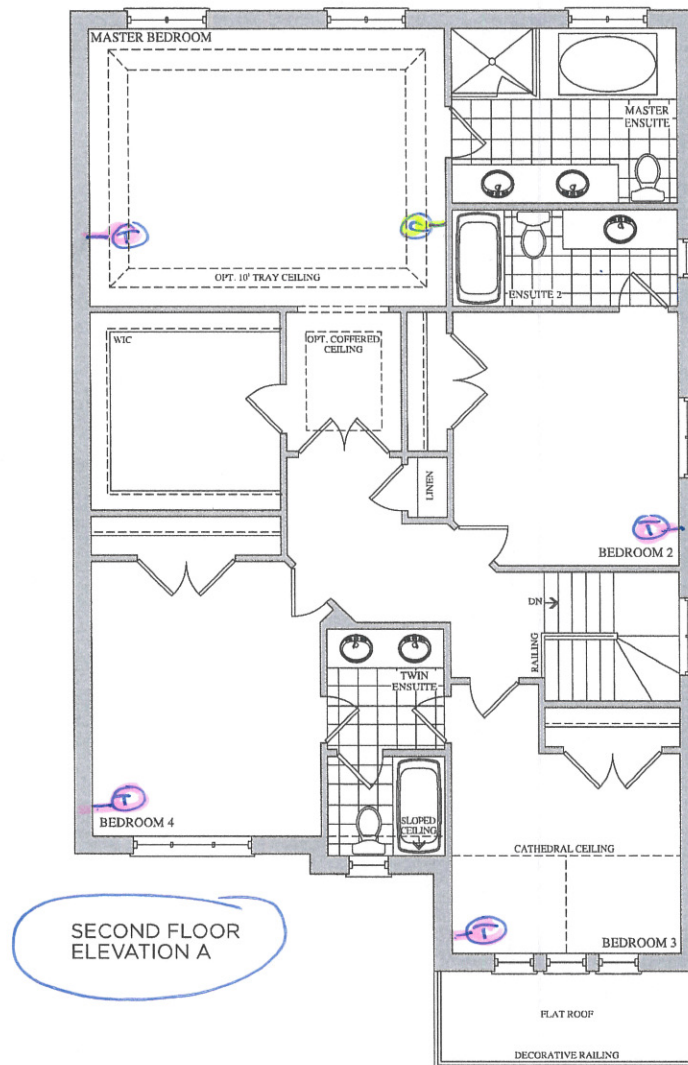


Lot 15  
June 22, 16  
~~OK~~ ~~OK~~

Basement Windows

2 x 30" x 24"

1 x 30" x 16"

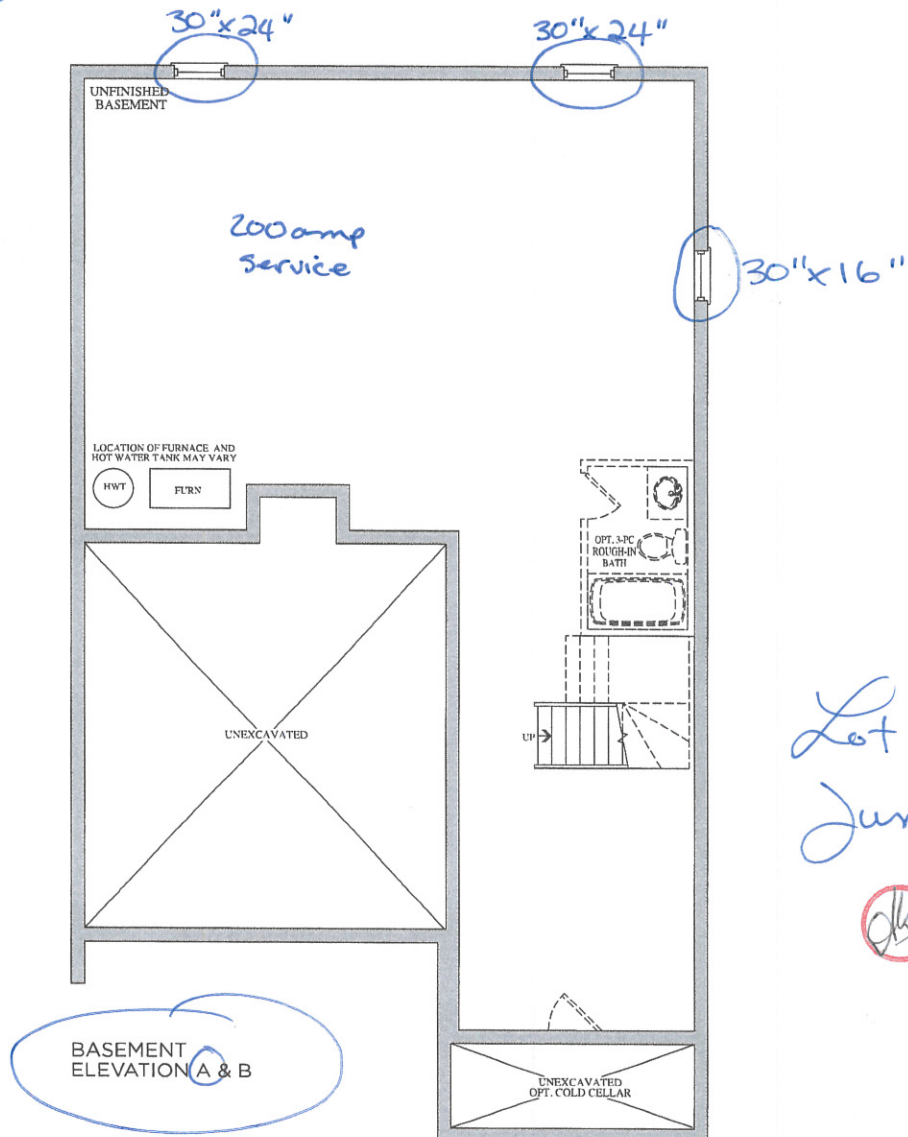

Lot 15  
June 22, 16







Stacey Carlete  
Project Coordinator



Claude Azzopardi  
Contracts Manager



Nancy Mc  
Corporate C

15  
Lot #



38.1 The Bizet			
Elevation	Circle One	A	2189.6 Square Feet
		B	2186.7 Square Feet
Optional Layouts	Circle All that Apply		

38.2 The Ravel			
Elevation	Circle One	A	2271.5 Square Feet
		B	2273.7 Square Feet
Optional Layouts	Circle All that Apply		

38.3 The Haydn			
Elevation	Circle One	A	2394.5 Square Feet
		B	2388.3 Square Feet
Optional Layouts	Circle All that Apply		

38.4 The Vivaldi			
Elevation	Circle One	A	2459.1 Square Feet
		B	2459.1 Square Feet
Optional Layouts	Circle All that Apply		

38.5 The Handel			
Elevation	Circle One	A	2549.2 Square Feet
		B	2554.7 Square Feet
Optional Layouts	Circle All that Apply		

38.9 The Puccini			
Elevation	Circle One	A	3628.0 Square Feet
		B	3634.7 Square Feet
Optional Layouts	Circle All that Apply	GFA1	GROUND FLOOR Optional Alternative Layout

38.6 The Scarlatti			
Elevation	Circle One	A	3521.1 Square Feet
		B	3508.1 Square Feet
Optional Layouts	Circle All that Apply	GFA1	GROUND FLOOR Optional Alternative Layout

38.7 The Schubert			
Elevation	Circle One	A	3593.8 Square Feet
		B	3610.5 Square Feet
Optional Layouts	Circle All that Apply	GFA1	GROUND FLOOR Optional Alternative Layout
		SFA4	SECOND FLOOR Additional Bedroom
Optional Layouts	Circle All that Apply		

38.8 The Corelli			
Elevation	Circle One	A	3801.5 Square Feet
		B	3801.5 Square Feet
Optional Layouts	Circle All that Apply	GFA1	GROUND FLOOR Optional Alternative Layout
		SFA4	SECOND FLOOR Additional Bedroom w/ Ensuite
Optional Layouts	Circle All that Apply		

41.1 The Strauss			
Elevation	Circle One	A	2554.2 Square Feet
		B	2571.2 Square Feet
Optional Layouts	Circle All that Apply	SFA1	SECOND FLOOR Shower in Lieu of Tub B2

41.2 The Mozart			
Elevation	Circle One	A	2725.9 Square Feet
		B	2711.1 Square Feet
Optional Layouts	Circle All that Apply	SFA1	SECOND FLOOR Shower in Lieu of Tub B2

41.3 The Chopin			
Elevation	Circle One	A	2800.0 Square Feet
		B	2810.5 Square Feet
Optional Layouts	Circle All that Apply		

41.4 The Bach			
Elevation	Circle One	A	2894.4 Square Feet
		B	2894.5 Square Feet
Optional Layouts	Circle All that Apply		

41.5 The Brahms			
Elevation	Circle One	A	3948.1 Square Feet
		B	3949.1 Square Feet
Optional Layouts	Circle All that Apply	GFA1	GROUND FLOOR Optional Alternative Layout
		SFA2	SECOND FLOOR Shower in Lieu of Tub B4
Optional Layouts	Circle All that Apply	SFA3	SECOND FLOOR Optional Laundry Layout

41.6 The Verdi			
Elevation	Circle One	A	3862.5 Square Feet
		B	3866.4 Square Feet
Optional Layouts	Circle All that Apply	GFA1	GROUND FLOOR Optional Alternative Layout
		SFA3	SECOND FLOOR Optional Laundry Layout
Optional Layouts	Circle All that Apply		

June 22, 16




**encore**  
BRAMPTON

Telephone — (T)  
Cable — (C)  
Electrical — (E)

# The Handel 38' SERIES

Elevation A • 2,603 sq.ft. | Elevation B • 2,603 sq.ft.

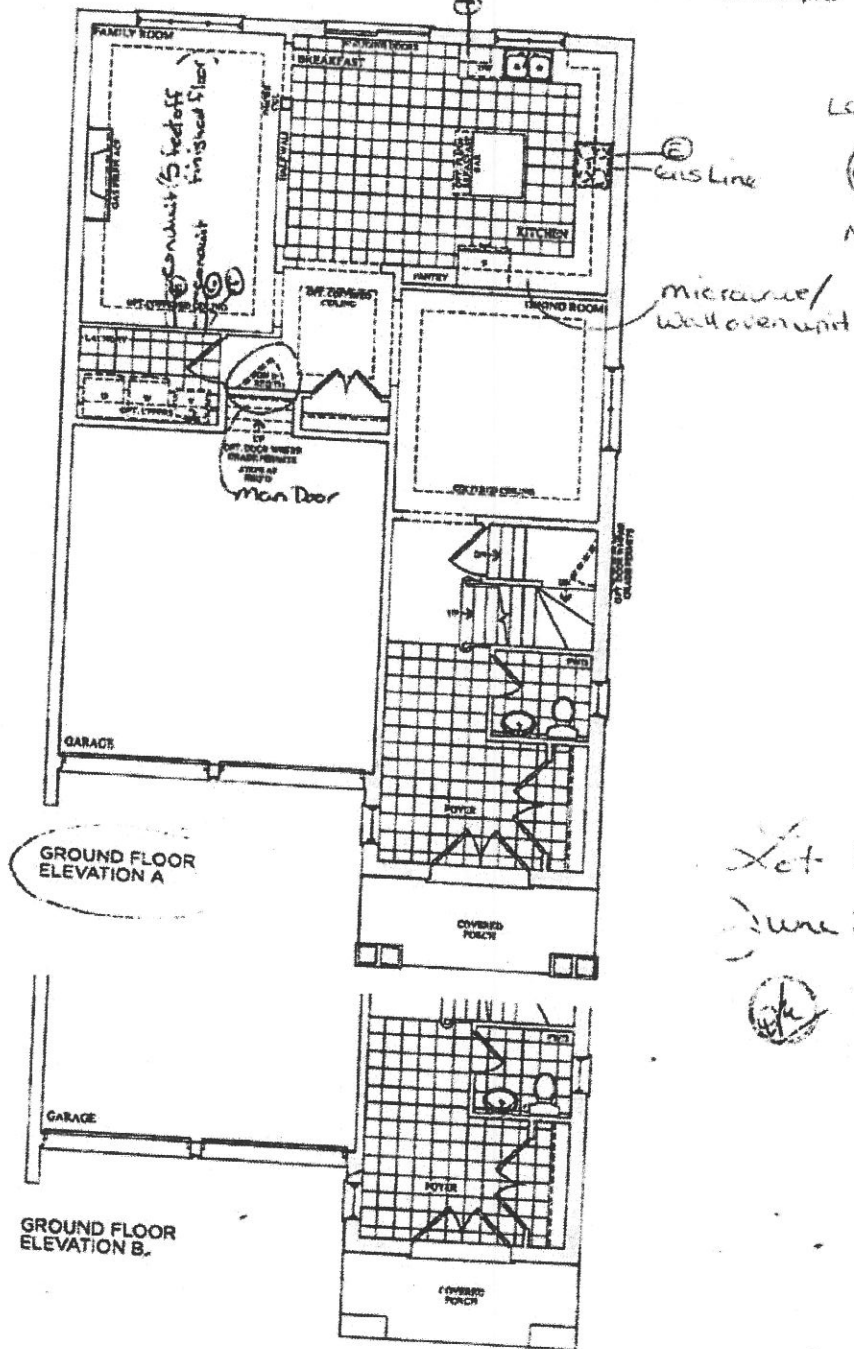

Prices, figures, features and floor plans are subject to change without notice. E.B.C.E. And/or disclaimer and approximate and actual usable floor space may vary from the stated area. Layout may be reverse of the unit depicted. E. & O.E.

**GOLDPARK**  
HOMES