

CONSTRUCTION SUMMARY

29 - 1 - 38-5 Elev.A HANDEL

CENTRAL VAC AND WIRING

Inv.515	1 - TELEPHONE AND CABLE ROUGH-IN LOCATIONS
Line6425	Note:
25May16 / 21Sep16	

EXTERIOR COLOURS

Inv.515	1 - EXTERIOR COLOUR PACKAGE 7
Line11651	Note:
25May16 / 21Sep16	

FIREPLACE

Inv.515	1 - FAMILY ROOM: INSTALL A STANDARD CORNER FIREPLACE IN LIEU OF THE BUILDER'S STANDARD FIREPLACE. SEE SKETCH
Line7389	Note:
25May16 / 21Sep16	

FORMING

Inv.515	1 - EXTERIOR: SIDE DOOR- HOME TO EXTERIOR- AS PER PLAN AND GRADE PERMITTING
Line6427	Note: GRADE DOES NOT PERMIT PER SITING DATED AUGUST 9, 2016
25May16 / 21Sep16	

FRAMING

Inv.515	1 - GARAGE: INSTALL MANDOOR - GARAGE TO HOUSE- AS PER PLAN AND GRADE PERMITING
Line6426	Note: GIVEN, AS PER AGREEMENT OF PURCHASE AND SALE
25May16 / 21Sep16	

HVAC

Inv.515	1 - KITCHEN: GAS LINE ROUGH -IN MAIN FLOOR FOR STOVE
Line6429	Note:
25May16 / 21Sep16	

MISC.

Inv.515	1 - BONUS PACKAGE: \$7073.80 (INCLUDING TAXES) WORTH OF UPGRADES FROM GOLD PARK HOMES DÉCOR CENTRE IS BEING APPLIED TOWARD THE STRUCTURAL APPOINTMENT. PURCHASER HAS A REMAINING AMOUNT OF \$2926.20 (INCLUDING TAXES) TO BE USED TOWARD THE COLOUR APPOINTMENT
Line7431	Note:
25May16 / 21Sep16	
Inv.515	1 - Purchaser has attended a Structural appointment at the Decor Centre & has DECLINED any additional upgrades and accepts and acknowledges that there will be no further structural changes/additions/deletions to be made upon signing on June 22, 2016
Line7432	Note:
25May16 / 21Sep16	
Inv.515	1 - Purchasers are aware & accepts that ANY changes made to upgrades after signing this Purchasers Extra Form are subject to a minimum administration fee of \$500. PLUS a 10% holdback fee
Line7433	Note:
25May16 / 21Sep16	

PLUMBING

CONSTRUCTION SUMMARY


29 - 1 - 38-5 Elev.A HANDEL

Inv.515	1 - KITCHEN: INSTALL ROUGH-IN - WATERLINE FOR FRIDGE
Line6430	Note:
25May16 / 21Sep16	
Inv.515	1 - BASEMENT: INSTALL ROUGH-IN - 3PC BASEMENT ROUGH-IN, AS PER PLAN
Line6431	Note:
25May16 / 21Sep16	
Inv.515	1 - LAUNDRY ROOM: MOVE LAUNDRY ROOM TO BASEMENT, SEE SKETCH FOR LOCATIONS
Line7411	Note:
25May16 / 21Sep16	


WINDOWS - BASEMENT

Inv.515	3 - BASEMENT: INSTALL THREE (X3) BASEMENT WINDOWS - UPGRADE EXISTING BASEMENT WINDOW TO 30 INCH X 24 INCH - MAY REQUIRE INSTALLATION OF WINDOW WELL
Line6428	Note:
25May16 / 21Sep16	


Elevation A • 2,603 sq.ft. | Elevation B • 2,603 sq.ft.

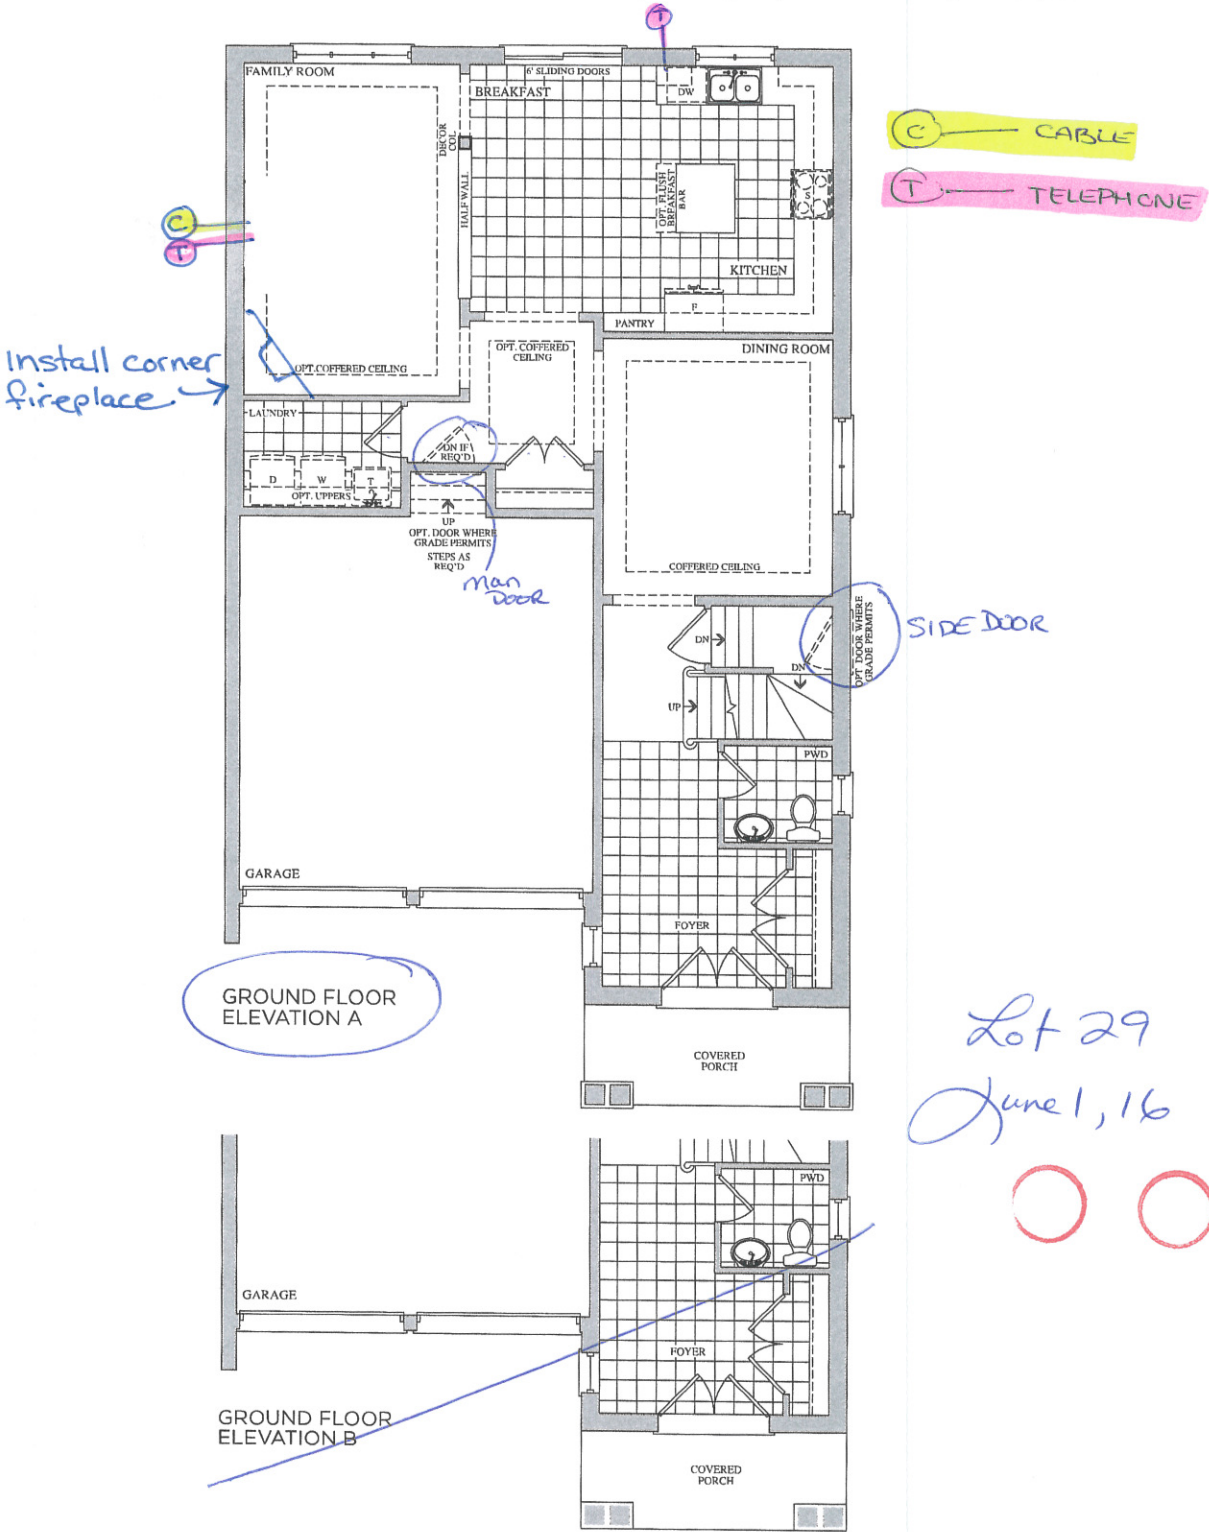

Prices, figures, illustrations, sizes, features and finishes are subject to change without notice. E.&O.E. Areas and dimensions are approximate and actual usable floor space may vary from the stated area. Layout may be reverse of the unit purchased. E. & O.E.

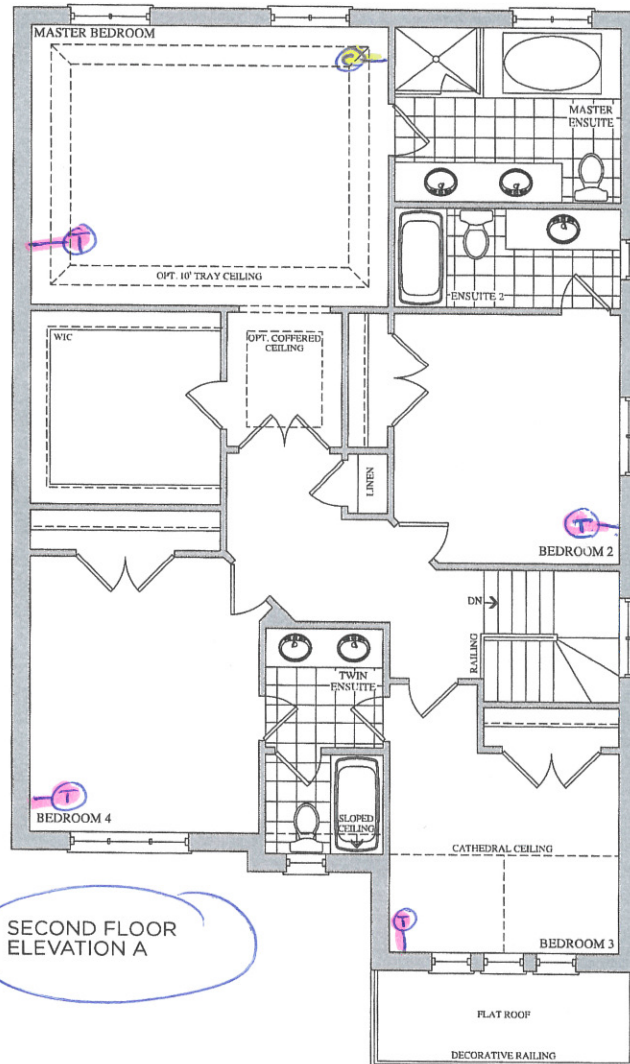


SECOND FLOOR
ELEVATION A

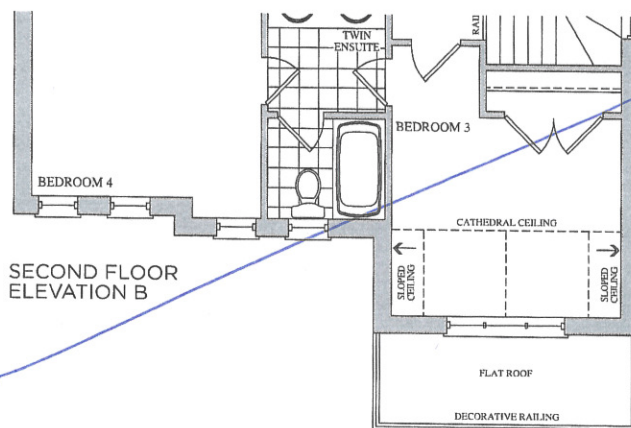

SECOND FLOOR
ELEVATION B

Lot 29
June 1, 16
OO

Bsmnt Windows
3x 30"x24"

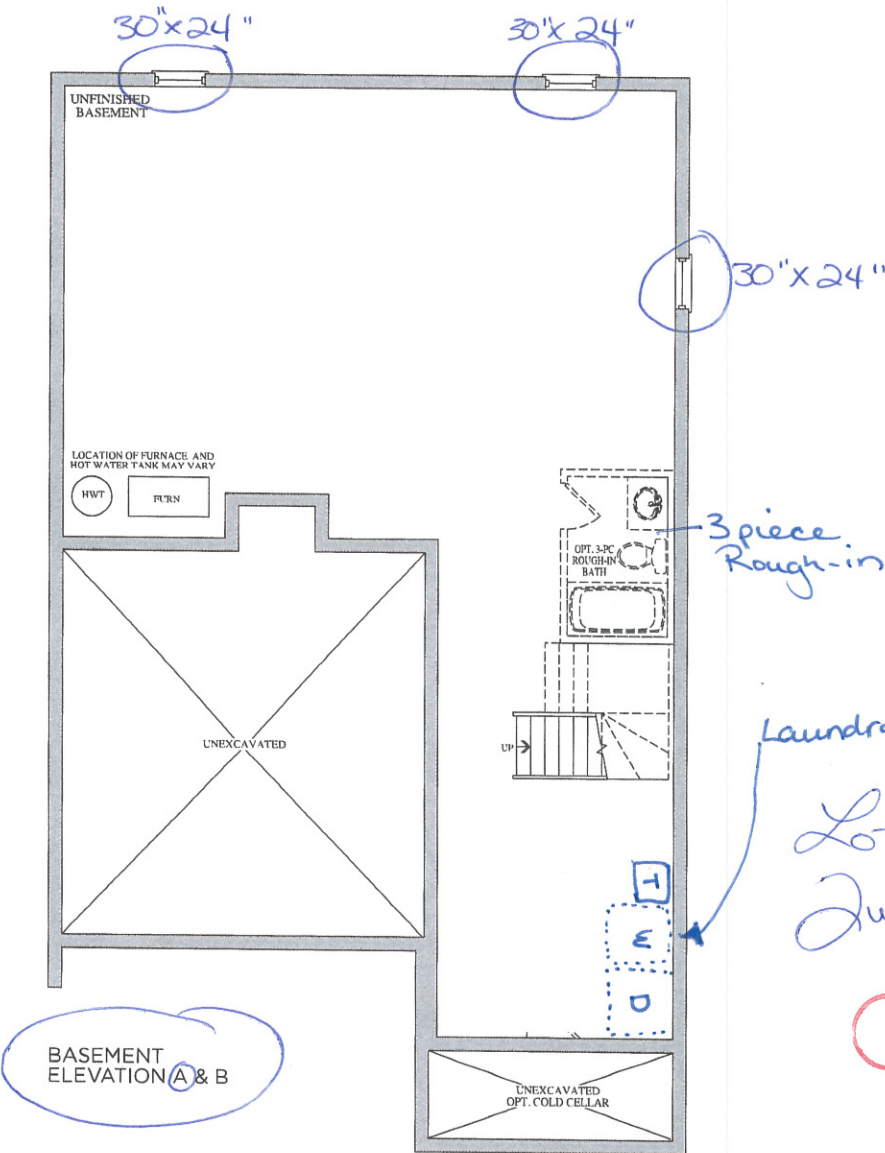

Prices, figures, illustrations, sizes, features and finishes are subject to change without notice. E.&O.E. Areas and dimensions are approximate and actual usable floor space may vary from the stated area. Layout may be reverse of the unit purchased. E. & O.E.



Stacey Carlete
Project Coordinator



Claude Azzopardi
Contracts Manager



Nancy Moore
Corporate Counsel

29
Lot #



38.1 The Bizet			
Elevation	Circle One	A	2189.6 Square Feet
		B	2186.7 Square Feet
Optional Layouts	Circle All that Apply		

38.2 The Ravel			
Elevation	Circle One	A	2271.5 Square Feet
		B	2273.7 Square Feet
Optional Layouts	Circle All that Apply		

38.3 The Haydn			
Elevation	Circle One	A	2394.5 Square Feet
		B	2388.3 Square Feet
Optional Layouts	Circle All that Apply		

38.4 The Vivaldi			
Elevation	Circle One	A	2459.1 Square Feet
		B	2459.1 Square Feet
Optional Layouts	Circle All that Apply		

38.5 The Handel			
Elevation	Circle One	A	2549.2 Square Feet
		B	2554.7 Square Feet
Optional Layouts	Circle All that Apply		

38.9 The Puccini			
Elevation	Circle One	A	3628.0 Square Feet
		B	3634.7 Square Feet
Optional Layouts	Circle All that Apply	GFA1	GROUND FLOOR Optional Alternative Layout

38.6 The Scarlatti			
Elevation	Circle One	A	3521.1 Square Feet
		B	3508.1 Square Feet
Optional Layouts	Circle All that Apply	GFA1	GROUND FLOOR Optional Alternative Layout

38.7 The Schubert			
Elevation	Circle One	A	3593.8 Square Feet
		B	3610.5 Square Feet
Optional Layouts	Circle All that Apply	GFA1	GROUND FLOOR Optional Alternative Layout
		SFA4	SECOND FLOOR Additional Bedroom

38.8 The Corelli			
Elevation	Circle One	A	3801.5 Square Feet
		B	3801.5 Square Feet
Optional Layouts	Circle All that Apply	GFA1	GROUND FLOOR Optional Alternative Layout
		SFA4	SECOND FLOOR Additional Bedroom w/ Ensuite

41.1 The Strauss			
Elevation	Circle One	A	2554.2 Square Feet
		B	2571.2 Square Feet
Optional Layouts	Circle All that Apply	SFA1	SECOND FLOOR Shower In Lieu of Tub B2

41.2 The Mozart			
Elevation	Circle One	A	2725.9 Square Feet
		B	2711.1 Square Feet
Optional Layouts	Circle All that Apply	SFA1	SECOND FLOOR Shower In Lieu of Tub B2

41.3 The Chopin			
Elevation	Circle One	A	2800.0 Square Feet
		B	2810.5 Square Feet
Optional Layouts	Circle All that Apply		

41.4 The Bach			
Elevation	Circle One	A	2894.4 Square Feet
		B	2894.5 Square Feet
Optional Layouts	Circle All that Apply		

41.5 The Brahms			
Elevation	Circle One	A	3948.1 Square Feet
		B	3949.1 Square Feet
Optional Layouts	Circle All that Apply	GFA1	GROUND FLOOR Optional Alternative Layout
		SFA2	SECOND FLOOR Shower In Lieu of Tub B4
		SFA3	SECOND FLOOR Optional Laundry Layout

41.6 The Verdi			
Elevation	Circle One	A	3862.5 Square Feet
		B	3866.4 Square Feet
Optional Layouts	Circle All that Apply	GFA1	GROUND FLOOR Optional Alternative Layout
		SFA3	SECOND FLOOR Optional Laundry Layout

June 1, 16

