

CONSTRUCTION SUMMARY

34 - 1 - 38-4 Elev.A VIVALDI

CENTRAL VAC AND WIRING

Inv.528	1 - TELEPHONE AND CABLE ROUGH-IN LOCATIONS
Line6375	Note:
31May16 / 20Sep16	
Inv.528	1 - FAMILY ROOM: INSTALL CONDUIT PIPE- FOR TELEVISION- MUST SPECIFY LOCATION AND TERMINATION POINT
Line6376	Note:
31May16 / 20Sep16	

ELECTRICAL

Inv.528	1 - FAMILY ROOM: INSTALL 110V WALL RECEPTACLE ON DEDICATED CIRCUIT -ABOVE FIREPLACE. SEE SKETCH
Line6377	Note:
31May16 / 20Sep16	
Inv.528	1 - TWIN ENSUITE: INSTALL SHOWER IN LIEU OF TUB- INCLUDES FRAMED GLASS SHOWER ENCLOSURE- TO GO IN TWIN ENSUITE INCLUDES SHOWER POT LIGHT
Line11548	Note:
31May16 / 20Sep16	

EXTERIOR COLOURS

Inv.528	1 - EXTERIOR COLOUR PACKAGE 7
Line11550	Note:
31May16 / 20Sep16	

FORMING

Inv.528	1 - SIDE DOOR- HOME TO EXTERIOR- AS PER PLAN AND GRADE PERMITTING
	GRADE DOES NOT PERMIT SIDE DOOR PER SITING AUGUST 2, 2016
Line6379	Note:
31May16 / 20Sep16	

FRAMING

Inv.528	1 - GARAGE: INSTALL MANDOOR - GARAGE TO HOUSE- AS PER PLAN AND GRADE PERMITTING
	GRADE DOES NOT PERMIT MANDOOR PER SITING AUGUST 2, 2016
Line6378	Note: GIVEN IN AGREEMENT OF PURCHASE AND SALE
31May16 / 20Sep16	
Inv.528	1 - TWIN ENSUITE: INSTALL SHOWER IN LIEU OF TUB- INCLUDES FRAMED GLASS SHOWER ENCLOSURE- TO GO IN TWIN ENSUITE
Line6380	Note:
31May16 / 20Sep16	

HVAC

Inv.528	1 - KITCHEN: INSTALL GAS LINE ROUGH - MAIN FLOOR - (2 STOREY MODELS) FOR STOVE
Line6381	Note:
31May16 / 20Sep16	

MISC.

CONSTRUCTION SUMMARY

34 - 1 - 38-4 Elev.A VIVALDI

Inv.528	1 - BONUS PACKAGE: \$7723.55 (INCLUDING TAXES) WORTH OF UPGRADES FROM GOLD PARK HOMES DÉCOR CENTRE IS BEING APPLIED TOWARD THE STRUCTURAL APPOINTMENT. PURCHASER HAS A REMAINING AMOUNT OF \$7276.45 (INCLUDING TAXES) TO BE USED TOWARD THE COLOUR APPOINTMENT
Line6383	Note:
31May16 / 20Sep16	
Inv.528	1 - Purchaser has attended a Structural appointment at the Decor Centre & has DECLINED any additional upgrades and accepts and acknowledges that there will be no further structural changes/additions/deletions to be made upon signing on May 31, 2016
Line6384	Note:
31May16 / 20Sep16	
Inv.528	1 - Purchasers are aware & accepts that ANY changes made to upgrades after signing this Purchasers Extra Form are subject to a minimum administration fee of \$500. PLUS a 10% holdback fee
Line6385	Note:
31May16 / 20Sep16	
Inv.528	1 - PURCHASER HAD \$15,000.00 IN DECOR DOLLARS FROM APS
Line11537	Note:
31May16 / 20Sep16	



PLUMBING

Inv.528	1 - KITCHEN: INSTALL ROUGH-IN - WATERLINE FOR FRIDGE
Line6382	Note:
31May16 / 20Sep16	
Inv.528	1 - TWIN ENSUITE: INSTALL SHOWER IN LIEU OF TUB- INCLUDES FRAMED GLASS SHOWER ENCLOSURE- TO GO IN TWIN ENSUITE
Line11549	Note:
31May16 / 20Sep16	

Telephone — (T)
Cable — (C)
Electrical — (E)

The
Vivaldi
38' SERIES

Elevation A • 2,518 sq.ft. | Elevation B • 2,518 sq.ft.

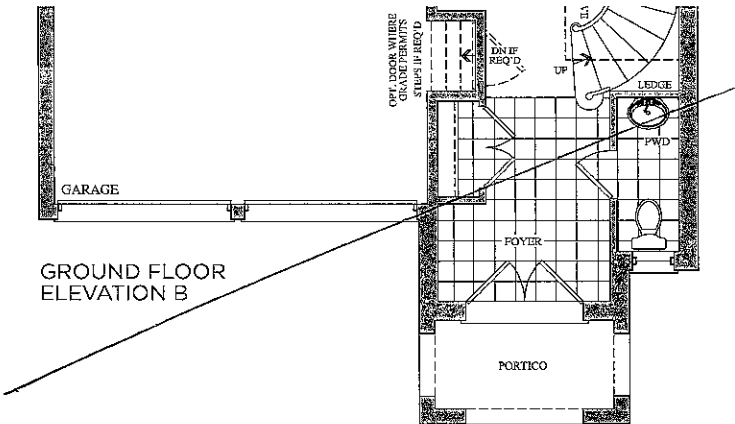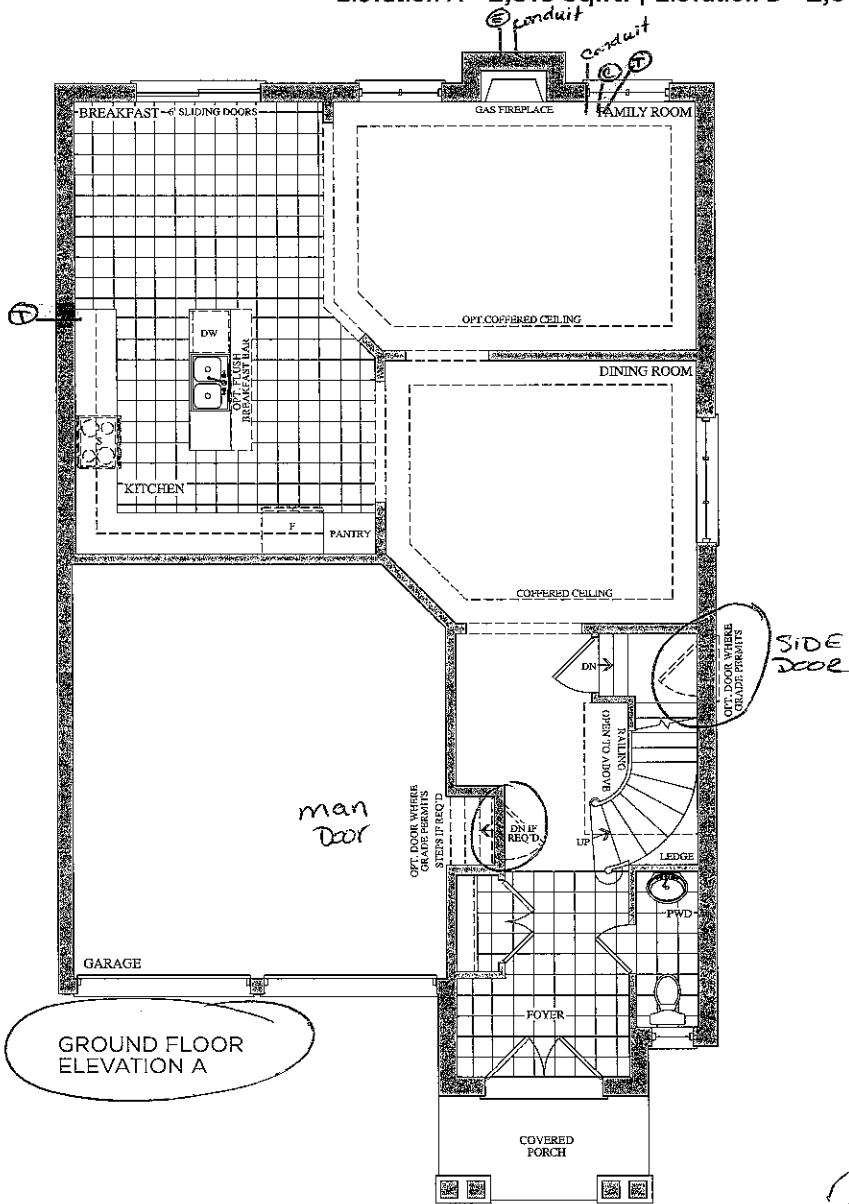


Lot 34
May 31, 16
NS


Prices, figures, illustrations, sizes, features and finishes are subject to change without notice. E.&O.E. Areas and dimensions are approximate and actual usable floor space may vary from the stated area. Layout may be reverse of the unit purchased. E. & O.E.

The
Vivaldi
38' SERIES

Elevation A • 2,518 sq.ft. | Elevation B • 2,518 sq.ft.

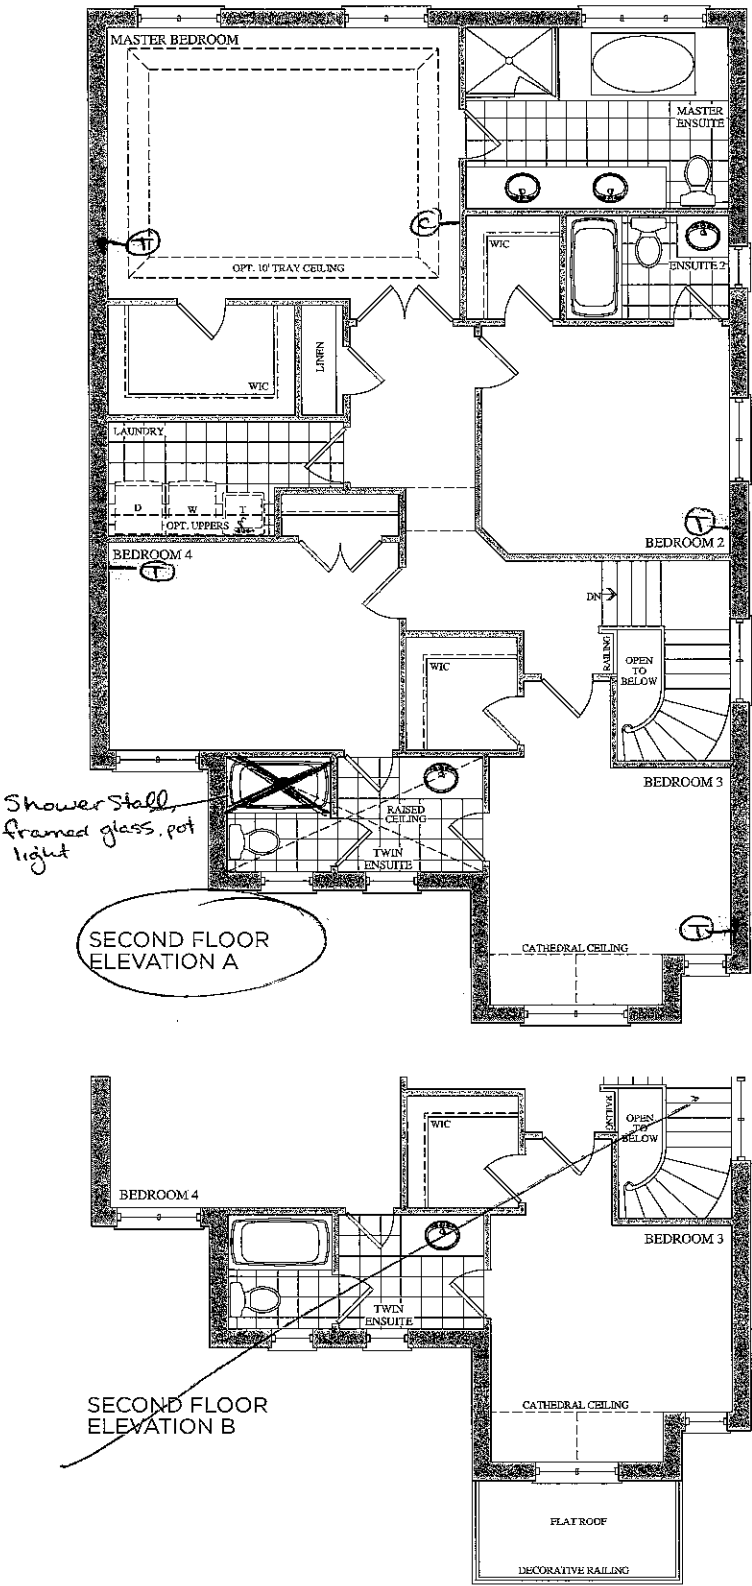

Prices, figures, illustrations, sizes, features and finishes are subject to change without notice. E.&O.E. Areas and dimensions are approximate and actual usable floor space may vary from the stated area. Layout may be reverse of the unit purchased. E. & O.E.

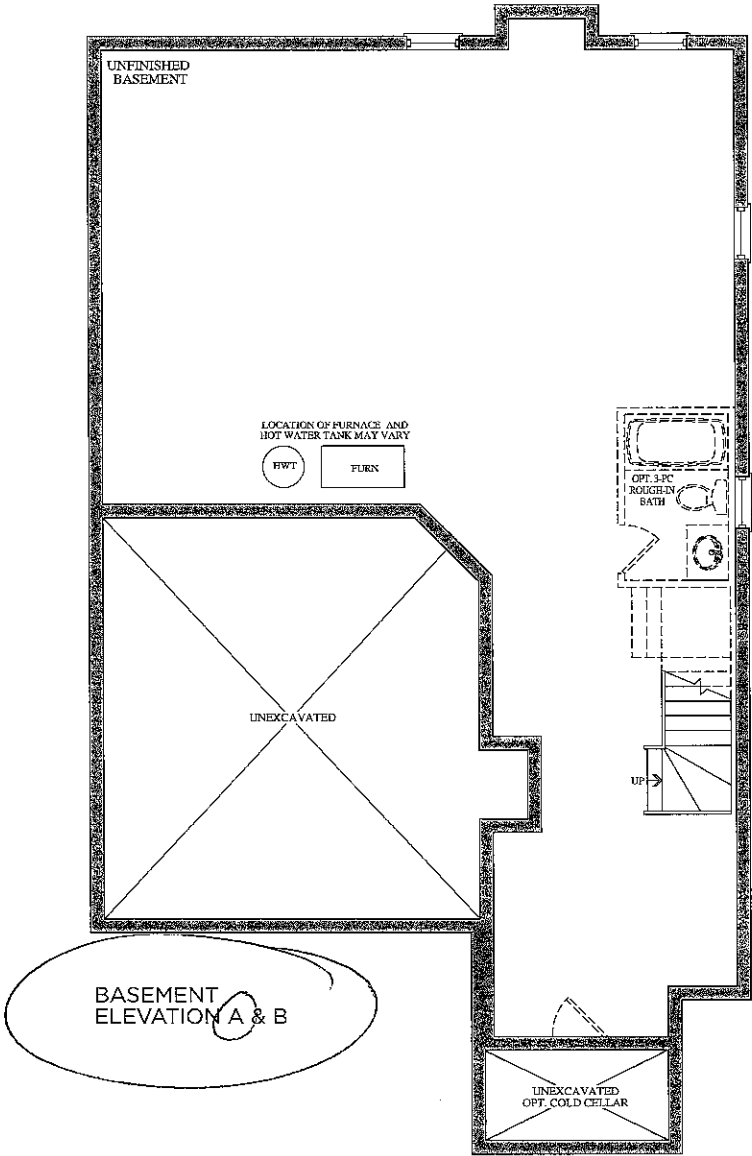

Lot 34
May 31, 16

NS

Prices, figures, illustrations, sizes, features and finishes are subject to change without notice. E.&O.E. Areas and dimensions are approximate and actual usable floor space may vary from the stated area. Layout may be reverse of the unit purchased. E. & O.E.