

Brampton Encore - 89 - 1 - 41-6 Elev.B VERDI OPT - GFA1

CENTRAL VAC AND WIRING

Inv.476	1 - FAMILY ROOM: INSTALL CONDUIT PIPE- FOR TELEVISION- MUST SPECIFY LOCATION AND TERMINATION POINT
Line5790	Note:
2May16 / 26Jul16	
Inv.476	1 - BEDROOM #2: INSTALL RG 6 ROUGH-IN IN BEDROOM #2. SEE SKETCH
Line5746	Note:
2May16 / 26Jul16	

ELECTRICAL

Inv.476	1 - TELEPHONE AND CABLE ROUGH-IN LOCATIONS
Line5745	Note:
2May16 / 26Jul16	
Inv.476	1 - KITCHEN: INSTALL 110V WALL RECEPTACLE ON DEDICATED CIRCUIT - FOR MICROWAVE - MICROWAVE NOT INCLUDED. TO GO AT THE END OF THE STANDARD CABINETS. SEE SKETCH. PURCHASER WILL BUY ADDITIONAL UPPERS AT THE TIME OF COLOUR APPOINTMENT
Line5747	Note:
2May16 / 26Jul16	
Inv.476	1 - LIVING ROOM: INSTALL ADDITIONAL STANDARD FIXTURE WITH SWITCH - IN LIVING ROOM. IN ADDITION TO BUILDER'S STANDARD SWITCH CONTROLLED RECEPTICAL
Line5748	Note:
2May16 / 26Jul16	
Inv.476	1 - FAMILY ROOM: INSTALL 110V WALL RECEPTACLE ON DEDICATED CIRCUIT - ABOVE FIREPLACE. SEE SKETCH
Line5791	Note:
2May16 / 26Jul16	

EXTERIOR COLOURS

Inv.476	1 - EXTERIOR COLOUR PACKAGE 6 ✓
Line9312	Note:
2May16 / 26Jul16	

FORMING

Inv.476	1 - EXTERIOR-INSTALL SIDE DOOR- HOME TO EXTERIOR- AS PER PLAN AND GRADE PERMITTING
Line5749	Note:
2May16 / 26Jul16	
Inv.476	1 - EXTERIOR/BACK YARD: INSTALL SIDE DOOR- HOME TO EXTERIOR- AS PER PLAN AND GRADE PERMITTING
Line5750	Note:
2May16 / 26Jul16	

INTERIOR TRIM AND DOORS

Inv.476	4 - MAIN FLOOR: INSTALL FOUR (4) STANDARD DOORS EXTENDED HEIGHT 96" (PRICE PER DOOR) MAIN FLOOR 3 STOREY MODELS - FOR CLOSETS, POWDER ROOM, LAUNDRY ROOM. SEE SKETCH
Line5752	Note:
2May16 / 26Jul16	
Inv.476	1 - DEN: INSTALL STANDARD FRENCH DOOR EXTENDED HEIGHT 96" (PRICE PER DOOR) MAIN FLOOR 3 STOREY MODELS -AT DEN
Line5753	Note:
2May16 / 26Jul16	

Brampton Encore - 89 - 1 - 41-6 Elev.B VERDI OPT - GFA1

MISC.

Inv.476	1 - BONUS PACKAGE: \$10,000.00 (INCLUDING TAXES) WORTH OF UPGRADES FROM GOLD PARK HOMES DÉCOR CENTRE IS BEING APPLIED TOWARD THE STRUCTURAL APPOINTMENT.
Line5792	Note:
2May16 / 26Jul16	
Inv.476	1 - Purchasers are aware & accepts that ANY changes made to upgrades after signing this Purchasers Extra Form are subject to a minimum administration fee of \$500. PLUS a 10% holdback fee
Line5794	Note:
2May16 / 26Jul16	
Inv.476	1 - Purchaser has attended a Structural appointment at the Decor Centre & has DECLINED any additional upgrades and accepts and acknowledges that there will be no further structural changes/additions/deletions to be made upon signing on May 3, 2016.
Line5793	Note:
2May16 / 26Jul16	

PLUMBING

Inv.476	1 - KITCHEN: INSTALL ROUGH-IN - WATERLINE FOR FRIDGE
Line5754	Note:
2May16 / 26Jul16	
Inv.476	1 - BASEMENT: INSTALL ROUGH-IN - 3PC BASEMENT ROUGH-IN, AS PER PLAN
Line5755	Note:
2May16 / 26Jul16	
Inv.476	1 - GARAGE: INSTALL HOSE BIB - STANDARD TO UPGRADED WITH HOT AND COLD WATER VALVE FOR GARAGE
Line5756	Note: HOSE BIB AT REAR OF HOUSE TO BE STANDARD
2May16 / 26Jul16	

WINDOWS - BASEMENT

Inv.476	3 - BASEMENT: INSTALL THREE (3) BASEMENT WINDOWS - UPGRADE EXISTING BASEMENT WINDOW TO 30 INCH X 24 INCH - MAY REQUIRE INSTALLATION OF WINDOW WELL
Line5751	Note:
2May16 / 26Jul16	


WINDOWS AND DOORS

Inv.476	1 - MAN DOOR GARAGE TO HOUSE - OPTIONAL - IF GRADE PERMITS
Line9315	Note: AS PER APS BONUS PACKAGE
2May16 / 26Jul16	


Telephone — (T)
cable — (C)
Electrical — (E)

The
Verdi
41' SERIES

Elevation A • 3,940 sq.ft. | Elevation B • 3,940 sq.ft.

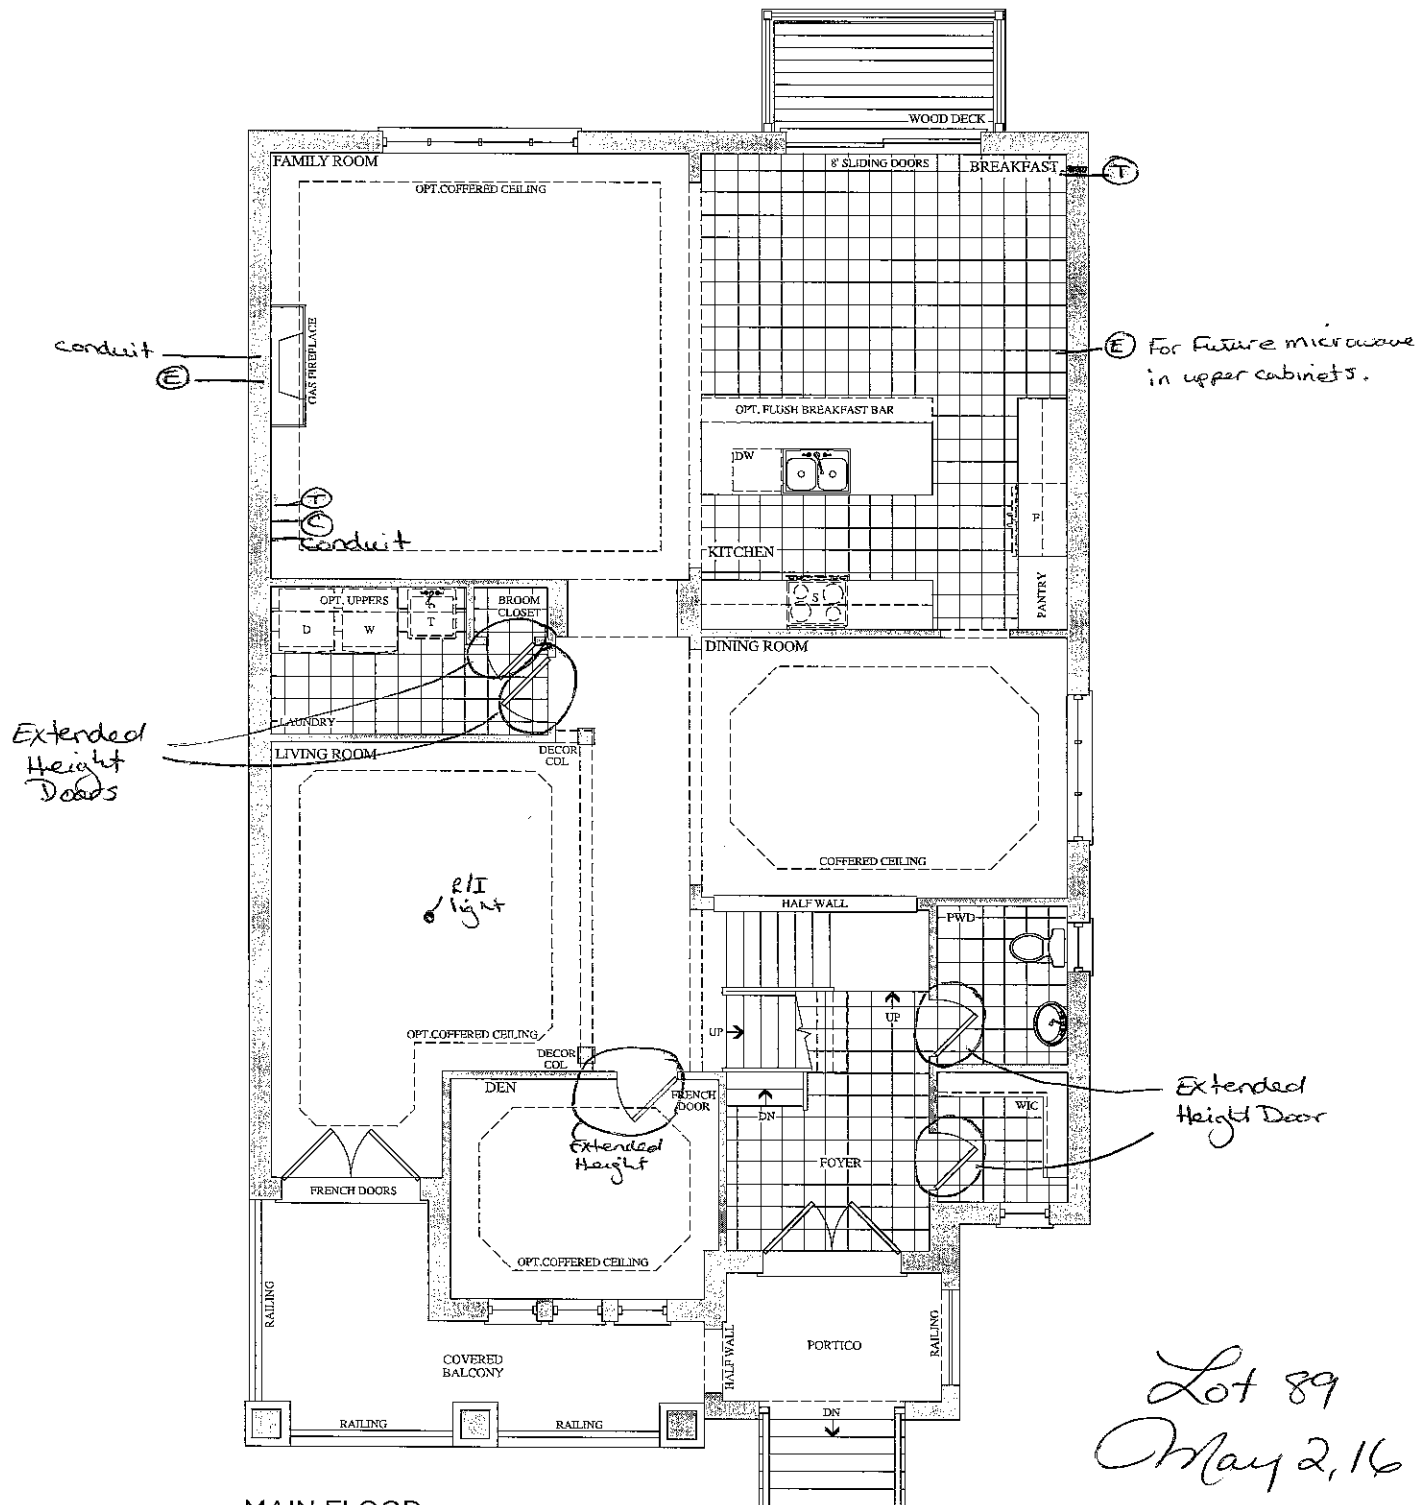

MAIN FLOOR
ELEVATION A

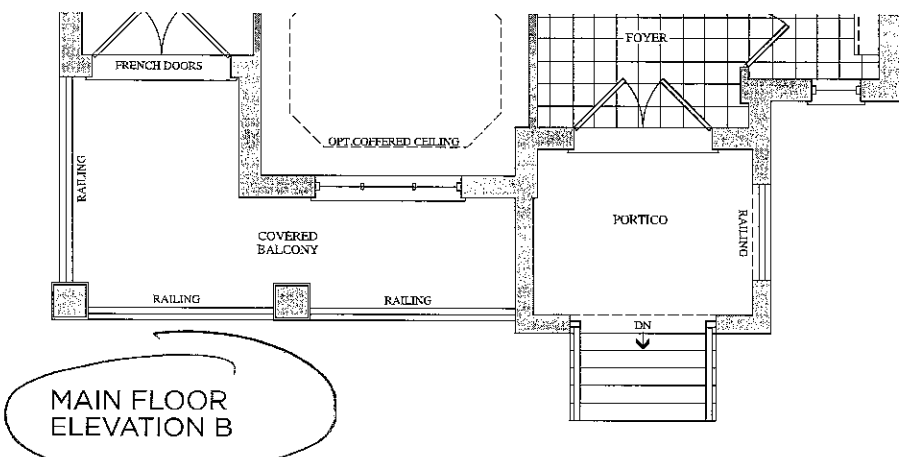

MAIN FLOOR
ELEVATION B


Lot 89
May 2, 16

Prices, figures, illustrations, sizes, features and finishes are subject to change without notice. E.&O.E. Areas and dimensions are approximate and actual usable floor space may vary from the stated area. Layout may be reverse of the unit purchased. E. & O.E.

Telephone — (T)
Cable — (C)
Electrical — (E)


The
Verdi
41' SERIES

Elevation A • 3,940 sq.ft. | Elevation B • 3,940 sq.ft.


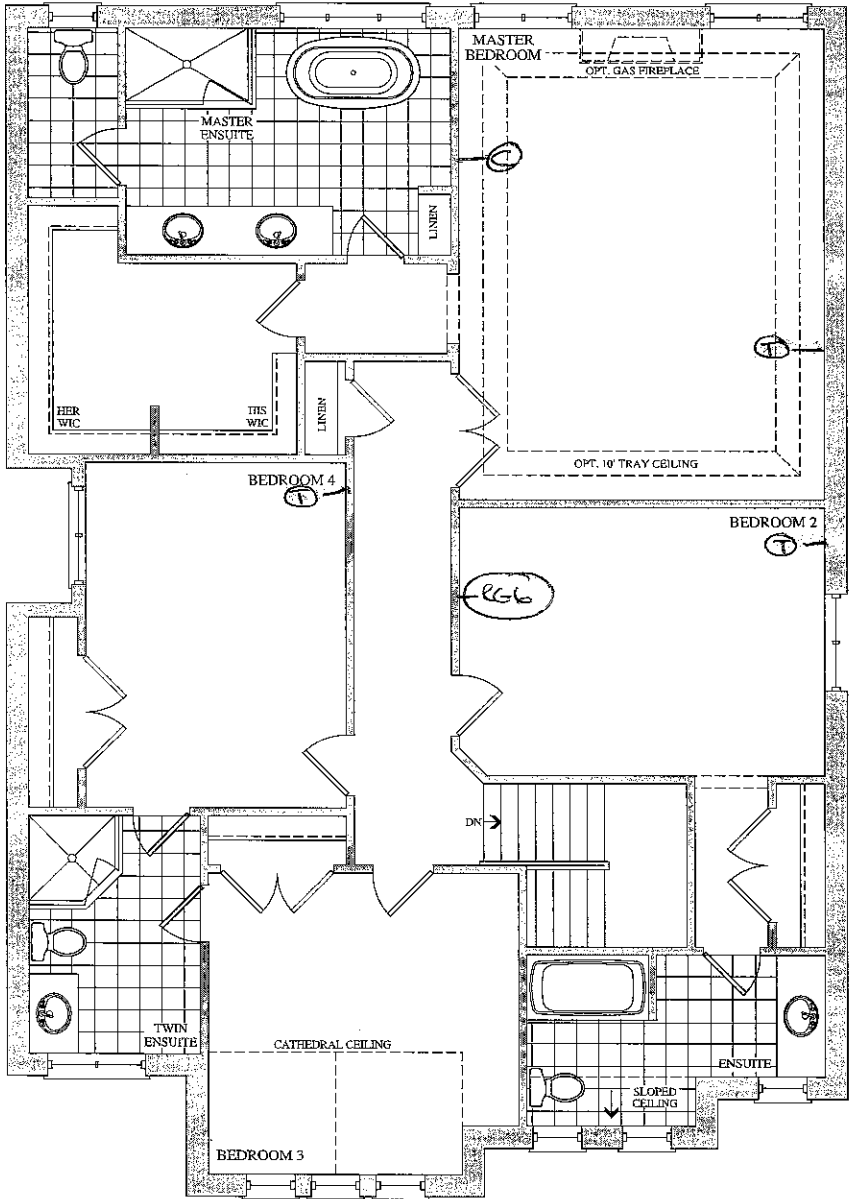


SECOND FLOOR
ELEVATION A

Lot 89
May 2, 16

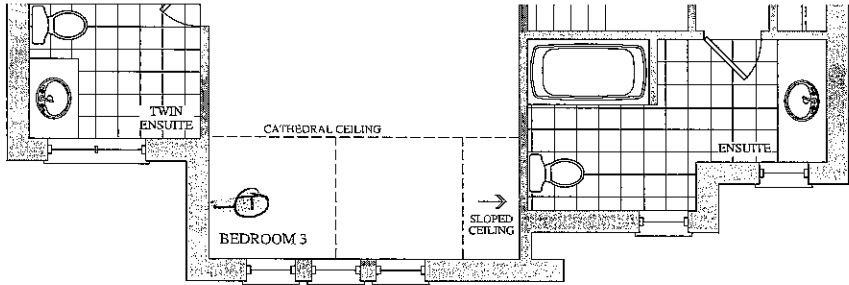

SECOND FLOOR
ELEVATION B

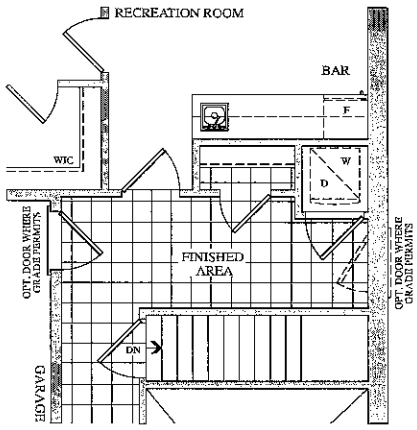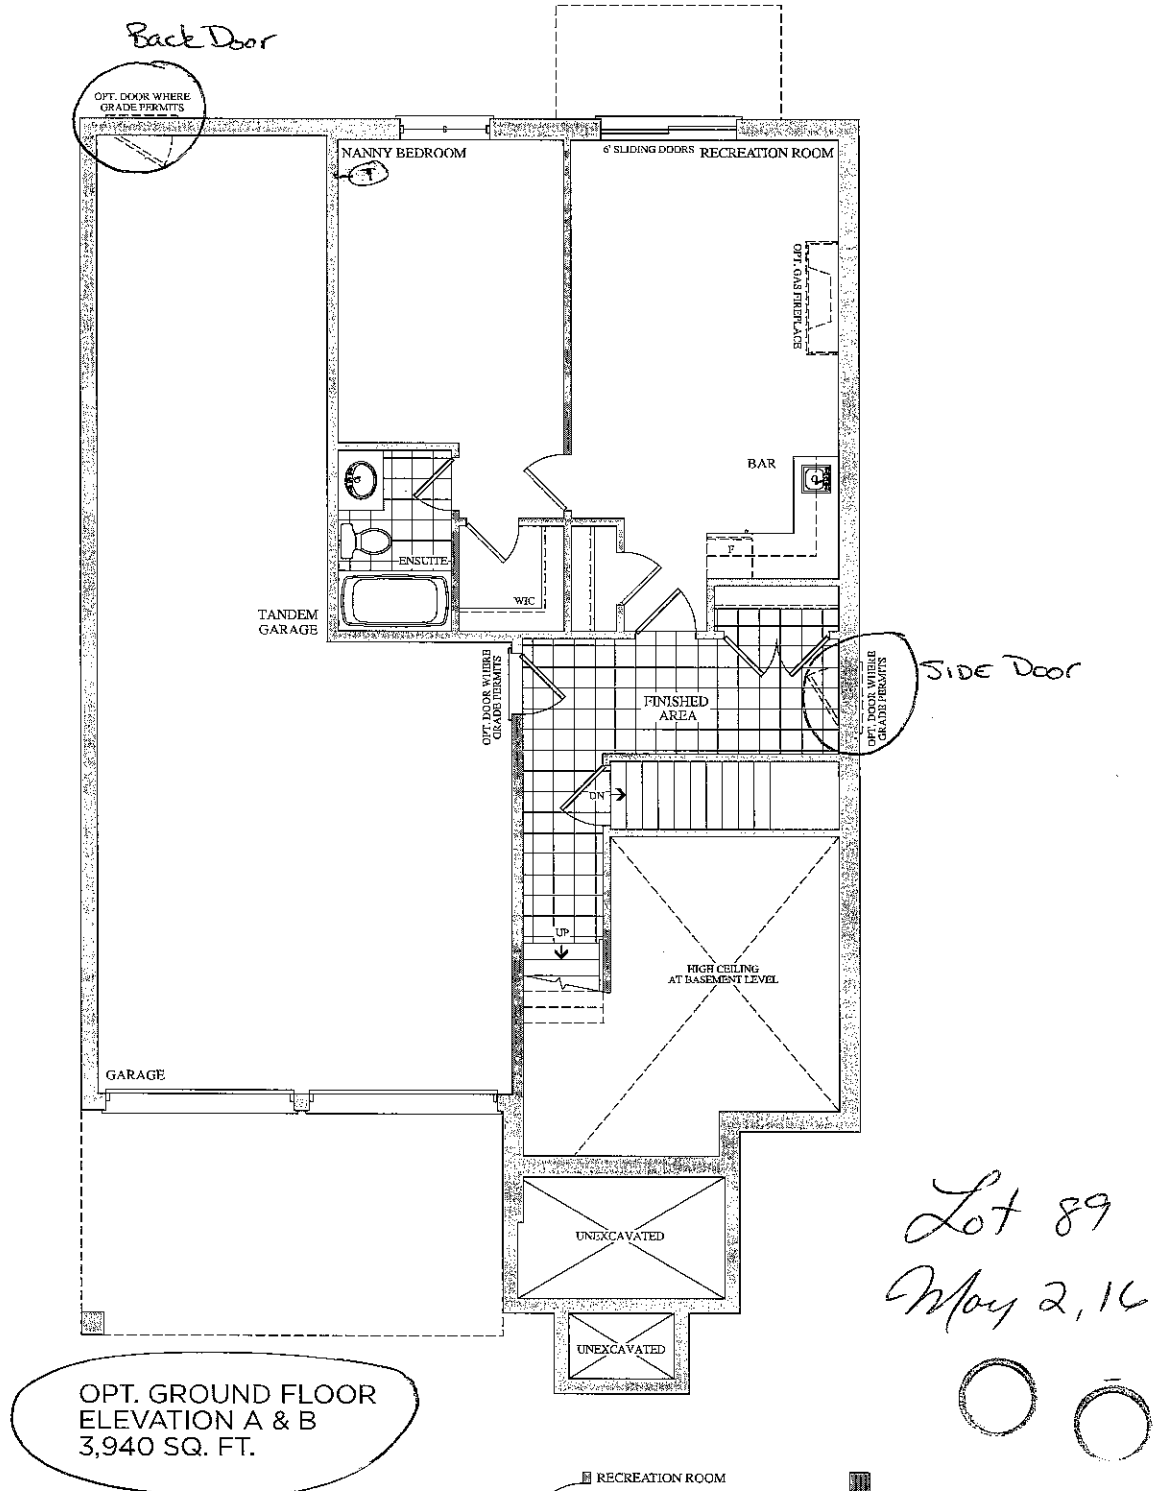


OPT. GROUND FLOOR
ELEVATION A & B
OPT. LAUNDRY

BSMNT WINDOWS

3 x 30" x 24"

Elevation A • 3,940 sq.ft. | Elevation B • 3,940 sq.ft.

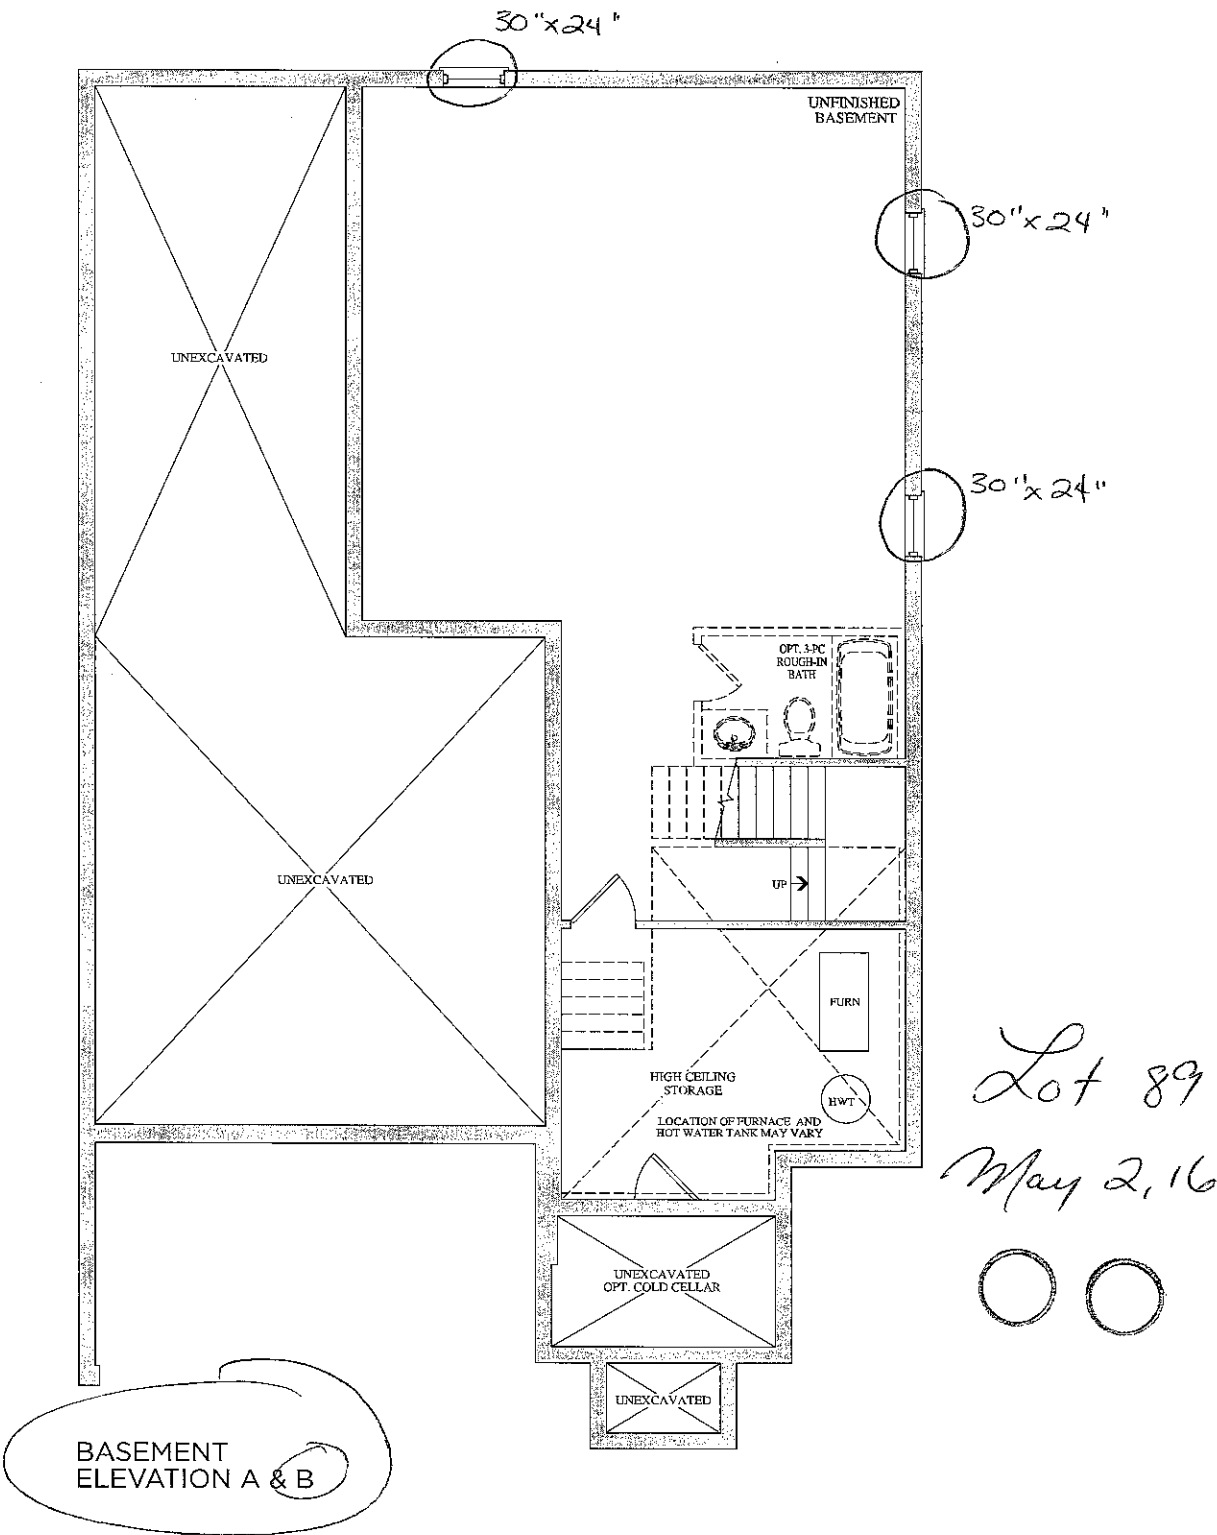



Stacey Carlete
Project Coordinator



Claude Azzopardi
Contracts Manager



Nancy Mc
Corporate C

89
Lot #



38.1 The Bizet			
Elevation	Circle One	A	2189.6 Square Feet
		B	2186.7 Square Feet
Optional Layouts	Circle All that Apply		

38.2 The Ravel			
Elevation	Circle One	A	2271.5 Square Feet
		B	2273.7 Square Feet
Optional Layouts	Circle All that Apply		

38.3 The Haydn			
Elevation	Circle One	A	2394.5 Square Feet
		B	2388.3 Square Feet
Optional Layouts	Circle All that Apply		

38.4 The Vivaldi			
Elevation	Circle One	A	2459.1 Square Feet
		B	2459.1 Square Feet
Optional Layouts	Circle All that Apply		

38.5 The Handel			
Elevation	Circle One	A	2549.2 Square Feet
		B	2554.7 Square Feet
Optional Layouts	Circle All that Apply		

38.9 The Puccini			
Elevation	Circle One	A	3628.0 Square Feet
		B	3634.7 Square Feet
Optional Layouts	Circle All that Apply	GFA1	GROUND FLOOR Optional Alternative Layout

38.6 The Scarlatti			
Elevation	Circle One	A	3521.1 Square Feet
		B	3508.1 Square Feet
Optional Layouts	Circle All that Apply	GFA1	GROUND FLOOR Optional Alternative Layout

38.7 The Schubert			
Elevation	Circle One	A	3593.8 Square Feet
		B	3610.5 Square Feet
Optional Layouts	Circle All that Apply	GFA1	GROUND FLOOR Optional Alternative Layout
		SFA4	SECOND FLOOR Additional Bedroom

38.8 The Corelli			
Elevation	Circle One	A	3801.5 Square Feet
		B	3801.5 Square Feet
Optional Layouts	Circle All that Apply	GFA1	GROUND FLOOR Optional Alternative Layout
		SFA4	SECOND FLOOR Additional Bedroom w/ Ensuite

41.1 The Strauss			
Elevation	Circle One	A	2554.2 Square Feet
		B	2571.2 Square Feet
Optional Layouts	Circle All that Apply	SFA1	SECOND FLOOR Shower in Lieu of Tub B2

41.2 The Mozart			
Elevation	Circle One	A	2725.9 Square Feet
		B	2711.1 Square Feet
Optional Layouts	Circle All that Apply	SFA1	SECOND FLOOR Shower in Lieu of Tub B2

41.3 The Chopin			
Elevation	Circle One	A	2800.0 Square Feet
		B	2810.5 Square Feet
Optional Layouts	Circle All that Apply		

41.4 The Bach			
Elevation	Circle One	A	2894.4 Square Feet
		B	2894.5 Square Feet
Optional Layouts	Circle All that Apply		

41.5 The Brahms			
Elevation	Circle One	A	3948.1 Square Feet
		B	3949.1 Square Feet
Optional Layouts	Circle All that Apply	GFA1	GROUND FLOOR Optional Alternative Layout
		SFA2	SECOND FLOOR Shower in Lieu of Tub B4
		SFA3	SECOND FLOOR Optional Laundry Layout

41.6 The Verdi			
Elevation	Circle One	A	3862.5 Square Feet
		B	3866.4 Square Feet
Optional Layouts	Circle All that Apply	GFA1	GROUND FLOOR Optional Alternative Layout
		SFA3	SECOND FLOOR Optional Laundry Layout

May 2, 16