

CONSTRUCTION SUMMARY

119 - 1 - 38-3 Elev.A HAYDN

CENTRAL VAC AND WIRING

Inv.555	1 - TELEPHONE AND CABLE ROUGH-IN LOCATIONS
Line7309	Note:
9Jun16 / 26Sep16	
Inv.555	1 - MASTER BEDROOM: INSTALL CAT 6 WIRING - UPGRADE AN OUTLET TO CAT 6- IN MASTER BEDROOM, SEE SKETCH
Line7310	Note:
9Jun16 / 26Sep16	
Inv.555	1 - KITCHEN: INSTALL VAC PAN UNDER KITCHEN SINK
Line7319	Note:
9Jun16 / 26Sep16	

EXTERIOR COLOURS

Inv.555	1 - EXTERIOR COLOUR PACKAGE 8
Line12000	Note:
9Jun16 / 26Sep16	

FORMING

Inv.555	1 - EXTERIOR: INSTALL SIDE DOOR- HOME TO EXTERIOR- AS PER PLAN AND GRADE PERMITTING
Line7312	Note: GRADE PERMITS PER SITING DATED AUGUST 2, 2016
9Jun16 / 26Sep16	

FRAMING

Inv.555	1 - GARAGE: ISNTALL MANDOOR - GARAGE TO HOUSE- AS PER PLAN AND GRADE PERMITING
Line7311	Note: GIVEN IN AGREEMENT OF PURCHASE AND SALE
9Jun16 / 26Sep16 GRADE PERMITS PER SITING DATED AUGUST 2, 2016	
Inv.555	1 - FAMILY ROOM: INSTALL OPTIONAL COFFERED CEILING - FAMILY ROOM (PER ROOM AS PER PLAN)
Line7313	Note:
9Jun16 / 26Sep16	

HVAC

Inv.555	1 - KITCHEN: INSTALL GAS LINE ROUGH - MAIN FLOOR FOR STOVE
Line7315	Note:
9Jun16 / 26Sep16	

KITCHEN AND BATH CABINETRY

Inv.555	1 - KITCHEN: INSTALL VAC PAN UNDER KITCHEN SINK
Line11999	Note:
9Jun16 / 26Sep16	

MISC.

Inv.555	1 - BONUS PACKAGE: \$10305.60 (INCLUDING TAXES) WORTH OF UPGRADES FROM GOLD PARK HOMES DÉCOR CENTRE IS BEING APPLIED TOWARD THE STRUCTURAL APPOINTMENT. PURCHASER HAS A REMAINING AMOUNT OF \$4694.40 (INCLUDING TAXES) TO BE USED TOWARD THE COLOUR APPOINTMENT
Line7320	Note:
9Jun16 / 26Sep16	

CONSTRUCTION SUMMARY

119 - 1 - 38-3 Elev.A HAYDN

Inv.555	1 - Purchaser has attended a Structural appointment at the Decor Centre & has DECLINED any additional upgrades and accepts and acknowledges that there will be no further structural changes/additions/deletions to be made upon signing on June 21, 2016
Line7321	Note:
9Jun16 / 26Sep16	
Inv.555	1 - Purchasers are aware & accepts that ANY changes made to upgrades after signing this Purchasers Extra Form are subject to a minimum administration fee of \$500. PLUS a 10% holdback fee
Line7322	Note:
9Jun16 / 26Sep16	

PLUMBING

Inv.555	1 - KITCHEN: INSTALL: INSTALL ROUGH-IN - WATERLINE FOR FRIDGE
Line7316	Note:
9Jun16 / 26Sep16	
Inv.555	1 - BASEMENT: INSTALL ROUGH-IN - 3PC BASEMENT ROUGH-IN, AS PER PLAN
Line7317	Note:
9Jun16 / 26Sep16	
Inv.555	1 - BACK YARD: INSTALL HOSE BIB - STANDARD TO UPGRADED WITH HOT AND COLD WATER VALVE
Line7318	Note: GARAGE HOSE BIB TO REMAIN STANDARD
9Jun16 / 26Sep16	



WINDOWS - BASEMENT

Inv.555	1 - BASEMENT: INSTALL ONE (X1) BASEMENT WINDOWS - UPGRADE EXISTING BASEMENT WINDOW TO 30 INCH X 24 INCH - MAY REQUIRE INSTALLATION OF WINDOW WELL. SEE SKETCH
Line7314	Note:
9Jun16 / 26Sep16	

The Haydn

38' SERIES

Elevation A • 2,454 sq.ft. | Elevation B • 2,448 sq.ft.

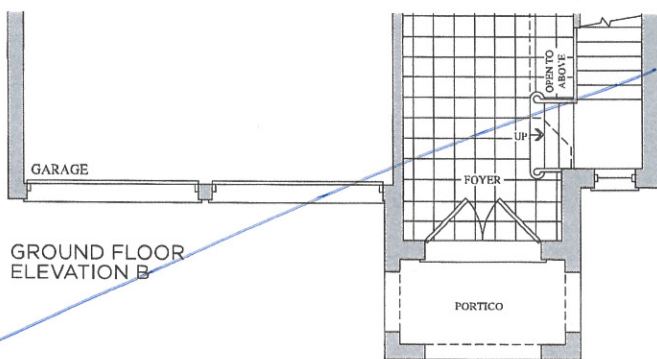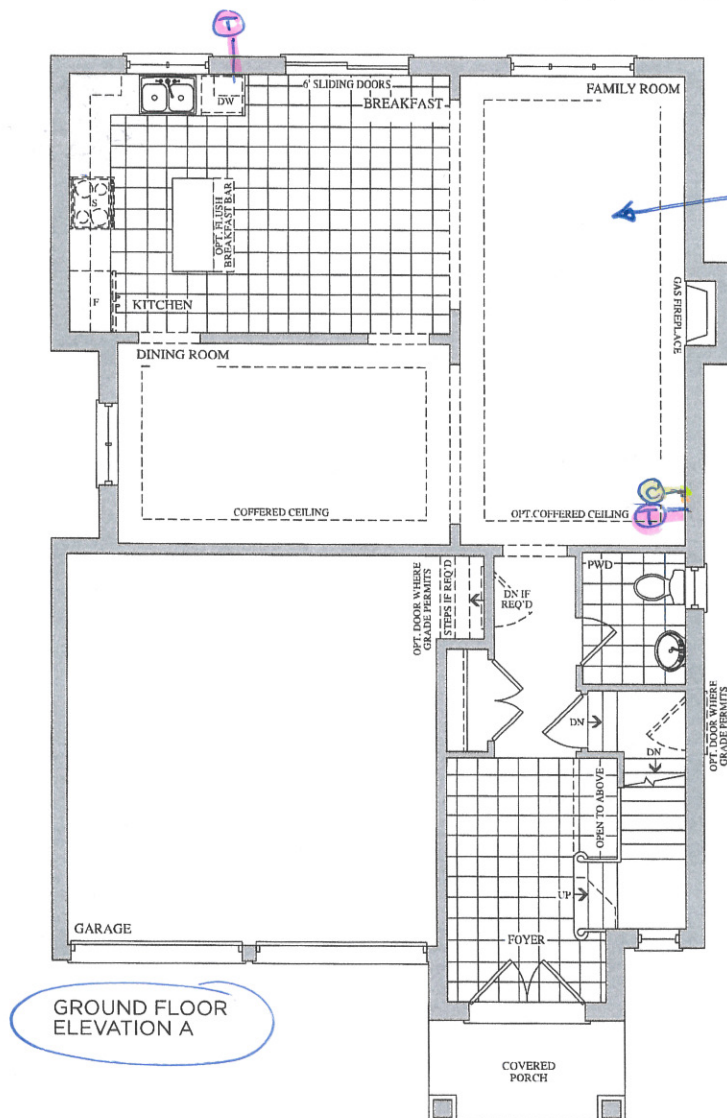


Prices, figures, illustrations sizes features and finishes are subject to change without notice. E.&O.E. Areas and dimensions are approximate and actual usable floor space may vary from the stated area. Layout may be reverse of the unit purchased. E. & O.E.


GOLDPARK
HOMES

The
Haydn
38' SERIES

Elevation A • 2,454 sq.ft. | Elevation B • 2,448 sq.ft.

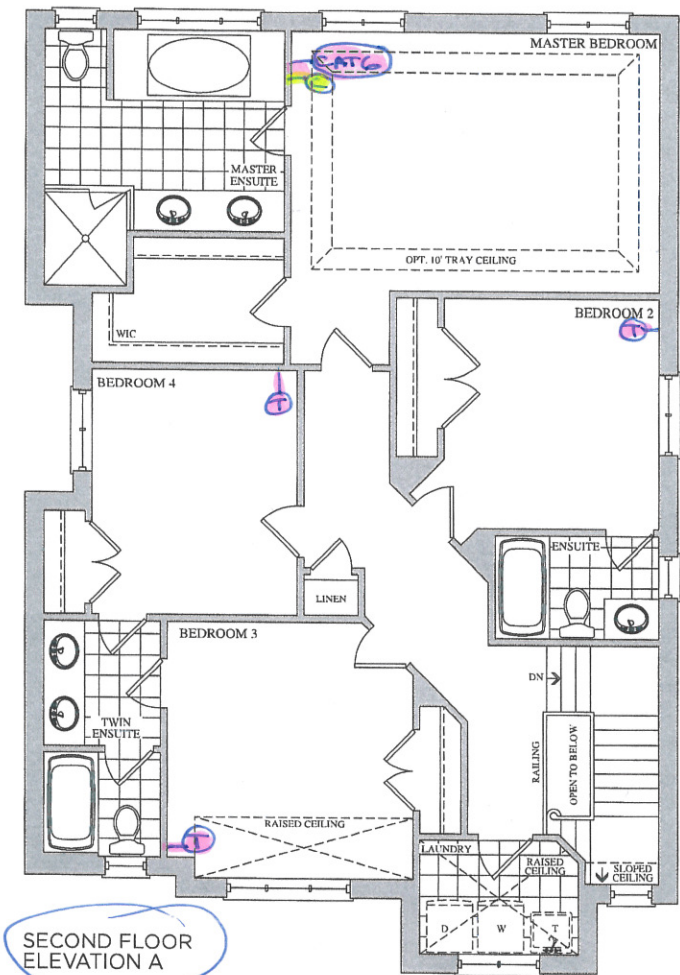


SECOND FLOOR
ELEVATION A

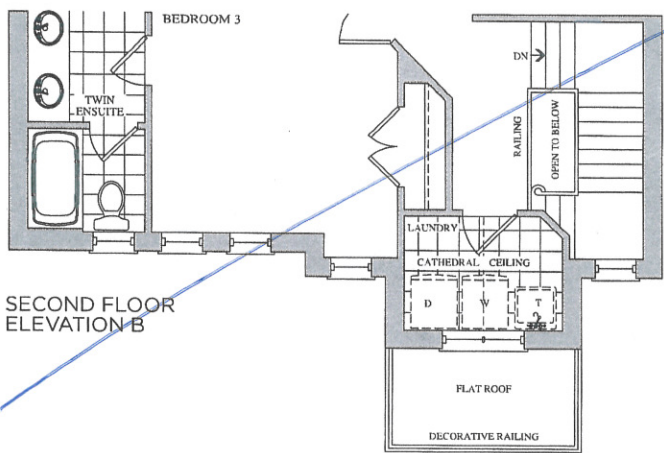

SECOND FLOOR
ELEVATION B

Prices, figures, illustrations, sizes, features and finishes are subject to change without notice. E.&O.E. Areas and dimensions are approximate and actual usable floor space may vary from the stated area. Layout may be reverse of the unit purchased. E. & O.E.

BSMNT WINDOWS
1 x 30"x24"

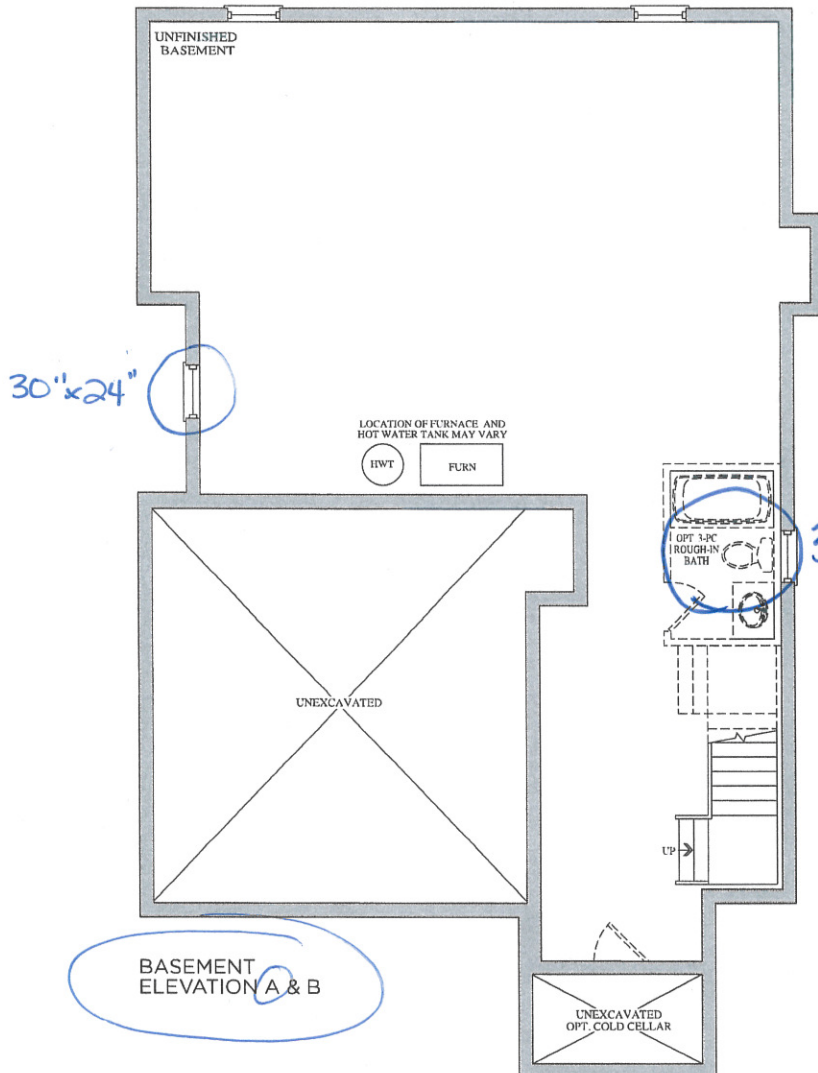

Lot 119
June 21, 16





Stacey Carlete
Project Coordinator



Claude Azzopardi
Contracts Manager



Nancy Moore
Corporate Counsel

119
Lot #



encore
BRAMPTON

Model	38.1 The Bizet		
Elevation	Circle One	A	2189.6 Square Feet
		B	2186.7 Square Feet
Optional Layouts	Circle All that Apply		

Model	38.2 The Ravel		
Elevation	Circle One	A	2271.5 Square Feet
		B	2273.7 Square Feet
Optional Layouts	Circle All that Apply		

Model	38.3 The Haydn		
Elevation	Circle One	A	2394.5 Square Feet
		B	2388.3 Square Feet
Optional Layouts	Circle All that Apply		

Model	38.4 The Vivaldi		
Elevation	Circle One	A	2459.1 Square Feet
		B	2459.1 Square Feet
Optional Layouts	Circle All that Apply		

Model	38.5 The Handel		
Elevation	Circle One	A	2549.2 Square Feet
		B	2554.7 Square Feet
Optional Layouts	Circle All that Apply		

Model	38.9 The Puccini		
Elevation	Circle One	A	3628.0 Square Feet
		B	3634.7 Square Feet
Optional Layouts	Circle All that Apply	GFA1	GROUND FLOOR Optional Alternative Layout

Model	38.6 The Scarlatti		
Elevation	Circle One	A	3521.1 Square Feet
		B	3508.1 Square Feet
Optional Layouts	Circle All that Apply	GFA1	GROUND FLOOR Optional Alternative Layout

Model	38.7 The Schubert		
Elevation	Circle One	A	3593.8 Square Feet
		B	3610.5 Square Feet
Optional Layouts	Circle All that Apply	GFA1	GROUND FLOOR Optional Alternative Layout
		SFA4	SECOND FLOOR Additional Bedroom
Optional Layouts	Circle All that Apply		

Model	38.8 The Corelli		
Elevation	Circle One	A	3801.5 Square Feet
		B	3801.5 Square Feet
Optional Layouts	Circle All that Apply	GFA1	GROUND FLOOR Optional Alternative Layout
		SFA4	SECOND FLOOR Additional Bedroom w/ Ensuite
Optional Layouts	Circle All that Apply		

Model	41.1 The Strauss		
Elevation	Circle One	A	2554.2 Square Feet
		B	2571.2 Square Feet
Optional Layouts	Circle All that Apply	SFA1	SECOND FLOOR Shower In Lieu of Tub B2

Model	41.2 The Mozart		
Elevation	Circle One	A	2725.9 Square Feet
		B	2711.1 Square Feet
Optional Layouts	Circle All that Apply	SFA1	SECOND FLOOR Shower In Lieu of Tub B2

Model	41.3 The Chopin		
Elevation	Circle One	A	2800.0 Square Feet
		B	2810.5 Square Feet
Optional Layouts	Circle All that Apply		

Model	41.4 The Bach		
Elevation	Circle One	A	2894.4 Square Feet
		B	2894.5 Square Feet
Optional Layouts	Circle All that Apply		

Model	41.5 The Brahms		
Elevation	Circle One	A	3948.1 Square Feet
		B	3949.1 Square Feet
Optional Layouts	Circle All that Apply	GFA1	GROUND FLOOR Optional Alternative Layout
		SFA2	SECOND FLOOR Shower In Lieu of Tub B4
Optional Layouts	Circle All that Apply	SFA3	SECOND FLOOR Optional Laundry Layout

Model	41.6 The Verdi		
Elevation	Circle One	A	3862.5 Square Feet
		B	3866.4 Square Feet
Optional Layouts	Circle All that Apply	GFA1	GROUND FLOOR Optional Alternative Layout
		SFA3	SECOND FLOOR Optional Laundry Layout
Optional Layouts	Circle All that Apply		

June 21, 16

