

CONSTRUCTION SUMMARY

120 - 1 - 38-4 Elev.B VIVALDI

CENTRAL VAC AND WIRING

Inv.606	1 - TELEPHONE AND CABLE ROUGH-IN LOCATIONS.
Line7437	Note:
27Jun16 / 27Sep16	

CERAMIC

Inv.606	1 - MASTER ENSUITE: DELETE THREE FEET OF THE MASTER ENSUITE VANITY TO ACCOMODATE A BIDET. VANITY TO STILL HAVE DOUBLE SINK. SEE SKETCH
Line12015	Note:
27Jun16 / 27Sep16	

ELECTRICAL

Inv.606	1 - KITCHEN: INSTALL KITCHEN CABINET STRIP VALANCE LIGHTS (UNDER CABINETS) - ROUGH - IN - DOES NOT INCLUDE (AND REQUIRES) KITCHEN UPGRADE PRICING
Line7438	Note:
27Jun16 / 27Sep16	

Inv.606	1 - BASEMENT: INSTALL 200 AMP ELECTRICAL SERVICE
Line7446	Note:
27Jun16 / 27Sep16	

EXTERIOR COLOURS

Inv.606	1 - EXTERIOR COLOUR PACKAGE 7
Line12012	Note:
27Jun16 / 27Sep16	

FORMING

Inv.606	1 - EXTERIOR: SIDE DOOR- HOME TO EXTERIOR- AS PER PLAN AND GRADE PERMITTING
Line7440	Note: GRADING PERMITS PER SITING DATED AUGUST 9, 2016
27Jun16 / 27Sep16	

FRAMING

Inv.606	1 - GARAGE: INSTALL MANDOOR - GARAGE TO HOUSE- AS PER PLAN AND GRADE PERMITTING
Line7439	Note: GIVEN IN AGREEMENT OF PURCHASE AND SALE
27Jun16 / 27Sep16 GRADING PERMITS PER SITING DATED AUGUST 9, 2016	

Inv.606	1 - FAMILY ROOM: INSTALL OPTIONAL COFFERED CEILING - FAMILY ROOM (PER ROOM AS PER PLAN)
Line7447	Note:
27Jun16 / 27Sep16	

Inv.606	1 - MAIN FLOOR: INSTALL FOUR (X4) STANDARD DOOR EXTENDED HEIGHT 96" (PRICE PER DOOR)- GROUND FLOOR 2 STOREY MODELS. FOR CLOSETS, POWDER ROOM AND BASEMENT DOORS
Line12016	Note:
27Jun16 / 27Sep16	

INTERIOR TRIM AND DOORS

CONSTRUCTION SUMMARY

120 - 1 - 38-4 Elev.B VIVALDI

Inv.606	4 - MAIN FLOOR: INSTALL FOUR (X4) STANDARD DOOR EXTENDED HEIGHT 96" (PRICE PER DOOR)- GROUND FLOOR 2 STOREY MODELS. FOR CLOSETS, POWDER ROOM AND BASEMENT DOORS
Line7444	Note:
27Jun16 / 27Sep16	

KITCHEN AND BATH CABINETRY

Inv.606	1 - KITCHEN: INSTALL KITCHEN CABINET STRIP VALANCE LIGHTS (UNDER CABINETS) - ROUGH - IN - DOES NOT INCLUDE (AND REQUIRES) KITCHEN UPGRADE PRICING
Line12013	Note:
27Jun16 / 27Sep16	

Inv.606	1 - MASTER ENSUITE: DELETE THREE FEET OF THE MASTER ENSUITE VANITY TO ACCOMODATE A BIDET. VANITY TO STILL HAVE DOUBLE SINK. SEE SKETCH
Line12014	Note:
27Jun16 / 27Sep16	

MISC.

Inv.606	1 - BONUS PACKAGE: \$10,000.00 (INCLUDING TAXES) WORTH OF UPGRADES FROM GOLD PARK HOMES DÉCOR CENTRE IS BEING APPLIED TOWARD THE STRUCTURAL APPOINTMENT. PURCHASER HAS A REMAINING AMOUNT OF \$00 (INCLUDING TAXES) TO BE USED TOWARD THE COLOUR APPOINTMENT
Line7448	Note:
27Jun16 / 27Sep16	

Inv.606	1 - Purchaser has attended a Structural appointment at the Decor Centre & has DECLINED any additional upgrades and accepts and acknowledges that there will be no further structural changes/additions/deletions to be made upon signing on June 27, 2016
Line7449	Note:
27Jun16 / 27Sep16	

Inv.606	1 - Purchasers are aware & accepts that ANY changes made to upgrades after signing this Purchasers Extra Form are subject to a minimum administration fee of \$500. PLUS a 10% holdback fee
Line7450	Note:
27Jun16 / 27Sep16	

PLUMBING

Inv.606	1 - MASTER ENSUITE: DELETE THREE FEET OF THE MASTER ENSUITE VANITY TO ACCOMODATE A BIDET. VANITY TO STILL HAVE DOUBLE SINK. SEE SKETCH
Line7441	Note:
27Jun16 / 27Sep16	

Inv.606	1 - MASTER ENSUITE: INSTALL BIDET - COMPLETE (INCLUDES FIXTURE)
Line7442	Note:
27Jun16 / 27Sep16	

Inv.606	1 - BASEMENT: INSTALL ROUGH-IN - 3PC BASEMENT ROUGH-IN, AS PER PLAN
Line7445	Note:
27Jun16 / 27Sep16	

WINDOWS - BASEMENT

Inv.606	2 - BASEMENT: INSTALL TWO (X2) BASEMENT WINDOWS - UPGRADE EXISTING BASEMENT WINDOW TO 30 INCH X 24 INCH - MAY REQUIRE INSTALLATION OF WINDOW WELL
Line7443	Note:
27Jun16 / 27Sep16	



CONSTRUCTION SUMMARY

120 - 1 - 38-4 Elev.B VIVALDI

The Vivaldi

38' SERIES

Elevation A • 2,518 sq.ft. | Elevation B • 2,518 sq.ft.

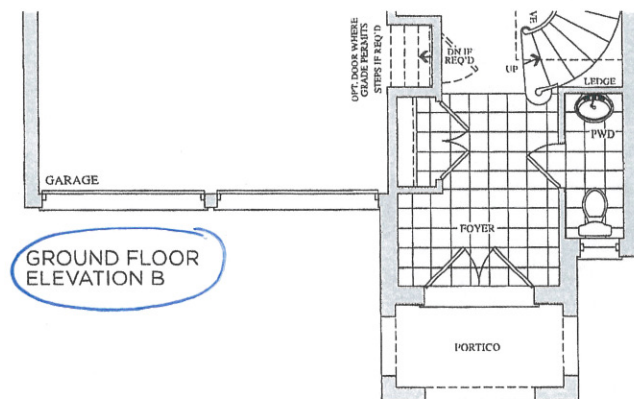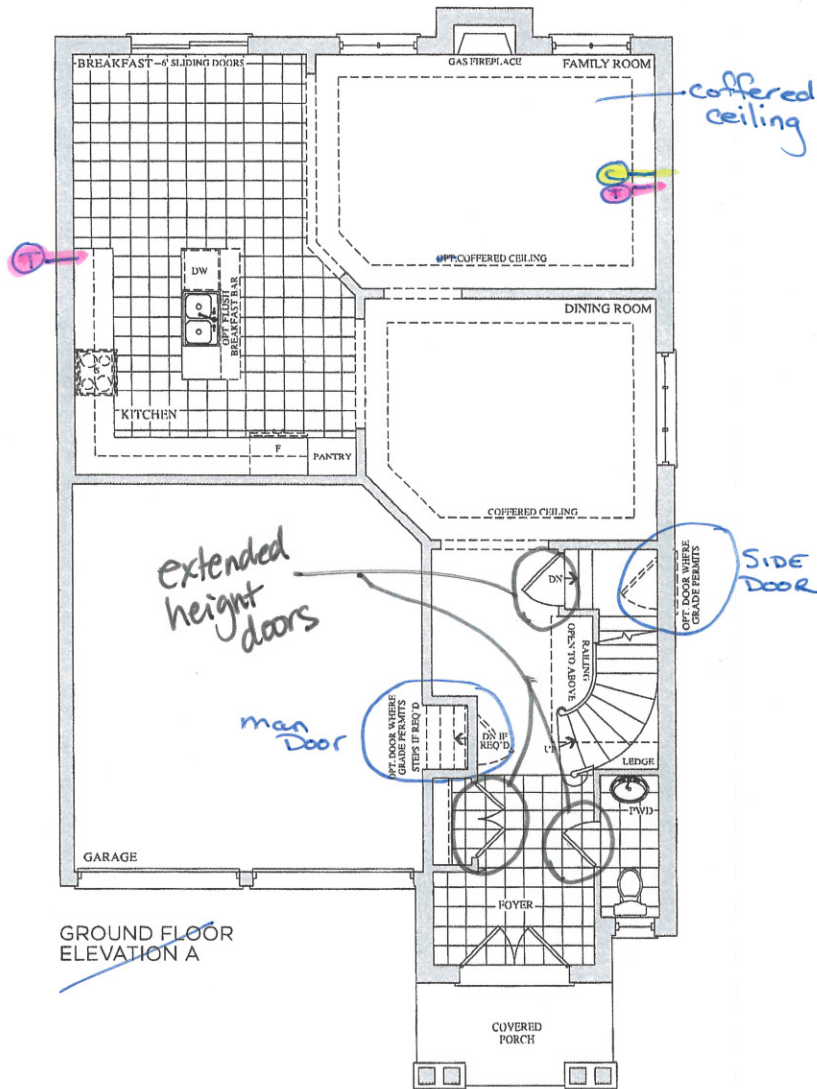

Lot 120
June 27, 16





Prices, figures, illustrations, sizes, features and finishes are subject to change without notice. L&O.L. Areas and dimensions are approximate and actual usable floor space may vary from the stated area. Layout may be reverse of the unit purchased. E. & O.E.

GOLD PARK
HOMES

The Vivaldi 38' SERIES

Elevation A • 2,518 sq.ft. | Elevation B • 2,518 sq.ft.

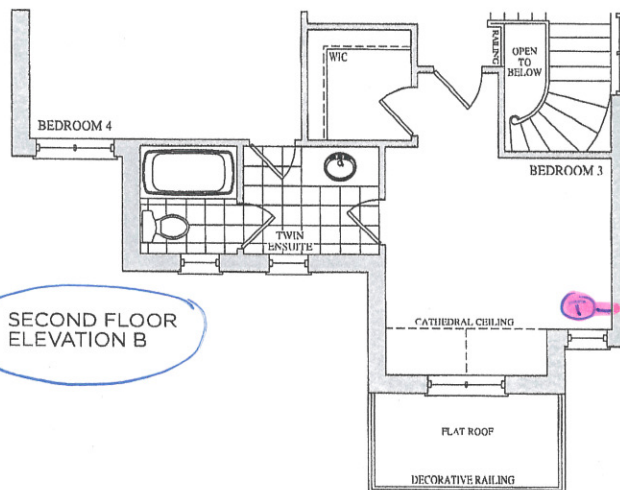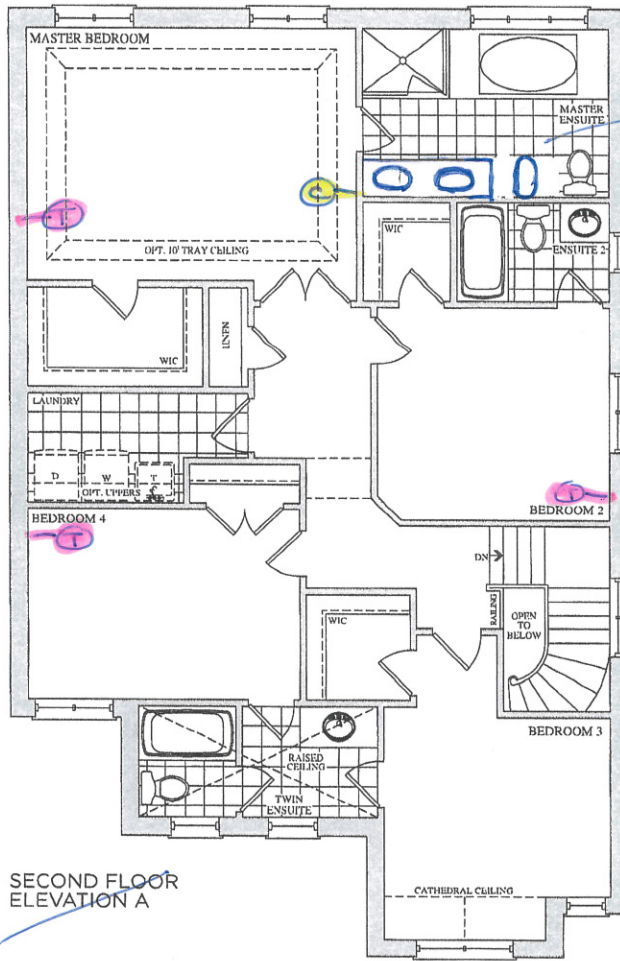

Lot 120
June 27, 16




Prices figures illustrations sizes features and finishes are subject to change without notice. E.&O.L. Areas and dimensions are approximate and actual usable floor space may vary from the stated area. Layout may be reverse of the unit purchased. E. & O.E.

GOLDPARK
HOMES

Basement Windows

2 x 30"x24"

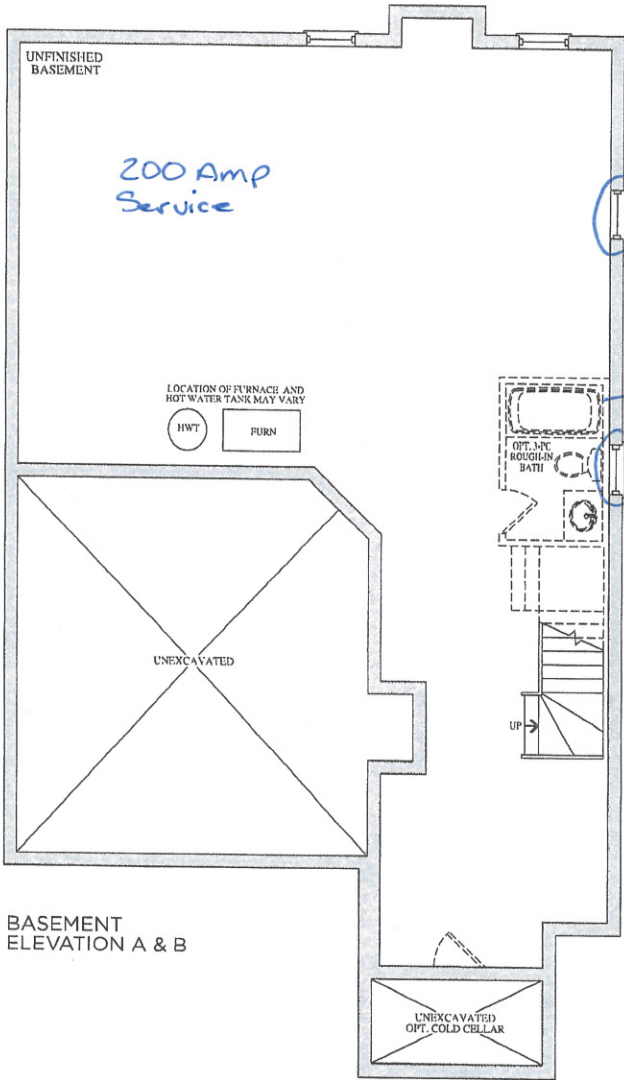

30"x24"

3 piece Rough-in

30"x24"

Lot 120
June 27, 16

Prices, figures, illustrations, sizes, features and finishes are subject to change without notice. E.&O.E. Areas and dimensions are approximate and actual usable floor space may vary from the stated area. Layout may be reverse of the unit purchased. E. & O.E.