




It is the builder's complete responsibility to ensure that all plans submitted for approval fully comply with the Architectural Guidelines and all applicable regulations and requirements including zoning provisions and any provisions in the subdivision agreement. The Control Architect is not responsible in any way for examining or approving site (lotting) plans or working drawings with respect to any zoning or building code or permit matter or that any house can be properly built or located on its lot.

This is to certify that these plans comply with the applicable Architectural Design Guidelines approved by the City of VAUGHAN.

MAY 10 2016

John G. Williams Limited, Architect

(lots 5(L), 6(LK), 7(LK))

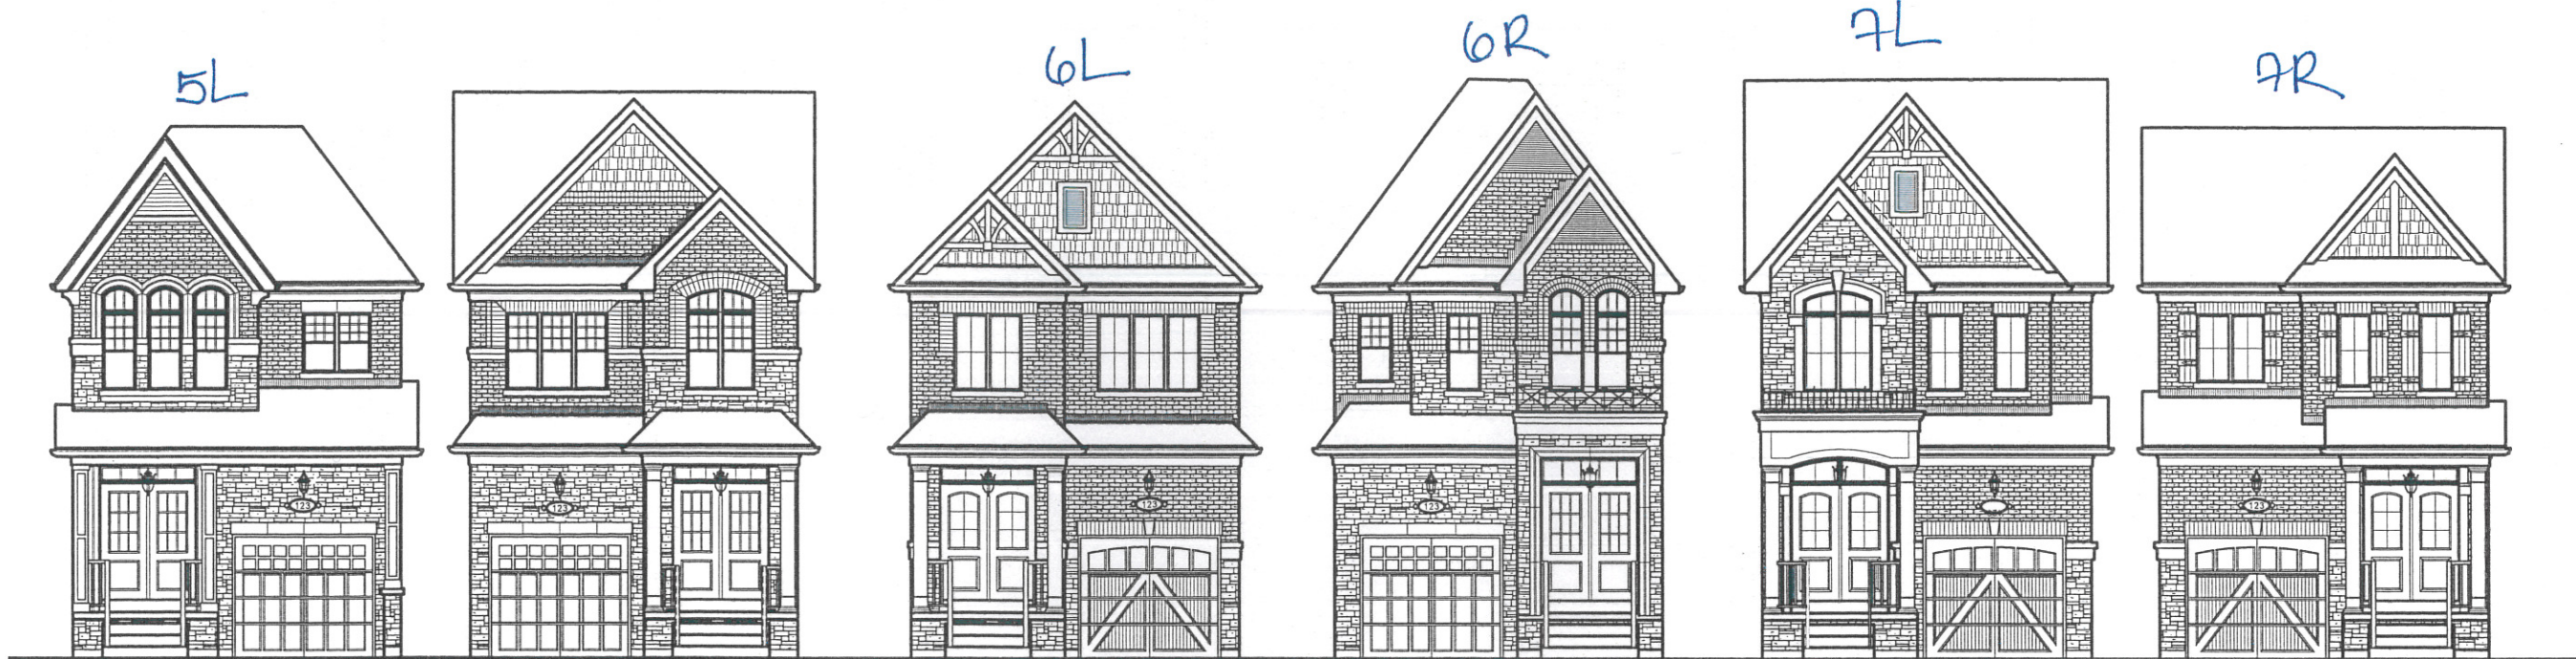

LOT # 5L	CRANBROOK CRESCENT
MODEL: THE RIVERSTONE, 'B'	25-01, REV.
COLOUR PACKAGE:	.
PRELIMINARY:	APR-21-16
FINAL:	MAY-03-16
DROP GARAGE SOFFIT:	.
OTHER:	.

LOT # 5R	CRANBROOK CRESCENT
MODEL: THE OAKMOUNT 'B'	25-03 - STD
COLOUR PACKAGE:	.
PRELIMINARY:	MAR-30-16
FINAL:	APR-21-16
DROP GARAGE SOFFIT:	.
OTHER:	.

LOT # 6L	CRANBROOK CRESCENT
MODEL: THE OAKMOUNT, 'A'	25-03, REV.
COLOUR PACKAGE:	.
PRELIMINARY:	APR-21-16
FINAL:	MAY-03-16
DROP GARAGE SOFFIT:	.
OTHER:	.

LOT # 6R	CRANBROOK CRESCENT
MODEL: THE HUDSON, 'B'	25-02, STD.
COLOUR PACKAGE:	.
PRELIMINARY:	APR-21-16
FINAL:	MAY-03-16
DROP GARAGE SOFFIT:	.
OTHER:	.

LOT # 7L	CRANBROOK CRESCENT
MODEL: HUDSON, ELEV. A	25-02, REV
COLOUR PACKAGE:	4
PRELIMINARY:	APR-11-16
FINAL:	APR-26-16
DROP GARAGE SOFFIT:	.
OTHER:	.

LOT # 7R	CRANBROOK CRESCENT
MODEL: THE RIVERSTONE 'A'	25-01, STD.
COLOUR PACKAGE:	1
PRELIMINARY:	APR-11-16
FINAL:	APR-26-16
DROP GARAGE SOFFIT:	.
OTHER:	.

revisions	date
1 ISSUED LOT 5R FOR REVIEW	30-Mar-16
2 ISSUED LOTS 5L, 6L, 6R FOR REVIEW	21-Apr-16
3 ISSUED LOTS 5R FOR FINAL	21-Apr-16
4 ISSUED LOT 5L, 6L AND 6R FOR FINAL	4-May-16
5	
6	
7	
8	
9	
10	
11	
12	
13	
14	
15	

client

Gold Park Homes

project

Huntington &
Nashville
Kleinburg

title

Streetscape

project #

14043

scale

3/32" = 1'0"

lot(s)

5 - 7