


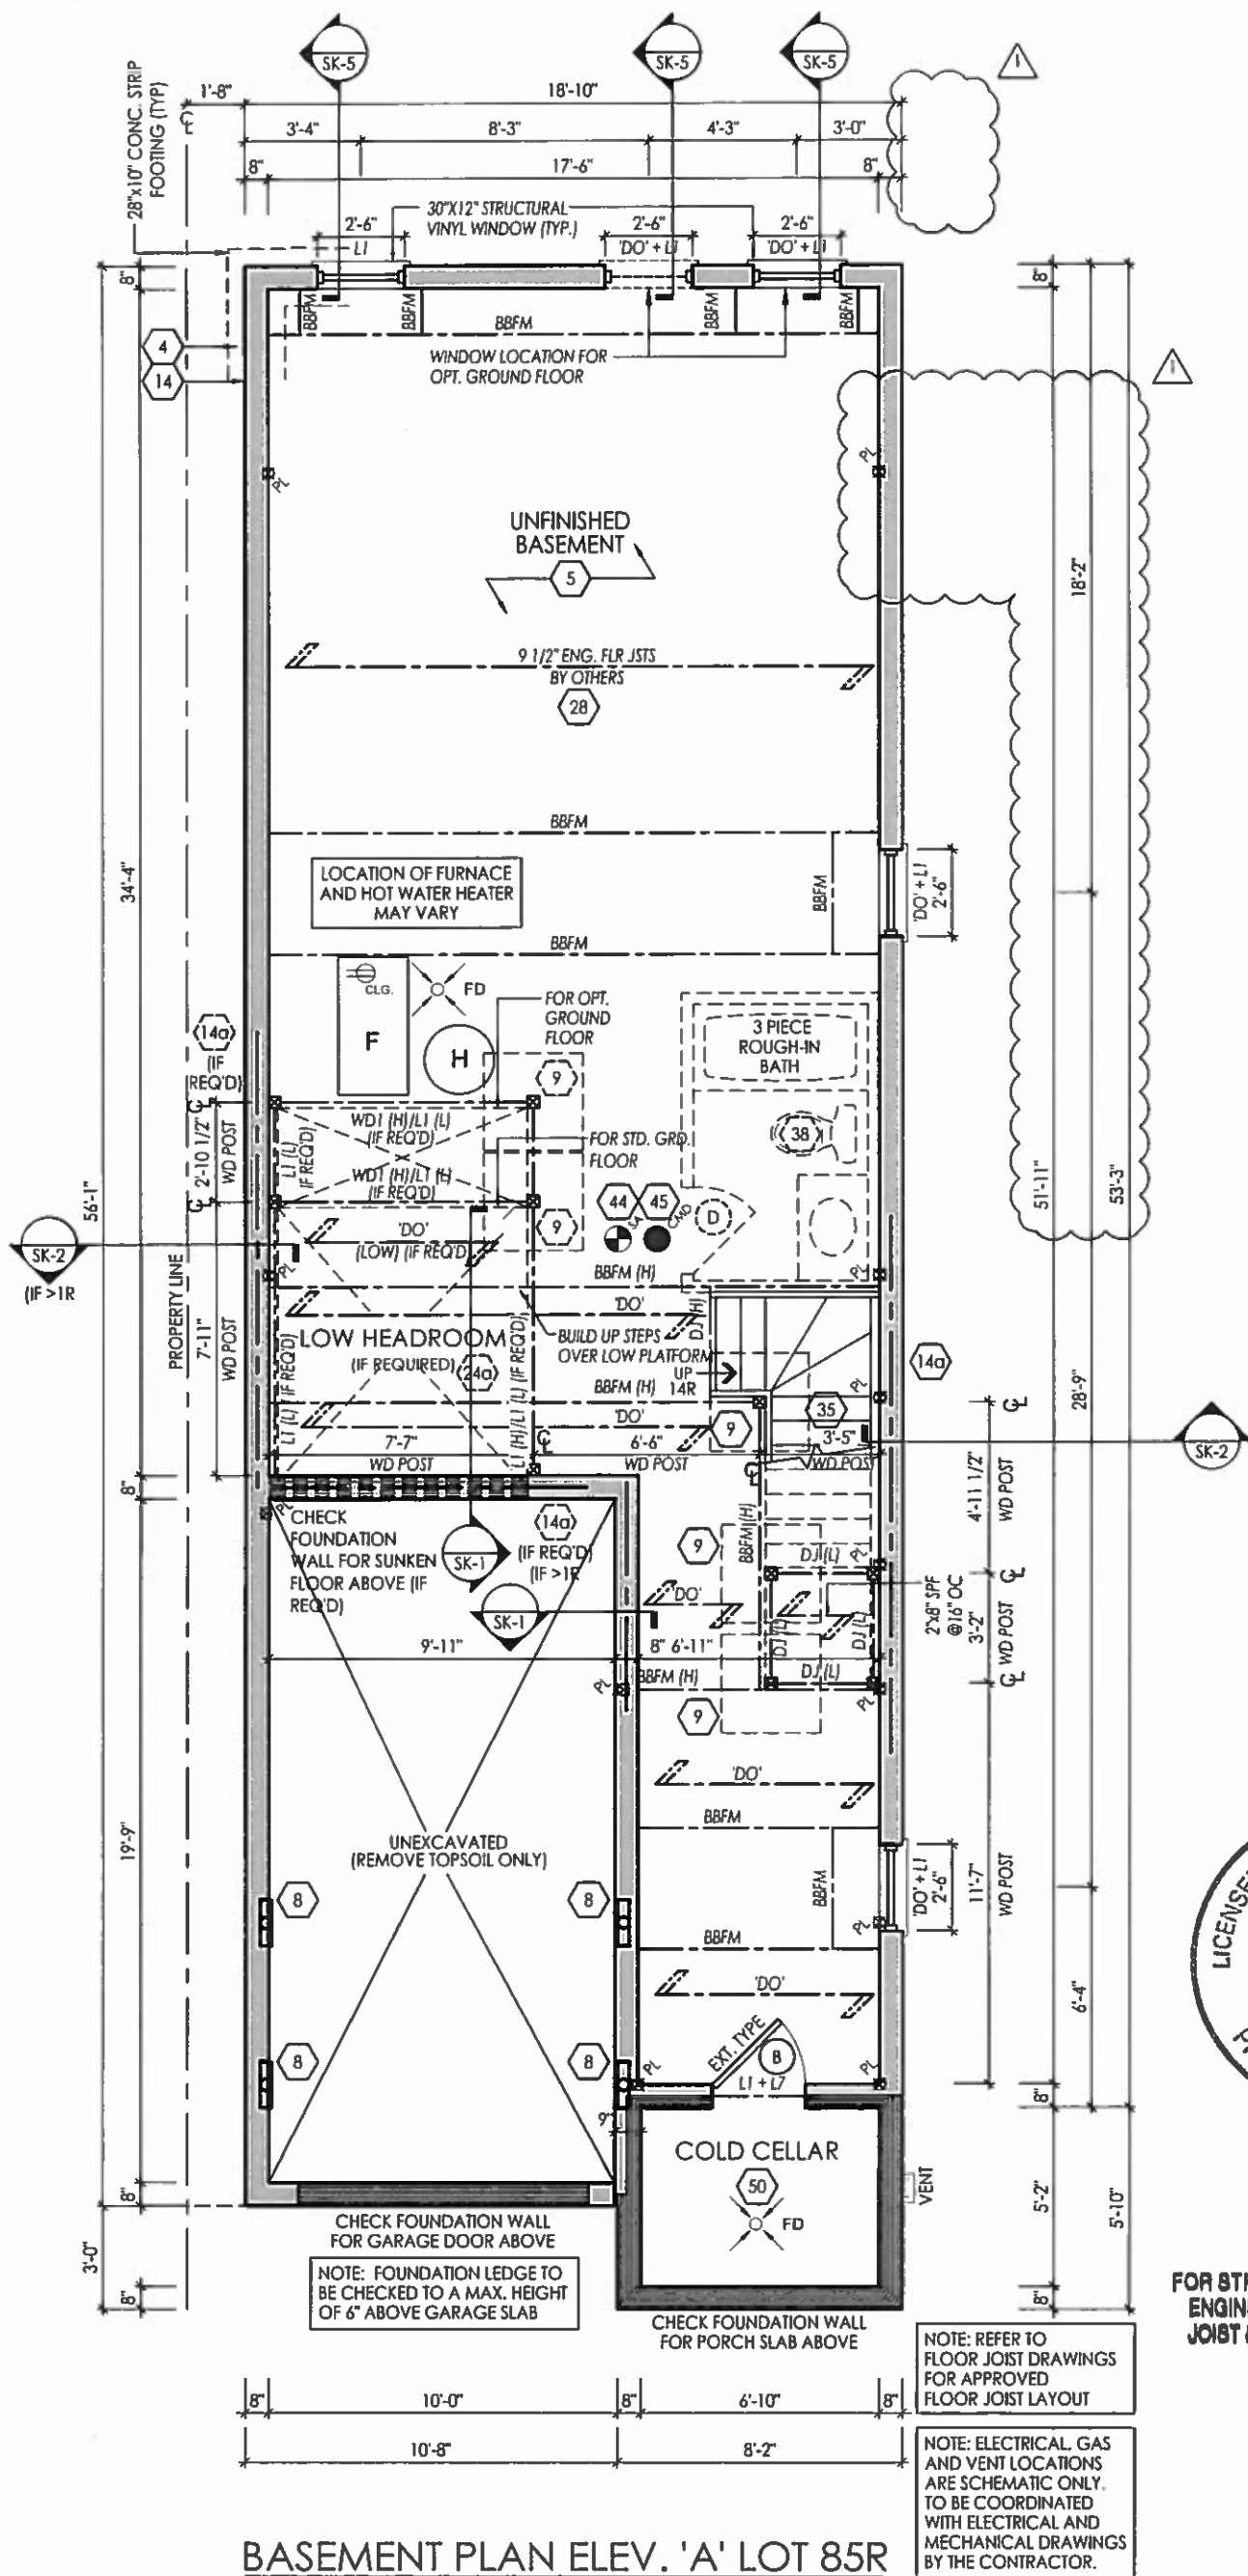

DEC 01 2016

FOR STRUCTURAL ONLY EXCLUDING
ENGINEERED ROOF TRUSS, FLOOR
JOIST & FLOOR LVL. BEAM DESIGNS

BASEMENT PLAN ELEV. 'A' LOT 85R

I, JULIO PINZON DECLARE THAT I HAVE REVIEWED AND TAKEN DESIGN RESPONSIBILITY FOR THE DESIGN WORK ON BEHALF OF RN DESIGN LTD. UNDER DIVISION C, PART-3 SUBSECTION-3.2.4 OF THE BUILDING CODE. I AM QUALIFIED AND THE FIRM IS REGISTERED IN THE APPROPRIATE CLASSES / CATEGORIES.

QUALIFIED DESIGNER BCIN: 38488
FIRM BCIN: 26995
DATE: 11.17.16
SIGNATURE: *[Signature]*


client				location			
Gold Park Homes				Kleinburg			
project				marketing name			
Huntington & Nashville							
#	revisions	date	dwn	chk	#	revisions	date
1	ISSUED FOR CLIENT REVIEW	27 NOV-16	AD	JP			
2	ISSUED FOR PERMIT	30 NOV-16	AD	JP			

rn design
Imagine • Inspire • Create



model 25-1
scale 3/16" = 1'0"
project # 14043

NOTE: NO UNPROTECTED OPENINGS PERMITTED FOR LIMITING DISTANCE LESS THAN 3'-1" (1.2M) AS PER 9.10.14 OF THE ONTARIO BUILDING CODE.

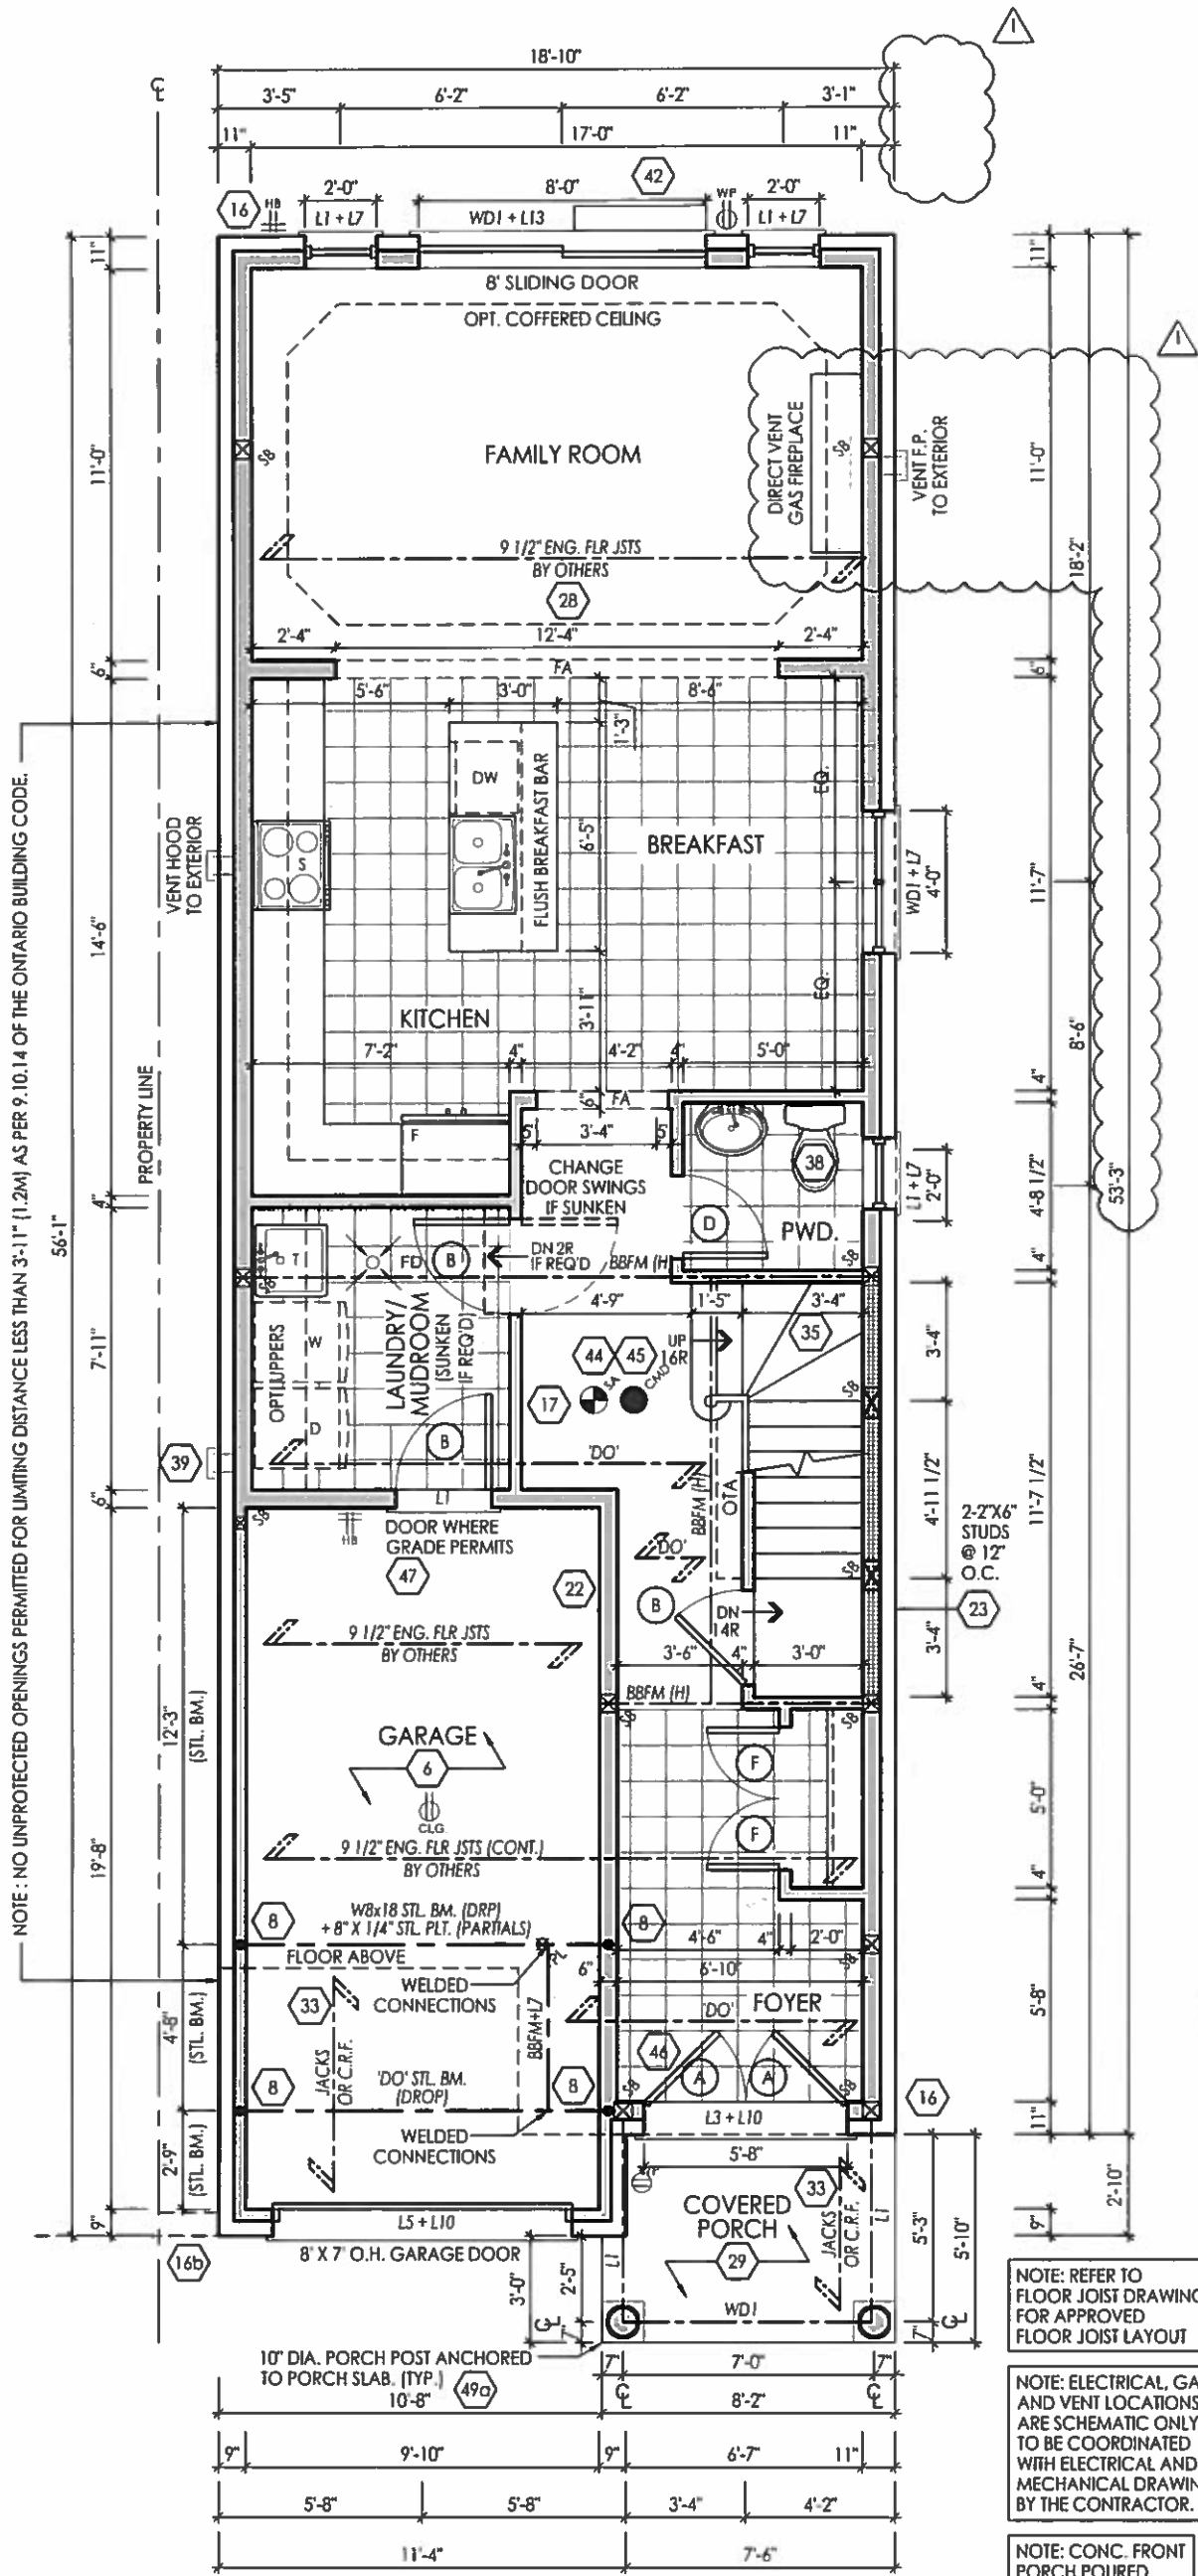

GROUND FLOOR PLAN ELEV. 'A' LOT 85R



FOR STRUCTURAL ONLY EXCLUDING
ENGINEERED ROOF TRUSS, FLOOR
JOIST & FLOOR LVL BEAM DESIGNS

NOTE: REFER TO
FLOOR JOIST DRAWINGS
FOR APPROVED
FLOOR JOIST LAYOUT

NOTE: ELECTRICAL, GAS
AND VENT LOCATIONS
ARE SCHEMATIC ONLY.
TO BE COORDINATED
WITH ELECTRICAL AND
MECHANICAL DRAWINGS
BY THE CONTRACTOR.

NOTE: CONC. FRONT
PORCH POURED
PRIOR TO BRICK

NOTE: REFER TO TRUSS
DRAWINGS FOR APPR.
TRUSS LAYOUT

NOTE: U/S OF ARCH 7'6" TYP.

I, JULIO PINZON DECLARE THAT I HAVE REVIEWED AND TAKEN
DESIGN RESPONSIBILITY FOR THE DESIGN WORK ON BEHALF
OF RN DESIGN LTD. UNDER DIVISION C, PART-3 SUBSECTION 3.2.4
OF THE BUILDING CODE. I AM QUALIFIED AND THE FIRM IS
REGISTERED IN THE APPROPRIATE CLASSES / CATEGORIES.

QUALIFIED DESIGNER BCIN: 38688
FIRM BCIN: 26995
DATE: 11.17.16
SIGNATURE: [Signature]

client				location			
Gold Park Homes				Kleinburg			
project				marketing name			
Huntington & Nashville							
#	revisions	date	dwn	chk	#	revisions	date
1	ISSUED FOR CLIENT REVIEW	28 NOV 16	AD	JP			
2	ISSUED FOR PERMIT	30 NOV 16	AD	JP			

Imagine - Inspire - Create



model 25-1
scale 3/16" = 1'0"
project # 14043

OPT. GROUND FLOOR PLAN ELEV. 'A' LOT 85R

SIGNATURE:

client
Gold Park Homes

project
Huntington & Nashville

location
Kleinburg
marketing name

AN design
Imagine • Inspire • Create

model
25-1


scale
 $3/16" = 1'0"$

project #
14043

page

A25

[illegible]

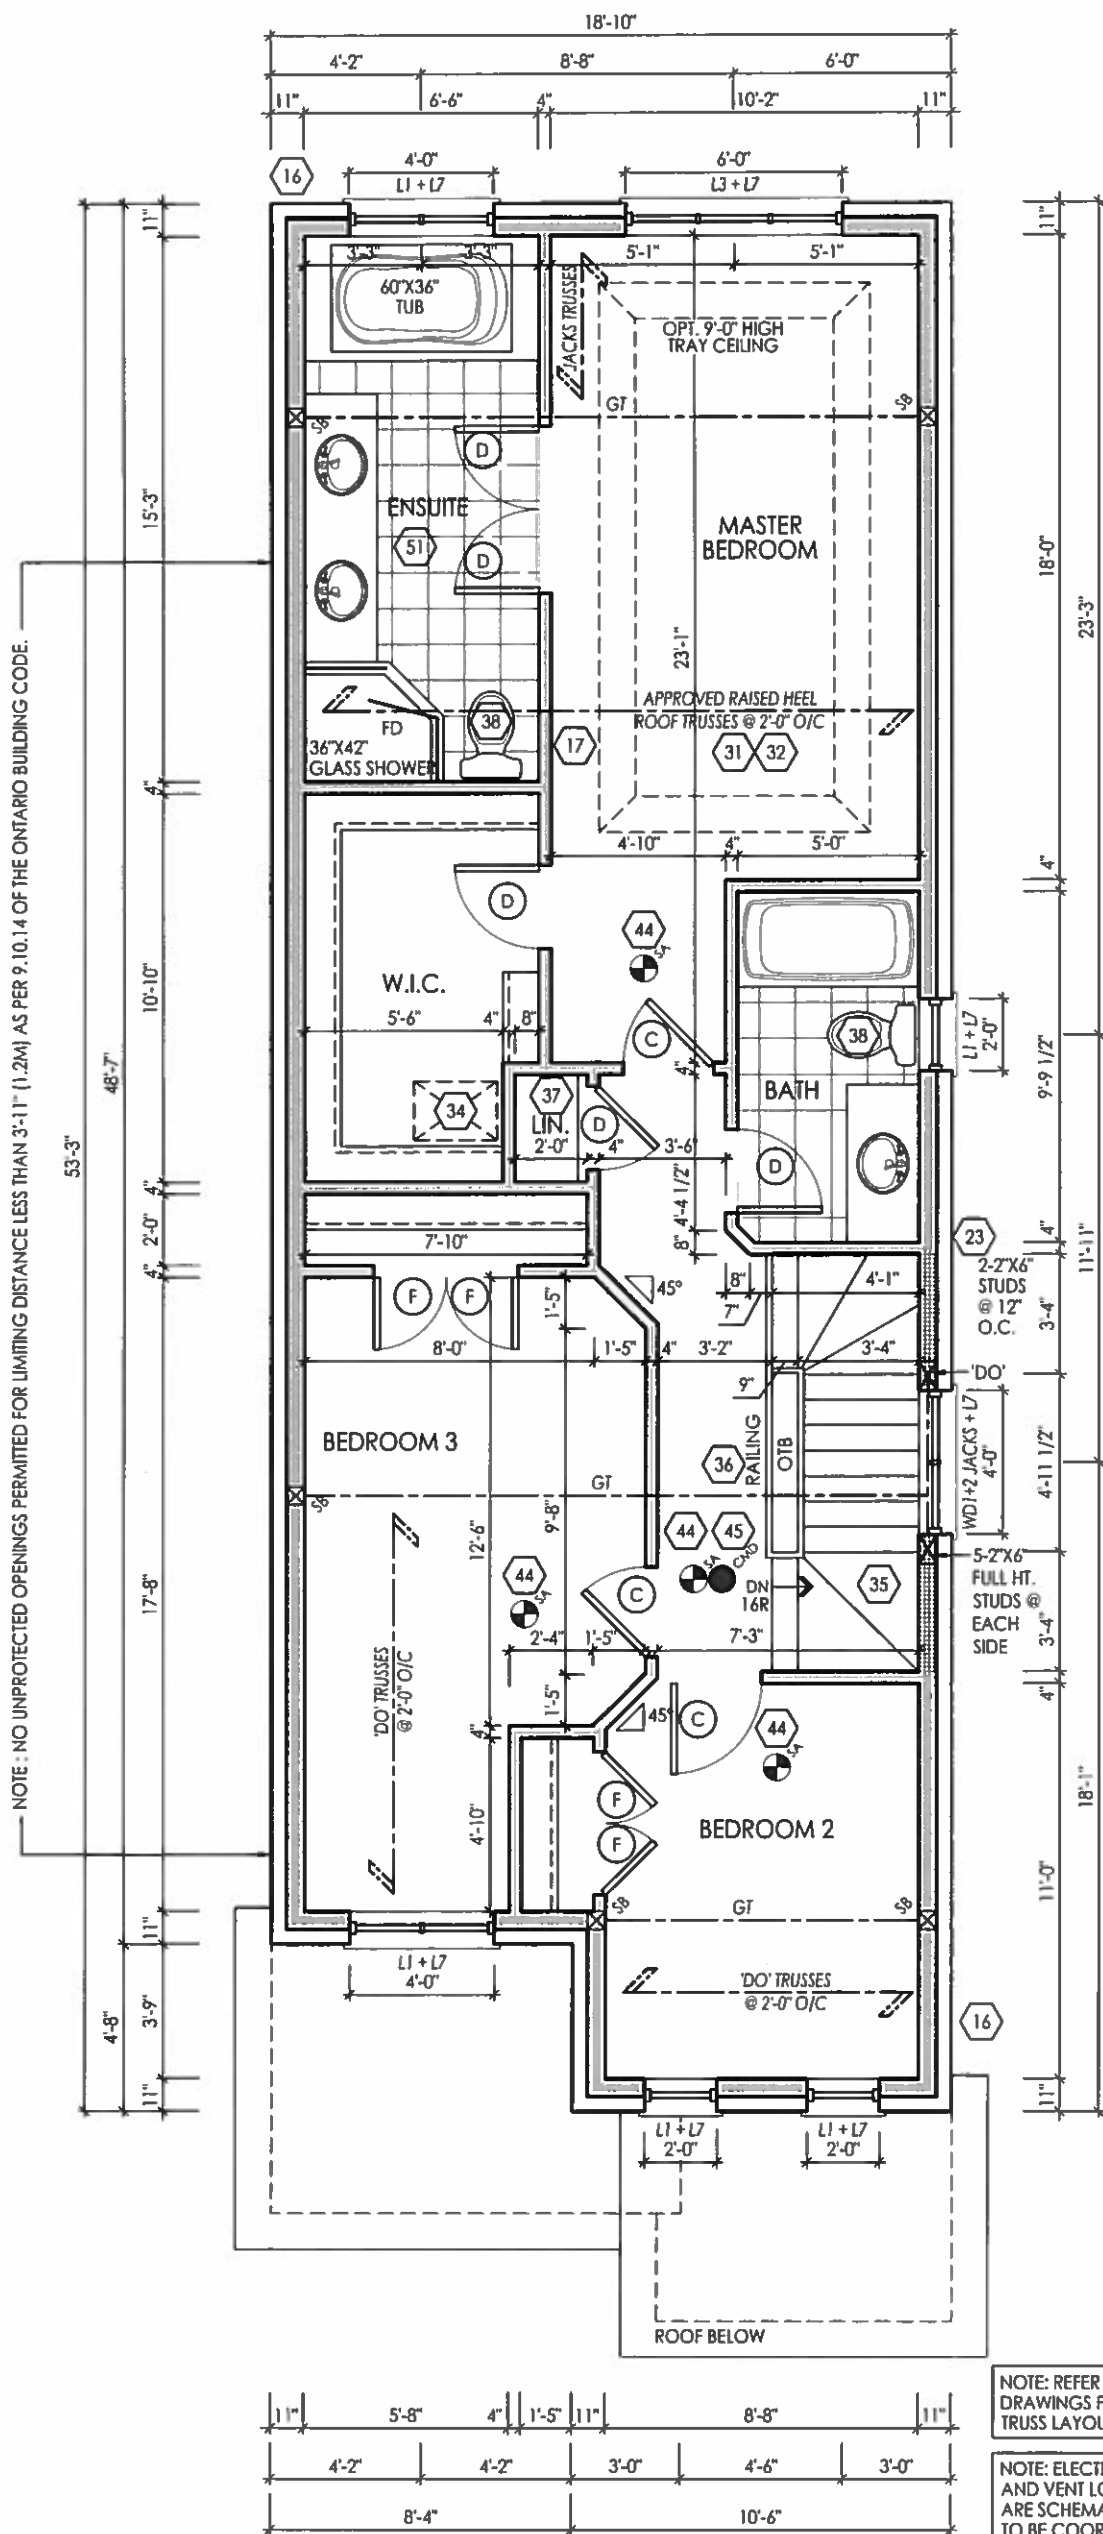

SECOND FLOOR PLAN ELEV. 'A' LOT 85R



DEC 01 2016

FOR STRUCTURAL ONLY EXCLUDING
ENGINEERED ROOF TRUSS, FLOOR
JOIST & FLOOR LVL. BEAM DESIGNS

I, JULIO PINZON DECLARE THAT I HAVE REVIEWED AND TAKEN DESIGN RESPONSIBILITY FOR THE DESIGN WORK ON BEHALF OF RN DESIGN LTD. UNDER DIVISION C, PART-3 SUBSECTION-3.2.4 OF THE BUILDING CODE. I AM QUALIFIED AND THE FIRM IS REGISTERED IN THE APPROPRIATE CLASSES / CATEGORIES.

QUALIFIED DESIGNER BCIN: 38688
FIRM BCIN: 26995
DATE: 11.17.16

SIGNATURE:

client Gold Park Homes location Kleinburg
project Huntington & Nashville marketing name

#	revisions	date	dwn	chk	#	revisions	date	dwn	chk
1	ISSUED FOR CLIENT REVIEW	28 NOV 16	AD	JP					
2	ISSUED FOR PERMIT	30 NOV 16	AD	JP					

RN design
Imagine - Inspire - Create



model 25-1
scale 3/16" = 1'0"
project # 14043

page A26