

CONSTRUCTION MODIFICATION / CLARIFICATION

LOT 72 –Kleinburg Glen

PROJECT- Kleinburg Glen

CHANGE

Plumbing

- Sink and dishwasher moved from layout in Construction summary. Please see attached kitchen revision layout.

Electrical

- Sink and dishwasher moved from layout in Construction summary. Please see attached kitchen revision layout.

Kitchen

- Sink and dishwasher moved from layout in Construction summary. Please see attached kitchen revision layout.

Thank you

DATE ISSUED: 1/16/17


ISSUED BY: Stacey Carlete

Trade Name: Gold Park Homes	Site location: Kleinburg	Model: 38-3- New Model
Address:	Project: Kleinburg Glen	Phase:


This layout has been explained to the purchaser by Cortina Kitchens Inc. and is understood by the purchaser.

WINDOW RELOCATED


PLEASE LEAVE 44" BURN RANGE + ISLAND

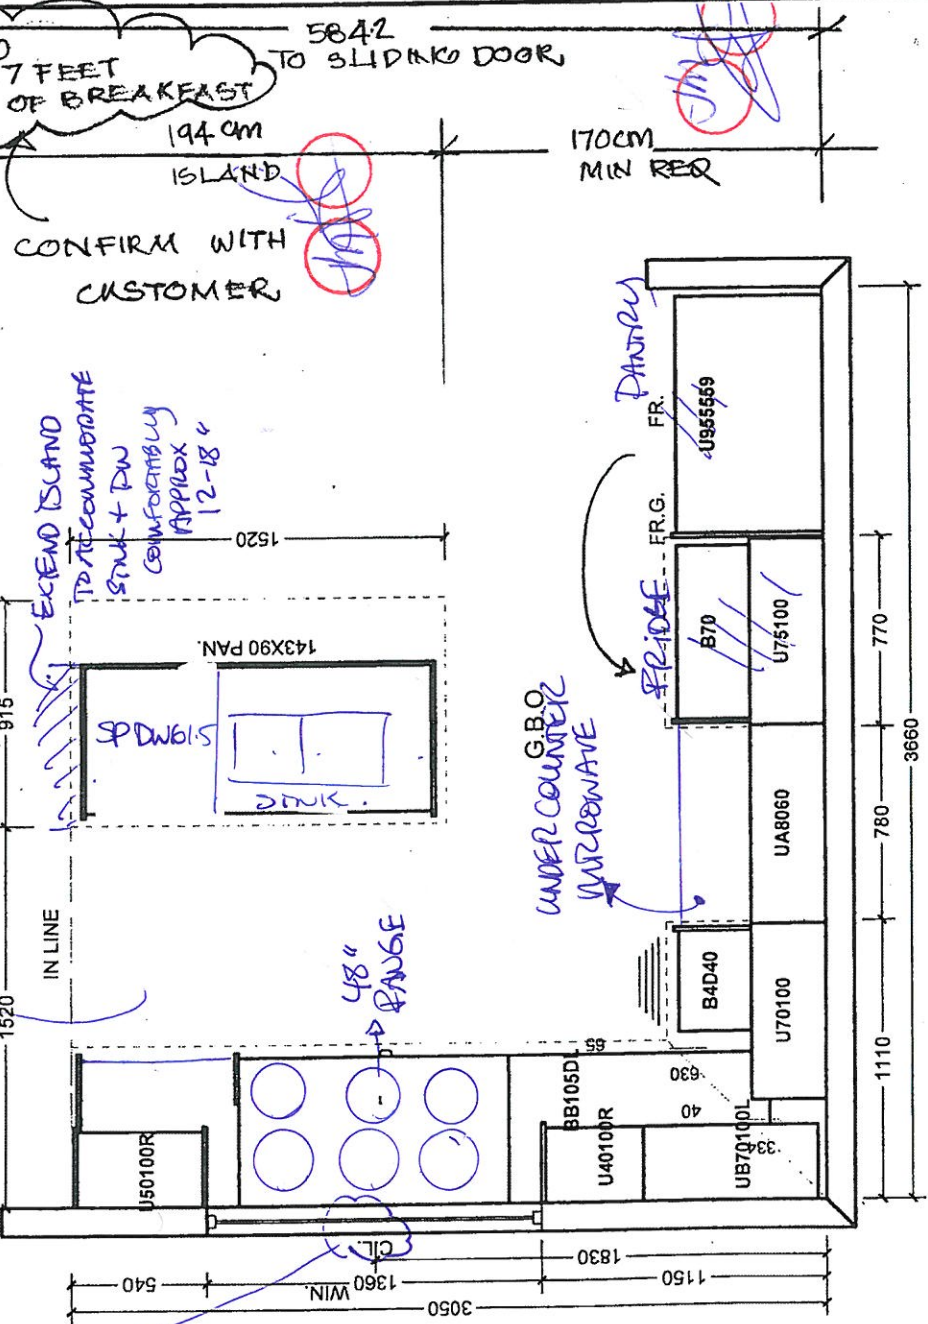


ENSUITE 2(BD.2)

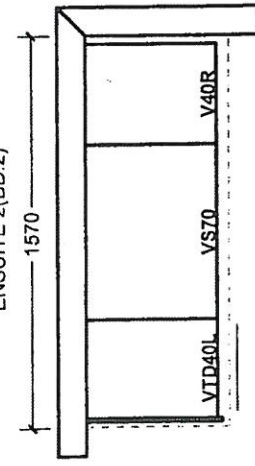


TWIN BATH(BD. 3/4)

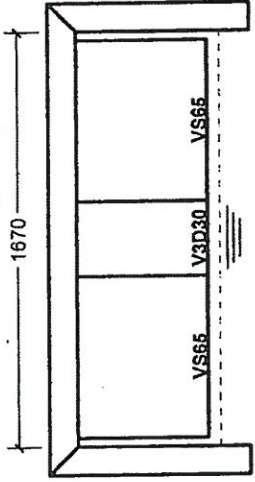


ENSUITE

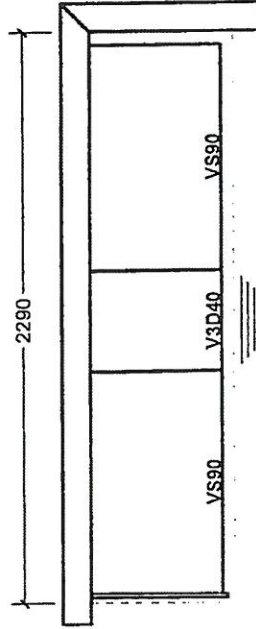

LAUNDRY

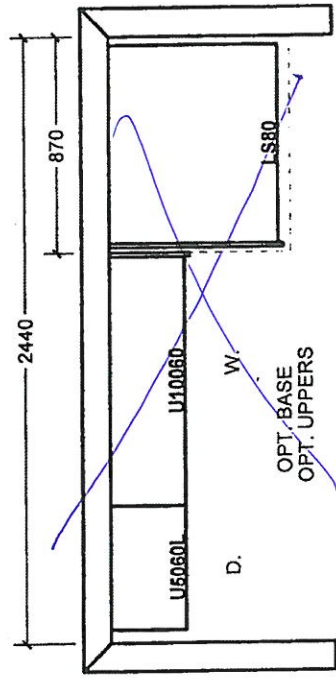

OPT. BENCH(MUD ROOM)

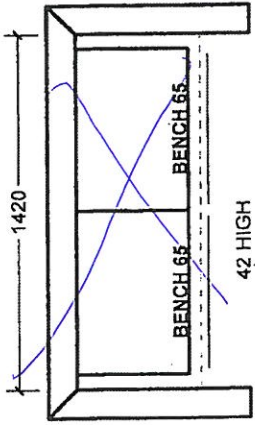

All prices subject to confirmation from head office.
This quotation is subject to the terms & conditions set out

All agreements are contingent upon strikes, accidents, and delays beyond our control.
Please provide our installer with template for sinkholes or \$150.00 will be charged for callback.

ACCEPTED DATE: DEC. 20.2016

[Signature]

Lot 72

[Signature]

Item A. Wood grain and colour are characteristics of the product. We cannot guarantee that such grain and colour will always match.
Item B. Cortina Kitchens Inc. reserves the right to alter dimensions and make technical changes without notice.

LOT 72

Trade Name: Gold Park Homes

Site location: Kleinburg

Model: 38-3- New Model

Address:

Project: Kleinburg Glen

Phase:

WINDOW
RELOCATED

PLEASE LEAVE 44" BURN RANGE + ISLAND

This layout has been explained to the purchaser by Cortina Kitchens Inc. and is understood by the purchaser.

1520

IN LINE

1520

915

1520

1520

1520</

KitchenAid®

FOR THE WAY IT'S MADE:™

PRODUCT MODEL NUMBERS

~~KRSC500E~~
~~KRSE600E~~

KRSC503E

Electrical: A 115 volt, 60 Hz, AC only, 15- or 20-amp fused, grounded electrical supply is required. It is recommended that a separate circuit serving only your refrigerator be provided. Use an outlet that cannot be turned off by a switch. Do not use an extension cord.

Water: A cold water supply with water pressure of between 30 and 120 psi (207 and 827 kPa) is required to operate the water dispenser and ice maker. If you have questions about your water pressure, call a licensed, qualified plumber.


Reverse Osmosis Water Supply:

IMPORTANT: The pressure of the water supply coming out of a reverse osmosis system going to the water inlet valve of the refrigerator needs to be between 30 and 120 psi (207 and 827 kPa).

If a reverse osmosis water filtration system is connected to your cold water supply, the water pressure to the reverse osmosis system needs to be a minimum of 40 to 60 psi (276 to 414 kPa).

Side by Side Refrigerator

PRODUCT DIMENSIONS

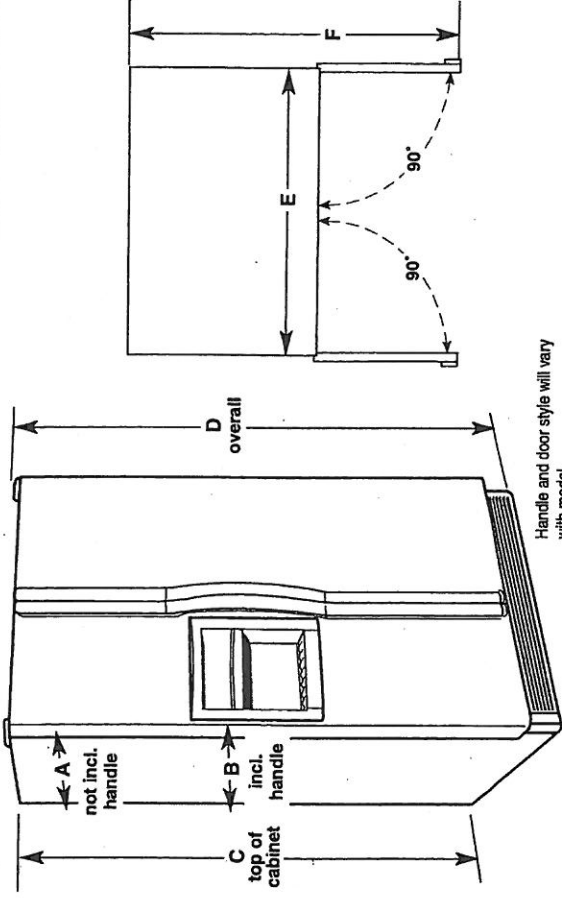


Handle and door style will vary with model.

Dimensions "C" and "D" include rollers extended 3/4" (1.9 cm).

Model	Model Size	Depth without Handle "A"	Depth with Handle "B"	Cabinet Height "C"	Overall Height "D"	Cabinet Width "E"	Depth "F" with Doors Open 90°
KRSC500E	23.9	27 1/2" (69.9 cm)	30" (76.2 cm)	71" (180.3 cm)	71 1/4" (181 cm)	35 3/4" (90.3 cm)	45 7/8" (116.5 cm)
KRSC503E	23.9	27 1/2"	30"	71"	71 1/4"	35 3/4"	45 7/8"
KRSE600E	23.9	30 1/2" (77.5 cm)	34" (86.4 cm)	69 1/2" (176.8 cm)	69 3/4" (177.1 cm)	35 3/4" (90.3 cm)	45 7/8" (116.5 cm)

LOCATION REQUIREMENTS

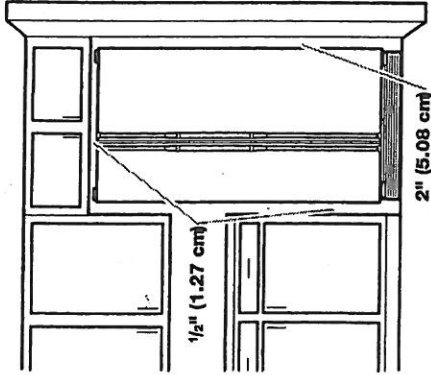

To ensure proper ventilation for your refrigerator, allow for 1/2" (1.27 cm) of space on each side and at the top. Allow for 1" (2.54 cm) of space behind the refrigerator. If your refrigerator has an ice maker, allow extra space at the back for the water line connections. When installing your refrigerator next to a fixed wall, leave a 2" (5.08 cm) minimum space on each side (depending on your model) to allow the doors to swing open.

NOTES:

- This refrigerator is intended for use in a location where the temperature ranges from a minimum of 55°F (13°C) to a maximum of 110°F (43°C). The preferred room temperature range for optimum performance, which reduces electricity usage and provides superior cooling, is between 60°F (15°C) and 90°F (32°C). It is recommended that you do not install the refrigerator near a heat source, such as an oven or radiator.
- Normal minimum cabinet cut-out width required for product installation is 36" (91.44 cm). However, if the product is placed against an extended wall and the ability to remove the crisper pans is desired, an additional 18" (45.72 cm) of cabinet width is required, so a total cabinet opening width of 54" (137.16 cm) is recommended.

WUENBURG GUN

LOT 72

MA 72

OCT. 20. 2016