

**Kleinburg Glen - 79 - 1 - 38-1 Elev.B HAMPTON
CENTRAL VAC AND WIRING**

Inv.612	1 - GREAT ROOM: Install a CONDUIT PIPE - FOR TELEVISION - Locate approx. 60" A.F.F above fireplace, terminating left of fireplace at cable rough-in. See plan for location.
Line7567	Note:
27Jun16 / 3Jan17	
ELECTRICAL	
Inv.612	1 - GREAT ROOM: Install a 110V WALL RECEPTACLE ON NORMAL CIRCUIT - approx. 60" A.F.F. above fireplace. See plan for location
Line7568	Note:
27Jun16 / 3Jan17	
Inv.612	1 - KITCHEN: RELOCATE STANDARD FIXTURE, move to approx. center above island. See plan for location.
Line7570	Note:
27Jun16 / 3Jan17	
Inv.612	6 - KITCHEN: POT LIGHT: 4 INCH HALOGEN POT LIGHT - 440 WH - PRICED PER LIGHT - 10 OR MORE, See plan for location.
Line7571	Note:
27Jun16 / 3Jan17	
Inv.612	1 - KITCHEN: Install single pole switch for potlights. See plan for location.
Line7572	Note:
27Jun16 / 3Jan17	
Inv.612	1 - KITCHEN: Install Rough in for future VALANCE LIGHTS (UNDER CABINETS) - ROUGH - IN - DOES NOT INCLUDE (AND REQUIRES) KITCHEN UPGRADE PRICING
Line7573	Note:
27Jun16 / 3Jan17	
Inv.612	10 - GREAT ROOM: POT LIGHT: 4 INCH HALOGEN POT LIGHT - 440 WH - PRICED PER LIGHT - 10 OR MORE. See plan for location.
Line7575	Note:
27Jun16 / 3Jan17	
Inv.612	1 - GREAT ROOM: Install 2 single pole switches for potlights. 1 switch for lights in corners + 1 switch for interior lights, see plan for location.
Line7576	Note: PRICE CORRECTED ON PE-1079
27Jun16 / 3Jan17	
Inv.612	2 - FOYER: Install 2 ROUGH - IN WALL OUTLET ON SAME SWITCH - DOES NOT INCLUDE FIXTURE - Locate approx. 80" A.F.F. See plan for location.
Line7578	Note:
27Jun16 / 3Jan17	
Inv.612	1 - FOYER: Install a single pole switch for wall sconces. See plan for location.
Line7579	Note:
27Jun16 / 3Jan17	
Inv.612	1 - MASTER ENSUITE: RELOCATE STANDARD VANITY SCONCE TO APPROX. CENTER ABOVE 1 SINK.
Line7582	Note:
27Jun16 / 3Jan17	
Inv.612	1 - MASTER ENSUITE: ROUGH - IN WALL OUTLET ON SAME SWITCH - DOES NOT INCLUDE FIXTURE - Locate approx. center of 1 sink, use same switch as standard vanity sconce. (1 standard + 1 extra on same switch). Locate approx. 80" A.F.F. See plan for location.
Line7583	Note:
27Jun16 / 3Jan17	

Kleinburg Glen - 79 - 1 - 38-1 Elev.B HAMPTON

Inv.612	1 - KITCHEN: 110V WALL RECEPTACLE ON DEDICATED CIRCUIT - MUST SPECIFY LOCATION for microwave on shelf. Cabinetry customization to be priced at colour appointment. See plan for location.
Line7588	Note:
27Jun16 / 3Jan17	

EXTERIOR COLOURS

Inv.612	1 - EXTERIOR COLOUR PACKAGE 4
Line15852	Note:
27Jun16 / 3Jan17	

MISC.


Inv.612	1 - Purchaser has attended a Structural appointment at the Decor Centre & has DECLINED any additional upgrades and accepts and acknowledges that there will be no further structural changes/additions/deletions to be made upon signing on June 27, 2016.
Line7585	Note:
27Jun16 / 3Jan17	
Inv.612	1 - Purchasers are aware & accepts that ANY changes made to upgrades after signing this Purchasers Extra Form are subject to a minimum administration fee of \$500. PLUS a 10% holdback fee.
Line7586	Note:
27Jun16 / 3Jan17	
Inv.612	1 - BONUS PACKAGE: \$7,500.00 (INCLUDING TAXES) WORTH OF UPGRADES FROM GOLD PARK HOMES DÉCOR CENTRE IS BEING APPLIED TOWARD THE STRUCTURAL APPOINTMENT. PURCHASER HAS A REMAINING AMOUNT OF \$384.40 (INCLUDING TAXES) TO BE USED TOWARD THE COLOUR APPOINTMENT.
Line7587	Note:
27Jun16 / 3Jan17	

WINDOWS - BASEMENT

Inv.612	4 - BASEMENT WINDOWS - UPGRADE EXISTING BASEMENT WINDOW TO 30 INCH X 24 INCH - MAY REQUIRE INSTALLATION OF WINDOW WELL
Line7584	Note:
27Jun16 / 3Jan17	


Elevation A • 2,388 sq.ft.

Elevation B • 2,375 sq.ft.

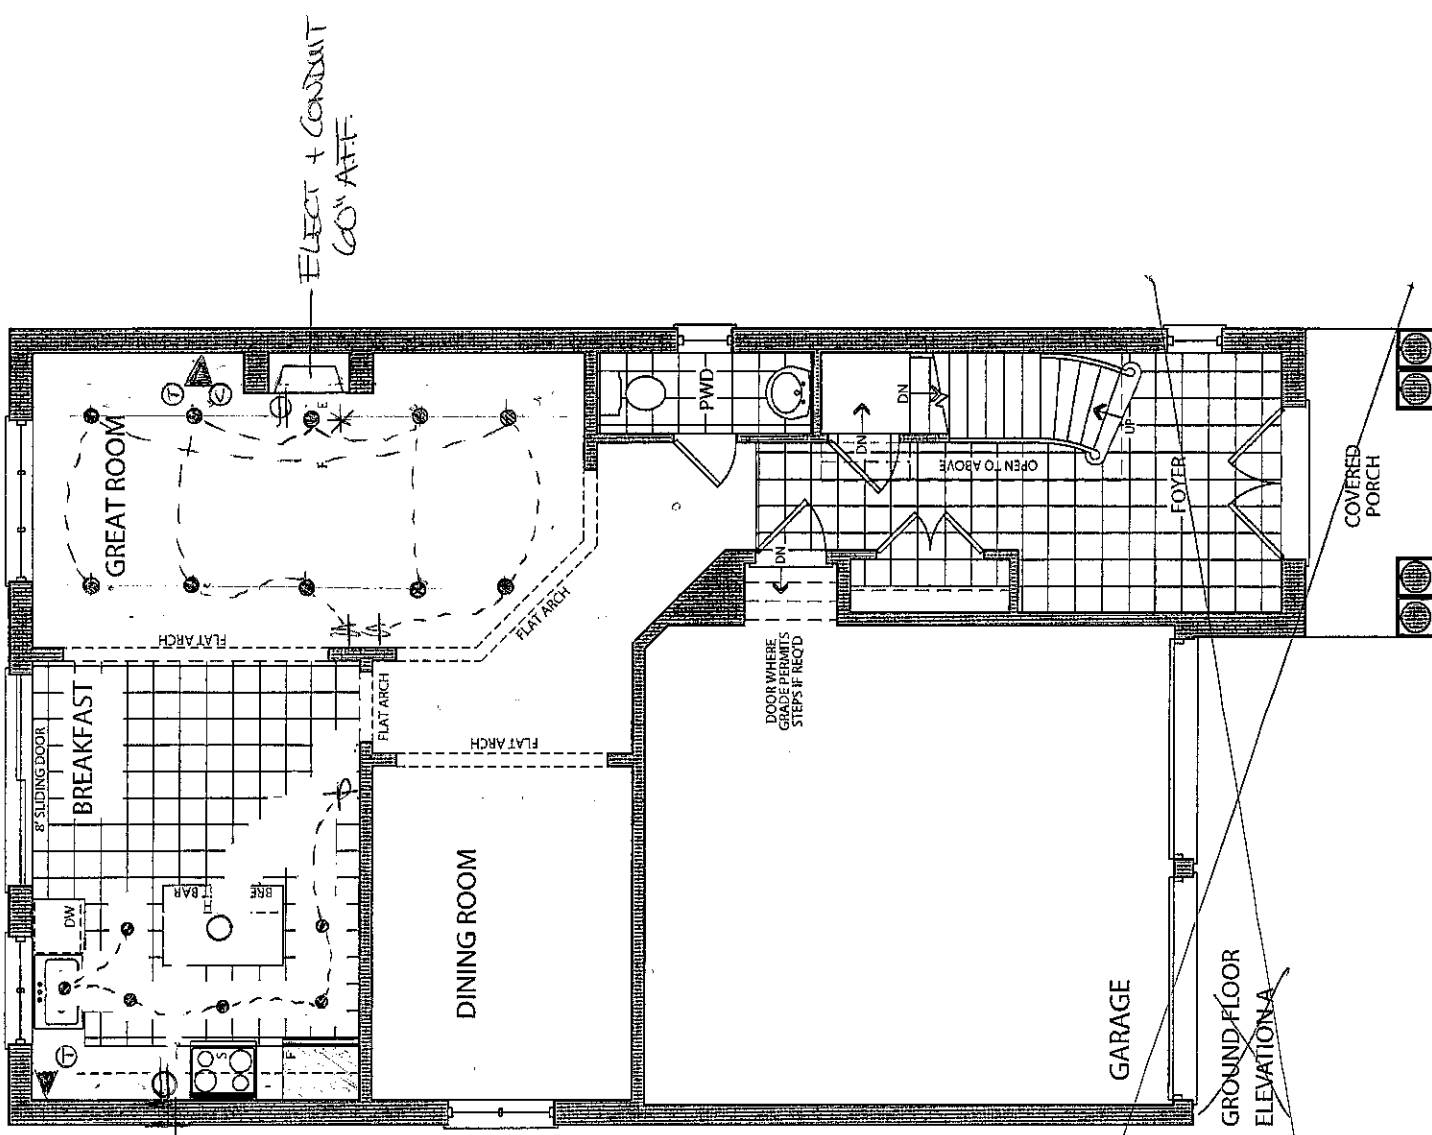

LEGEND

- MOVE STA LIGHT
- POTLIGHT
- ⌘ SINGLE POLE SWITCH
- ⊕ ELECT OUTLET
- * CONDUIT PIPE
- ⊥ SCORCE
- ▲ ① PHONE
- ▲ ② CABLE

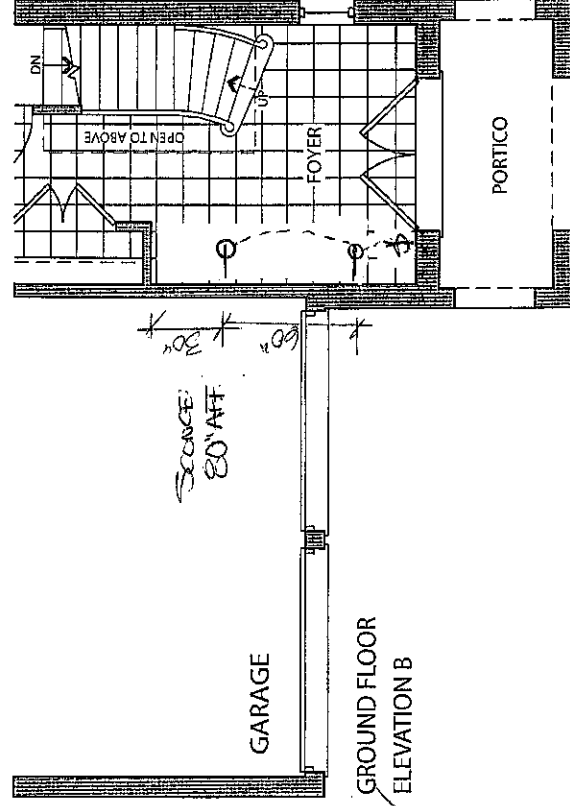

Elevation A • 2,388 sq.ft.



Elevation B • 2,375 sq.ft.

LOT 79

June 27 2016

W92
W92


BOTH SLOPE
AT STD
HEIGHT

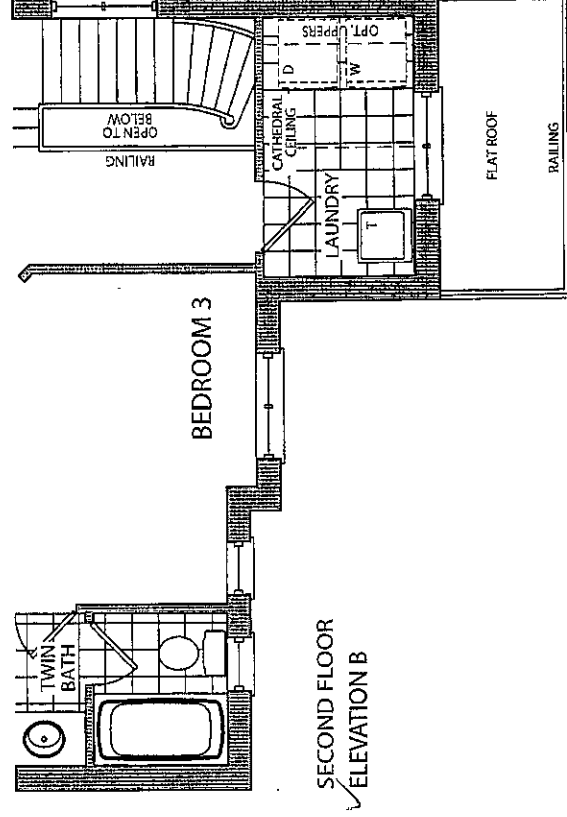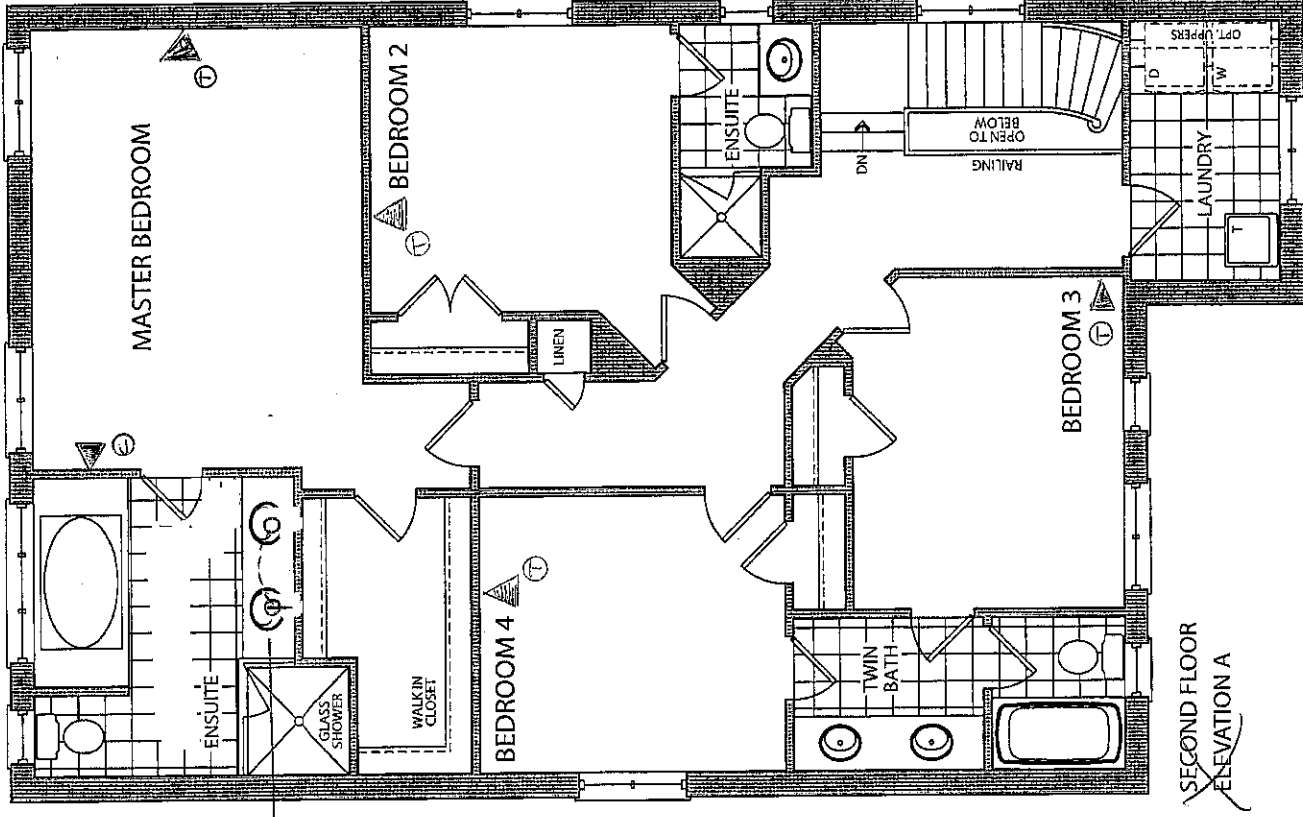

LOT 79

JUNE 27 2016

over
MR

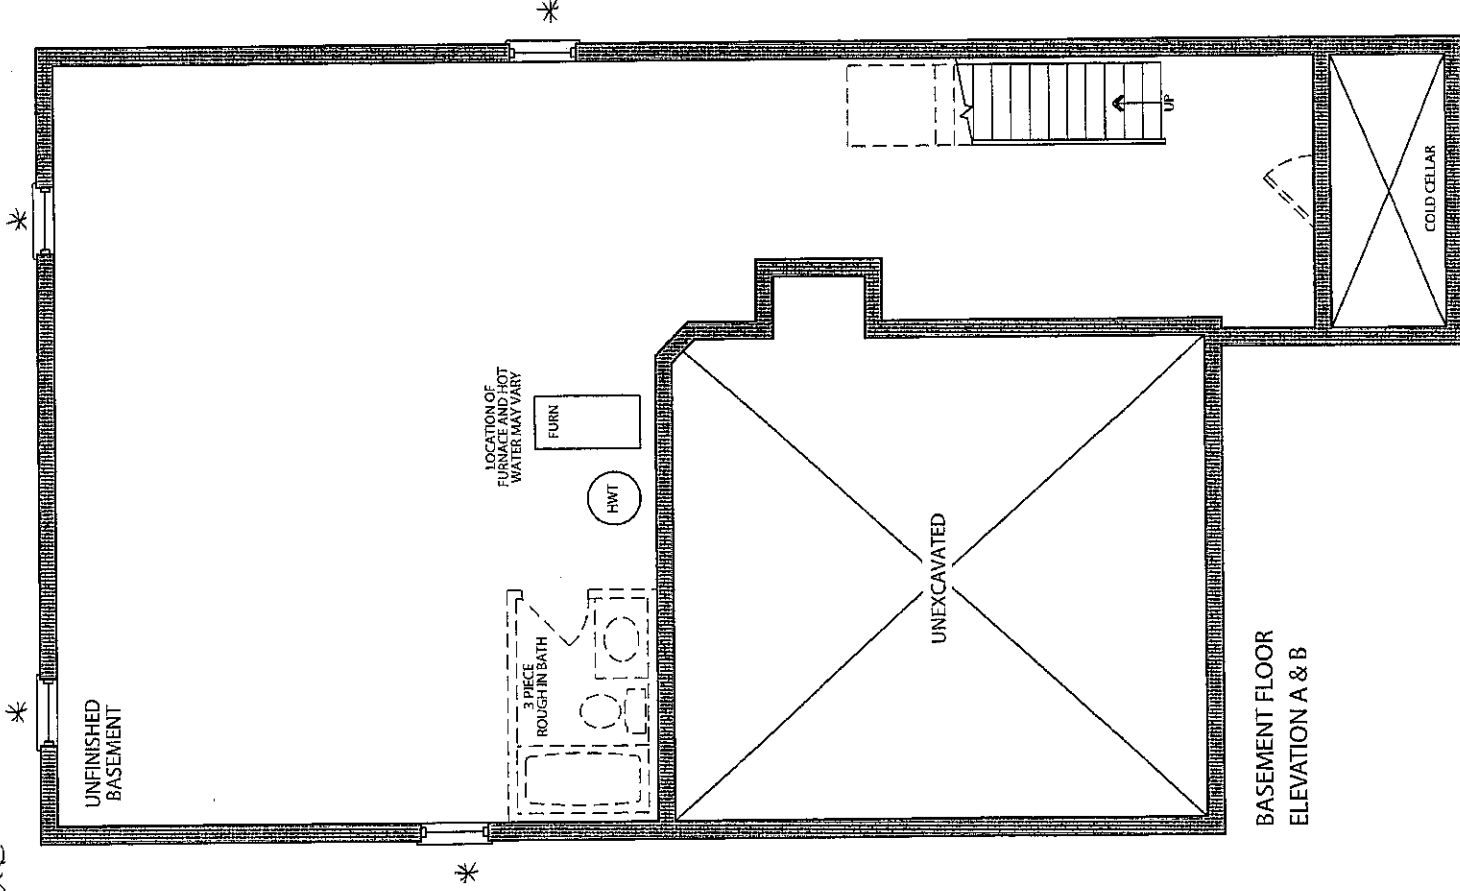

BASEMENT FLOOR
ELEVATION A & B

LARGER
WINDOW
* 24x30




Stacey Carlete
Project Coordinator



Claude Azzopardi
Contracts Manager



Nancy Martini
Corporate Controller

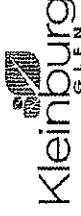

38.1 The Hampton	
Model	
Elevation	A 2339.9 Square Feet
	B 2327.8 Square Feet
Taller Ceilings	GFTC 9' Ceilings Ground Floor
	MFTC 10' Ceilings Main Floor
	SFTC 9' Ceilings Second Floor
Optional Layouts	

38.2 The Kingston	
Model	
Elevation	A 2445.9 Square Feet
	B 2445.9 Square Feet
Taller Ceilings	GFTC 9' Ceilings Ground Floor
	MFTC 10' Ceilings Main Floor
	SFTC 9' Ceilings Second Floor
Optional Layouts	SFA1 SECOND FLOOR Shower in Lieu of Tub (Bedroom 2)

38.3 The Birkdale	
Model	
Elevation	A 2574.1 Square Feet
	B 2575.5 Square Feet
Taller Ceilings	GFTC 9' Ceilings Ground Floor
	MFTC 10' Ceilings Main Floor
	SFTC 9' Ceilings Second Floor
Optional Layouts	SFA1 SECOND FLOOR Shower in Lieu of Tub (Bedroom 2)

38.4 The Bridgeport	
Model	
Elevation	A 2723.2 Square Feet
	B 2762.0 Square Feet
Taller Ceilings	GFTC 9' Ceilings Ground Floor
	MFTC 10' Ceilings Main Floor
	SFTC 9' Ceilings Second Floor
Optional Layouts	SFA3 SECOND FLOOR Shower in Lieu of Tub (Twin Bath)


38.5 The Rosemont	
Model	
Elevation	A 2804.9 Square Feet
	B 2804.5 Square Feet
Taller Ceilings	GFTC 9' Ceilings Ground Floor
	MFTC 10' Ceilings Main Floor
	SFTC 9' Ceilings Second Floor
Optional Layouts	SFA1 SECOND FLOOR Shower in Lieu of Tub (Bedroom 2)
	SFA3 SECOND FLOOR Shower in Lieu of Tub (Twin Bath)
	SFA5 SECOND FLOOR Additional Bedroom

38.6 The Wyndham	
Model	
Elevation	A 2883.5 Square Feet
	B 2896.0 Square Feet
Taller Ceilings	GFTC 9' Ceilings Ground Floor
	MFTC 10' Ceilings Main Floor
	SFTC 9' Ceilings Second Floor
Optional Layouts	SFA1 SECOND FLOOR Shower in Lieu of Tub (Bedroom 2)
	SFA3 SECOND FLOOR Shower in Lieu of Tub (Twin Bath)
	SFA5 SECOND FLOOR Additional Bedroom

June 27 2016

MR

MR

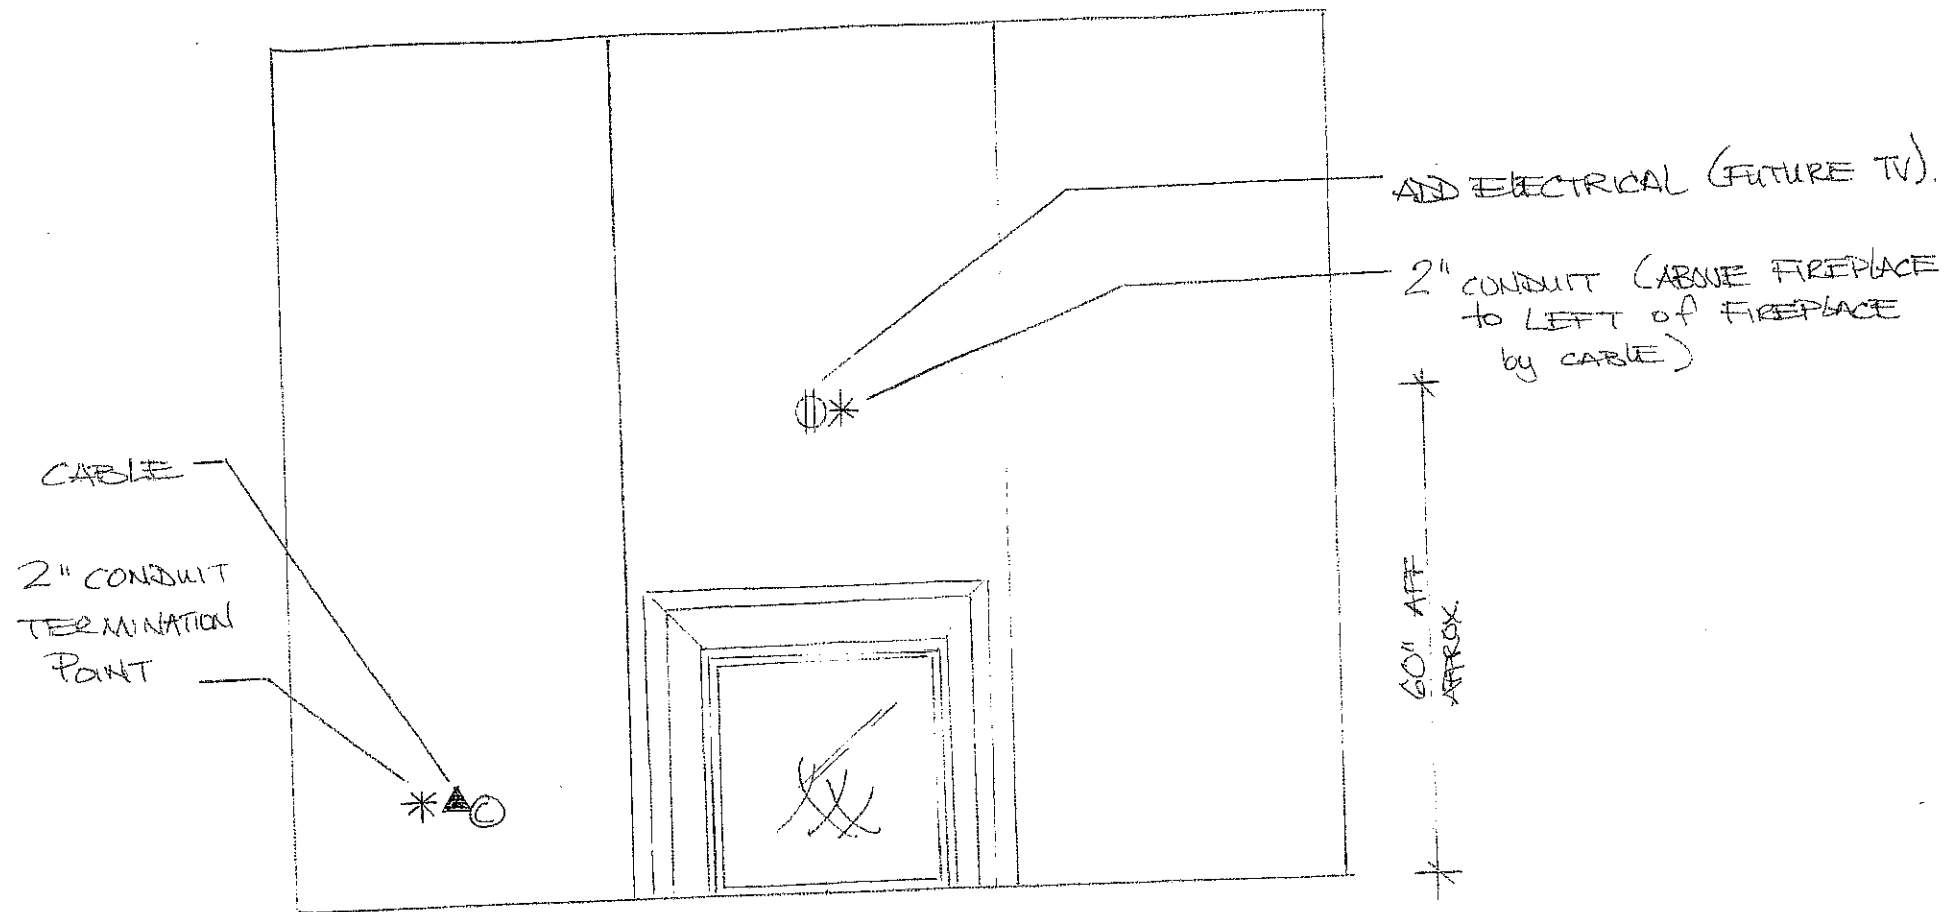

MR
MCE

LOT 79
GREAT ROOM- FIREPLACE ELEVATION
JUNE 27 2016.