

**Kleinburg Glen - 67 - 1 - 38-6 Elev.A WYNDHAM
CENTRAL VAC AND WIRING**

Inv.659	1 - KITCHEN: CONDUIT PIPE - FROM MAIN FLOOR KITCHEN TO ELECTRICAL PANEL - PLEASE SEE FLOOR PLAN FOR LOCATION. TO BE INSTALLED AT 68" AFF.
Line8433	Note:
13Jul16 / 13Oct16	
Inv.659	1 - MUD ROOM: ROUGH - IN FOR EXTRA SECURITY KEY PAD. See floorplan for location
Line8413	Note:
13Jul16 / 13Oct16	
Inv.659	3 - CAT 5 WIRING - ROUGH IN FOR FUTURE SECURITY CAMERAS. 1 x Above right garage. 1 x center of house - Basement Level. 1 x front Portico, top left. Please see floorplan for locations.
Line8414	Note:
13Jul16 / 13Oct16	
Inv.659	1 - GREAT ROOM: CONDUIT PIPE - FOR TELEVISION - TO BE INSTALLED APPROX 68" AFF. PLEASE TERMINATE AT STANDARD HEIGHT, RIGHT SIDE OF FIREPLACE.
Line8416	Note:
13Jul16 / 13Oct16	
Inv.659	1 - GREAT ROOM: CAT 5 WIRING - ADD EXTRA OUTLET AT CONDUIT TERMINATION POINT TO THE RIGHT OF FIREPLACE AT STANDARD HEIGHT.
Line10526	Note: PLEASE SEE FLOORPLAN FOR LOCATION
13Jul16 / 13Oct16	
Inv.659	1 - DEN: CAT 5 WIRING - ADD EXTRA OUTLET. PLEASE SEE FLOORPLAN FOR LOCATION
Line10937	Note:
13Jul16 / 13Oct16	

CERAMIC

Inv.947	1 - THROUGH-OUT: Metal Transitions between hardwood and any other material
Line13515	Note:
8Nov16 / 3Jan17	
Inv.947	1 - POWDER ROOM FLOOR TILE: UPG 4
Line13518	Note:
8Nov16 / 3Jan17	
Inv.947	1 - LAUNDRY FLOOR TILE: UPG 2
Line13519	Note:
8Nov16 / 3Jan17	
Inv.947	1 - MASTER ENSUITE TILE: UPG 4
Line13542	Note:
8Nov16 / 3Jan17	
Inv.947	1 - ENSUITE 3/4 Tub Wall Tile: UPG 1
Line13543	Note:
8Nov16 / 3Jan17	
Inv.947	1 - ENSUITE 2 Tub Wall Tile: UPG 1
Line13544	Note:
8Nov16 / 3Jan17	
Inv.947	1 - MASTER ENSUITE Shower Wall Tile: UPG 1
Line13564	Note:
8Nov16 / 3Jan17	

Kleinburg Glen - 67 - 1 - 38-6 Elev.A WYNDHAM

Inv.947	1 - MASTER ENSUITE: Vertical Accent Wall Tile - Marble Mosaics Polished Marmara Herringbone 0,6"x1,3" Code #GM.MARMARA.HER.BON
Line13565	Note: See Drawings attached for details
8Nov16 / 3Jan17	
Inv.947	1 - MASTER ENSUITE SHOWER FLOOR: UPG 3 Marble Mosaics Polished Marmara Herringbone 0,6"x1,3" Code #GM.MARMARA.HER.BON
Line13566	Note:
8Nov16 / 3Jan17	
Inv.947	2 - MASTER ENSUITE: VANITY SINK - Compac Minuet Square Vessel
Line15599	Note: See spec sheet attached
8Nov16 / 3Jan17	

DRYWALL

Inv.659	1 - SMOOTH CEILINGS - (2 - Story Design) 2ND FLOOR
Line8428	Note:
13Jul16 / 13Oct16	

ELECTRICAL

Inv.659	1 - KITCHEN: 110V WALL RECEPTACLE ON DEDICATED CIRCUIT - FOR MICROWAVE - MICROWAVE NOT INCLUDED. PLEASE SEE FLOORPLAN FOR LOCATION. LEFT OF FRIDGE TO ACCOMMODATE WALL OVEN/MICRO COMBO
Line8419	Note:
13Jul16 / 13Oct16	
Inv.659	3 - KITCHEN: ROUGH - IN CEILING OUTLET ON SAME SWITCH - DOES NOT INCLUDE FIXTURE - 3 OVER ISLAND.
Line8425	Note:
13Jul16 / 13Oct16	
Inv.659	6 - EXTERIOR FRONT: POT LIGHT: 4 INCH LINE VOLTAGE POT LIGHT - (EXTERIOR) - EACH. PLEASE SEE FRONT ELEVATION FOR LOCATIONS.
Line8427	Note:
13Jul16 / 13Oct16	
Inv.659	1 - GREAT ROOM: 110V WALL RECEPTACLE ON NORMAL CIRCUIT - BESIDE CABLE ABOVE FIREPLACE FOR FUTURE TELEVISION. TO BE INSTALLED APPROX. 68" AFF. PLEASE SEE FLOORPLAN FOR LOCATION
Line8418	Note:
13Jul16 / 13Oct16	
Inv.659	1 - KITCHEN: 220V WALL RECEPTICAL ON DEDICATED CIRCUIT - FOR 4 WIRE BUILT - IN WALL OVEN - PLEASE SEE FLOORPLAN FOR LOCATION. LEFT OF FRIDGE TO ACCOMMODATE WALL OVEN/MICRO COMBO
Line8420	Note:
13Jul16 / 13Oct16	
Inv.659	1 - KITCHEN CABINET STRIP VALANCE LIGHTS (UNDER CABINETS) - ROUGH - IN - DOES NOT INCLUDE (AND REQUIRES) KITCHEN UPGRADE PRICING
Line8426	Note:
13Jul16 / 13Oct16	
Inv.659	1 - KITCHEN: 110V WALL RECEPTACLE ON NORMAL CIRCUIT - APPROX 68" AFF NEXT TO CONDUITE PIPE. PLEASE SEE FLOORPLAN FOR LOCATION
Line8434	Note:
13Jul16 / 13Oct16	

Kleinburg Glen - 67 - 1 - 38-6 Elev.A WYNDHAM

Inv.659	1 - GREAT ROOM: RELOCATE STANDARD ELECTRICAL TO THE RIGHT OF FIREPLACE AT STANDARD HEIGHT - NEXT TO CONDUIT TERMINATION AND CAT 5 WIRE. PLEASE SEE FLOORPLAN FOR LOCATION
Line10527	Note:
13Jul16 / 13Oct16	
Inv.659	1 - KITCHEN: 110V WALL RECEPTACLE ON DEDICATED CIRCUIT - GAS FIRED APPLIANCE - FOR AUX. EQUIPMENT - NOT A STOVE PLUG
Line10162	Note:
13Jul16 / 13Oct16	
Inv.659	1 - MASTER BEDROOM: 110V WALL RECEPTACLE ON NORMAL CIRCUIT - APPROX 68" AFF. PLEASE SEE FLOORPLAN FOR LOCATION
Line10528	Note:
13Jul16 / 13Oct16	
Inv.947	1 - PURCHASER TO REMOVE KITCHEN AFTER CLOSING- ELECTRICAL PURCHASED AT STRUCTURAL WILL NOT MATCH STANDARD KITCHEN LAYOUT
Line15855	Note:
8Nov16 / 3Jan17	

FRAMING

Inv.659	1 - MAIN FLOOR CEILING 10FT- INCLUDES: TALLER FRONT DOOR WITH TRANSOM, TALLER FRONT AND REAR ELEVATION WINDOWS OR WITH TRANSOM, EXTRA TALL FLAT ARCHES, 8' TALL INTERIOR DOORS, WITH KITCHEN CROWN AND FURRING PANEL,
Line8435	Note:
13Jul16 / 13Oct16	
Inv.659	1 - MASTER ENSUITE: UPGRADE TO FREE STANDING TUB - UPG1 ONLY
Line12632	Note:
13Jul16 / 13Oct16	
Inv.659	1 - GREAT ROOM: DELETE STANDARD MANTLE AND BUILD UP TO CEILING. PLEASE SEE SKETCH ATTACHED.
Line10152	Note:
13Jul16 / 13Oct16	
Inv.659	1 - 2ND FLOOR: EXTENDED HEIGHT ARCHWAY (PRICE PER DOORWAY) - 1 IN HALLWAY IN FRONT OF MASTER BEDROOM, 1 - DELETE WALK IN CLOSET DOOR AND REPLACE WITH EXTENDED HEIGHT ARCHWAY, 1 - WALK WAY TO ENSUITE/WIC. PLEASE SEE FLOORPLAN FOR LOCATIONS
Line12633	Note:
13Jul16 / 13Oct16	
Inv.659	1 - 2ND FLOOR: STANDARD DOOR EXTENDED HEIGHT 96 INCH (PRICE PER DOOR)
Line12634	Note:
13Jul16 / 13Oct16	

GLASS AND MIRROR

Inv.659	1 - MASTER ENSUITE: CONVERT FRAMED SHOWER TO 10MM FRAMELESS SHOWER ENCLOSURE WITH DOOR AND 10MM SIDE PANEL
Line8431	Note:
13Jul16 / 13Oct16	

HARDWOOD

Inv.947	1 - MAIN FLOOR HALLWAY / DEN / DINING ROOM / KITCHEN / GREAT ROOM / ALL LANDINGS / UPPER HALL: UPG 5 Hardwood Vintage Solid Sawn Hand Scraped Character Pearl White Oak 5" Gotham
Line13513	Note:
8Nov16 / 3Jan17	

Kleinburg Glen - 67 - 1 - 38-6 Elev.A WYNDHAM

Inv.947	1 - FOYER: UPG 5 Hardwood Vintage Solid Sawn Hand Scraped Character Pearl White Oak 5" Gotham
Line13514	Note:
8Nov16 / 3Jan17	
Inv.947	1 - THROUGH-OUT: Metal Transitions between hardwood and any other material
Line15853	Note:
8Nov16 / 3Jan17	

HVAC

Inv.659	1 - KITCHEN: UPGRADE VENTING FOR STOVE TO 8 INCH PIPE EXTERIOR WALL.
Line8423	Note:
13Jul16 / 13Oct16	
Inv.659	1 - KITCHEN: GAS LINE ROUGH - FOR FUTURE GAS COOKTOP. SEE FLOORPLAN FOR LOCATION
Line8422	Note:
13Jul16 / 13Oct16	

INTERIOR TRIM AND DOORS

Inv.659	16 - 2ND FLOOR: STANDARD DOOR EXTENDED HEIGHT 96 INCH (PRICE PER DOOR)
Line8437	Note:
13Jul16 / 13Oct16	
Inv.659	3 - 2ND FLOOR: EXTENDED HEIGHT ARCHWAY (PRICE PER DOORWAY) - 1 IN HALLWAY IN FRONT OF MASTER BEDROOM; 1 - DELETE WALK IN CLOSET DOOR AND REPLACE WITH EXTENDED HEIGHT ARCHWAY, 1 - WALK WAY TO ENSUITE/WIC. PLEASE SEE FLOORPLAN FOR LOCATIONS
Line8438	Note:
13Jul16 / 13Oct16	
Inv.659	1 - MAIN FLOOR CEILING 10FT- INCLUDES: TALLER FRONT DOOR WITH TRANSOM, TALLER FRONT AND REAR ELEVATION WINDOWS OR WITH TRANSOM, EXTRA TALL FLAT ARCHES, 8' TALL INTERIOR DOORS, WITH KITCHEN CROWN AND FURRING PANEL,
Line12631	Note:
13Jul16 / 13Oct16	

KITCHEN AND BATH CABINETRY

Inv.659	1 - MAIN FLOOR CEILING 10FT- INCLUDES: TALLER FRONT DOOR WITH TRANSOM, TALLER FRONT AND REAR ELEVATION WINDOWS OR WITH TRANSOM, EXTRA TALL FLAT ARCHES, 8' TALL INTERIOR DOORS, WITH KITCHEN CROWN AND FURRING PANEL,
Line12629	Note:
13Jul16 / 13Oct16	
Inv.659	1 - MAIN FLOOR CEILING 10FT- INCLUDES: TALLER FRONT DOOR WITH TRANSOM, TALLER FRONT AND REAR ELEVATION WINDOWS OR WITH TRANSOM, EXTRA TALL FLAT ARCHES, 8' TALL INTERIOR DOORS, WITH KITCHEN CROWN AND FURRING PANEL,
Line12630	Note:
13Jul16 / 13Oct16	
Inv.947	1 - ENSUITE 2: Vanity Cabinet Stain
Line13562	Note:
8Nov16 / 3Jan17	

MISC.

Kleinburg Glen - 67 - 1 - 38-6 Elev.A WYNDHAM

Inv.659	1 - Purchaser has attended a Structural appointment at the Decor Centre & has DECLINED any additional upgrades and accepts and acknowledges that there will be no further structural changes/additions/deletions to be made upon signing on Aug 8, 2016.
Line10153	Note:
13Jul16 / 13Oct16	

Inv.659	1 - BONUS PACKAGE: \$7,500.00 (INCLUDING TAXES) WORTH OF UPGRADES FROM GOLD PARK HOMES DÉCOR CENTRE IS BEING APPLIED TOWARD THE STRUCTURAL APPOINTMENT. PURCHASER HAS A REMAINING AMOUNT OF \$00 (INCLUDING TAXES) TO BE USED TOWARD THE COLOUR APPOINTMENT.
Line10155	Note:
13Jul16 / 13Oct16	

Inv.659	1 - Purchasers are aware & accepts that ANY changes made to upgrades after signing this Purchasers Extra Form are subject to a minimum administration fee of \$500. PLUS a 10% holdback fee.
Line10154	Note:
13Jul16 / 13Oct16	

Inv.659	1 - Purchaser request that all upgrades from this purchaser's extras form to be added to the purchase price. Purchaser is aware that upgrades will be processed only after the builder receives approval letter from the bank.
Line10156	Note:
13Jul16 / 13Oct16	

Inv.659	1 - BALANCE AFTER CREDIT: \$40,457.20
	50% DEPOSIT: \$20,228.60
	50% ON CLOSING: \$20,228.60
Line10158	Note:
13Jul16 / 13Oct16	

Inv.947	1 - Purchasers are aware & accepts that ANY changes made to upgrades after signing this Purchasers Extra Form are subject to a minimum administration fee of \$500. PLUS a 10% holdback fee.
Line15602	Note:
8Nov16 / 3Jan17	

Inv.947	1 - Purchaser has attended a Colour appointment at the Decor Centre & has DECLINED any additional upgrades and accepts and acknowledges that there will be no further structural changes/additions/deletions to be made upon signing.
Line15601	Note:
8Nov16 / 3Jan17	

Inv.947	1 - STAIRCASE - The purchaser was advised and therefore accepts and acknowledges that the stain of the staircase and flooring chosen do not match. This difference might result in an undesirable colour variance.
Line15603	Note: The purchaser agrees that the vendor is to be exempt from any and all claims by the purchaser regarding this colour variance.
8Nov16 / 3Jan17	

Inv.947	1 - Purchaser Accepts Standard Appliance Openings:
	Fridge - 37-1/2"W x 73-1/2" High Approx.
	Range - 30-1/2"D x 31-1/2"W Approx.
	Dishwasher - 24" W Approx
Line15604	Note:
8Nov16 / 3Jan17	

Inv.947	1 - PAID FOR IN FULL BY CC. 2 PAYMENTS
Line15605	Note:
8Nov16 / 3Jan17	

PAINT

Inv.947	1 - STAIRS: STAIN - Handrail and Treads / PAINT - White Risers & Stringers
Line13535	Note:
8Nov16 / 3Jan17	

PLUMBING

Kleinburg Glen - 67 - 1 - 38-6 Elev.A WYNDHAM

Inv.659	1 - MASTER ENSUITE: UPGRADE TO FREE STANDING TUB - UPG1 ONLY
Line8432	Note:
13Jul16 / 13Oct16	

STAIRS AND RAILINGS

Inv.947	1 - STAIRS: UPG To Euroline R6 with V-Groove handrail with Square Posts/Caps.
Line13568	Note:
8Nov16 / 3Jan17	
Inv.947	1 - STAIRS: STAIN - Handrail and Treads / PAINT - White Risers & Stringers
Line15854	Note:
8Nov16 / 3Jan17	

TRIM AND DOORS

Inv.947	1 - UPG- MAIN FLOOR & 2ND FLOOR TRIM & BASEBOARDS: *****UPG 2 Angus Riverwalk*****
Line13560	Note: ASK ROB FOR TRIM CODE
8Nov16 / 3Jan17	

Purchasers: Mariapia Bifolchi & Daniele Bifolchi Property: 67
Telephone Res. / Bus: (416) 727-0522 Project: Burkshire Holdings Inc.
Decor Advisor: Laura Lofaro Model and Elevation: 38-6 Elev.A WYNDHAM

Layout Changes: ☐ Yes ☐ No Sketch Attached: ☐ Yes ☐ No Exterior Colour Scheme:

1. Cabinetry

	Style and Colour	Counter	Hardware
Kitchen / Breakfast	Toscana PVC AntWhite	Grigio Sardo STD Edge FE20	CS1-24
Laundry Room	N/A		
Powder Room	N/A		
Master Ensuite Bathroom	Varese PVC Silver	Wilsonart Black Alicante 4926K-07	CS1-23
Second Ensuite Bathroom (If Applicable)	*Siena Oak Graphite	Wilsonart Calacutta Marble 4925K-07	CS1-23
Ensuite 3/4	Toscana PVC WhtCryst	Wilsonart Pearl Soapstone 4886-38	CS1-23
Dishwasher Cabinet	N/A		

Comment

HOME OWNER TO REMOVE STANDARD KITCHEN AND REPLACE WITH OWN CUSTOM AT OWN EXPENSE AND WARRANTY AFTER CLOSING.
Electrical requests for Kitchen at Structurals will not match standard layout. Home owner aware and accepts.

2. Floor Tile

	Selection	Grout	Threshold
Entrance Vestibule	*See Hardwood		
Main Hall	*See Hardwood		
Kitchen / Breakfast	*See Hardwood		
Laundry Room	*12x24 Land Series Grigio (Grey)		
Powder Room	*12x24 Carrera X Series White Polished		
Master Ensuite Bathroom	*12x24 Carrera X Series White Polished		
Second Ensuite Bathroom (If Applicable)	12x12 Sacramento White		
Lower Landing (If Applicable)	*See Hardwood		
Ensuite 3/4	12x12 Sacramento Grey		

Comment

3. Wall Tile

	Selection	Listello/Inserts	Describe
Master Ensuite Bathroom		☐ Yes ☐ No	
Tub Deck	N/A	☐ Yes ☒ No	
Shower Stall	*4x12 Chess Arctic White Bevelled	☒ Yes ☐ No	
Bathroom Walls	N/A	☐ Yes ☒ No	
Second Ensuite Bathroom (If Applicable)	*4x12 Chess Tender Grey Bevelled	☐ Yes ☒ No	
Ensuite 3/4	*CDC 4x16 Sterling Grey Bright	☐ Yes ☒ No	
Kitchen Backsplash	☐ Yes ☒ No		Backsplash Behind Fridge

Comment

Free Standing Tub for Master Ensuite
** See Master Ensuite Shower Accent Wall and Shower Floor** Vertical Accent Wall Tile - Marble Mosaics Polished Marmara Herringbone 0.6"x1,3"
Code #GM.MARMARA.HER.BON



INTERIOR COLOUR SCHEME

*** NOTE: This is not an approved document. Document must be locked ***

Scheduled Closing Date: November-07-16

Purchasers: Mariapia Bifulchi & Daniele Bifulchi
Telephone Res. / Bus: (416) 727-0522
Decor Advisor: Laura Lofaro

Property: 67
Project: Burkshire Holdings Inc.
Model and Elevation: 38-6 Elev.A WYNDHAM

4. Plumbing Fixtures

☐	Second Ensuite	☐	Powder Room	☐
☐	Master Ensuite Bathroom	☐	Other Room - Specify	☐
☐	Other Room - Specify	☐	Other Washroom	☐

Comment

STD Throughout Except for Master Ensuite Sinks: Compac Minuet Square Vessel X2. See spec sheet attached
* Master UPG TO Free standing Tub at structurals

5. Hardwood Flooring

	Type and Stain		Type and Stain
Main Hall	*Vintage SS WhtOak HS Gotham	Upper Landing	*Vintage SS WhtOak HS Gotham
Kitchen / Breakfast	*Vintage SS WhtOak HS Gotham	Upper Hall	*Vintage SS WhtOak HS Gotham
Living Room	N/A	Master Bedroom	N/A
Dining Room	*Vintage SS WhtOak HS Gotham	Bedroom #2	N/A
Family Room	N/A	Bedroom #3	N/A
Den/Library	*Vintage SS WhtOak HS Gotham	Bedroom #4	N/A
Entrance Vestibule	*Vintage SS WhtOak HS Gotham	Bedroom #5	N/A
Lower Landing (If Applicable)	*Vintage SS WhtOak HS Gotham	Other Room - Specify	*Vintage SS WhtOak HS Gotham
		Great Room	

Comment

*Vintage White Oak Solid Sawn Gotham 5"

6. Carpeting

	Upgrade	Description
Main Hall	☐	N/A
Living Room	☐	N/A
Dining Room	☐	N/A
Family Room	☐	N/A
Den/Library	☐	N/A
Upper Hall	☐	N/A
Master Bedroom	☐	T15
Bedroom #2	☐	T15
Bedroom #3	☐	T15
Bedroom #4	☐	T15
Bedroom #5	☐	N/A
	☐	
Upper Landing (If Applicable)	☐	N/A
Lower Landing (If Applicable)	☐	N/A

	Type	Area
Upgrade Underpad	N/A	
Carpet on Stairs	Capped	Runner - *Upgrade
	N/A	

Comment

Standard Underpad Throughout

*** NOTE: This is not an approved document. Document must be locked ***
Scheduled Closing Date: November-07-16

Purchasers: Mariapia Bifulchi & Daniele Bifulchi Property: 67
Telephone Res. / Bus: (416) 727-0522 Project: Burkshire Holdings Inc.
Decor Advisor: Laura Lofaro Model and Elevation: 38-6 Elev.A WYNDHAM

7. Fireplace

	Living Room		Family Room		Other Room - Specify	
	Purchased	As Per Plan	N/A	Purchased	As Per Plan	N/A
Fireplace Type	☐	☐	☐	☐	☐	☒
Mantle Type						STD
Colour / Stain						N/A
Surround						N/A
Hearth						N/A

Comment

Wall built up to ceiling - notes from Structural - Mantle Deleted

8. Trim Carpentry

Interior Doors	STD	Front Door Glass Inserts	STD	Door Handles	STD
Interior Trim	***UPG 2 ANGUS MAIN & 2ND FLOOR, ASK ROB*****				

Comment

9. Plaster Mouldings and Medallions

	N/A		Kitchen/Breakfast	N/A
Entrance Vestibule				
Main Hall			Den/Library	
Living Room			Lower Landing	
Dining Room			Other Room - Specify	
Family Room				

Comment

10. Railings and Spindles

Railing Package	V-Groove Handrail, Euroline R6
Railing Colour	Vintage Gotham
Stringer / Riser	White

Comment

Square Pickets - See sketch attached

Spindle Colour	Black Wrought Iron
Treads	Vintage Gotham
Oak Stairs	☒ Yes ☐ No

11. Wall Paint

	Master Bedroom
Main & Upper Hall	
Living Room	
Dining Room	
Kitchen / Breakfast	
Family Room	
Powder Room	
Laundry Room	
Den/Library	
Trim Paint	White
Comment	Smooth Ceilings First Floor

Cool White Throughout



INTERIOR COLOUR SCHEME

*** NOTE: This is not an approved document. Document must be locked ***

Scheduled Closing Date: November-07-16

Purchasers: Mariapia Bifulchi & Daniele Bifulchi Property: 67
Telephone Res. / Bus: (416) 727-0522 Project: Burkshire Holdings Inc.
Decor Advisor: Laura Lofaro Model and Elevation: 38-6 Elev.A WYNDHAM

12. Electrical

Plugs and Switches ☒ White ☐ Ivory

Above Kitchen Cabinet Light ☐ Yes ☒ No

Hood Fan ☐ White ☐ Ivory

Below Kitchen Cabinet Light ☐ Yes ☒ No

Appliances

Built in Cooktop

☐ Yes ☐ No ☐ Yes ☐ No

Built in Oven

Gas Stove

☒ Yes ☐ No ☐ Yes ☐ No

Microwave

Comment

Homeowner to remove standard kitchen and accommodate appliances at own expense and warranty after closing

13. Heating and Air Conditioning

Air Conditioning

Gas Provisions Stove

Gas Provisions Dryer

Gas Provisions Barbecue


Comment

14. Additional Comments

15. Disclaimers and Notes

- 1) Colours of all materials are as close as possible to builder's selection, but not necessarily identical due to variances in manufacturing.
- 2) Any extras listed above are null and void unless accompanied by a separate invoice/amendment. Said invoice must be paid in full.
- 3) The Purchaser acknowledges that after Interior Colour Selection form is signed and dated, no further changes will be permitted other than re-selection due to unavailability. Purchaser's Initials
- 4) The Purchaser acknowledges reading and accepting the "Gold Park Homes Decor Centre Disclaimers" form. This document contains other miscellaneous disclaimers.



This Interior Colour Selection is final and approved by:

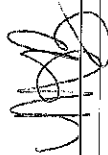Signature: 

Date: Dec. 19 / 16 Signature:

Date:

- Standard 2CM & 3CM
- Upgrade 1 2CM & 3CM
- Upgrade 1 4 CM
- Upgrade 2

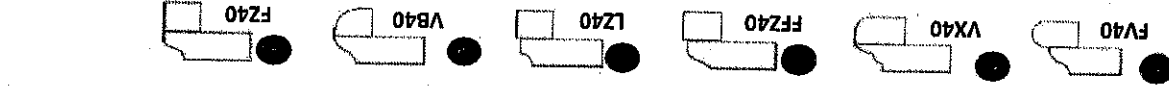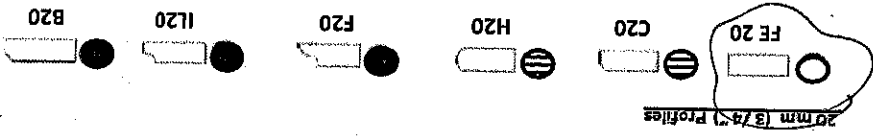

Note: All colours may not be available in 30mm at time ordered. Vendor reserves the right to use 40 mm edges (by lamination process).

*Mitre edge is available in Upgrade 1 for an overall thickness of 2". All other Mitre edge options will be an Upgrade 2 Edge.


STO KUTZEN STUK

DEC. 19, 2016

Handwritten initials

KG - 67

ACCENT APPROX 2 FT IN FROM
OUTSIDE WALL

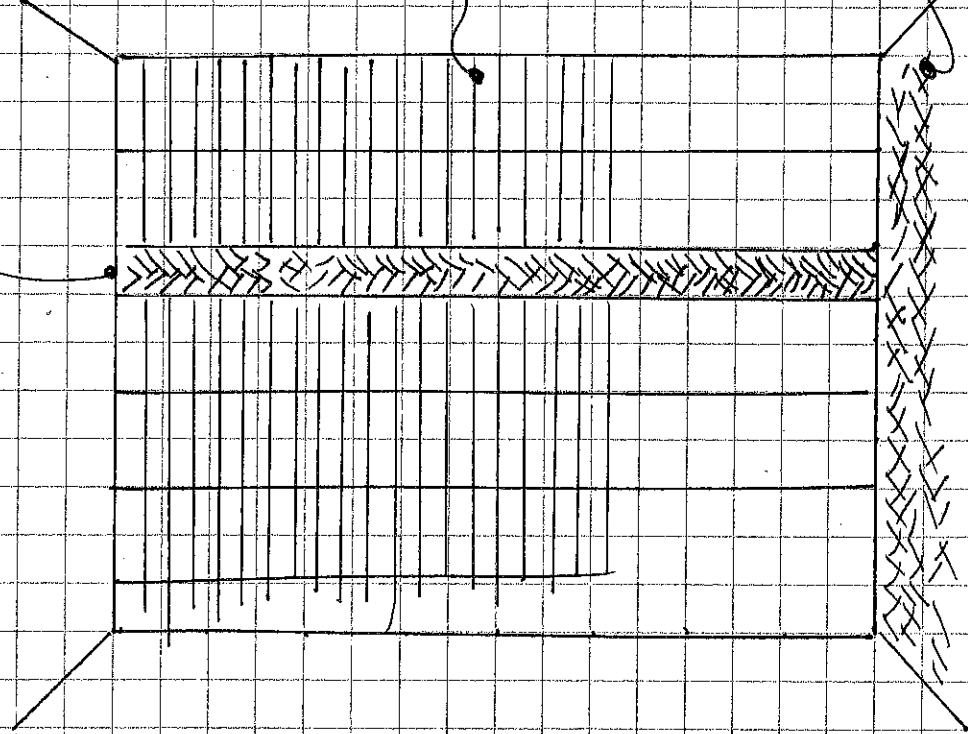

4x12 CHESATEAUX WHITE
BEVELLED
HORIZONTALLY SPOKED
2 FULL TIES FROM
OUTSIDE WALLS

FLOOR + VERTICAL ACCENT
APPROX 4-6"
MARBLE MOSAIC'S POC.
MARINARA DEPARTMENT
0.6" x 1.3" CODE:
GM. MARINARA HER. BON

KG. 60167

MPB

Dec. 19, 2016

Minuet

rectangular vessel lavatory

13-0024-W



Finish

Soft white vitreous china
Nano-easy clean glaze



**Overflow
Rear**



**Template
Supplied**




**Faucet drilling
Single hole**




Dimensions

19" (W) x 15 1/4" (D) x 6 1/4" (H)

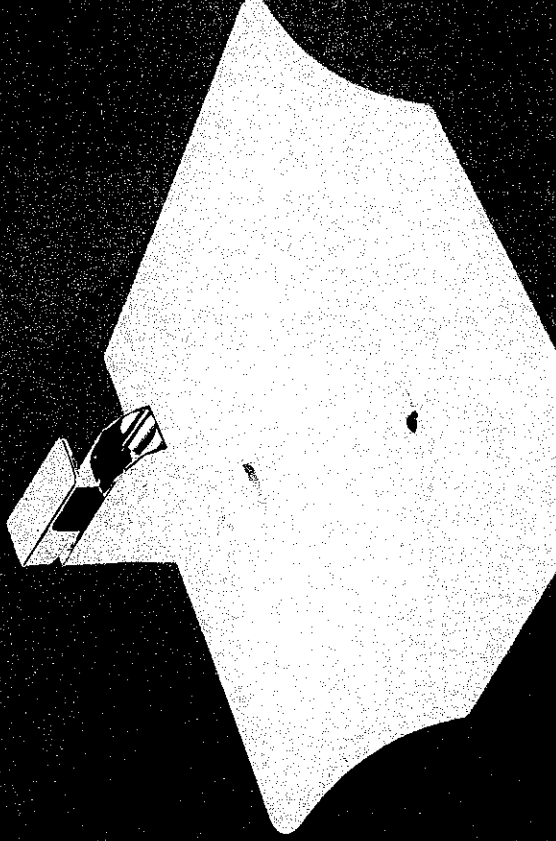


LOT No.: 67	
ROOM: MASTER ENSUITE X2	
DATE: DEC. 19. 2016	SIGNATURE:
Kleinfelder	GOLDPARK WORTH MORE


STANDARD HARDWARE

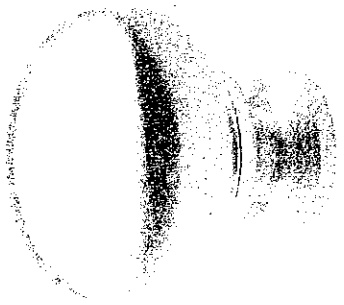


CSI-6

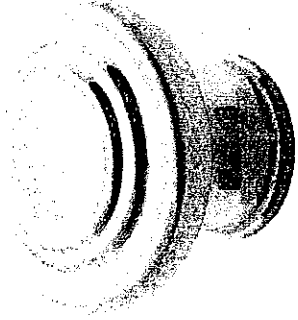


CSI-10

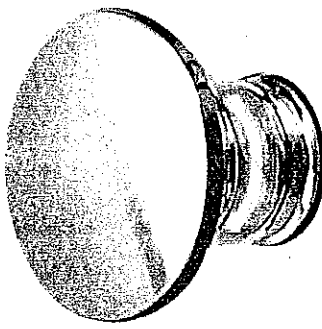


CSI-14

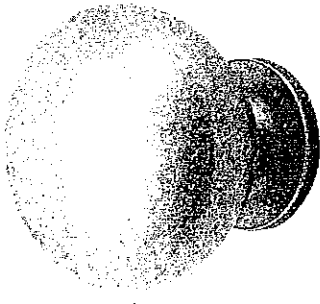


CSI-16

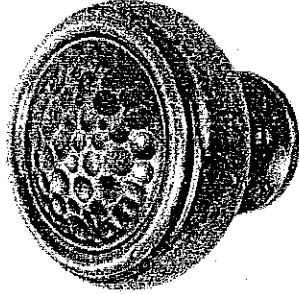


CSI-18

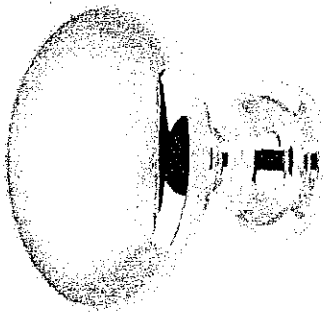


CSI-19

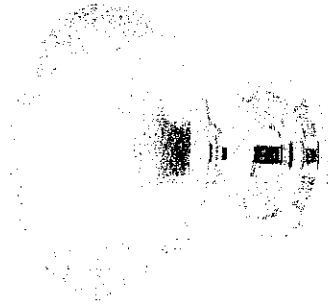

CSI-20

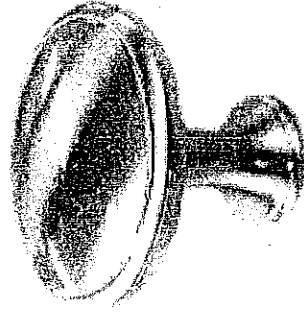


CSI-21

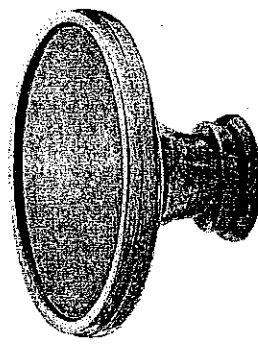


CSI-22


MASTER ENSUITE
→ SECOND ENSUITE / ENSUITE 3/4

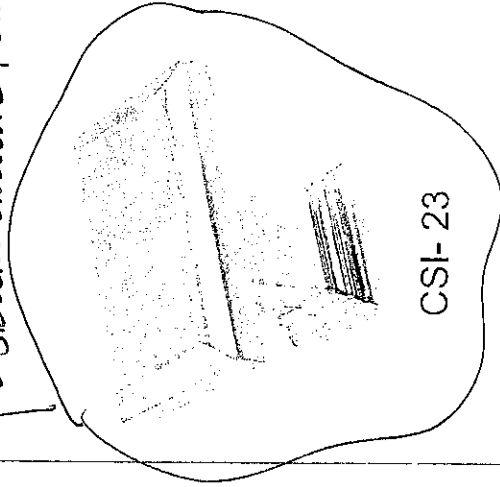

CSI-23

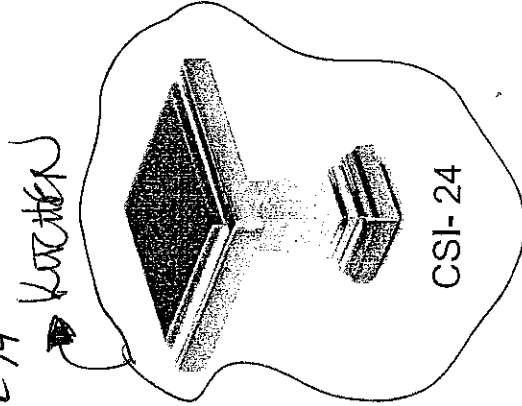

CSI-24

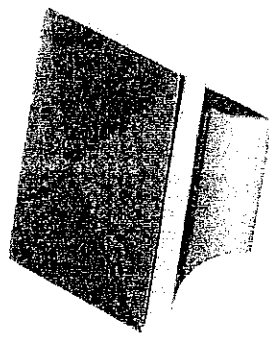

CSI-25

K6. lot 67

*NOTES:

- IMAGES ARE FOR QUICK REFERENCE PURPOSES ONLY
- ACTUAL SIZES AND FINISHES AS PER HARDWARE
- SAMPLE BOARD PROVIDED TO DECOR CENTRE



Dec 19. 2016

CORTINA

KITCHENS INC.

70 Regina Road Woodbridge ON L4L 8L6
905-264-6464

CHARCOAL STAIN INFORMATION

Builder: GOLDPARK HOMES Project: KENNEDY BLVD Lot #: 67

Charcoal is a spray stain applied to Oak and Maple products with several characteristics that are important to be aware of when purchasing this product.

1. Shadow lines may be visible at the interior profile edges of a door or drawer front. If movement occurs shadow lines may increase or decrease, depending on the style and/or size of a door or drawer front.
2. Variation and unevenness may be visible in the finish.
3. Hairline cracks at the joints are created over time due to the nature of natural wood, caused by usage, humidity**, or dryness. They tend to be more visible to darker stains, than lighter wood stains.

** Relative humidity is recommended to be between 45% and 55%. Please refer to Cortina Kitchens "Cleaning, Care, Maintenance, & Warranty Information" guide.

Please be advised that Cortina Kitchens will not replace doors and/or parts that exhibit the above characteristics associated with this finish. These characteristics are not avoidable and are a result of the natural characteristics of wood and wood veneer, and the characteristics of darker stains on wood.

The Charcoal stain is not available on doors in Group IV, Group IVA, Group V and Group VA.

Thank you for your understanding.

I am well informed of this information, and agree to the purchase of any of the subject finishes listed above.

Purchaser: [Signature] Date: DEC. 19, 2016

November 2012

CORTINA

KITCHENS INC.

70 Regina Road Woodbridge ON L4L 8L6
905-264-6464

INFORMATION - PVC DOORS

Builder: Gold Park Homes Project Lot # 07

All cabinets with PVC (Thermofoil) Doors come with melamine gables, panels and kick. The doors, crown moulding and light valance are PVC wrapped. Open shelves incorporated in design will only be available with melamine interiors. There will be variations in colour shades between the PVC parts (doors, crown and Light valance) and the melamine parts (open shelves, Gables, Panels and Kick) due to the difference in material.

Furring Panel with crown moulding to the ceiling is not available on all PVC door styles due to subtle variations in colour shades between the PVC parts (moulding) and the melamine parts (furring panel) due to the difference in material. Grain directions in wood grain pattern melamine, vary between the furring panel, crown moulding (horizontal) and the PVC doors (vertical).

Thank you for your understanding.

I am well informed of this information, and agree to the purchase of the above.

Purchaser: [Signature] Date: Dec. 19, 2016

CORTINA

70 Revere Road, Woodbridge, Ontario L4L 8L6
Tel: 905-284-4464 Fax: 905-284-0684
www.CortinaKitchens.com

QUOTATION

Date: 28/06/16

Trade Name: Gold Park Homes

Site location:

Model: 38-6


Address:

Project: Kleinburg Glen

Phase:

This layout has been explained to the purchaser by Cortina Kitchens Inc. and is understood by the purchaser.

NEED CEMENT FROM STRUCTURAL
DOES NOT MATCH STD
KITCHEN. PURCHASER IS
AWARE AND ACCEPTS #.

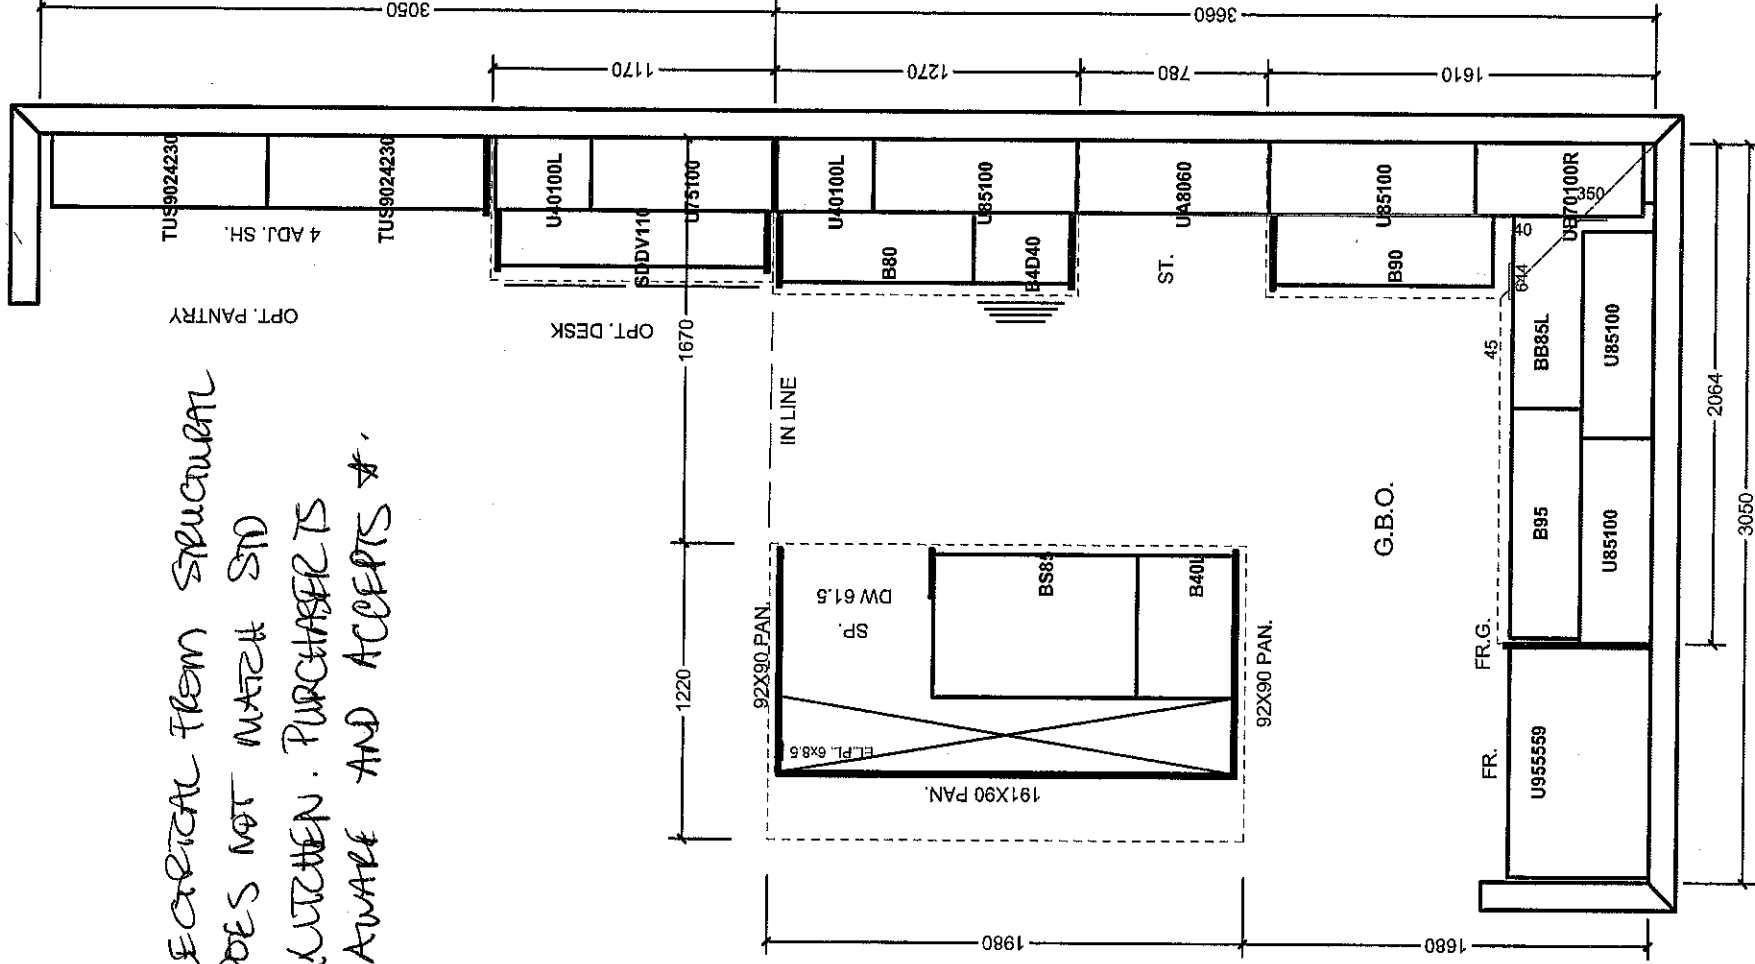

All prices subject to confirmation from head office.
This quotation is subject to the terms & conditions set out

All agreements are contingent upon strikes, accidents, and delays beyond our control.
Please provide our installer with template for sinkholes or \$150.00 will be charged for callback.

ACCEPTED DATE: DEC. 19. 2016

Lot 67

X [Signature]

Item A. Wood grain and colour are characteristics of the product. We cannot guarantee that such grain and colour will always match.
Item B. Cortina Kitchens Inc. reserves the right to alter dimensions and make technical changes without notice.

CORTINA





70 Regina Road, Woodbridge, Ontario L4L 8L8
Tel: 905-264-0084 Fax: 905-264-0084
www.CortinaKitchens.com

QUOTATION

Date: 28/06/16


Trade Name: Gold Park Homes	Site location:	Model: 38-6
Address:	Project: Kleinburg Glen	Phase:

This layout has been explained to the purchaser by Cortina Kitchens Inc. and is understood by the purchaser.

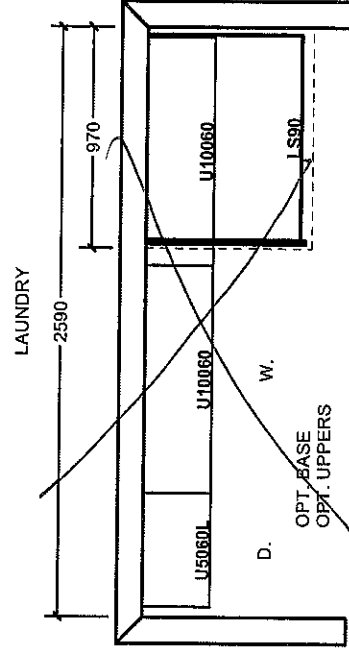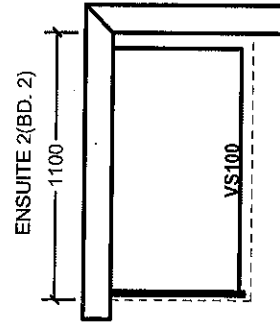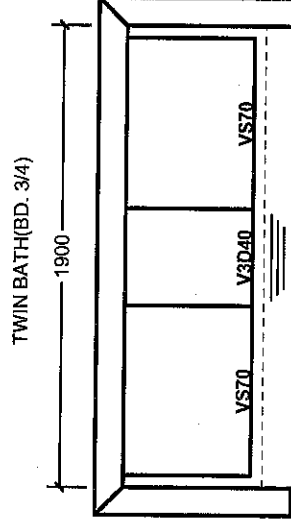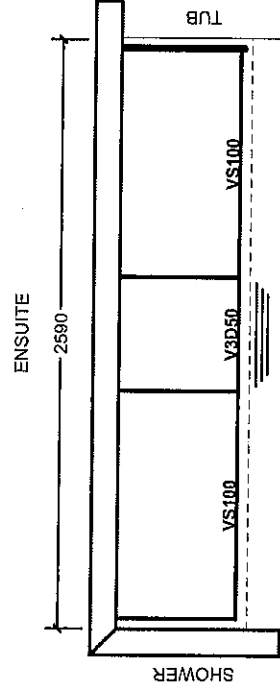


OPT. 5 BED. SECOND FLOOR


TWIN BATH(BD. 2/3)

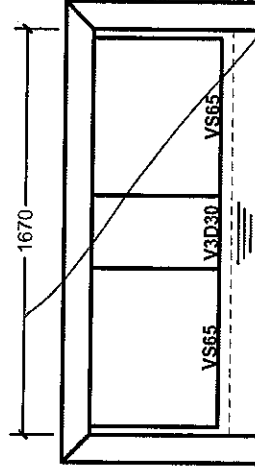


TWIN BATH(BD. 4/5)

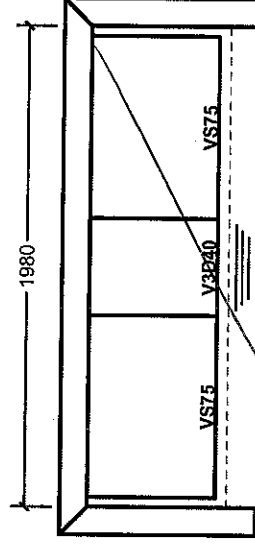

ENSUITE

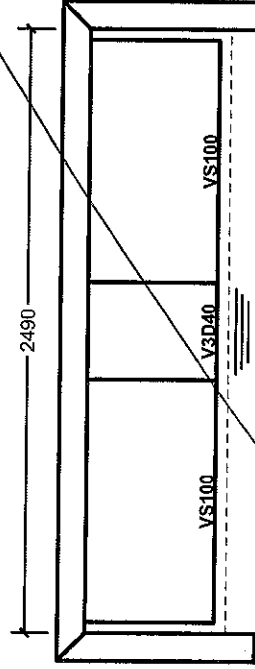

PART SECOND FL. W/SH.

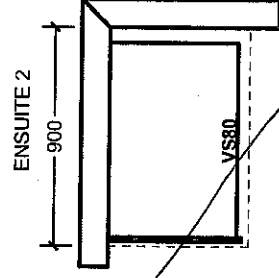

All prices subject to confirmation from head office.

This quotation is subject to the terms & conditions set out

All agreements are contingent upon strikes, accidents, and delays beyond our control. Please provide our installer with template for sinkholes or \$150.00 will be charged for callback.

ACCEPTED DATE: Dec. 19. 2016

LOT 67

[Signature]

Item A. Wood grain and colour are characteristics of the product. We cannot guarantee that such grain and colour will always match.
Item B. Cortina Kitchens Inc. reserves the right to alter dimensions and make technical changes without notice.


Elevation A • 2,951 sq.ft.
Elevation B • 2,954 sq.ft.

CONDUIT TERMINATION + CABLE + CAT'S POINT. STD. HEIGHT


DELETE STANDARD
#P. MANTLE + BUILD
FRAME UP TO
CEILING. SEE
ATT'D SKETCH.

* 110V
+ CONDUIT ABOVE
+ REPLACE APPROX. 68" AFF

* CONDUIT AT 68" AFF
TERMINATING AT
ELECTRICAL PANEL
+ 110V NEXT TO CONDUIT
APPROX 68" AFF.

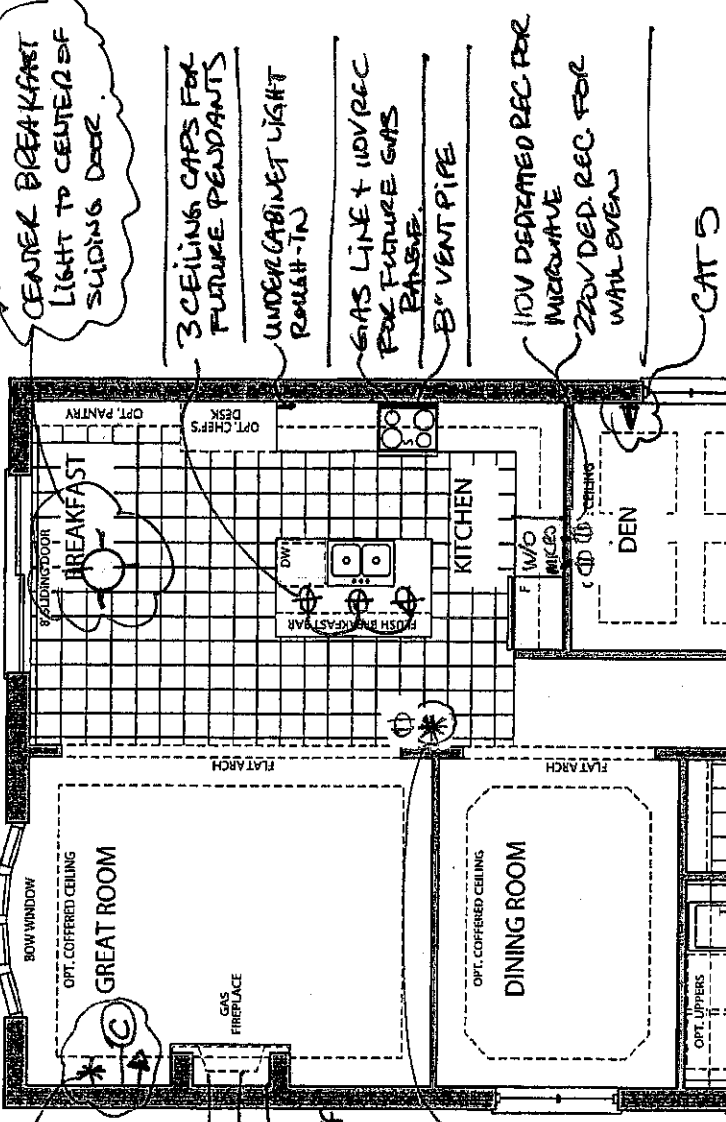

GROUND FLOOR
ELEVATION A

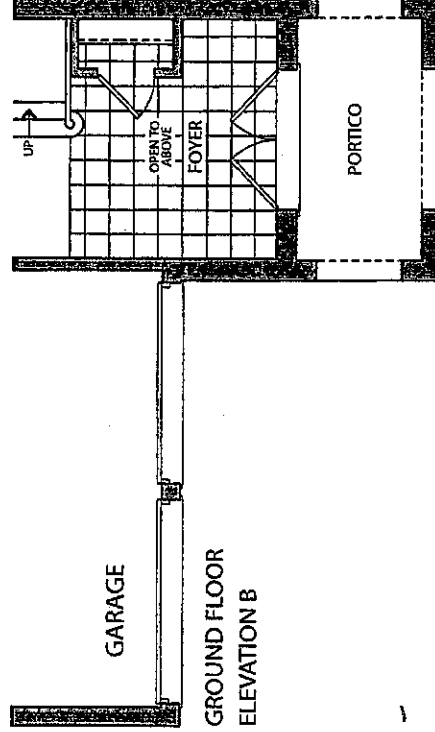


GROUND FLOOR
ELEVATION B

- 10FT MAIN FLOOR -

FREE STANDING
TUB

Elevation A • 2,951 sq.ft.

Elevation B • 2,954 sq.ft.

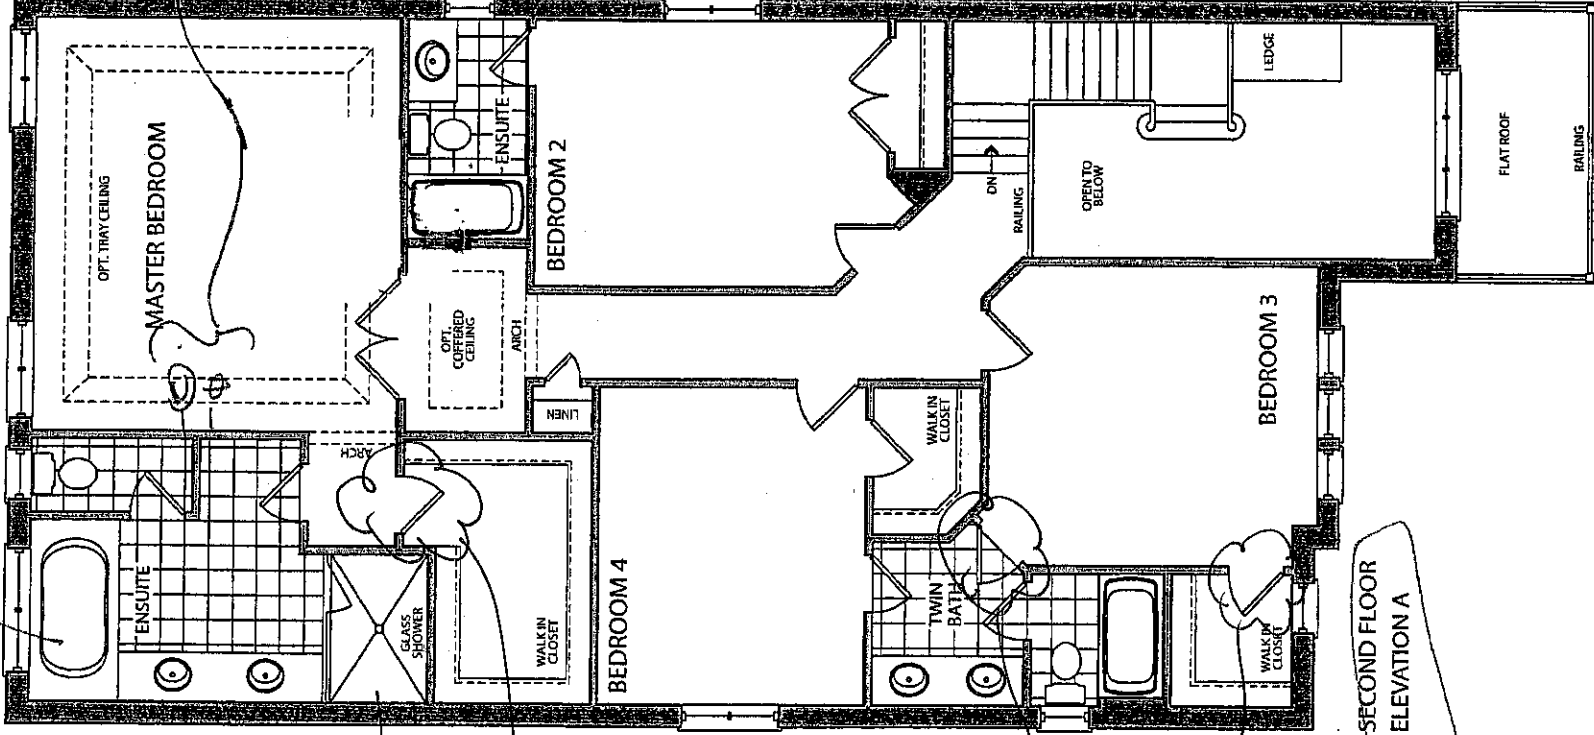


FRAMELESS
SHOWER

DELETE
W.I.C. DOOR.
ARCHWAY
ONLY

SWING DOOR
INTO BEDROOM
NOT INTO
BATHROOM'S
W.I.C.

CABLE & 110V RECEPTACLE
AT APPROX 68" AFF
FOR FUTURE TV

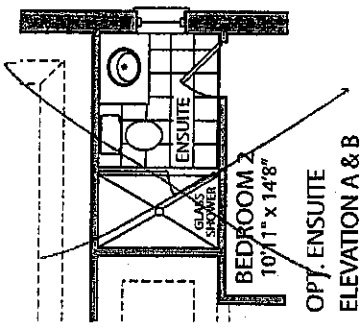


Colours

DEC. 19. 2016

STRUCTURAL

LOT 67

SEA. 6. 2016

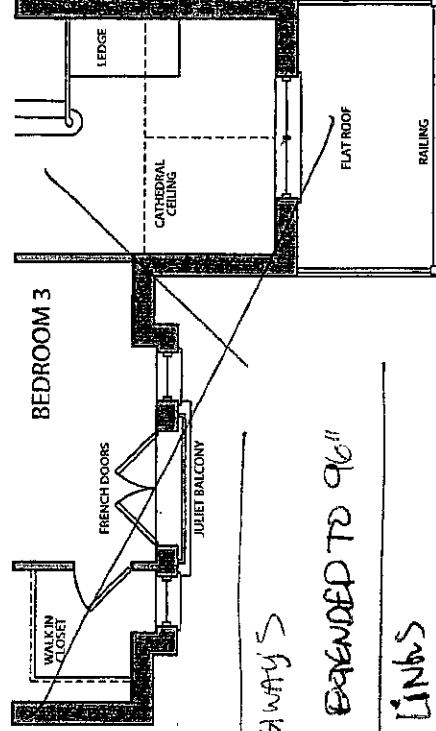


EXTENDED ARCHWAY'S

DOOR HEIGHTS EXTENDED TO 96"

SMOOTH CEILING'S

Elevation A • 2,951 sq.ft.

Elevation B • 2,954 sq.ft.

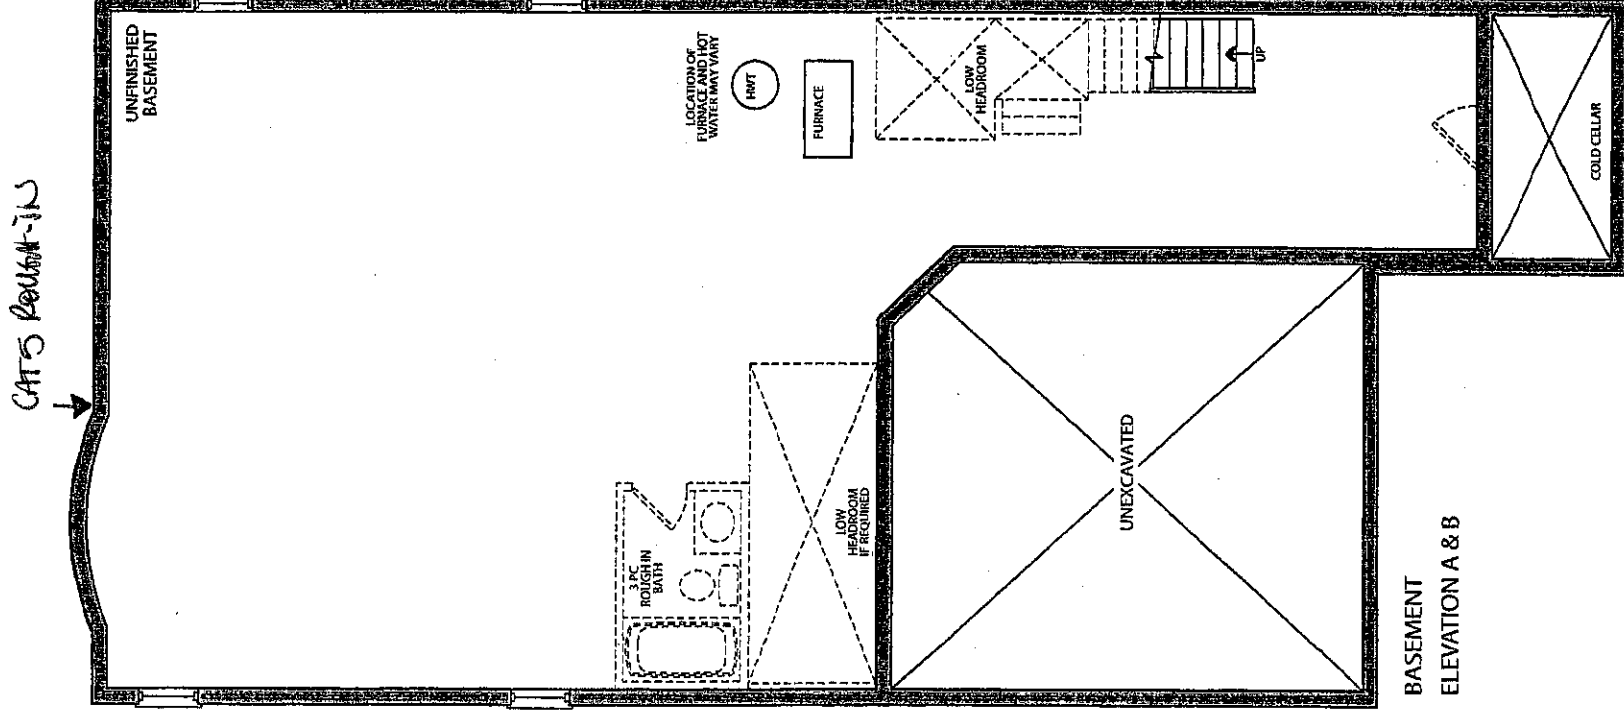

Covers

DEC. 19, 2016

STRUCTURAL

Lot 67

SEP. 6, 2016

SEP. 6, 2016