

CONSTRUCTION MODIFICATION / CLARIFICATION

LOT 3R –Kleinburg Glen

PROJECT- Kleinburg Glen

UPGRADE

- Replace existing 12" x 30" rear basement windows
- Install two 24" x 30" rear basement windows

Thank you

DATE ISSUED: 2/15/17


ISSUED BY: Stacey Carlete



the Hudson

Elevation A • 1,898 sq.ft.


Elevation B • 1,898 sq.ft.

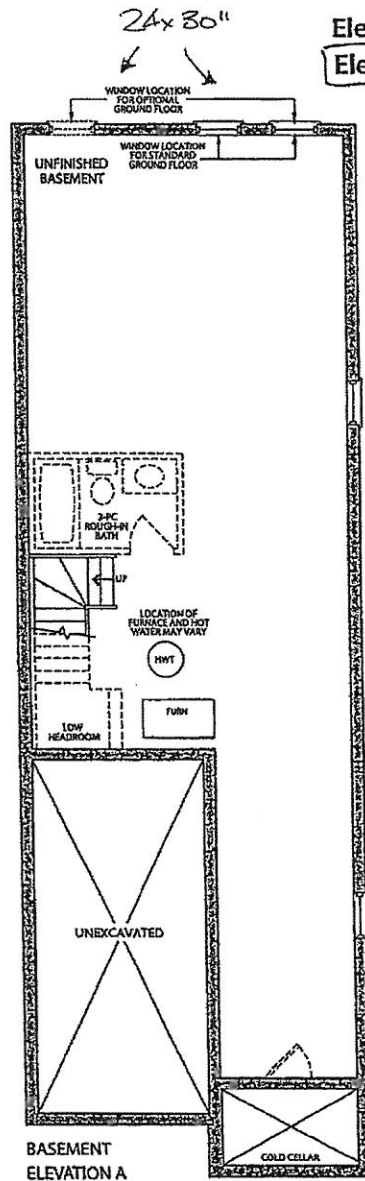

14x24x30" * 24x30"

14x24x30" * 24x30"

KG-3R
FEB. 9 2017

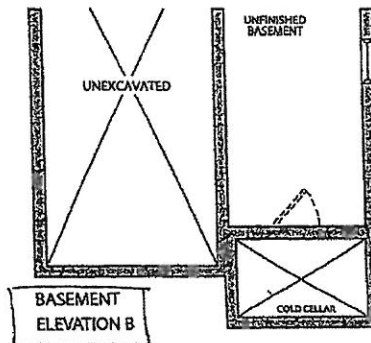

LDT 3R



Prices, figures, illustrations, sizes, features and finishes are subject to change without notice. E&O.E. Areas and dimensions are approximate and actual usable floor space may vary from the stated area. Layout may be reverse of the unit purchased. E. & O.E.

GOLDpark
HOMES