

CONSTRUCTION MODIFICATION / CLARIFICATION

LOT 8R –Kleinburg Glen

PROJECT- Kleinburg Glen

UPGRADE

Kitchen

- Delete uppers above stove to accommodate for chimney style hood. Homeowner to install hood after closing.

Electrical

- Delete uppers above stove to accommodate for chimney style hood. Homeowner to install hood after closing.

Thank you

DATE ISSUED: 2/15/17

ISSUED BY: Stacey Carlete

Trade Name: Gold Park Homes

Site location: Kleinburg

Model: 25-6

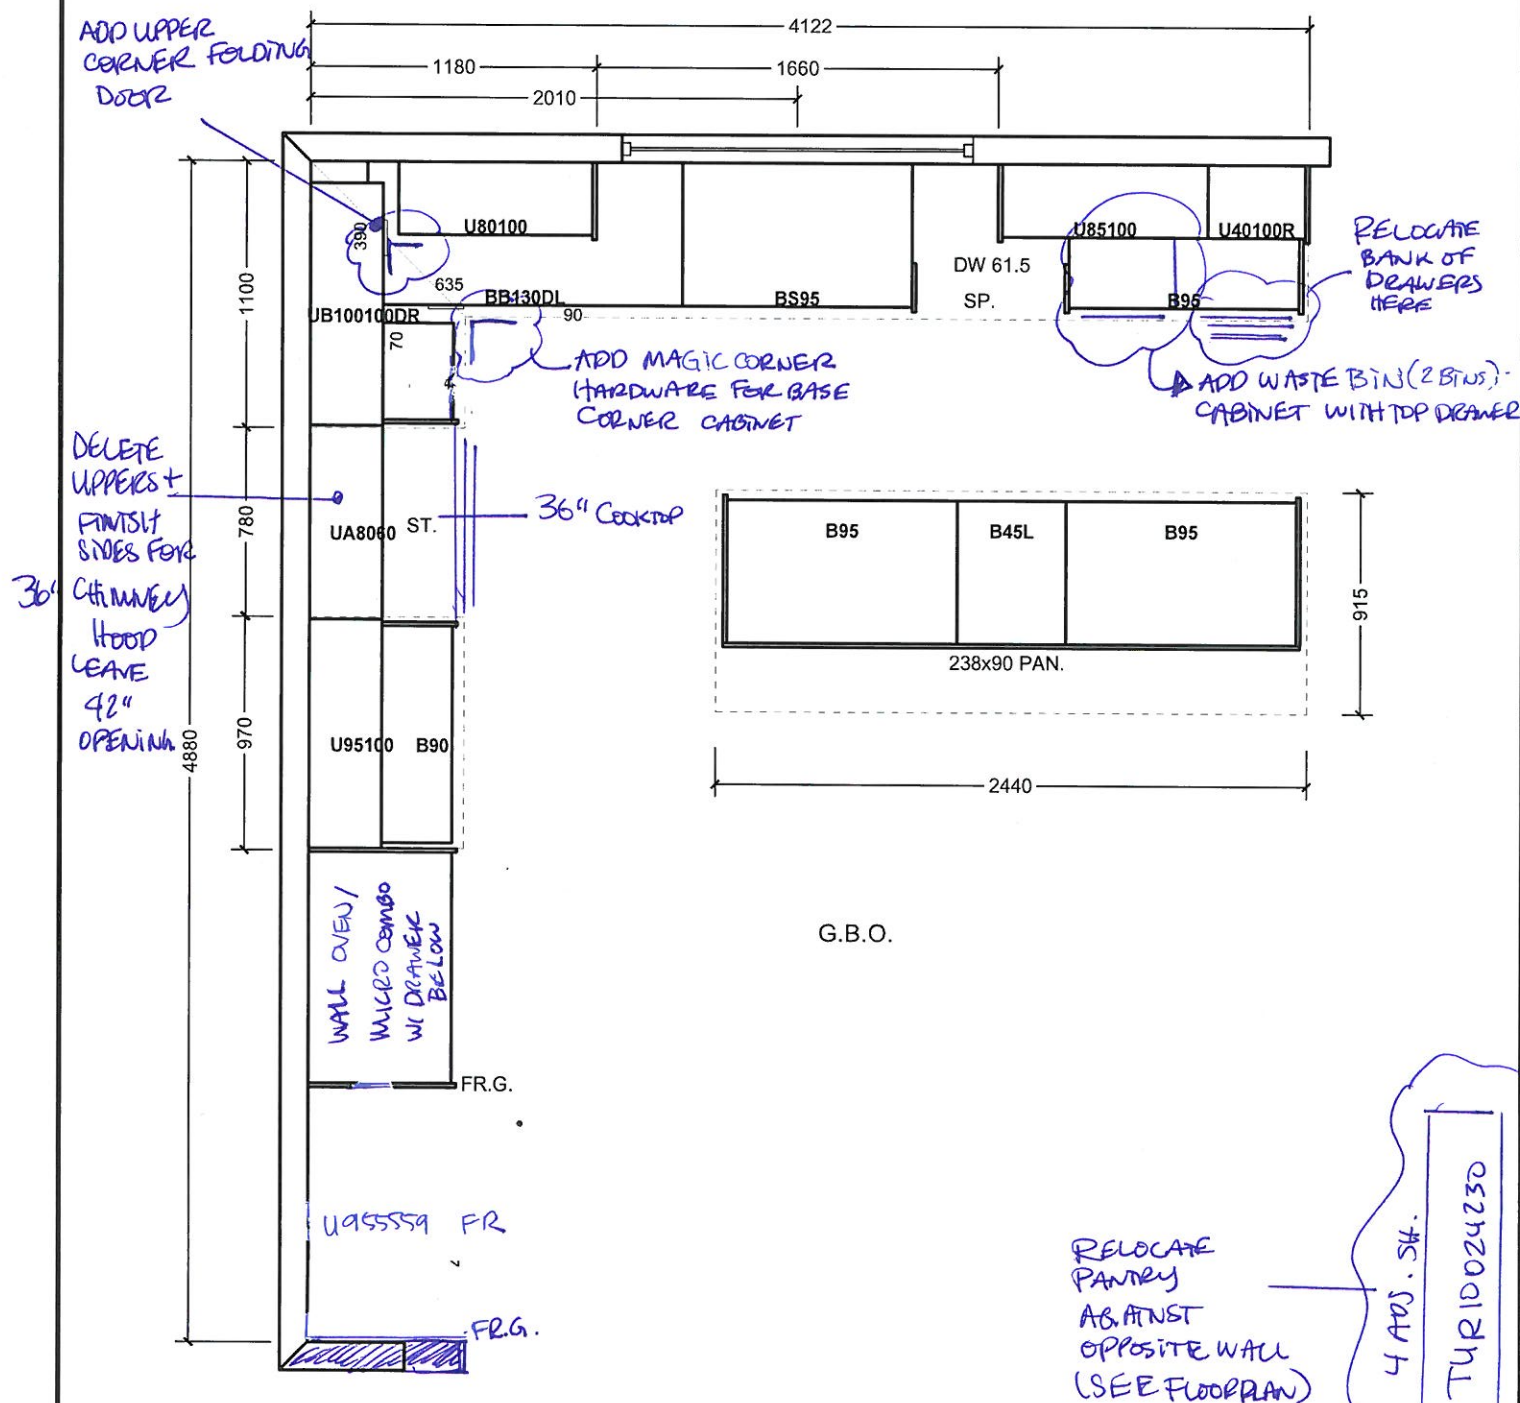
Address:

Project: Kleinburg Glen

Phase:

This layout has been explained to the purchaser by Cortina Kitchens Inc. and is understood by the purchaser.

OPT. MAIN FLOOR KITCHEN

All prices subject to confirmation from head office.
This quotation is subject to the terms & conditions set out

ACCEPTED DATE:

FEB 2. 2017

All agreements are contingent upon strikes, accidents, and delays beyond our control.
Please provide our installer with template for sinkholes or \$150.00 will be charged for callback.

LOT 8R

Florentino Rose