

February 15, 2017

CONSTRUCTION MODIFICATION / CLARIFICATION

LOT 69 –Kleinburg Glen

PROJECT- Kleinburg Glen

UPGRADE

Drywall and Paint

- Smooth Ceilings on Second Floor


Thank you

DATE ISSUED: 2/15/17

ISSUED BY: Stacey Carlete

Elevation A • 2,861 sq.ft.


Elevation B • 2,861 sq.ft.

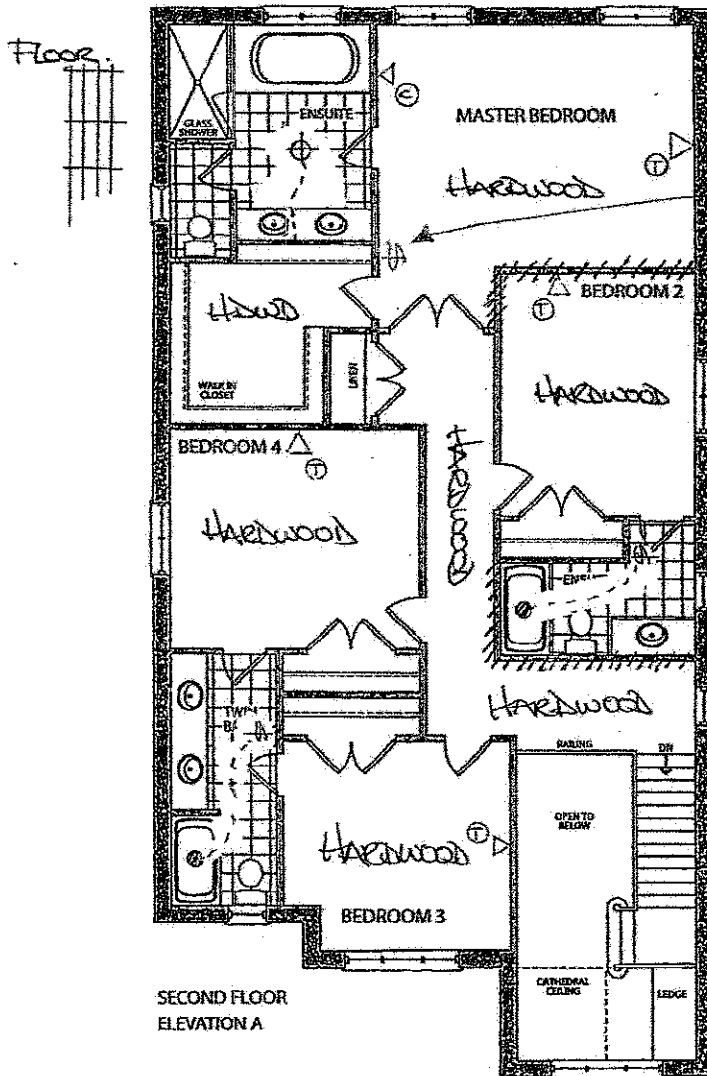

LOT 69


July 21 2016

REQUEST: switch location for WIC light

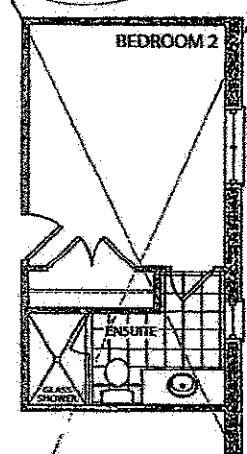

OPT. ENSUITE
ELEVATION A & B

//// = INSULATE
WALL

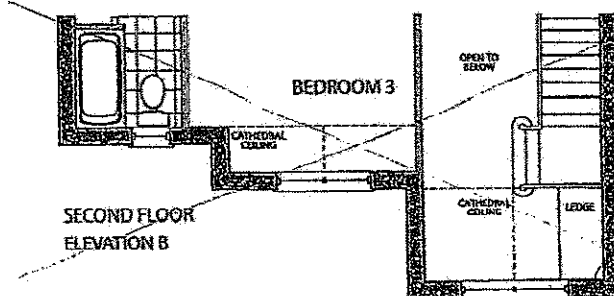

KG-69

Nov 8 2016

KG-69

Feb 2 2017

SMOOTH CEILING ON
2ND FLOOR