Schedule 1: Designer Information

Use one form for each individual who reviews and takes responsibility for design activities with respect to the project.

A. Project Information					
Building number, street name			Unit no. 38-04 `B'	Lot/con.	
Municipality VAUGHAN	Postal code	Plan number/ other desc 65M-4500	1000 1000 1000 No. 10		
B. Individual who reviews and	takes responsib				
Name		Firm			
Julio Pinzon		RN Design Limited		Ti	
Street address 8395 Jane Street			Unit no. 203	Lot/con.	
Municipality Postal code		Province	E-mail		
Vaughan	L4K 5Y2	Ontario	juliop@rnde	sign.com	
Telephone number	Fax number		Cell number		
(905) 738-3177	(905) 738				
C. Design activities undertaken b					
		- House	☐ Building St		
Small Buildings		ng Services	☐ Plumbing -		
☐ Large Buildings☐ Complex Buildings		tion, Lighting and Power rotection		- All Buildings wage Systems	
Description of designer's work		ToteCtion	☐ OII-site Se	wage Systems	
Review of the site plan design ar	nd working draw	ings for Lot 74 model B	RIDGEPORT 38-0	4 'B' REV.	
Design responsibility excludes a					
the OBC.	•				
D. Declaration of Designer					
IJulio Pinzon		declare the	at (choose one as ap	propriate):	
(print name)					
☑ I review and take responsib	ility for the design	work on behalf of a firm regis	tered under Division	C, Part 3,	
subsection 3.2.4. of the Bui	lding Code. I am qu	ualified, and the firm is regist	ered, in the appropria	ate	
classes/categories:					
Individual BCIN:	38688	_			
Firm BCIN:	26995				

☐ I review and take responsibility for the design work and am qualified in the appropriate category as an "other					
designer" under Division C,	Part 3, subsection	3.2.5 of the Building Code.			
Individual BCIN: _					
Basis for exemption	from registration:				
		on and qualification requirem	ents of the Building	Code.	
Basis for exemption from I	registration and qua	alification:			
I certify that:					
The information contained in	this schedule is tru	e to the best of my knowledg	e.		
I have authority to bind the co	orporation or partne	ership (if applicable).			
			7		
A		1-1-1	17 =		
August 24, 2016 Date	2 000000000000000000000000000000000000	Signature o	f Designer		
Date		Signature o	Designer		

*For the purposes of this form, "individual" means the "person" referred to in Division C, Part 3, Clause 3.2.4.7. (1)(d), Division C, Part 3, Article 3.2.5.1. and all other persons who are exempt from qualification under Division C, Part 3, Subsections 3.2.4. and 3.2.5.

NOTE:

- 1. Firm and Individual BCIN numbers are not required for building permit applications submitted prior to January 1, 2006
- Schedule 1 does not need to be completed by architects, or holders of a Certificate of Practice or a Temporary License under the Architects
 Act

It is the builder's complete responsibility to It is the builder's complete responsibility to ensure that all plans submitted for approval fully comply with the Architectural Guidelines and all applicable regulations and requirements including zoning provisions and any provisions in the subdivision agreement. The Control Architect is not responsible in any way for examining or approving site (lotting) plans or working drawings with respect to any zoning or building code or permit matter or that any house can be properly built or located on its lot.


This is to certify that these plans comply with the applicable Architectural Design Guidelines approved by the City of VAUGHAN.

ARCHITECTURAL REVIEW & APPROVAL AUG 22 2016

John G. Williams Limited, Architect

NOTE:
UNDER-SLAB WEEPER DRAIN NETWORKS TO BE INSTALLED TO CAPTURE
GROUND WATER SEEPAGE ASSOCIATED WITH SEASONAL AND PERIODIC
HIGH WATER TABLE WITH THE SHALLOW SAND UNIT BENEATH THE SITE.
UNDER-SLAB DRAINAGE NETWORK TO CONSIST OF 100mm DIAMETER
PERFORATED TILES WRAPPED IN GEOTEXTILE AND EMBEDDED IN CSA FINE
CONCRETE AGGREGATE AT MAXIMUM 5000 OVC, BENEATH BASEMENT SLAB.
PERIMETER AND UNDER-SLAB DRAINS TO BE DRAINED BY GRAVITY INTO THE
MUNICIPAL STORM SEWER SERVICES.



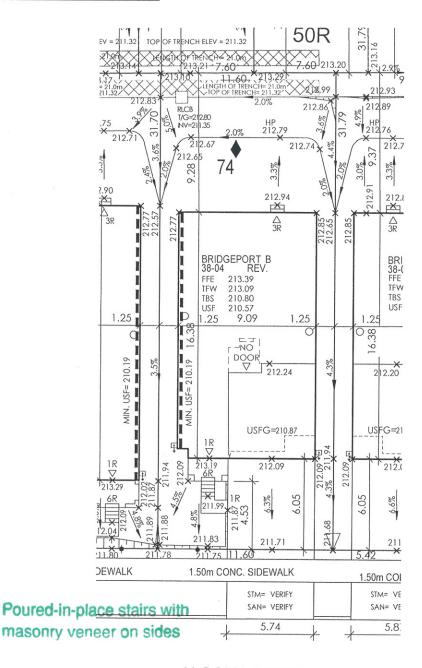

ALGOMA DRIVE

SITE PLAN REVIEW

LOT NO ... 74 65M-4500 ... REGISTERED PLAN ...

THE PROPOSED LOT GRADING AND DRAINAGE IS APPROVED AS BEING IN CONFORMITY WITH THE OVERALL APPROVED GRADING PLANS FOR THE SUBDIVISION.

THIS REVIEW DOES NOT WARRANT THAT OTHER INFORMATION SHOWN ON THIS DRAWING IS ACCURATE OR COMPLETE. SC RESPONSIBILITY FOR THE DESIGN AND DETAILS SHALL REMAIN WITH THE DESIGNER.

NO COMMENT

☐ REVIEWED BY ...

COMMENTS AS NOTED

□ DATE AUG.18 2016





IOTE: BUILDER TO VERIFY LOCATION OF ALL HYDRANTS, STREET IGHTS, TRANSFORMERS AND OTHER SERVICES. IF MIN. DIMENSIONS IRE NOT MAINTAINED BUILDER IS TO RELOCATE AT HIS OWN EXPENSE

REG. PLAN No. 65M-4500 ZONE RD4 LOT NUMBER LOT 74 LOT AREA(m)² 368.17 BLDG AREA(m)² NA LOT COVERAGE(%) NA No. OF STOREYS MEAN HEIGHT(m) 10.01 PEAK HEIGHT(m) NA DECK LINE(m) NA

LEGEND						
FFE	FINISHED FLOOR ELEVATION	\boxtimes	BELL PEDESTAL			
TFW	TOP OF FOUNDATION		CABLE PEDESTAL			
	WALL		CATCH BASIN			
TBS	TOP OF BASEMENT SLAE		DBL. CATCH BASIN			
USF	UNDER SIDE FOOTING	*	ENGINEERED FILL			
USFR	UNDER SIDE FOOTING @		HYDRO CONNECTION			
USFG	UNDER SIDE FOOTING @	P	FIRE HYDRANT			
00.0	GARAGE TOP OF ENGINEERED	SL	STREET LIGHT			
TEF	FILL	$\geq \leq$	MAIL BOX			
R	NUMBER OF RISERS TO GRADE		TRANSFORMER			
WOD	WALKOUT DECK	\triangle	SEWER CONNECTIONS 2 LOTS			
LOB	LOOKOUT BASEMENT	7	SEWER CONNECTIONS 1			
WOB	WALK OUT BASEMENT	4	WATER CONNECTION			
REV	REVERSE PLAN	9	WATER VALVE			
STD	STANDARD PLAN	_	CHAMBER			
Δ	DOOR		HYDRANT AND VALVE			
0	WINDOW	H	HYDRO METER			
AC	AIR CONDITIONING	•	GAS METER			
⊕	DOWN SPOUT TO SPLASH PAD	Ŏ	MANHOLE - STORM			
>	SWALE DIRECTION	1	MANHOLE - SANITARY			
SP	SUMP PUMP	•	POTENTIAL HIGH WATER TABLE (SEE NOTE ON THIS DRAWING)			
X—————————————————————————————————————						
PRIVACY FENCE						
		SOUND BA				
FOOTING TO BE EXTENDED TO 1.22 (MIN) BELOW GRADE						
-						

NO.	DESCRIPTION	DATE	DWN	СНК
1	ISSUED FOR REVIEW	23-JUN-16	RK	JP
2	REVISED PER ENG COMM - FINAL	14-JUL-16	RK	JP
3	ISSUED FINAL	08-AUG-16	RK	JP

I, JULIO PINZON DECLARE THAT I HAVE REVIEWED AND TAKEN design work on behalf of RN Design Limited under Division C, Part 3, subst 3.2.4 of the Building Code. I am qualified, and the firm is registered, in the appropriate class/categories.
QUALIFIED DESIGNER BCIN 38688

FIRM BCIN 26995

AUG 2 4

I. Julio Pinzon declare that I



Olfo · Croato RN DESIGN LTD.

8395 JANE STREET, SUITE 203 VAUGHAN, ONTARIO. L4K 5Y2 T:905-738-3177 | F: 905-738-5449

CLIENT

GOLD PARK HOMES

PROJECT/LOCATION

KLEINBURG GLEN VAUGHAN, ON

SITE PLAN

drawn by	SCALE
RK	1:250
PROJECT No. 14043	LOT NUMBER