

Brampton Encore - 32 - 1 - 38-6 Elev.A SCARLATTI
CENTRAL VAC AND WIRING

Inv.561	1 - TELEPHONE AND CABLE ROUGH-IN LOCATION
Line6847	Note:
13Jun16 / 26Sep16	
Inv.561	1 - FAMILY ROOM: INSTALL CONDUIT PIPE- FOR TELEVISION- MUST SPECIFY LOCATION AND TERMINATION POINT, ABOVE FIREPLACE, SEE SKETCH
Line6848	Note:
13Jun16 / 26Sep16	
Inv.561	1 - FAMILY ROOM: INSTALL CAT 6 WIRING - UPGRADE AN OUTLET TO CAT 6- MUST SPECIFY LOCATION. SEE SKETCH
Line6850	Note:
13Jun16 / 26Sep16	
Inv.561	1 - GROUND FLOOR: INSTALL RG 6 ROUGH-IN IN GROUND FLOOR. SEE SKETCH
Line6851	Note:
13Jun16 / 26Sep16	
Inv.561	1 - MASTER BEDROOM. INSTALL ROUGH-IN FOR EXTRA SECURITY KEY PAD, IN MASTER BEDROOM
Line6852	Note:
13Jun16 / 26Sep16	
Inv.561	1 - GROUND FLOOR/MAN DOOR: INSTALL ROUGH-IN FOR EXTRA SECURITY KEY PAD BESIDE MAN DOOR.
Line6853	Note: GRADING DOES NOT PERMIT THE MAN DOOR, CREDIT WILL BE ISSUED FOR THE SECURITY KEY PAD HERE. DELETE SECURITY KEY PAD.
13Jun16 / 26Sep16	
Inv.862	1 - DELETE: #7 IN PE 561
GROUND FLOOR/MAN DOOR: INSTALL ROUGH-IN FOR EXTRA SECURITY KEY PAD	
Line11921	Note: GRADE DOES NOT PERMIT. CREDIT TO BE USED TOWARD COLOUR APPOINTMENT
26Sep16 / 24Feb17	

ELECTRICAL

Inv.561	1 - FAMILY ROOM: INSTALL 110V WALL RECEPTACLE ON DEDICATED CIRCUIT - ABOVE FIREPLACE. SEE SKETCH
Line6849	Note:
13Jun16 / 26Sep16	
Inv.561	1 - LIVING ROOM: INSTALL ADDITIONAL STANDARD FIXTURE WITH SWITCH - MUST SPECIFY LOCATION, IN LIVING ROOM. SEE SKETCH
Line6854	Note: IN ADDITION TO BUILDER'S STANDARD SWITCH CONTROLLED RECEPTICAL
13Jun16 / 26Sep16	
Inv.561	1 - KITCHEN: INSTALL KITCHEN CABINET VALANCE LIGHTS (UNDER CABINETS) - WITH STRIP LIGHTS - DOES NOT INCLUDE (AND REQUIRES) KITCHEN UPGRADE PRICING
Line6855	Note:
13Jun16 / 26Sep16	
Inv.561	3 - EXTERIOR: INSTALL THREE (X3) POT LIGHTS: 4 INCH LINE VOLTAGE POT LIGHT - (EXTERIOR) -EACH, AS SHOWN ON BROCHURE. SEE SKETCH
Line6856	Note:
13Jun16 / 26Sep16	

EXTERIOR COLOURS

Inv.561	1 - EXTERIOR COLOUR PACKAGE 3
Line11580	Note:
13Jun16 / 26Sep16	

Brampton Encore - 32 - 1 - 38-6 Elev.A SCARLATTI

FRAMING

Inv.561	1 - GARAGE: INSTALL MANDOOR - GARAGE TO HOUSE- AS PER PLAN AND GRADE PERMITING
Line6857	Note: GIVEN IN AGREEMENT OF PURCHASE AND SALE
13Jun16 / 26Sep16	GRADE DOES NOT PERMIT PER SITING ON AUGUST 2, 2016 NO CREDIT TO PURCHASER.
Inv.561	1 - MAIN FLOOR: INSTALL FOUR (X4) STANDARD DOORS EXTENDED HEIGHT 96" (PRICE PER DOOR) MAIN FLOOR 3 STOREY MODELS - TO GO IN CLOSETS, POWDER ROOM AND LAUNDRY. SEE SKETCH
Line11582	Note:
13Jun16 / 26Sep16	

GRANITE MARBLE QUARTZ

Inv.1,140	1 - KITCHEN: INSTALL 2 CM GRP I Optional Flush BBar
Line16854	Note:
30Jan17 / 24Feb17	

HARDWOOD

Inv.1,140	1 - DINING ROOM: INSTALL 4 1/4" SOLID RED OAK HARDWOOD, Upgrade 2 LEVEL I Dining
Line16847	Note:
30Jan17 / 24Feb17	
Inv.1,140	1 - FAMILY ROOM: INSTALL 4 1/4" SOLID RED OAK HARDWOOD, Upgrade 2 LEVEL I Family
Line16848	Note:
30Jan17 / 24Feb17	
Inv.1,140	1 - LIVING ROOM: INSTALL 4 1/4" SOLID RED OAK HARDWOOD, Upgrade 2 LEVEL I Living
Line16849	Note:
30Jan17 / 24Feb17	
Inv.1,140	1 - BEAKFAST AREA: INSTALL 4 1/4" SOLID RED OAK HARDWOOD, Upgrade 2 LEVEL I BREAKFAST AREA
Line16850	Note:
30Jan17 / 24Feb17	
Inv.1,140	1 - UPPER HALL: INSTALL 4 1/4" SOLID RED OAK HARDWOOD, Upgrade 2 LEVEL I Upper Hall
Line16860	Note:
30Jan17 / 24Feb17	

INTERIOR TRIM AND DOORS

Inv.561	4 - MAIN FLOOR: INSTALL FOUR (X4) STANDARD DOORS EXTENDED HEIGHT 96" (PRICE PER DOOR) MAIN FLOOR 3 STOREY MODELS - TO GO IN CLOSETS, POWDER ROOM AND LAUNDRY. SEE SKETCH
Line6858	Note:
13Jun16 / 26Sep16	

KITCHEN AND BATH CABINETRY

Inv.1,140	1 - KITCHEN: INSTALL Spray Stain Kitchen
Line16852	Note:
30Jan17 / 24Feb17	
Inv.1,140	1 - KITCHEN: INSTALL UPG 1 GRP III Opt Light Valance
Line16853	Note:
30Jan17 / 24Feb17	

MISC.

Brampton Encore - 32 - 1 - 38-6 Elev.A SCARLATTI

Inv.561	1 - BONUS PACKAGE: \$6774.35 (INCLUDING TAXES) WORTH OF UPGRADES FROM GOLD PARK HOMES DÉCOR CENTRE IS BEING APPLIED TOWARD THE STRUCTURAL APPOINTMENT. PURCHASER HAS A REMAINING AMOUNT OF \$3225.65 (INCLUDING TAXES) TO BE USED TOWARD THE COLOUR APPOINTMENT
Line6862	Note:
13Jun16 / 26Sep16	
Inv.561	1 - Purchaser has attended a Structural appointment at the Decor Centre & has DECLINED any additional upgrades and accepts and acknowledges that there will be no further structural changes/additions/deletions to be made upon signing on June 13, 2016
Line6863	Note:
13Jun16 / 26Sep16	
Inv.561	1 - Purchasers are aware & accepts that ANY changes made to upgrades after signing this Purchasers Extra Form are subject to a minimum administration fee of \$500. PLUS a 10% holdback fee
Line6864	Note:
13Jun16 / 26Sep16	
Inv.862	1 - Purchasers are aware & accepts that ANY changes made to upgrades after signing this Purchasers Extra Form are subject to a minimum administration fee of \$500. PLUS a 10% holdback fee
Line11922	Note:
26Sep16 / 24Feb17	
Inv.1,140	1 - BONUS PACKAGE: \$3225.65 (INCLUDING TAXES) WORTH OF UPGRADES FROM GOLD PARK HOMES DÉCOR CENTRE IS BEING APPLIED TOWARD THE COLOUR APPOINTMENT
Line16855	Note:
30Jan17 / 24Feb17	
Inv.1,140	1 - Purchaser has attended a Colour appointment at the Decor Centre & has DECLINED any additional upgrades and accepts and acknowledges that there will be no further structural changes/additions/deletions to be made upon signing on January 30, 2017
Line16856	Note:
30Jan17 / 24Feb17	
Inv.1,140	1 - Purchasers are aware & accepts that ANY changes made to upgrades after signing this Purchasers Extra Form are subject to a minimum administration fee of \$500. PLUS a 10% holdback fee
Line16857	Note:
30Jan17 / 24Feb17	

PAINTING

Inv.1,140	1 - STAIRCASE: Stain Staircases 3 Storey Model (Euroline Pickets Charged Separately)
Line16851	Note:
30Jan17 / 24Feb17	

PLUMBING

Inv.561	1 - KITCHEN: INSTALL ROUGH-IN - WATERLINE FOR FRIDGE
Line6859	Note:
13Jun16 / 26Sep16	
Inv.561	1 - BASEMENT: INSTALL ROUGH-IN - 2PC BASEMENT ROUGH-IN, AS PER PLAN
Line6860	Note:
13Jun16 / 26Sep16	
Inv.561	1 - GARAGE: INSTALL HOSE BIB - STANDARD TO UPGRADED WITH HOT AND COLD WATER VALVE. IN GARAGE ONLY
Line6861	Note:
13Jun16 / 26Sep16	

Scheduled Closing Date:

Purchaser: JOHN C. MEDLEY

Property: 32 of Plan -

Telephone Res. / Bus: (647) 466-2884

Project: Fieldwalk Investments Inc.

Decor Advisor: Terri Parisani

Model and Elevation: 38-6 Elev.A SCARLATTI

Layout Changes: ☐ Yes ☒ No

Sketch Attached: ☒ Yes ☐ No

Exterior Colour Scheme:

1. Cabinetry

	Style and Colour	Counter	Hardware
Kitchen / Breakfast	Siena(oak)*Charcoal	Grigio Sardo Granite Edge: FE20	cs1-20
Laundry Room			
Powder Room			
TWIN BATH	Varese(pvc)ChocoMaple	6698-46 Paloma Polar Laminate	cs1-14
Master Ensuite Bathroom	Varese(pvc) Mystic	6697-46 Argento Romano Laminate	cs1-16
Second Ensuite Bathroom (If Applicable)	Siena(oak)Greystone	7735-58 Portico Marble Laminate	cs1-18
Dishwasher Cabinet			

Comment

2. Floor Tile

	Selection	Grout	Threshold
Entrance Vestibule	Serpentine Beyaz 13 x 13	N/A	N/A
Main Hall			
Kitchen / Breakfast	Serpentine Beyaz 13 x 13	N/A	N/A
Laundry Room	Serpentine Beyaz 13 x 13	N/A	N/A
Powder Room	Serpentine Beyaz 13 x 13	N/A	N/A
TWIN BATH	Costa Matte White 13 x 13	N/A	N/A
Master Ensuite Bathroom	Costa Matte White 13 x 13	N/A	N/A
Second Ensuite Bathroom (If Applicable)	Costa Matte White 13 x 13	N/A	N/A
Lower Landing (If Applicable)			

Comment

GROUND FLOOR HALL: Serpentine Beyaz 13 x 13

3. Wall Tile

	Selection	Listello/Inserts	Describe
TWIN BATH	Weave Tender Grey 8 x 10	☐ Yes ☒ No	
Master Ensuite Bathroom			
Tub Deck	Weave Tender Grey 8 x 10	☐ Yes ☒ No	
Shower Stall	Weave Tender Grey 8 x 10	☐ Yes ☒ No	
Bathroom Walls	Weave Tender Grey 8 x 10	☐ Yes ☒ No	
Second Ensuite Bathroom (If Applicable)	Weave Tender Grey 8 x 10	☐ Yes ☒ No	
		☐ Yes ☐ No	

Kitchen Backsplash

☐ Yes ☒ No

Backsplash Behind Fridge

Comment

Scheduled Closing Date:

Purchaser: JOHN C. MEDLEY
Telephone Res. / Bus: (647) 466-2884
Decor Advisor: Terri Parisani

Property: 32 of Plan -
Project: Fieldwalk Investments Inc.
Model and Elevation: 38-6 Elev.A SCARLATTI

4. Plumbing Fixtures

☐	Second Ensuite	☐	Powder Room	☐	
Master Ensuite Bathroom	☐	Other Room - Specify	☐	Other Washroom	☐

Comment

PLUMBING FIXTURES TO BE STANDARD THROUGHOUT

5. Hardwood Flooring

	Type and Stain		Type and Stain
Main Hall	*Upg.2 Preverco 4 1/4" Espresso	Upper Landing	
Kitchen / Breakfast		Upper Hall	**Upg.2 Preverco 4 1/4" Espresso
Living Room	*Upg.2 Preverco 4 1/4" Espresso	Master Bedroom	
Dining Room	*Upg.2 Preverco 4 1/4" Espresso	Bedroom #2	
Family Room	*Upg.2 Preverco 4 1/4" Espresso	Bedroom #3	
Den/Library		Bedroom #4	
Entrance Vestibule		Bedroom #5	
Lower Landing (If Applicable)		Other Room - Specify	
		BREAKFAST AREA	*Upg.2 Preverco 4 1/4" Espresso

Comment

* HARDWOOD IS A 4 1/4" SOLID RED OAK

6. Carpeting

	Upgrade	Description
Main Hall	☐	
Living Room	☐	
Dining Room	☐	
Family Room	☐	
Den/Library	☐	
Upper Hall	☐	
Master Bedroom	☐	T-15
Bedroom #2	☐	T-15
Bedroom #3	☐	T-15
Bedroom #4	☐	T-15
Bedroom #5	☐	
GROUND FLOOR	☐	T-15
Upper Landing (If Applicable)	☐	
Lower Landing (If Applicable)	☐	

Upgrade Underpad	Type T-15	Area
Carpet on Stairs	Capped 	Runner - *Upgrade

Comment

Scheduled Closing Date:

Purchaser: JOHN C. MEDLEY

Property: 32 of Plan -

Telephone Res. / Bus: (647) 466-2884

Project: Fieldwalk Investments Inc.

Decor Advisor: Terri Parisani

Model and Elevation: 38-6 Elev.A SCARLATTI

7. Fireplace

	Living Room			Family Room			Other Room - Specify		
	Purchased	As Per Plan	N/A	Purchased	As Per Plan	N/A	Purchased	As Per Plan	N/A
	☐	☐	☒	☐	☒	☐	☐	☐	☒
Fireplace Type				NF-20					
Mantle Type				STANDARD					
Colour / Stain				WHITE PAINT-GRADE					
Surround				NERO MARQUINA					
Hearth									
Comment									

8. Trim Carpentry

Interior Doors	STANDARD	Front Door Glass Inserts	STANDARD	Door Handles	STANDARD
Interior Trim	STANDARD				
Comment					

9. Plaster Mouldings and Medallions

Entrance Vestibule	N/A		Kitchen/Breakfast	N/A	
Main Hall	N/A		Den/Library	N/A	
Living Room	N/A		Lower Landing	N/A	
Dining Room	N/A		Other Room - Specify		
Family Room	N/A				
Comment					

10. Railings and Spindles

Railing Package	STANDARD		
Railing Colour	*ESPRESSO RED OAK	Spindle Colour	*ESPRESSO RED OAK
Stringer / Riser	*ESPRESSO RED OAK	Treads	*ESPRESSO RED OAK
Comment	Oak Stairs ☒ Yes ☐ No		
NOTE: LANDINGS TO BE STINED TO MATCH STAIRCASE			

11. Wall Paint

Main & Upper Hall	WARM GREY	Master Bedroom	WARM GREY
Living Room	WARM GREY	Bedroom #2	WARM GREY
Dining Room	WARM GREY	Bedroom #3	WARM GREY
Kitchen / Breakfast	WARM GREY	Bedroom #4	WARM GREY
Family Room	WARM GREY	Bedroom #5	WARM GREY
Powder Room	WARM GREY	Master Ensuite	WARM GREY
Laundry Room	WARM GREY	TWIN BATH	WARM GREY
Den/Library	WARM GREY	Second Ensuite	WARM GREY
Trim Paint	WHITE	GROUND FLOOR	WARM GREY
Comment	Smooth Ceilings First Floor		

Scheduled Closing Date:

Purchaser: JOHN C. MEDLEY

Property: 32 of Plan -

Telephone Res. / Bus: (647) 466-2884

Project: Fieldwalk Investments Inc.

Decor Advisor: Terri Parisani

Model and Elevation: 38-6 Elev.A SCARLATTI

12. Electrical

Plugs and Switches	☒ White ☐ Ivory		Above Kitchen Cabinet Light	☐ Yes ☒ No
Hood Fan	☐ White ☐ Ivory		Below Kitchen Cabinet Light	☒ Yes ☐ No
Appliances	Built in Cooktop	Built in Oven	Gas Stove	Microwave
	☐ Yes ☒ No	☐ Yes ☒ No	☐ Yes ☒ No	☐ Yes ☒ No

Comment

STANDARD HOOD FAN: STAINLESS STEEL

13. Heating and Air Conditioning

Air Conditioning		Gas Provisions Stove	
Gas Provisions Dryer		Gas Provisions Barbecue	

Comment


GAS LINE FOR BBQ IS STANDARD

14. Additional Comments

15. Disclaimers and Notes

- 1) Colours of all materials are as close as possible to builder's selection, but not necessarily identical due to variances in manufacturing.
- 2) Any extras listed above are null and void unless accompanied by a separate invoice/amendment. Said invoice must be paid in full.
- 3) The Purchaser acknowledges that after Interior Colour Selection form is signed and dated, no further changes will be permitted other than re-selection due to unavailability. _____ Purchaser's Initials
- 4) The Purchaser acknowledges reading and accepting the "Gold Park Homes Decor Centre Disclaimers" form. This document contains other miscellaneous disclaimers.

This Interior Colour Selection is final and approved by:

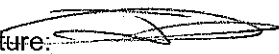Signature:  Date: Jan 30, 2017

Scheduled Closing Date:

Purchaser: JOHN C. MEDLEY

Property: 32 of Plan -

Telephone Res. / Bus: (647) 466-2884

Project: Fieldwalk Investments Inc.

Decor Advisor: Terri Parisani

Model and Elevation: 38-6 Elev.A SCARLATTI

Layout Changes: ☐ Yes ☒ No Sketch Attached: ☒ Yes ☐ No Exterior Colour Scheme:

1. Cabinetry

	Style and Colour	Counter	Hardware
Kitchen / Breakfast	Siena(oak)*Charcoal	Grigio Sardo Granite Edge: FE20	cs1-20
Laundry Room			
Powder Room			
TWIN BATH	Varese(pvc)ChocoMaple	6698-46 Paloma Polar Laminate	cs1-14
Master Ensuite Bathroom	Varese(pvc) Mystic	6697-46 Argento Romano Laminate	cs1-16
Second Ensuite Bathroom (If Applicable)	Siena(oak)Greystone	7735-58 Portico Marble Laminate	cs1-18
Dishwasher Cabinet			
Comment			

2. Floor Tile

	Selection	Grout	Threshold
Entrance Vestibule	Serpentine Beyaz 13 x 13	N/A	N/A
Main Hall			
Kitchen / Breakfast	Serpentine Beyaz 13 x 13	N/A	N/A
Laundry Room	Serpentine Beyaz 13 x 13	N/A	N/A
Powder Room	Serpentine Beyaz 13 x 13	N/A	N/A
TWIN BATH	Costa Matte White 13 x 13	N/A	N/A
Master Ensuite Bathroom	Costa Matte White 13 x 13	N/A	N/A
Second Ensuite Bathroom (If Applicable)	Costa Matte White 13 x 13	N/A	N/A
Lower Landing (If Applicable)			
Comment	GROUND FLOOR HALL: Serpentine Beyaz 13 x 13		

3. Wall Tile

	Selection	Listello/Inserts	Describe
TWIN BATH	Weave Tender Grey 8 x 10	☐ Yes ☒ No	
Master Ensuite Bathroom			
Tub Deck	Weave Tender Grey 8 x 10	☐ Yes ☒ No	
Shower Stall	Weave Tender Grey 8 x 10	☐ Yes ☒ No	
Bathroom Walls	Weave Tender Grey 8 x 10	☐ Yes ☒ No	
Second Ensuite Bathroom (If Applicable)	Weave Tender Grey 8 x 10	☐ Yes ☒ No	
		☐ Yes ☐ No	
Kitchen Backsplash	☐ Yes ☒ No	Backsplash Behind Fridge	
Comment			

Scheduled Closing Date:

Purchaser: JOHN C. MEDLEY

Property: 32 of Plan -

Telephone Res. / Bus: (647) 466-2884

Project: Fieldwalk Investments Inc.

Decor Advisor: Terri Parisani

Model and Elevation: 38-6 Elev.A SCARLATTI

4. Plumbing Fixtures

	Second Ensuite		Powder Room	
Master Ensuite Bathroom		Other Room - Specify		Other Washroom

Comment

PLUMBING FIXTURES TO BE STANDARD THROUGHOUT

5. Hardwood Flooring

	Type and Stain		Type and Stain
Main Hall	*Upg.2 Preverco 4 1/4" Espresso	Upper Landing	
Kitchen / Breakfast		Upper Hall	**Upg.2 Preverco 4 1/4" Espresso
Living Room	*Upg.2 Preverco 4 1/4" Espresso	Master Bedroom	
Dining Room	*Upg.2 Preverco 4 1/4" Espresso	Bedroom #2	
Family Room	*Upg.2 Preverco 4 1/4" Espresso	Bedroom #3	
Den/Library		Bedroom #4	
Entrance Vestibule		Bedroom #5	
Lower Landing (If Applicable)		Other Room - Specify	
		BREAKFAST AREA	*Upg.2 Preverco 4 1/4" Espresso

Comment

* HARDWOOD IS A 4 1/4" SOLID RED OAK

6. Carpeting

	Upgrade	Description
Main Hall	☐	
Living Room	☐	
Dining Room	☐	
Family Room	☐	
Den/Library	☐	
Upper Hall	☐	
Master Bedroom	☐	T-15
Bedroom #2	☐	T-15
Bedroom #3	☐	T-15
Bedroom #4	☐	T-15
Bedroom #5	☐	
GROUND FLOOR	☐	T-15
Upper Landing (If Applicable)	☐	
Lower Landing (If Applicable)	☐	

Upgrade Underpad	Type	Area
	T-15	
Carpet on Stairs	Capped	Runner - *Upgrade

Comment

Scheduled Closing Date:

Purchaser: JOHN C. MEDLEY

Property: 32 of Plan -

Telephone Res. / Bus: (647) 466-2884

Project: Fieldwalk Investments Inc.

Decor Advisor: Terri Parisani

Model and Elevation: 38-6 Elev.A SCARLATTI

7. Fireplace

	Living Room			Family Room			Other Room - Specify		
	Purchased	As Per Plan	N/A	Purchased	As Per Plan	N/A	Purchased	As Per Plan	N/A
	☐	☐	☒	☐	☒	☐	☐	☐	☒
Fireplace Type				NF-20					
Mantle Type				STANDARD					
Colour / Stain				WHITE PAINT-GRADE					
Surround				NERO MARQUINA					
Hearth									
Comment									

8. Trim Carpentry

Interior Doors	STANDARD	Front Door Glass Inserts	STANDARD	Door Handles	STANDARD
Interior Trim	STANDARD				
Comment					

9. Plaster Mouldings and Medallions

Entrance Vestibule	N/A		Kitchen/Breakfast	N/A	
Main Hall	N/A		Den/Library	N/A	
Living Room	N/A		Lower Landing	N/A	
Dining Room	N/A		Other Room - Specify		
Family Room	N/A				
Comment					

10. Railings and Spindles

Railing Package	STANDARD		
Railing Colour	*ESPRESSO RED OAK	Spindle Colour	*ESPRESSO RED OAK
Stringer / Riser	*ESPRESSO RED OAK	Treads	*ESPRESSO RED OAK
Comment	Oak Stairs ☒ Yes ☐ No		
NOTE: LANDINGS TO BE STINED TO MATCH STAIRCASE			

11. Wall Paint

Main & Upper Hall	WARM GREY	Master Bedroom	WARM GREY
Living Room	WARM GREY	Bedroom #2	WARM GREY
Dining Room	WARM GREY	Bedroom #3	WARM GREY
Kitchen / Breakfast	WARM GREY	Bedroom #4	WARM GREY
Family Room	WARM GREY	Bedroom #5	WARM GREY
Powder Room	WARM GREY	Master Ensuite	WARM GREY
Laundry Room	WARM GREY	TWIN BATH	WARM GREY
Den/Library	WARM GREY	Second Ensuite	WARM GREY
Trim Paint	WHITE	GROUND FLOOR	WARM GREY
Comment	Smooth Ceilings First Floor		

Scheduled Closing Date:

Purchaser: JOHN C. MEDLEY
Telephone Res. / Bus: (647) 466-2884
Decor Advisor: Terri Parisani

Property: 32 of Plan -
Project: Fieldwalk Investments Inc.
Model and Elevation: 38-6 Elev.A SCARLATTI

12. Electrical

Plugs and Switches ☒ White ☐ Ivory
Hood Fan ☐ White ☐ Ivory
Appliances Built in Cooktop Built in Oven Gas Stove Microwave
☐ Yes ☒ No ☐ Yes ☒ No ☐ Yes ☒ No ☐ Yes ☒ No
Above Kitchen Cabinet Light ☐ Yes ☒ No
Below Kitchen Cabinet Light ☒ Yes ☐ No

Comment

STANDARD HOOD FAN: STAINLESS STEEL

13. Heating and Air Conditioning

Air Conditioning Gas Provisions Stove
Gas Provisions Dryer Gas Provisions Barbecue

Comment


GAS LINE FOR BBQ IS STANDARD


14. Additional Comments

15. Disclaimers and Notes

- Colours of all materials are as close as possible to builder's selection, but not necessarily identical due to variances in manufacturing.
- Any extras listed above are null and void unless accompanied by a separate invoice/amendment. Said invoice must be paid in full.
- The Purchaser acknowledges that after Interior Colour Selection form is signed and dated, no further changes will be permitted other than re-selection due to unavailability. _____ Purchaser's Initials
- The Purchaser acknowledges reading and accepting the "Gold Park Homes Decor Centre Disclaimers" form. This document contains other miscellaneous disclaimers.


This Interior Colour Selection is final and approved by:

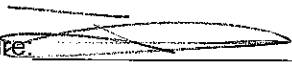Signature:  Date: Jan 30, 2017

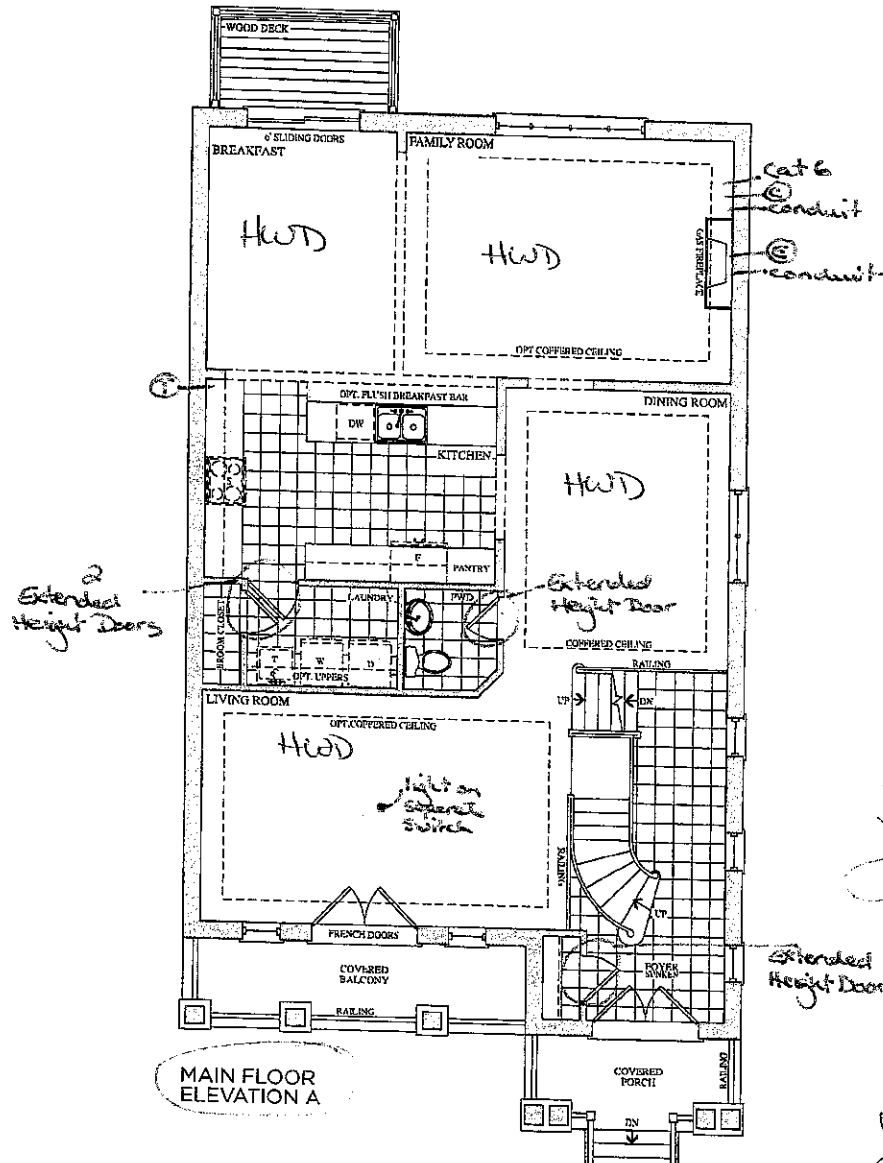


Lot 32
June 13, 16

Extended
Hesit Door

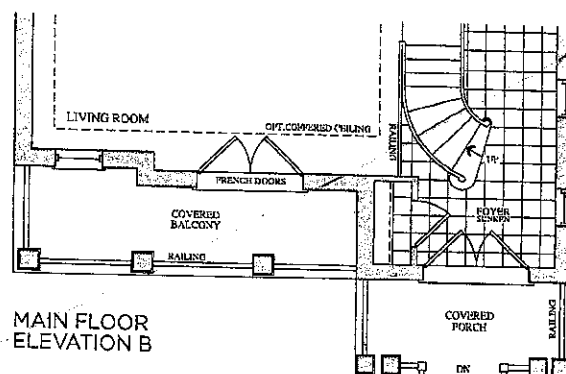

Lot 32
Jan. 30, 17



Prices, figures, illustrations, sizes, features and finishes are subject to change without notice. E&O.L. Areas and dimensions are approximate and actual usable floor space may vary from the stated area. Layout may be reverse of the unit purchased. E. & O.E.

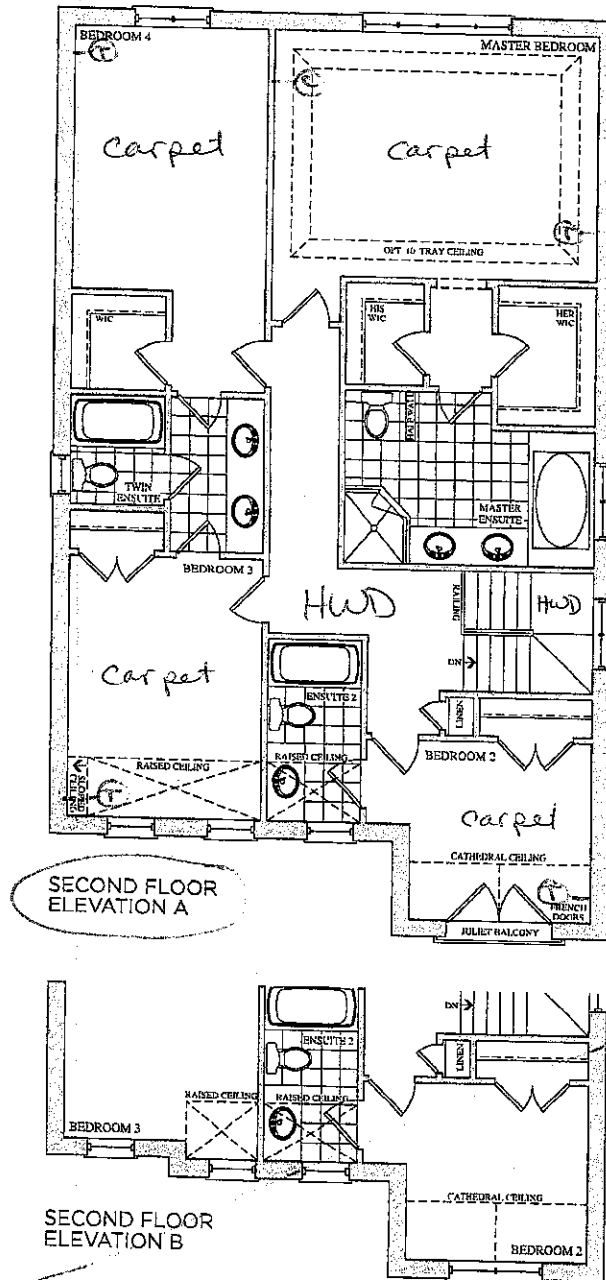

Lot 32
June 13, 16

Lot 32
Jan 30, 17

Cable — @

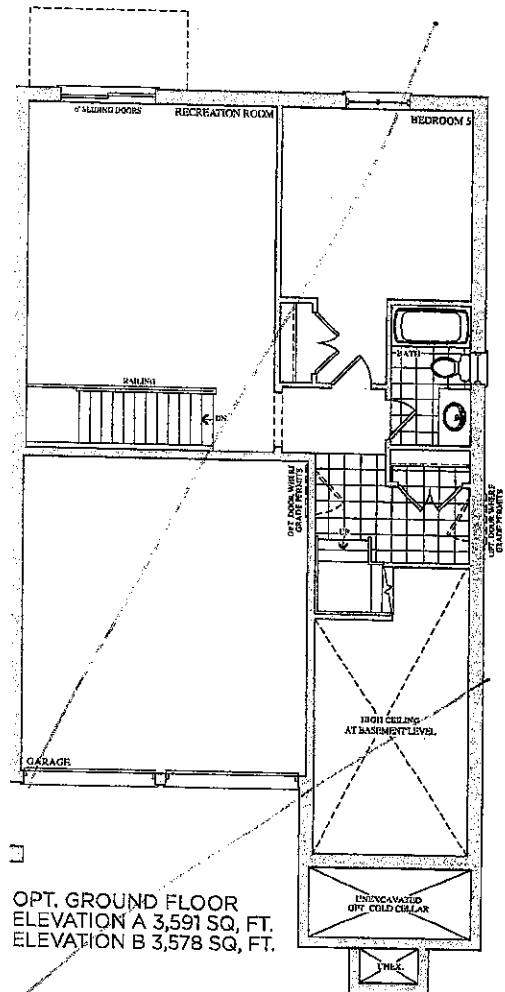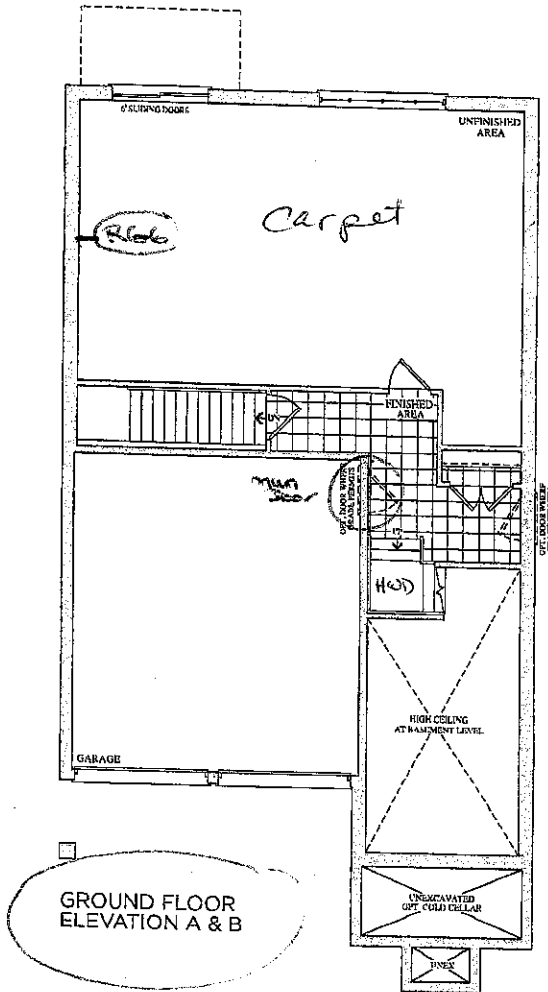


Lot 32
June 13, 16
[Signature]

Lot 32
Jan 30, 17
[Signature]

Trade Name: Gold Park Homes	Site location: Brampton	Model: 38-6
Address:	Project: Encore	Phase:

This layout has been explained to the purchaser by Cortina Kitchens Inc. and is understood by the purchaser.

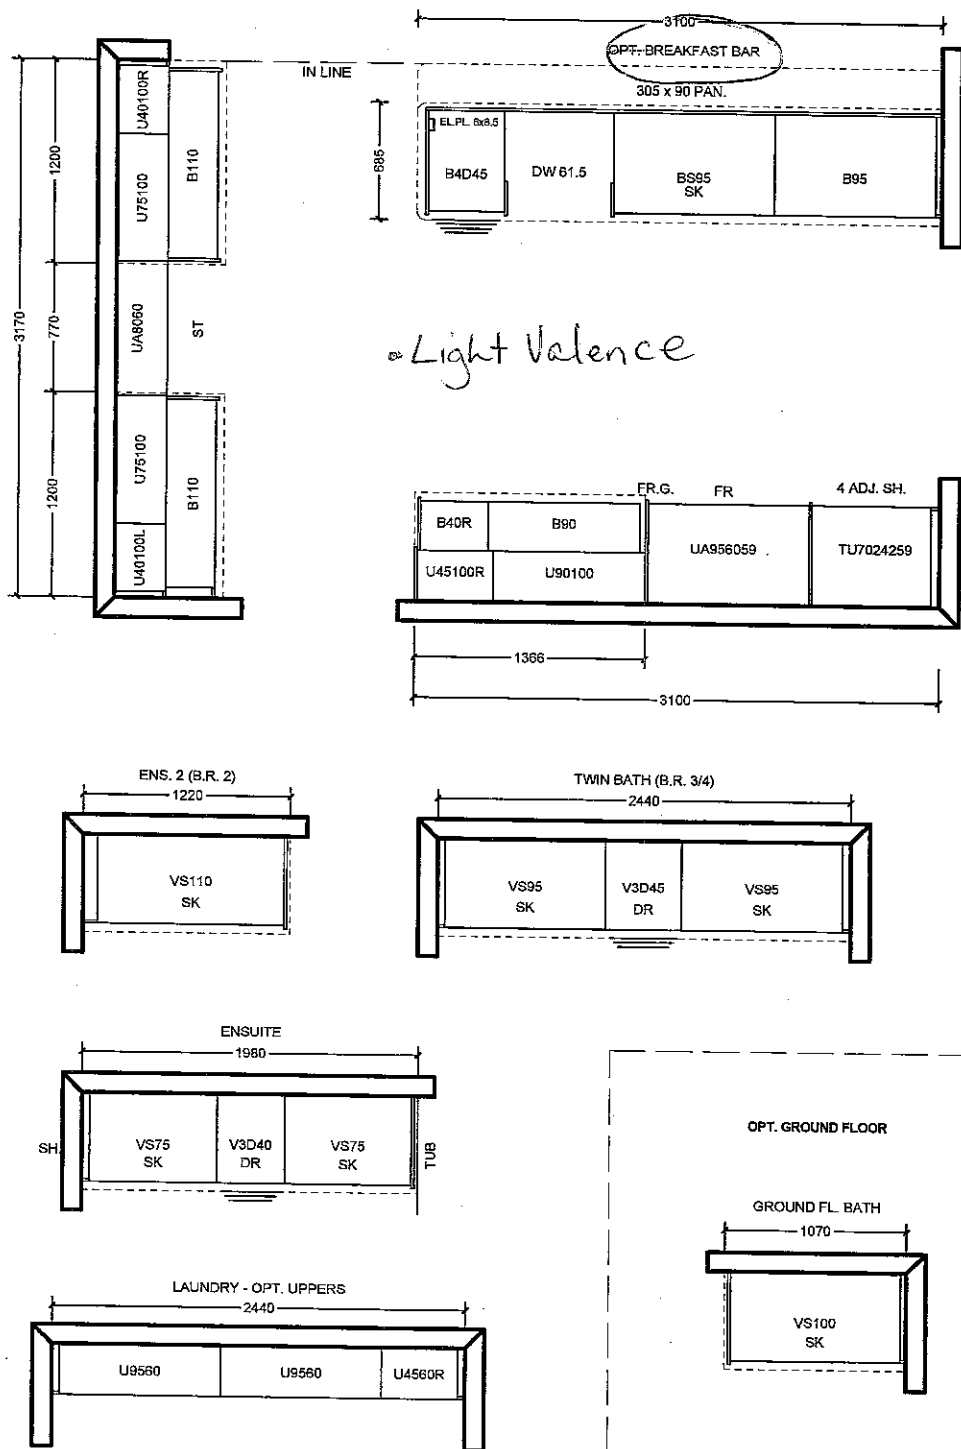

All prices subject to confirmation from head office.

This quotation is subject to the terms & conditions set out in Cortina's Agreement of Purchase and Sale

All agreements are contingent upon strikes, accidents, and delay beyond our control. Please provide our installer with template for sinkholes or \$150.00 will be charged for callback.

ACCEPTED DATE: _____

CUSTOMER SIGNATURE _____

SALESPERSON SIGNATURE _____

CORTINA HEAD OFFICE APPROVAL _____

ITEM A. Wood grain and colour are characteristics of the product, we cannot guarantee that such grain and colour will always match
ITEM B. Cortina Kitchens reserves the right to alter dimensions and make technical changes without notice.

Lot 32
Jan. 30, 17


STANDARD HARDWARE

Lot 32

Jan 30, 17



CSI-6

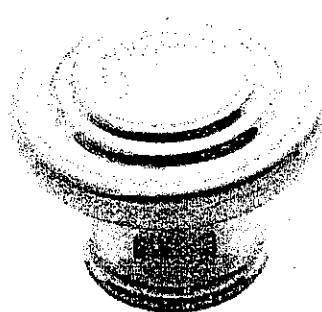

CSI-10




CSI-14

Twin




CSI-16

Master

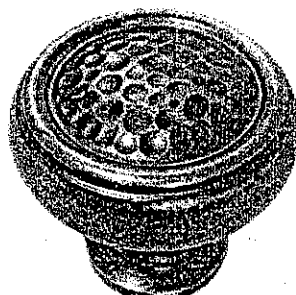


CSI-18

Ens. 2

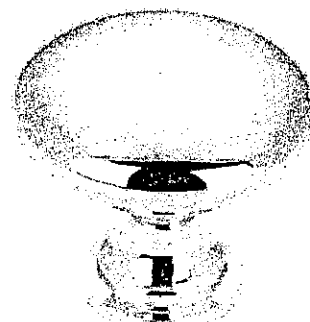


CSI-19

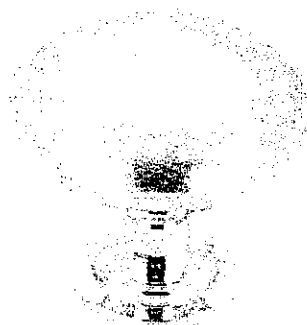

CSI-20


Kitchen

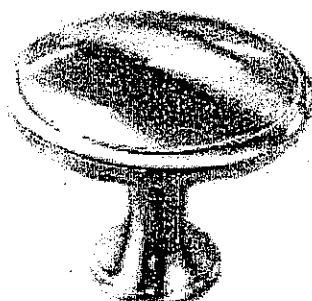


CSI-21




CSI-22

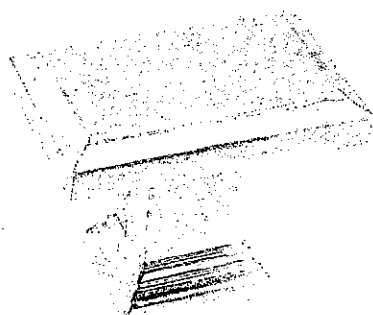

CSI-23

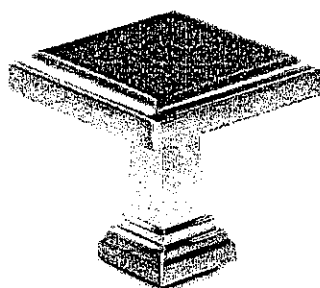

CSI-24

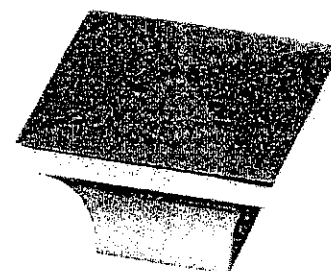

CSI-25

*NOTES:

- IMAGES ARE FOR QUICK REFERENCE PURPOSES ONLY
- ACTUAL SIZES AND FINISHES AS PER HARDWARE SAMPLE BOARD PROVIDED TO DECOR CENTRE

GOLDPARK
HOMES




**Granite, Marble,
Engineered Surfaces**

- standard 2CM & 3CM
- ⊖ Upgrade 1 2CM & 3CM
- ⊗ Upgrade 1 4 CM
- Upgrade 2


20 mm (3/4") Profiles



30mm (1-1/4") Profiles

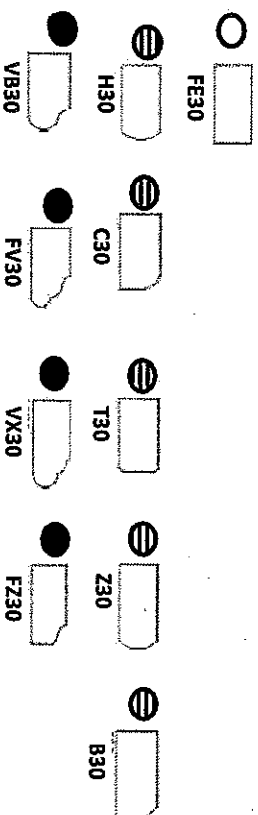

40mm (1-1/2") Profiles

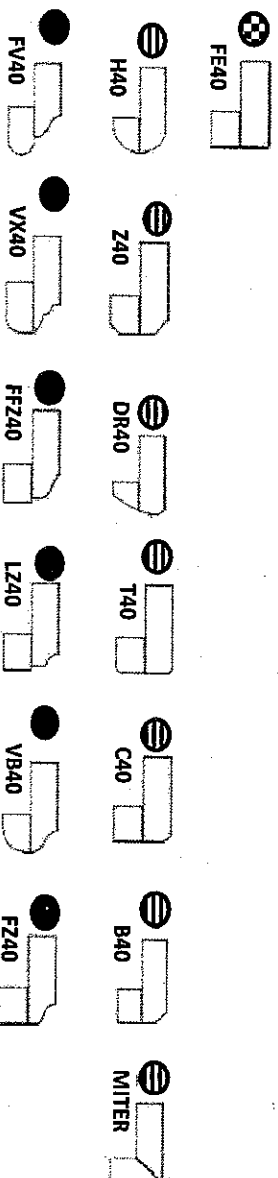

Note: All colours may not be available in 30mm at time ordered. Vendor reserves the right to use 40 mm edges (by lamination process).

*Mitre edge is available in Upgrade 1 for an overall thickness of 2". All other Mitre edge options will be an Upgrade 2 Edge.

Not 32
Jan. 30, 17

CORTINA

KITCHENS INC.

70 Regina Road Woodbridge ON L4L 8L6
905-264-6464

CHARCOAL STAIN INFORMATION

Builder Gold Park Homes Project Encore Lot # 32

Charcoal is a spray stain applied to Oak and Maple products with several characteristics that are important to be aware of when purchasing this product.

1. Shadow lines may be visible at the interior profile edges of a door or drawer front. If movement occurs shadow lines may increase or decrease, depending on the style and/or size of a door or drawer front.
2. Variation and unevenness may be visible in the finish.
3. Hairline cracks at the joints are created over time due to the nature of natural wood, caused by usage, humidity**, or dryness. They tend to be more visible to darker stains, than lighter wood stains.


** Relative humidity is recommended to be between 45% and 55%. Please refer to Cortina Kitchens "Cleaning, Care, Maintenance, & Warranty Information" guide.

Please be advised that Cortina Kitchens will not replace doors and/or parts that exhibit the above characteristics associated with this finish. These characteristics are not avoidable and are a result of the natural characteristics of wood and wood veneer, and the characteristics of darker stains on wood.

The Charcoal stain is not available on doors in Group IV, Group IVA, Group V and Group VA.

Thank you for your understanding.

I am well informed of this information, and agree to the purchase of any of the subject finishes listed above.

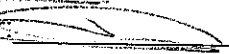Purchaser: 

Date: Jan 30, 2017