

CONSTRUCTION MODIFICATION / CLARIFICATION

LOT 34R –Kleinburg Glen

PROJECT- Kleinburg Glen

MODIFICATION

Electrical, HVAC, Plumbing

- Please relocate the appliances from the previously marked basement location to the revised basement location as per the attached drawing


Thank you

DATE ISSUED: 3/1/17

ISSUED BY: Stacey Carlete

Elevation A • 1,898 sq.ft.

Elevation B • 1,898 sq.ft.

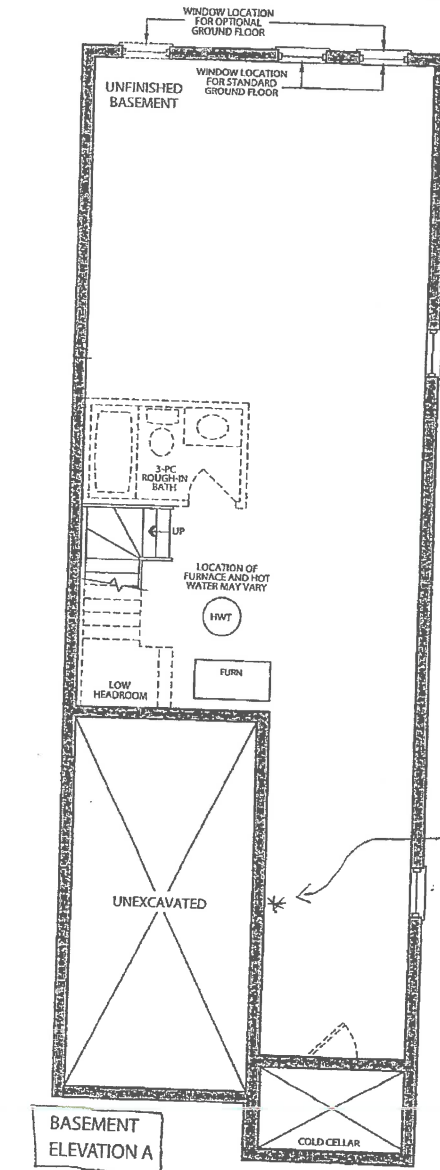


Preferred laundry location.



Aug 2 2016

LOT 34R

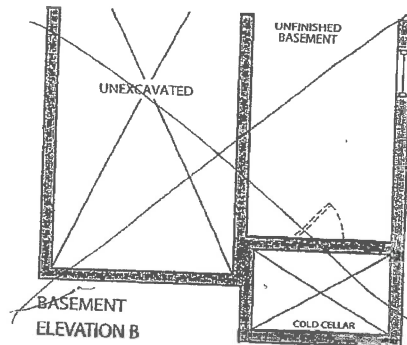

KG-34R

FEB 19 2017



Prices, figures, illustrations, sizes, features and finishes are subject to change without notice. E.&O.E. Areas and dimensions are approximate and actual usable floor space may vary from the stated area. Layout may be reverse of the unit purchased. E. & O.E.