

Brampton Encore - 107 - 1 - 38-4 Elev.A VIVALDI

CERAMIC

|                  |                                                                       |
|------------------|-----------------------------------------------------------------------|
| Inv.1,218        | 1 - KITCHEN: INSTALL Floor Upgrade 2 Kitchen and Breakfast Floor      |
| Line18385        | Note: *NOTE TILE DIRECTION ON FLOOR PLAN- TO BE INSTALLED VERTICALLY. |
| 1Mar17 / 14Mar17 |                                                                       |
| Inv.1,218        | 1 - FOYER: INSTALL Floor Upgrade 2 Foyer Vestibule Floor              |
| Line18386        | Note: *NOTE TILE DIRECTION ON FLOOR PLAN- TO BE INSTALLED VERTICALLY. |
| 1Mar17 / 14Mar17 |                                                                       |
| Inv.1,218        | 1 - POWDER ROOM: INSTALL Floor Upgrade 2 Powder Room Floor            |
| Line18387        | Note: *NOTE TILE DIRECTION ON FLOOR PLAN- TO BE INSTALLED VERTICALLY. |
| 1Mar17 / 14Mar17 |                                                                       |

ELECTRICAL

|                   |                                                  |
|-------------------|--------------------------------------------------|
| Inv.603           | 1 - TELEPHONE AND CABLE ROUGH-IN LOCATIONS       |
| Line7412          | Note:                                            |
| 23Jun16 / 28Jul16 |                                                  |
| Inv.603           | 1 - BASEMENT: INSTALL 200 AMP ELECTRICAL SERVICE |
| Line7430          | Note:                                            |
| 23Jun16 / 28Jul16 |                                                  |

EXTERIOR COLOURS

|                   |                               |
|-------------------|-------------------------------|
| Inv.709           | 1 - EXTERIOR COLOUR PACKAGE 3 |
| Line9484          | Note:                         |
| 28Jul16 / 28Jul16 |                               |

FORMING

|                   |                                                                                     |
|-------------------|-------------------------------------------------------------------------------------|
| Inv.603           | 1 - EXTERIOR: INSTALL SIDE DOOR- HOME TO EXTERIOR- AS PER PLAN AND GRADE PERMITTING |
| Line7414          | Note:                                                                               |
| 23Jun16 / 28Jul16 |                                                                                     |

FRAMING

|                   |                                                                                 |
|-------------------|---------------------------------------------------------------------------------|
| Inv.603           | 1 - GARAGE: INSTALL MANDOOR - GARAGE TO HOUSE- AS PER PLAN AND GRADE PERMITTING |
| Line7413          | Note: GIVEN IN AGREEMENT OF PURCHASE AND SALE                                   |
| 23Jun16 / 28Jul16 |                                                                                 |

GLASS AND MIRROR

|                   |                                                                                                          |
|-------------------|----------------------------------------------------------------------------------------------------------|
| Inv.603           | 1 - MASTER ENSUITE: CONVERT FRAMED SHOWER TO 10MM FRAMLESS SHOWER ENCLOSURE WITH DOOR. IN MASTER ENSUITE |
| Line7415          | Note:                                                                                                    |
| 23Jun16 / 28Jul16 |                                                                                                          |

GRANITE MARBLE QUARTZ

|                  |                                                     |
|------------------|-----------------------------------------------------|
| Inv.1,218        | 1 - KITCHEN: INSTALL 2 CM GRP 2 Kitchen with Island |
| Line18377        | Note:                                               |
| 1Mar17 / 14Mar17 |                                                     |
| Inv.1,218        | 1 - KITCHEN: INSTALL 2 CM GRP 2 Optional Flush BBar |
| Line18378        | Note:                                               |
| 1Mar17 / 14Mar17 |                                                     |

Brampton Encore - 107 - 1 - 38-4 Elev.A VIVALDI

HARDWOOD

|                  |                                                                                                      |
|------------------|------------------------------------------------------------------------------------------------------|
| Inv.1,218        | 1 - DINING ROOM: INSTALL PREVERCO 4 1/4" ENGINEERED RED OAK IN KOMODO Upgrade 1<br>LEVEL S Dining    |
| Line18380        | Note:                                                                                                |
| 1Mar17 / 14Mar17 |                                                                                                      |
| Inv.1,218        | 1 - FAMILY ROOM: INSTALL PREVERCO 4 1/4" ENGINEERED RED OAK IN KOMODO Upgrade 1<br>1 LEVEL S Family  |
| Line18381        | Note:                                                                                                |
| 1Mar17 / 14Mar17 |                                                                                                      |
| Inv.1,218        | 1 - MAIN HALL: INSTALL PREVERCO 4 1/4" ENGINEERED RED OAK IN KOMODO Upgrade 1<br>LEVEL S Main Hall   |
| Line18382        | Note:                                                                                                |
| 1Mar17 / 14Mar17 |                                                                                                      |
| Inv.1,218        | 1 - UPPER HALL: INSTALL PREVERCO 4 1/4" ENGINEERED RED OAK IN KOMODO Upgrade 1<br>LEVEL S Upper Hall |
| Line18383        | Note:                                                                                                |
| 1Mar17 / 14Mar17 |                                                                                                      |

INTERIOR TRIM AND DOORS

|                   |                                                                                                                                                              |
|-------------------|--------------------------------------------------------------------------------------------------------------------------------------------------------------|
| Inv.603           | 4 - MAIN FLOOR: INSTALL FOUR (X4) STANDARD DOOR EXTENDED HEIGHT 96" (PRICE<br>PER DOOR)- MAIN FLOOR 2 STOREY MODELS. FOR CLOSET, POWDER ROOM AND<br>BASEMENT |
| Line7424          | Note:                                                                                                                                                        |
| 23Jun16 / 28Jul16 |                                                                                                                                                              |

KITCHEN AND BATH CABINETRY

|                  |                                                               |
|------------------|---------------------------------------------------------------|
| Inv.1,218        | 1 - KITCHEN: INSTALL Oak PVC 59 Upper Corner Diagonal 100cm h |
| Line18379        | Note:                                                         |
| 1Mar17 / 14Mar17 |                                                               |

MISC.

|                   |                                                                                                                                                                                                                                                                            |
|-------------------|----------------------------------------------------------------------------------------------------------------------------------------------------------------------------------------------------------------------------------------------------------------------------|
| Inv.603           | 1 - BONUS PACKAGE: \$13,836.85 (INCLUDING TAXES) WORTH OF UPGRADES FROM GOLD<br>PARK HOMES DÉCOR CENTRE IS BEING APPLIED TOWARD THE STRUCTURAL<br>APPOINTMENT. PURCHASER HAS A REMAINING AMOUNT OF \$1163.15 (INCLUDING TAXES)<br>TO BE USED TOWARD THE COLOUR APPOINTMENT |
| Line7427          | Note:                                                                                                                                                                                                                                                                      |
| 23Jun16 / 28Jul16 |                                                                                                                                                                                                                                                                            |
| Inv.603           | 1 - Purchaser has attended a Structural appointment at the Decor Centre & has DECLINED any additional<br>upgrades and accepts and acknowledges that there will be no further structural changes/additions/deletions<br>to be made upon signing on June 23, 2016            |
| Line7428          | Note:                                                                                                                                                                                                                                                                      |
| 23Jun16 / 28Jul16 |                                                                                                                                                                                                                                                                            |
| Inv.603           | 1 - Purchasers are aware & accepts that ANY changes made to upgrades after signing this Purchasers Extra<br>Form are subject to a minimum administration fee of \$500. PLUS a 10% holdback fee                                                                             |
| Line7429          | Note:                                                                                                                                                                                                                                                                      |
| 23Jun16 / 28Jul16 |                                                                                                                                                                                                                                                                            |
| Inv.1,218         | 1 - BONUS PACKAGE: \$1163.15 (INCLUDING TAXES) WORTH OF UPGRADES FROM GOLD<br>PARK HOMES DÉCOR CENTRE IS BEING APPLIED TOWARD THE COLOUR APPOINTMENT                                                                                                                       |
| Line18390         | Note:                                                                                                                                                                                                                                                                      |
| 1Mar17 / 14Mar17  |                                                                                                                                                                                                                                                                            |

Brampton Encore - 107 - 1 - 38-4 Elev.A VIVALDI

|                  |                                                                                                                                                                                                                                                       |
|------------------|-------------------------------------------------------------------------------------------------------------------------------------------------------------------------------------------------------------------------------------------------------|
| Inv.1,218        | 1 - Purchaser has attended a Colour appointment at the Decor Centre & has DECLINED any additional upgrades and accepts and acknowledges that there will be no further structural changes/additions/deletions to be made upon signing on March 1, 2017 |
| Line18391        | Note:                                                                                                                                                                                                                                                 |
| 1Mar17 / 14Mar17 |                                                                                                                                                                                                                                                       |
| Inv.1,218        | 1 - Purchasers are aware & accepts that ANY changes made to upgrades after signing this Purchasers Extra Form are subject to a minimum administration fee of \$500. PLUS a 10% holdback fee.                                                          |
| Line18392        | Note:                                                                                                                                                                                                                                                 |
| 1Mar17 / 14Mar17 |                                                                                                                                                                                                                                                       |

PAINTING

|                  |                                                                                     |
|------------------|-------------------------------------------------------------------------------------|
| Inv.1,218        | 1 - STAIRCASE: Stain Staircase 2 Storey Model (Euroline Pickets Charged Separately) |
| Line18384        | Note:                                                                               |
| 1Mar17 / 14Mar17 |                                                                                     |

PLUMBING

|                   |                                                                               |
|-------------------|-------------------------------------------------------------------------------|
| Inv.603           | 1 - BASEMENT: INSTALL ROUGH-IN - 3PC BASEMENT ROUGH-IN, AS PER PLAN           |
| Line7425          | Note:                                                                         |
| 23Jun16 / 28Jul16 |                                                                               |
| Inv.603           | 1 - BASEMENT: INSTALL ROUGH-IN LAUNDRY IN BASEMENT, INCLUDING TUB. SEE SKETCH |
| Line7426          | Note:                                                                         |
| 23Jun16 / 28Jul16 |                                                                               |

STAIRS AND RAILINGS

|                  |                                          |
|------------------|------------------------------------------|
| Inv.1,218        | 1 - STAIRCASE: INSTALL EUROLINE 1 Black  |
| Line18388        | Note:                                    |
| 1Mar17 / 14Mar17 |                                          |
| Inv.1,218        | 1 - STAIRCASE: INSTALL V Groove Handrail |
| Line18389        | Note:                                    |
| 1Mar17 / 14Mar17 |                                          |

WINDOWS - BASEMENT

|                   |                                                                                                                                                     |
|-------------------|-----------------------------------------------------------------------------------------------------------------------------------------------------|
| Inv.603           | 3 - BASEMENT: INSTALL THREE (X3) BASEMENT WINDOWS - UPGRADE EXISTING BASEMENT WINDOW TO 30 INCH X 24 INCH - MAY REQUIRE INSTALLATION OF WINDOW WELL |
| Line7419          | Note:                                                                                                                                               |
| 23Jun16 / 28Jul16 |                                                                                                                                                     |



INTERIOR COLOUR SCHEME

\*\*\* NOTE: This is not an approved document. Document must be locked \*\*\*

Scheduled Closing Date:

Purchaser: Harbhajan Kaur Aujla

Telephone Res. / Bus: (905) 817-0934 / (905) 399-3237

Decor Advisor: Terri Parisani

Property: 107 of Plan -

Project: Fieldwalk Investments Inc.

Model and Elevation: 38-4 Elev.A VIVALDI

Layout Changes: ☒ Yes ☐ No      Sketch Attached: ☒ Yes ☐ No      Exterior Colour Scheme:

1. Cabinetry

|                                         | Style and Colour        | Counter                            | Hardware |
|-----------------------------------------|-------------------------|------------------------------------|----------|
| Kitchen / Breakfast                     | Venice(pvc)ChocoMaple   | *Upg.2, 6141 Ocean Foam Edge: FE20 | cs1-24   |
| Laundry Room                            |                         |                                    |          |
| Powder Room                             |                         |                                    |          |
| TWIN BATH                               | Varese(pvc)WhiteCrystal | P-344LM Inukshuk Grey Laminate     | cs1-23   |
| Master Ensuite Bathroom                 | Venice(pvc)Mystic       | 6696-46 Carrara Bianco Laminate    | cs1-25   |
| Second Ensuite Bathroom (If Applicable) | Toscana(pvc)AntiqWhite  | 1877K-52 Autumn Carnival Laminate  | cs1-14   |
|                                         |                         |                                    |          |

Dishwasher Cabinet

Comment

2. Floor Tile

|                                         | Selection                                 | Grout | Threshold |
|-----------------------------------------|-------------------------------------------|-------|-----------|
| Entrance Vestibule                      | *Upg.2 New Byzantine Pentaflic Grey 12x24 | N/A   | N/A       |
| Main Hall                               |                                           |       |           |
| Kitchen / Breakfast                     | *Upg.2 New Byzantine Pentaflic Grey 12x24 | N/A   | N/A       |
| Laundry Room                            | Serpentine Beyaz 13 x 13                  | N/A   | N/A       |
| Powder Room                             | *Upg.2 New Byzantine Pentaflic Grey 12x24 | N/A   | N/A       |
| TWIN BATH                               | New Reeds Brown 13 x 13                   | N/A   | N/A       |
| Master Ensuite Bathroom                 | Serpentine Beyaz 13 x 13                  | N/A   | N/A       |
| Second Ensuite Bathroom (If Applicable) | Serpentine Krem 13 x 13                   | N/A   | N/A       |
| Lower Landing (If Applicable)           |                                           |       |           |
|                                         |                                           |       |           |

Comment

3. Wall Tile

|                                         | Selection              | Listello/Inserts                                              | Describe |
|-----------------------------------------|------------------------|---------------------------------------------------------------|----------|
| TWIN BATH                               | New Reeds Brown 8 x 10 | <input type="radio"/> Yes <input checked="" type="radio"/> No |          |
| Master Ensuite Bathroom                 |                        |                                                               |          |
| Tub Deck                                | Weave White 8 x 10     | <input type="radio"/> Yes <input checked="" type="radio"/> No |          |
| Shower Stall                            | Weave White 8 x 10     | <input type="radio"/> Yes <input checked="" type="radio"/> No |          |
| Bathroom Walls                          | Weave White 8 x 10     | <input type="radio"/> Yes <input checked="" type="radio"/> No |          |
| Second Ensuite Bathroom (If Applicable) | Serpentine Krem 8 x 10 | <input type="radio"/> Yes <input checked="" type="radio"/> No |          |
|                                         |                        | <input type="radio"/> Yes <input type="radio"/> No            |          |

Kitchen Backsplash ☐ Yes ☐ No      Backsplash Behind Fridge

Comment



INTERIOR COLOUR SCHEME

\*\*\* NOTE: This is not an approved document. Document must be locked \*\*\*

Scheduled Closing Date:

Purchaser:

Harbhajan Kaur Aujla

Telephone Res. / Bus:

(905) 817-0934 / (905) 399-3237

Decor Advisor:

Terri Parisani

Property: 107 of Plan -

Project: Fieldwalk Investments Inc.

Model and Elevation: 38-4 Elev.A VIVALDI

4. Plumbing Fixtures

Second Ensuite

Powder Room

Master Ensuite Bathroom

Other Room - Specify

Other Washroom

Comment

ALL FIXTURES TO REMAIN AS STANDARD THROUGHOUT

5. Hardwood Flooring

|                               | Type and Stain                |                      | Type and Stain                 |
|-------------------------------|-------------------------------|----------------------|--------------------------------|
| Main Hall                     | *Upg1, Preverco 4 1/4" Komodo | Upper Landing        | <input type="text"/>           |
| Kitchen / Breakfast           | <input type="text"/>          | Upper Hall           | **Upg1, Preverco 4 1/4" Komodo |
| Living Room                   | <input type="text"/>          | Master Bedroom       | <input type="text"/>           |
| Dining Room                   | *Upg1, Preverco 4 1/4" Komodo | Bedroom #2           | <input type="text"/>           |
| Family Room                   | *Upg1, Preverco 4 1/4" Komodo | Bedroom #3           | <input type="text"/>           |
| Den/Library                   | <input type="text"/>          | Bedroom #4           | <input type="text"/>           |
| Entrance Vestibule            | <input type="text"/>          | Bedroom #5           | <input type="text"/>           |
| Lower Landing (If Applicable) | <input type="text"/>          | Other Room - Specify | <input type="text"/>           |

Comment

ALL HARDWOOD IS ENGINEERED RED OAK

6. Carpeting

|                               | Upgrade                  | Description          |
|-------------------------------|--------------------------|----------------------|
| Main Hall                     | <input type="checkbox"/> | <input type="text"/> |
| Living Room                   | <input type="checkbox"/> | <input type="text"/> |
| Dining Room                   | <input type="checkbox"/> | <input type="text"/> |
| Family Room                   | <input type="checkbox"/> | <input type="text"/> |
| Den/Library                   | <input type="checkbox"/> | <input type="text"/> |
| Upper Hall                    | <input type="checkbox"/> | <input type="text"/> |
| Master Bedroom                | <input type="checkbox"/> | T-04                 |
| Bedroom #2                    | <input type="checkbox"/> | T-04                 |
| Bedroom #3                    | <input type="checkbox"/> | T-04                 |
| Bedroom #4                    | <input type="checkbox"/> | T-04                 |
| Bedroom #5                    | <input type="checkbox"/> | <input type="text"/> |
| <input type="text"/>          | <input type="checkbox"/> | <input type="text"/> |
| Upper Landing (If Applicable) | <input type="checkbox"/> | <input type="text"/> |
| Lower Landing (If Applicable) | <input type="checkbox"/> | <input type="text"/> |

Upgrade Underpad

Type

STANDARD

Area

Carpet on Stairs

Capped

Runner - \*Upgrade

Comment





## INTERIOR COLOUR SCHEME

\*\*\* NOTE: This is not an approved document. Document must be locked \*\*\*

Scheduled Closing Date:

Purchaser: Harbhajan Kaur Aujla

Property: 107 of Plan -

Telephone Res. / Bus: (905) 817-0934 / (905) 399-3237

Project: Fieldwalk Investments Inc.

Decor Advisor: Terri Parisani

Model and Elevation: 38-4 Elev.A VIVALDI

## 7. Fireplace

Living Room

Purchased

As Per Plan

N/A

Family Room

Purchased

As Per Plan

N/A

Other Room - Specify

Purchased

As Per Plan

N/A

Fireplace Type



STANDARD

Mantle Type

NF-24

Colour / Stain

WHITE PAINT-GRADE

Surround

NERO MARQUINA

Hearth

NONE

Comment

## 8. Trim Carpentry

Interior Doors

STANDARD

Front Door Glass Inserts

STANDARD

Door Handles

STANDARD

Interior Trim

STANDARD

Comment

## 9. Plaster Mouldings and Medallions

Entrance Vestibule

N/A

Kitchen/Breakfast

N/A

Main Hall

N/A

Den/Library

N/A

Living Room

N/A

Lower Landing

N/A

Dining Room

N/A

Other Room - Specify

N/A

Family Room

N/A

Comment

## 10. Railings and Spindles

Railing Package

EUROLINE 1 WITH V-GROOVE HANDRAIL

Railing Colour

KOMODO RED OAK

Spindle Colour

BLACK

Stringer / Riser

KOMODO RED OAK

Treads

KOMODO RED OAK

Comment

Oak Stairs



Yes



No

STAIN STAIR LANDINGS TO MATCH STAIR STAIN

## 11. Wall Paint

Main &amp; Upper Hall

WARM GREY

Master Bedroom

WARM GREY

Living Room

WARM GREY

Bedroom #2

WARM GREY

Dining Room

WARM GREY

Bedroom #3

WARM GREY

Kitchen / Breakfast

WARM GREY

Bedroom #4

WARM GREY

Family Room

WARM GREY

Bedroom #5

WARM GREY

Powder Room

WARM GREY

Master Ensuite

WARM GREY

Laundry Room

WARM GREY

TWIN BATH

WARM GREY

Den/Library

WARM GREY

Second Ensuite

WARM GREY

Trim Paint

WHITE

Comment

Smooth Ceilings First Floor



INTERIOR COLOUR SCHEME

\*\*\* NOTE: This is not an approved document. Document must be locked \*\*\*

Scheduled Closing Date:

Purchaser: Harbhajan Kaur Aujla  
Telephone Res. / Bus: (905) 817-0934 / (905) 399-3237  
Decor Advisor: Terri Parisani

Property: 107 of Plan -  
Project: Fieldwalk Investments Inc.  
Model and Elevation: 38-4 Elev.A VIVALDI

12. Electrical

Plugs and Switches ☒ White ☐ Ivory   
Hood Fan ☐ White ☐ Ivory  
Appliances Built in Cooktop Built in Oven Gas Stove Microwave  
☐ Yes ☒ No ☐ Yes ☒ No ☐ Yes ☒ No ☐ Yes ☒ No  
Comment

13. Heating and Air Conditioning

Air Conditioning  Gas Provisions Stove   
Gas Provisions Dryer  Gas Provisions Barbecue   
Comment  
GAS LINE FOR BBQ IS STANDARD

14. Additional Comments

15. Disclaimers and Notes

- Colours of all materials are as close as possible to builder's selection, but not necessarily identical due to variances in manufacturing.
- Any extras listed above are null and void unless accompanied by a separate invoice/amendment. Said invoice must be paid in full.
- The Purchaser acknowledges that after Interior Colour Selection form is signed and dated, no further changes will be permitted other than re-selection due to unavailability. HA Purchaser's Initials
- The Purchaser acknowledges reading and accepting the "Gold Park Homes Decor Centre Disclaimers" form. This document contains other miscellaneous disclaimers.

This Interior Colour Selection is final and approved by:

X Signature: Harbhajan Aujla Date:                       
Authentisign  
3/2/2017 4:13:37 PM EST

# CORTINA

KITCHENS INC.

70 Regina Road Woodbridge ON L4L 8L6  
905-264-6464

## INFORMATION - PVC DOORS

Builder: Gold Park Homes Project: Encore Lot #: 107

All cabinets with PVC (Thermofoil) Doors come with melamine gables, panels and kick. The doors, crown moulding and light valance are PVC wrapped. Open shelves incorporated in design will only be available with melamine interiors. There will be variations in colour shades between the PVC parts (doors, crown and Light valance) and the melamine parts (open shelves, Gables, Panels and Kick) due to the difference in material.

Furring Panel with crown moulding to the ceiling is not available on all PVC door styles due to subtle variations in colour shades between the PVC parts (moulding) and the melamine parts (furring panel) due to the difference in material. Grain directions in wood grain pattern melamine, vary between the furring panel, crown moulding (horizontal) and the PVC doors (vertical).

Thank you for your understanding.

I am well informed of this information, and agree to the purchase of the above.

Purchaser: \_\_\_\_\_

Authentisign

*Harbhajan Auja*

3/2/2017 4:19:46 PM EST

Date: Mar. 2, 17

Lot 107

**CORTINA**  
KITCHENS INC.  
70 Regina Road, Woodbridge, Ontario L4L 6L6  
Tel: 905-254-8454 Fax: 905-254-0654  
[www.CortinaKitchens.com](http://www.CortinaKitchens.com)

### QUOTATION

Date: 06/23/16

Trade Name: Gold Park Homes

**Site location:** Brampton


Model: 38-4

Address:

Project Encore

### Phase\*

This layout has been explained to the purchaser by Cortina Kitchens Inc. and is understood by the purchaser.

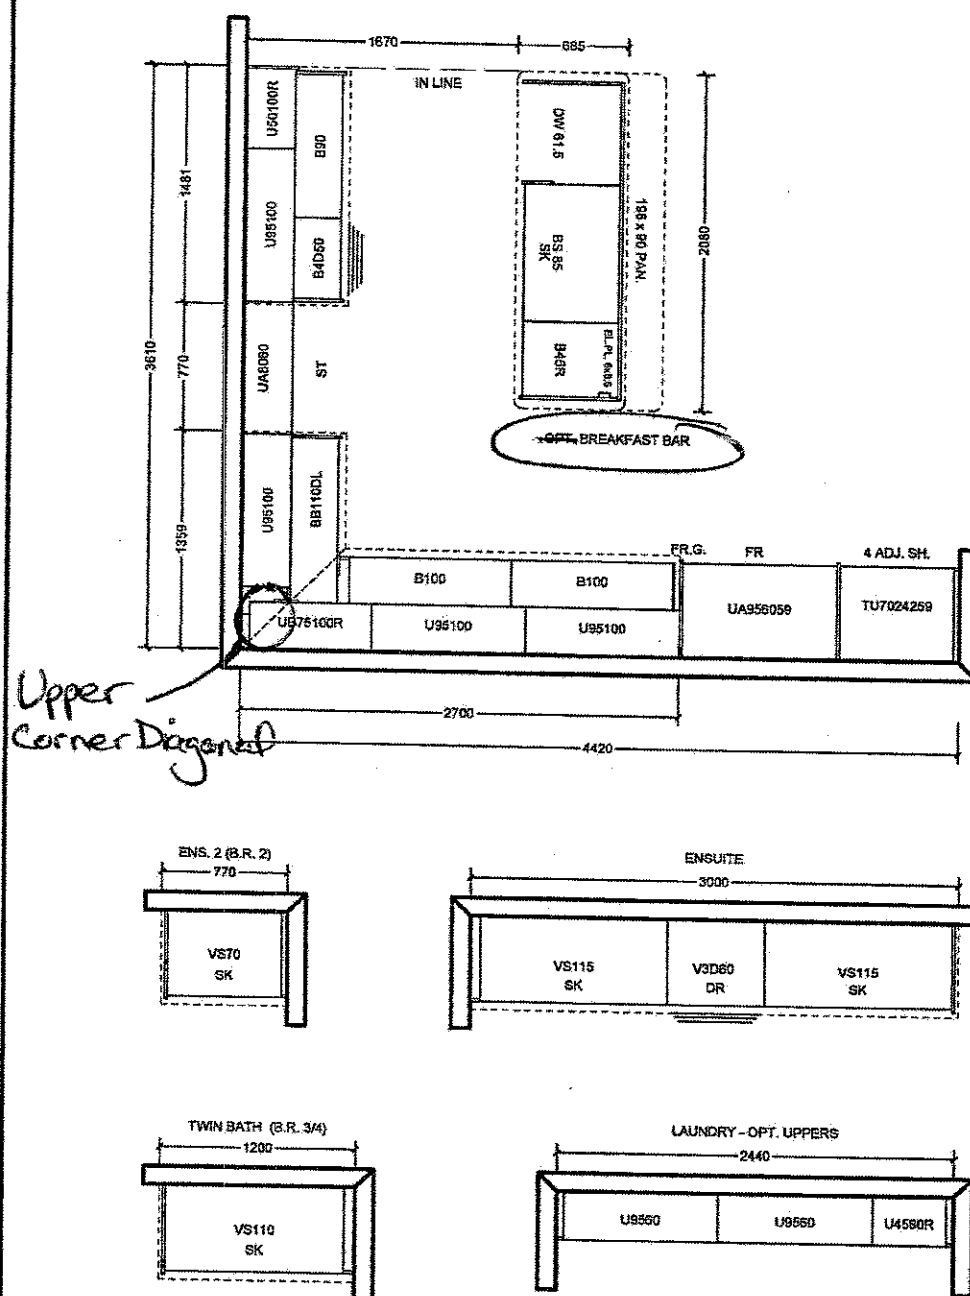

All prices subject to confirmation from head office.  
This quotation is subject to the terms & conditions set out  
in Cortina's Agreement of Purchase and Sale

All agreements are contingent upon strikes, accidents, and delay beyond our control. Please provide our installer with template for sinkholes or \$150.00 will be charged for callback.

ACCEPTED AUTHENTISIGN

**Harbhajan Auja**  
CUSTOMER SIGNATURE  
3/2/2017 4:13:47 PM EST

SALESPERSON SIGNATURE \_\_\_\_\_

**CORTINA HEAD OFFICE APPROVAL:**

ITEM A. Wood grain and colour are characteristics of the product, we cannot guarantee that such grain and colour will always match.


ITEM B. CorGua Kitchens reserves the right to alter dimensions and make technical changes without notice.

encore  
BRANTON

The  
Vivaldi  
38' SERIES

Elevation A • 2,518 sq.ft. | Elevation B • 2,518 sq.ft.

Tiles to be  
installed  
vertically in  
Kitchen

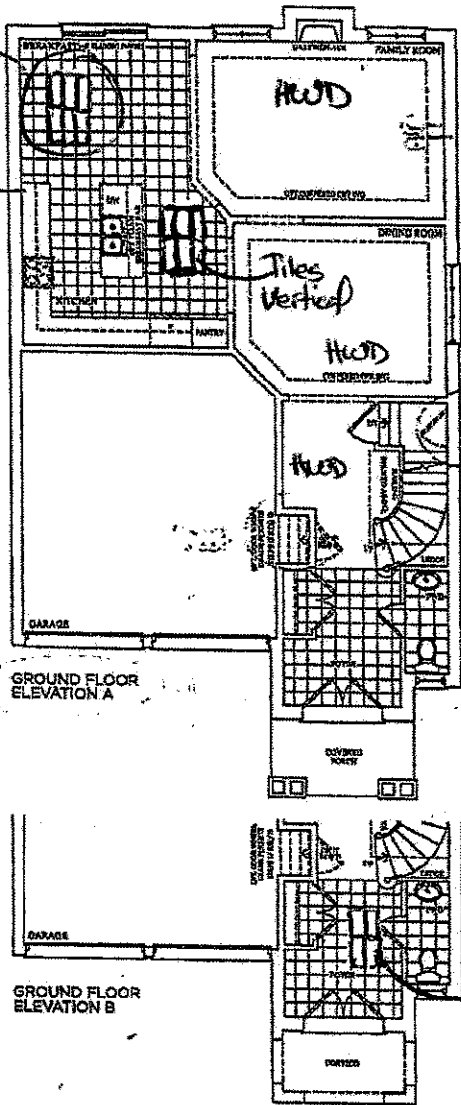

Side Door

Lot 107  
June 23, 16

  
Harbhajan Arora  
Baljit Arora

 Tiles Installed  
Vertically in  
Foyer/Powder Rm

Please refer to the site plan and floor plan for the actual layout. The actual layout may vary from the stated area. Layout may be revised at the discretion of the architect. S.S. & C.C.



Lot 107  
Apr. 1, 17



encore  
BRAMPTON

The  
**Vivaldi**  
38' SERIES

Elevation A • 2,518 sq.ft. | Elevation B • 2,518 sq.ft.

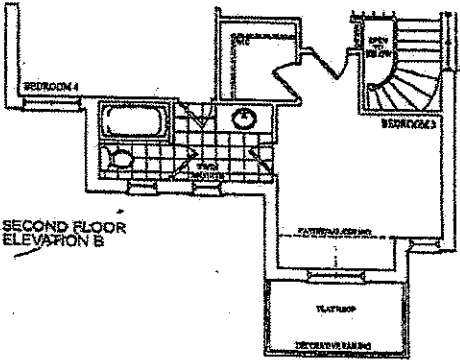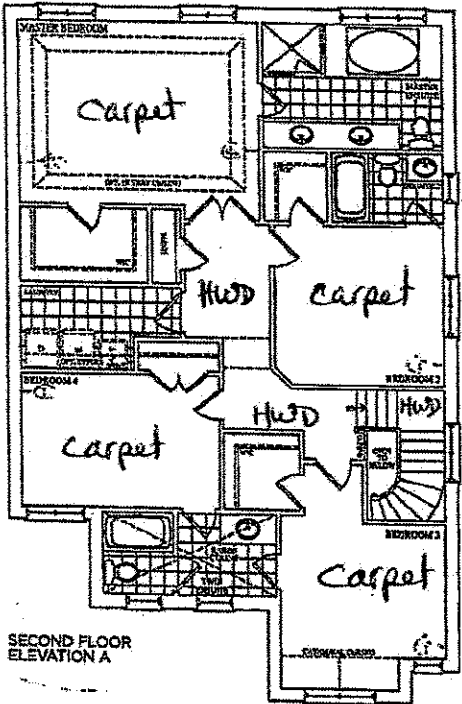

Lot 107  
June 27, 17

  
Harbourside  
Balcony Area

These figures, including the square footage and features are subject to change without notice. E.S.O.L. Areas and dimensions are approximate and actual usable floor space may vary from the stated area. E.S.O.L. only by license of the city of Brampton, L.S.O.E.



Lot 107  
Apr. 1, 17



Lot 107

MODIFIED: 19/05/16

STANDARD HARDWARE


Mar. 1, 17



STANDARD HARDWARE




CSI-6

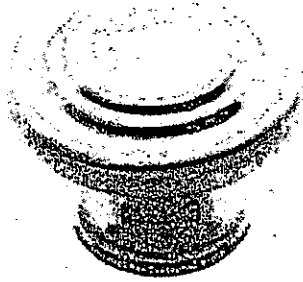


CSI-10




CSI-14 Ens. 2

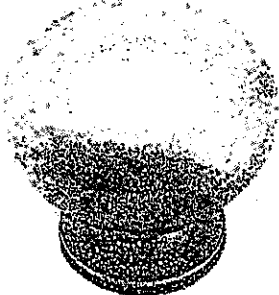

CSI-16

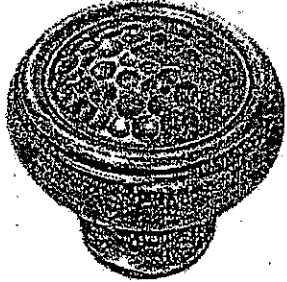


CSI-18

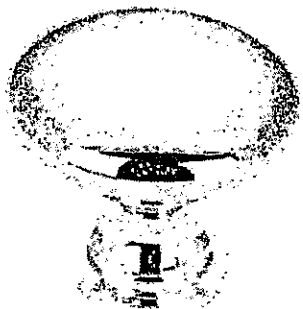

CSI-19




CSI-20

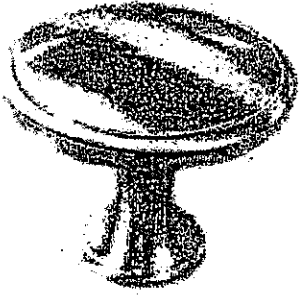


CSI-21




CSI-22

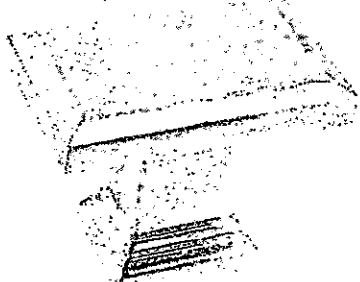

CSI-23 Twin Bath

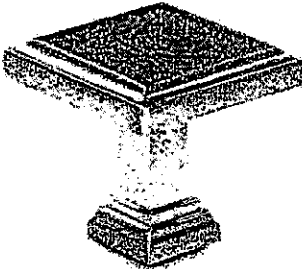

CSI-24 Kitchen

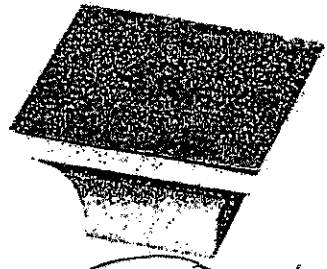

CSI-25 Master

\*NOTES:

- IMAGES ARE FOR QUICK REFERENCE PURPOSES ONLY
- ACTUAL SIZES AND FINISHES AS PER HARDWARE SAMPLE BOARD PROVIDED TO DECOR CENTRE

Lot 107


GOLDPARK  
HOMES




Granite, Marble,  
Engineered Surfaces

- Standard 2CM & 3CM
- Upgrade 1 2CM & 3CM
- Upgrade 1 4 CM
- Upgrade 2


20 mm (3/4") Profiles

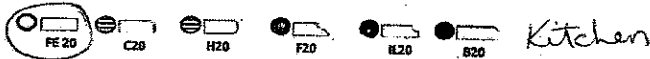

30mm (1 1/8") Profiles

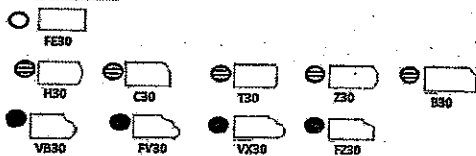

40mm (1 1/2") Profiles

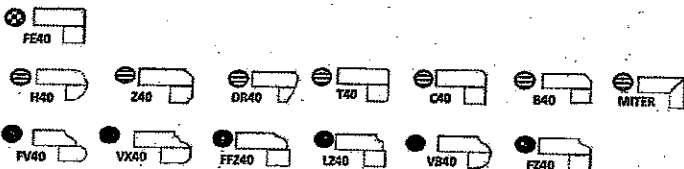

Note: All colours may not be available in 30mm at time ordered. Vendor reserves the right to use 40 mm edges (by lamination process).

\*Mitre edge is available in Upgrade 1 for an overall thickness of 2". All other Mitre edge options will be an Upgrade 2 Edge.