

Kleinburg Glen - 52 - 1 - 38-4 Elev.A BRIDGEPORT
CENTRAL VAC AND WIRING

Inv.660	4 - DEN/ MASTER BEDROOM / BEDROOM 2 / BEDROOM 3: CAT 6 WIRING - UPGRADE AN OUTLET TO CAT 6 - See plan for location.
Line17399	Note:
13Jul16 / 17Mar17	
Inv.660	1 - GREAT ROOM: CONDUIT PIPE - FOR TELEVISION - Locate approx. 66" A.F.F. above fireplace, terminating beside cable/fibre optic outlet (toward rear of house, see plan for location)
Line17192	Note:
13Jul16 / 17Mar17	
Inv.660	2 - MUD ROOM & MASTER BEDROOM: ROUGH - IN FOR EXTRA SECURITY KEY PAD
Line17396	Note:
13Jul16 / 17Mar17	
Inv.660	1 - GREAT ROOM: ROUGH - IN FIBER OPTIC CABLE - HOME RUN TO ELECTRICAL PANEL - Locate next to cable, see plan for location.
Line17398	Note:
13Jul16 / 17Mar17	

DRYWALL

Inv.660	1 - SMOOTH CEILINGS - (2 - Story Design) 2ND FLOOR
Line17157	Note:
13Jul16 / 17Mar17	
Inv.660	1 - GREAT ROOM: OPTIONAL COFFERED CEILING - GREAT ROOM (PER ROOM AS PER PLAN)
Line19195	Note:
13Jul16 / 17Mar17	

ELECTRICAL

Inv.660	7 - KITCHEN: POT LIGHT: 4 INCH HALOGEN POT LIGHT - 440 WH - PRICED PER LIGHT - 10 OR MORE
Line17401	Note:
13Jul16 / 17Mar17	
Inv.660	1 - DINING ROOM: UPGRADE TO DIMMER SWITCH - ONE UNIT - MUST PROVIDE LOCATION
Line17602	Note:
13Jul16 / 17Mar17	
Inv.660	1 - KITCHEN: RELOCATE STANDARD FIXTURE - Locate above island, see plan for location.
Line17161	Note:
13Jul16 / 17Mar17	
Inv.660	1 - KITCHEN: 110V WALL RECEPTACLE ON DEDICATED CIRCUIT - GAS FIRED APPLIANCE - FOR AUX. EQUIPMENT - NOT A STOVE PLUG
Line17159	Note:
13Jul16 / 17Mar17	
Inv.660	1 - KITCHEN: ROUGH - IN CEILING OUTLET ON SAME SWITCH - DOES NOT INCLUDE FIXTURE - Locate above island, use same switch as standard ceiling light. See plan for location.
Line17162	Note:
13Jul16 / 17Mar17	
Inv.660	1 - KITCHEN: Single pole switch for potlights in kitchen
Line17164	Note:
13Jul16 / 17Mar17	

Kleinburg Glen - 52 - 1 - 38-4 Elev.A BRIDGEPORT

Inv.660	1 - GREAT ROOM: UPGRADE TO DIMMER SWITCH - ONE UNIT - MUST PROVIDE LOCATION
Line17403	Note:
13Jul16 / 17Mar17	
Inv.660	1 - GREAT ROOM: Add electrical above fireplace (approx. 66" A.F.F.) for future TV.
Line17191	Note:
13Jul16 / 17Mar17	
Inv.660	1 - KITCHEN: 110V WALL RECEPTACLE ON DEDICATED CIRCUIT - FOR MICROWAVE - MICROWAVE NOT INCLUDED
Line17195	Note:
13Jul16 / 17Mar17	
Inv.660	1 - KITCHEN: 220V WALL RECEPTICAL ON DEDICATED CIRCUIT - FOR 4 WIRE BUILT - IN WALL OVEN - MUST SPECIFY LOCATION
Line17196	Note:
13Jul16 / 17Mar17	
Inv.660	6 - GREAT ROOM: POT LIGHT: 4 INCH HALOGEN POT LIGHT - 440 WH - PRICED PER LIGHT - 10 OR MORE
Line17400	Note:
13Jul16 / 17Mar17	
Inv.660	4 - DINING ROOM: POT LIGHT: 4 INCH HALOGEN POT LIGHT - 440 WH - PRICED PER LIGHT - 10 OR MORE
Line17402	Note:
13Jul16 / 17Mar17	

EXTERIOR COLOURS

Inv.660	1 - EXTERIOR COLOUR PACKAGE 10
Line19112	Note:
13Jul16 / 17Mar17	

FRAMING

Inv.660	1 - MASTER BEDROOM FRAME 2ND FLOOR FLOOR ARCH AT 96 INCH
Line17198	Note:
13Jul16 / 17Mar17	
Inv.660	1 - MAIN FLOOR CEILING 10FT- 8' INTERIOR DOORS AND ARCHES, TALLER FRONT AND REAR ELEVATION DOORS AND WINDOWS WITH TRANSOM, KITCHEN FURRING PANEL AND CROWN WITH 12" BULK HEAD,
Line17395	Note:
13Jul16 / 17Mar17	
Inv.660	1 - MASTER BEDROOM: OPTIONAL 10 FOOT TRAY CEILING - MASTER BEDROOM (EXCLUDES 25.7 AND 45.1 OPT)
Line17406	Note:
13Jul16 / 17Mar17	
Inv.660	1 - GREAT ROOM: OPTIONAL COFFERED CEILING - GREAT ROOM (PER ROOM AS PER PLAN)
Line17409	Note:
13Jul16 / 17Mar17	
Inv.660	18 - MAIN FLOOR: FRAME MAIN FLOOR DOORS AT 96 INCH - ADDED WITH THE ADDITION OF TALLER INTERIOR DOORS
Line17592	Note:
13Jul16 / 17Mar17	

GLASS AND MIRROR

Kleinburg Glen - 52 - 1 - 38-4 Elev.A BRIDGEPORT

Inv.660	1 - MASTER ENSUITE: CONVERT FRAMED SHOWER TO 10MM FRAMLESS SHOWER ENCLOSURE WITH DOOR AND 10MM SIDE PANEL
Line17193	Note:
13Jul16 / 17Mar17	

HVAC

Inv.660	1 - KITCHEN: GAS LINE ROUGH - GROUND FLOOR
Line17160	Note:
13Jul16 / 17Mar17	

INTERIOR TRIM AND DOORS

Inv.660	1 - MASTER BEDROOM: EXTENDED HEIGHT ARCHWAY (PRICE PER DOORWAY) - 96"
Line17199	Note:
13Jul16 / 17Mar17	

Inv.660	18 - 2ND FLOOR: STANDARD DOOR EXTENDED HEIGHT 96 INCH (PRICE PER DOOR) - SECOND FLOOR 2 STOREY 38 FOOT AN 42 FOOT MODELS ONLY
Line17595	Note:
13Jul16 / 17Mar17	

Inv.660	1 - MAIN FLOOR CEILING 10FT- 8' INTERIOR DOORS AND ARCHES, TALLER FRONT AND REAR ELEVATION DOORS AND WINDOWS WITH TRANSOM, KITCHEN FURRING PANEL AND CROWN WITH 12" BULK HEAD,
Line19130	Note:
13Jul16 / 17Mar17	

KITCHEN AND BATH CABINETRY

Inv.660	1 - MAIN FLOOR CEILING 10FT- 8' INTERIOR DOORS AND ARCHES, TALLER FRONT AND REAR ELEVATION DOORS AND WINDOWS WITH TRANSOM, KITCHEN FURRING PANEL AND CROWN WITH 12" BULK HEAD,
Line19131	Note:
13Jul16 / 17Mar17	

PLUMBING

Inv.660	1 - MASTER ENSUITE: UPGRADE TO FREE STANDING TUB - UPG1 ONLY
Line17194	Note:
13Jul16 / 17Mar17	

Inv.660	1 - KITCHEN: ROUGH - IN - WATERLINE FOR FRIDGE
Line17197	Note:
13Jul16 / 17Mar17	

WINDOWS - BASEMENT

Inv.660	4 - BASEMENT WINDOWS - UPGRADE EXISTING BASEMENT WINDOW TO 46 INCH X 32 INCH - MAY REQUIRE INSTALLATION OF WINDOW WELL
Line19137	Note:
13Jul16 / 17Mar17	

WINDOWS AND DOORS

Inv.660	1 - MAIN FLOOR CEILING 10FT- 8' INTERIOR DOORS AND ARCHES, TALLER FRONT AND REAR ELEVATION DOORS AND WINDOWS WITH TRANSOM, KITCHEN FURRING PANEL AND CROWN WITH 12" BULK HEAD,
Line19136	Note:
13Jul16 / 17Mar17	





CONSTRUCTION SUMMARY

Kleinburg Glen - 52 - 1 - 38-4 Elev.A BRIDGEPORT

10' CEILING
PACKAGE

R/IN MICRO
+
wall oven.

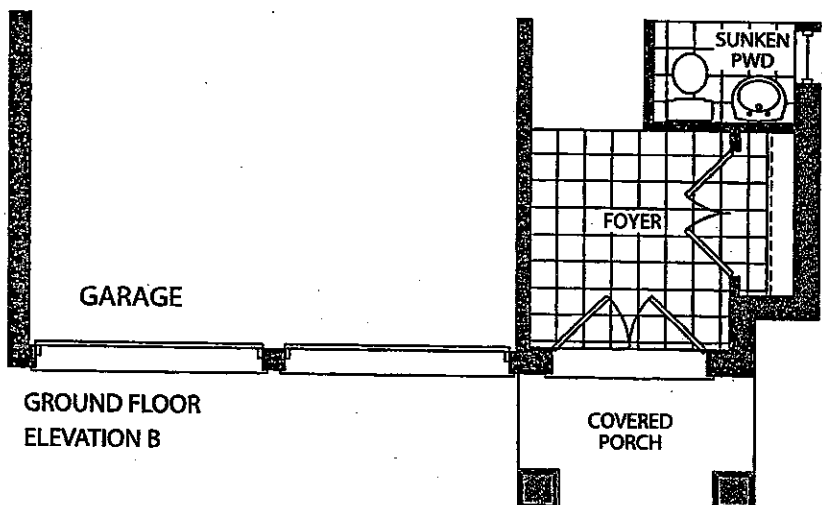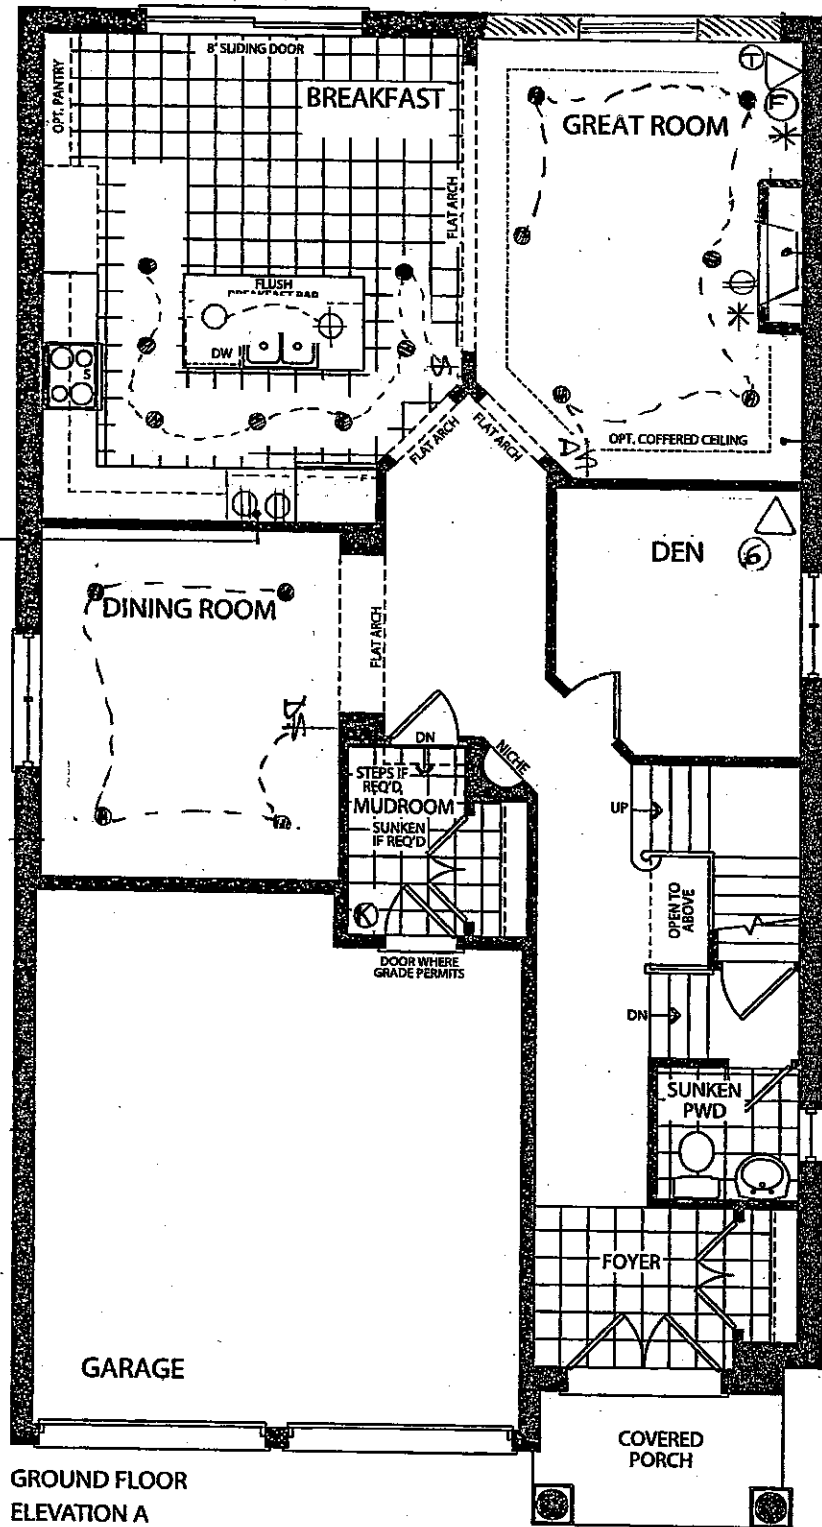

LEGEND

● POTLIGHT

○ STD CEILING
LIGHT

⊕ CAPPED CEILING
OUTLET

⊕ ELECT. OUTLET

* CONDUIT

Ⓢ FIBRE OPTIC


Ⓢ CAT 6

Ⓢ PHONE


Ⓢ R/IN KEYPAD

\$ SINGLE POLE
SWITCH

D\$ DIMMER SWITCH

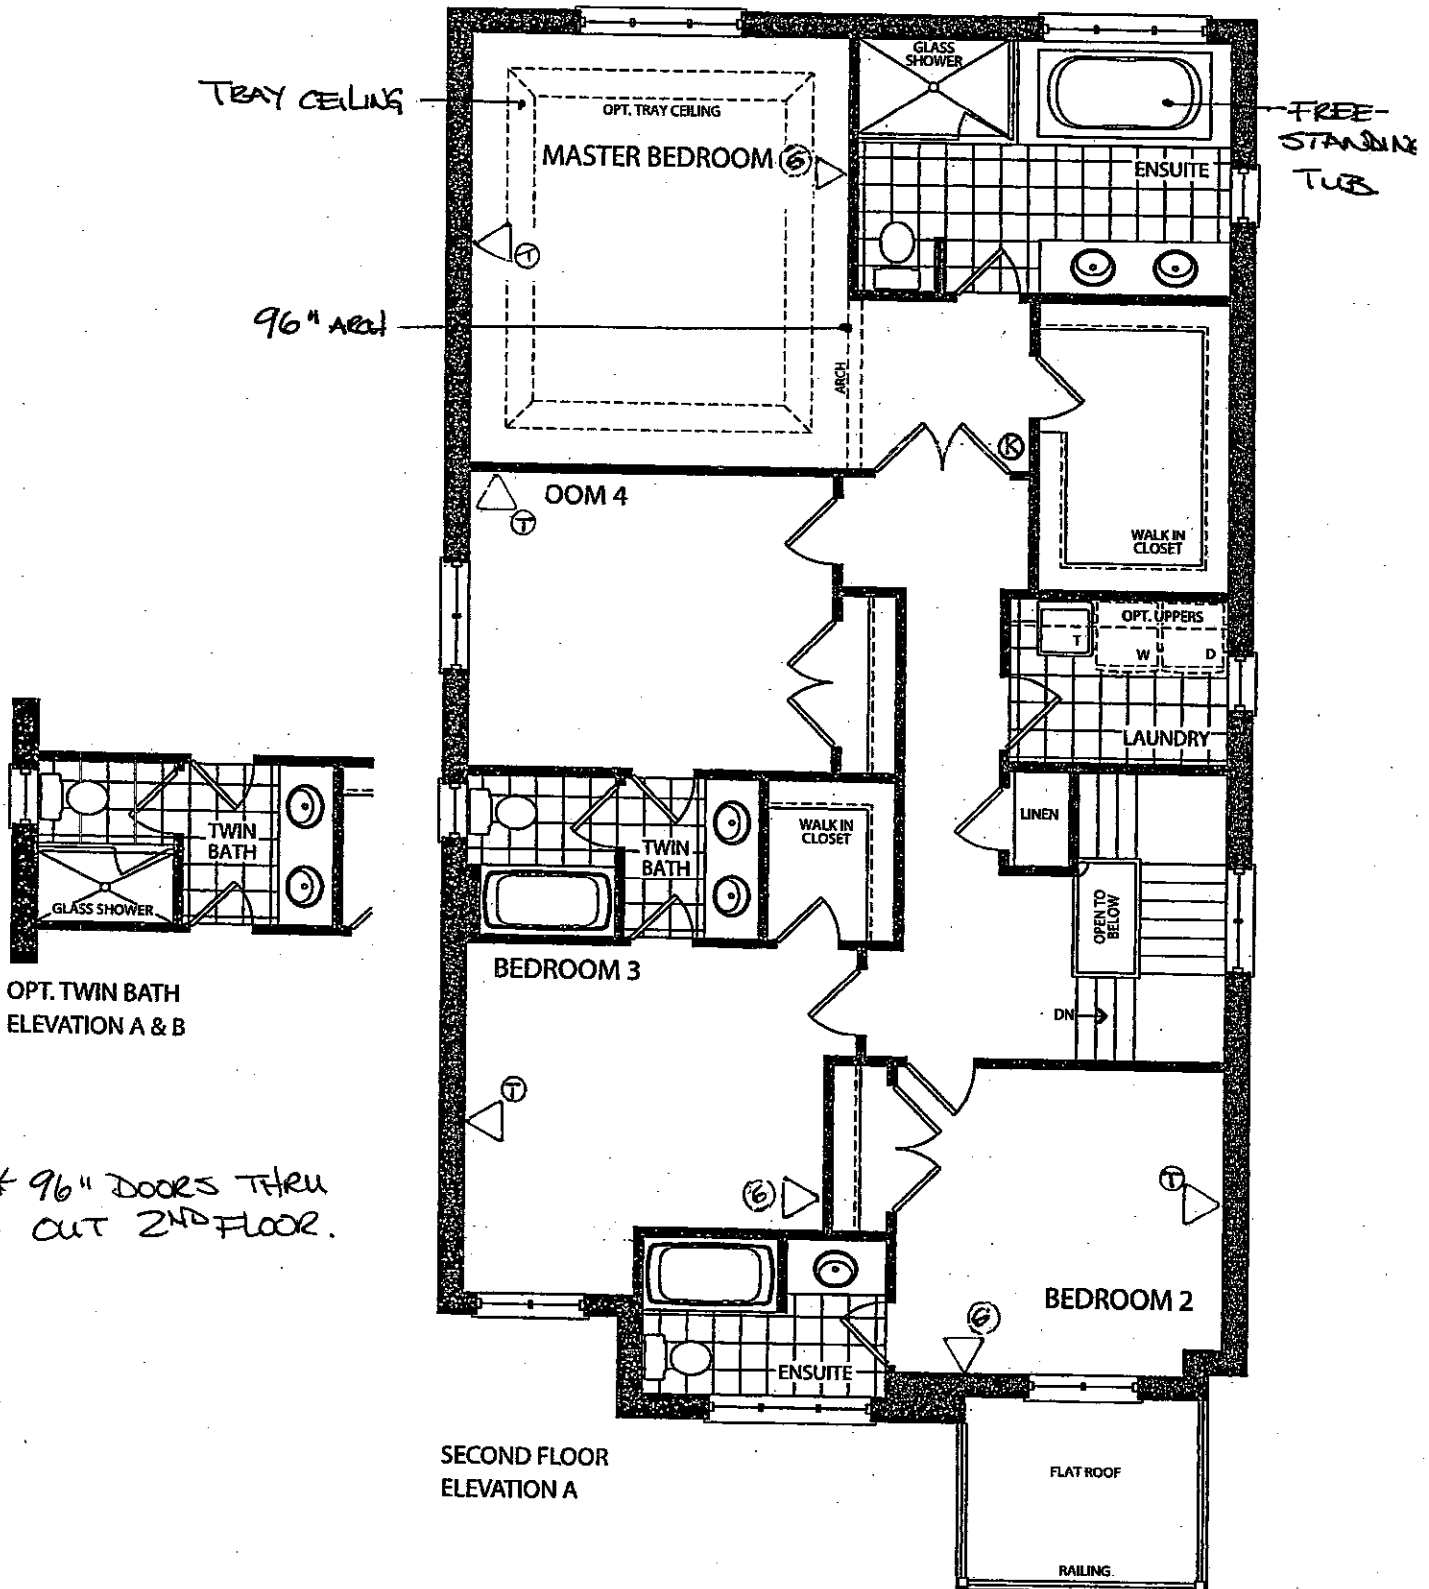

SECOND FLOOR
ELEVATION A

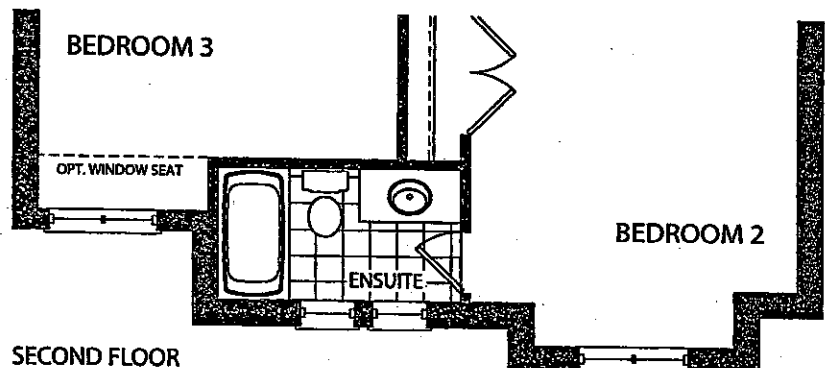

SECOND FLOOR
ELEVATION B

