

Kleinburg Glen - 86 - 1 - 38-4 Elev.A BRIDGEPORT
CENTRAL VAC AND WIRING

Inv.1,145	1 - GREAT ROOM: ROUGH - IN FIBER OPTIC CABLE - HOME RUN TO ELECTRICAL PANEL - See plan for location.
Line18306	Note:
30Jan17 / 17Mar17	
Inv.1,145	4 - DEN / MASTER BEDROOM / BEDROOM 2 / BEDROOM 3: CAT 6 WIRING - UPGRADE AN OUTLET TO CAT 6 - See plan for location.
Line18308	Note:
30Jan17 / 17Mar17	
Inv.1,145	1 - MUD ROOM: ROUGH - IN FOR EXTRA SECURITY KEY PAD
Line18305	Note:
30Jan17 / 17Mar17	
Inv.1,145	1 - GREAT ROOM: CONDUIT PIPE - FOR TELEVISION - Locate approx. 66" A.F.F. above fireplace, terminating beside fibre optic - see plan for location.
Line18307	Note:
30Jan17 / 17Mar17	

DRYWALL

Inv.1,145	1 - SMOOTH CEILINGS - (2 - Story Design) 2ND FLOOR
Line16913	Note:
30Jan17 / 17Mar17	

ELECTRICAL

Inv.1,145	1 - GREAT ROOM: 110V WALL RECEPTACLE ON NORMAL CIRCUIT - Locate apprx.66" A.F.F. above fireplace for future tv
Line18309	Note:
30Jan17 / 17Mar17	
Inv.1,145	1 - KITCHEN: 110V WALL RECEPTACLE ON DEDICATED CIRCUIT - GAS FIRED APPLIANCE - FOR AUX. EQUIPMENT - NOT A STOVE PLUG
Line18310	Note:
30Jan17 / 17Mar17	
Inv.1,145	1 - KITCHEN: 110V WALL RECEPTACLE ON DEDICATED CIRCUIT - FOR MICROWAVE - MICROWAVE NOT INCLUDED
Line18312	Note:
30Jan17 / 17Mar17	
Inv.1,145	1 - KITCHEN: 220V WALL RECEPTICAL ON DEDICATED CIRCUIT - FOR 4 WIRE BUILT - IN WALL OVEN - MUST SPECIFY LOCATION
Line18313	Note:
30Jan17 / 17Mar17	
Inv.1,145	7 - KITCHEN: POT LIGHT: 4 INCH HALOGEN POT LIGHT - 440 WH - PRICED PER LIGHT - 10 OR MORE
Line18314	Note:
30Jan17 / 17Mar17	
Inv.1,145	6 - GREAT ROOM: POT LIGHT: 4 INCH HALOGEN POT LIGHT - 440 WH - PRICED PER LIGHT - 10 OR MORE
Line18315	Note:
30Jan17 / 17Mar17	
Inv.1,145	1 - KITCHEN: Single pole switch for potlights
Line18316	Note:
30Jan17 / 17Mar17	

Kleinburg Glen - 86 - 1 - 38-4 Elev.A BRIDGEPORT

Inv.1,145	1 - GREAT ROOM:Single pole switch for potlights
Line18317	Note:
30Jan17 / 17Mar17	
Inv.1,145	1 - KITCHEN: Single pole switch for potlights
Line18318	Note:
30Jan17 / 17Mar17	
Inv.1,145	4 - DINING ROOM: POT LIGHT: 4 INCH HALOGEN POT LIGHT - 440 WH - PRICED PER LIGHT - 10 OR MORE
Line18319	Note:
30Jan17 / 17Mar17	
Inv.1,145	1 - KITCHEN: RELOCATE STANDARD FIXTURE - Locate above island, see plan for location.
Line18320	Note:
30Jan17 / 17Mar17	
Inv.1,145	1 - KITCHEN: ROUGH - IN CEILING OUTLET ON SAME SWITCH - DOES NOT INCLUDE FIXTURE - Locate above island, see plan for location. Use same switch as standard ceiling light
Line18321	Note:
30Jan17 / 17Mar17	
Inv.1,145	1 - DINING ROOM: UPGRADE TO DIMMER SWITCH - ONE UNIT See plan for location.
Line18322	Note:
30Jan17 / 17Mar17	

EXTERIOR COLOURS

Inv.1,145	1 - EXTERIOR COLOUR PACKAGE 7
Line16923	Note:
30Jan17 / 17Mar17	

FRAMING

Inv.1,145	1 - MASTER BEDROOM: EXTENDED HEIGHT ARCHWAY (PRICE PER DOORWAY) - 96"
Line16917	Note:
30Jan17 / 17Mar17	
Inv.1,145	1 - MAIN FLOOR CEILING 10FT- 8' INTERIOR DOORS AND ARCHES, TALLER FRONT AND REAR ELEVATION DOORS AND WINDOWS WITH TRANSOM, KITCHEN FURRING PANEL AND CROWN WITH 12" BULK HEAD,
Line18323	Note:
30Jan17 / 17Mar17	
Inv.1,145	1 - 2ND FLOOR: STANDARD DOOR EXTENDED HEIGHT 96 INCH (PRICE PER DOOR) MAIN FLOOR 3 STOREY MODELS -
Line19190	Note:
30Jan17 / 17Mar17	

GLASS AND MIRROR

Inv.1,145	1 - MASTER ENSUITE: CONVERT FRAMED SHOWER TO 10MM FRAMELESS SHOWER ENCLOSURE WITH DOOR AND 10MM SIDE PANEL
Line18325	Note:
30Jan17 / 17Mar17	

HVAC

Inv.1,145	1 - KITCHEN GAS LINE ROUGH - GROUND FLOOR for future gas stove
Line18311	Note:
30Jan17 / 17Mar17	

INTERIOR TRIM AND DOORS

Inv.1,145	18 - 2ND FLOOR: STANDARD DOOR EXTENDED HEIGHT 96 INCH (PRICE PER DOOR) MAIN FLOOR 3 STOREY MODELS -
Line16916	Note:
30Jan17 / 17Mar17	

Inv.1,145	1 - MAIN FLOOR CEILING 10FT- 8' INTERIOR DOORS AND ARCHES, TALLER FRONT AND REAR ELEVATION DOORS AND WINDOWS WITH TRANSOM, KITCHEN FURRING PANEL AND CROWN WITH 12" BULK HEAD,
Line19133	Note:
30Jan17 / 17Mar17	

KITCHEN AND BATH CABINETRY

Inv.1,145	1 - MAIN FLOOR CEILING 10FT- 8' INTERIOR DOORS AND ARCHES, TALLER FRONT AND REAR ELEVATION DOORS AND WINDOWS WITH TRANSOM, KITCHEN FURRING PANEL AND CROWN WITH 12" BULK HEAD,
Line19134	Note:
30Jan17 / 17Mar17	

PLUMBING

Inv.1,145	1 - MASTER ENSUITE: UPGRADE TO FREE STANDING TUB - UPG1 ONLY
Line18327	Note:
30Jan17 / 17Mar17	

WINDOWS - BASEMENT

Inv.1,145	4 - BASEMENT WINDOWS - UPGRADE EXISTING BASEMENT WINDOW TO 30 INCH X 16 INCH
Line16912	Note:
30Jan17 / 17Mar17	

WINDOWS AND DOORS

Inv.1,145	1 - MAIN FLOOR CEILING 10FT- 8' INTERIOR DOORS AND ARCHES, TALLER FRONT AND REAR ELEVATION DOORS AND WINDOWS WITH TRANSOM, KITCHEN FURRING PANEL AND CROWN WITH 12" BULK HEAD,
Line19135	Note:
30Jan17 / 17Mar17	

10' CEILING
PACKAGE



GAS LINE
+
ELECT.

B/I Micro
+
Wall OVEN.

GAS FIREPLACE

ELECT - 66" AFF
+ CONDUIT

COFFERED
CEILING.

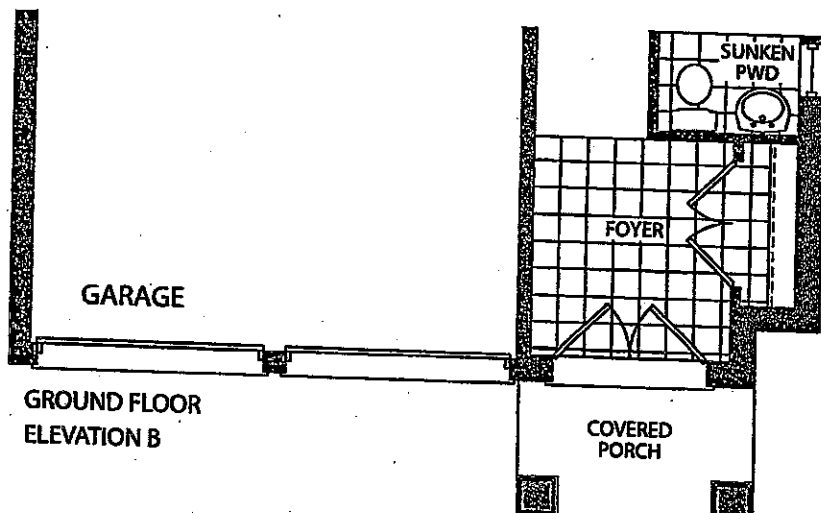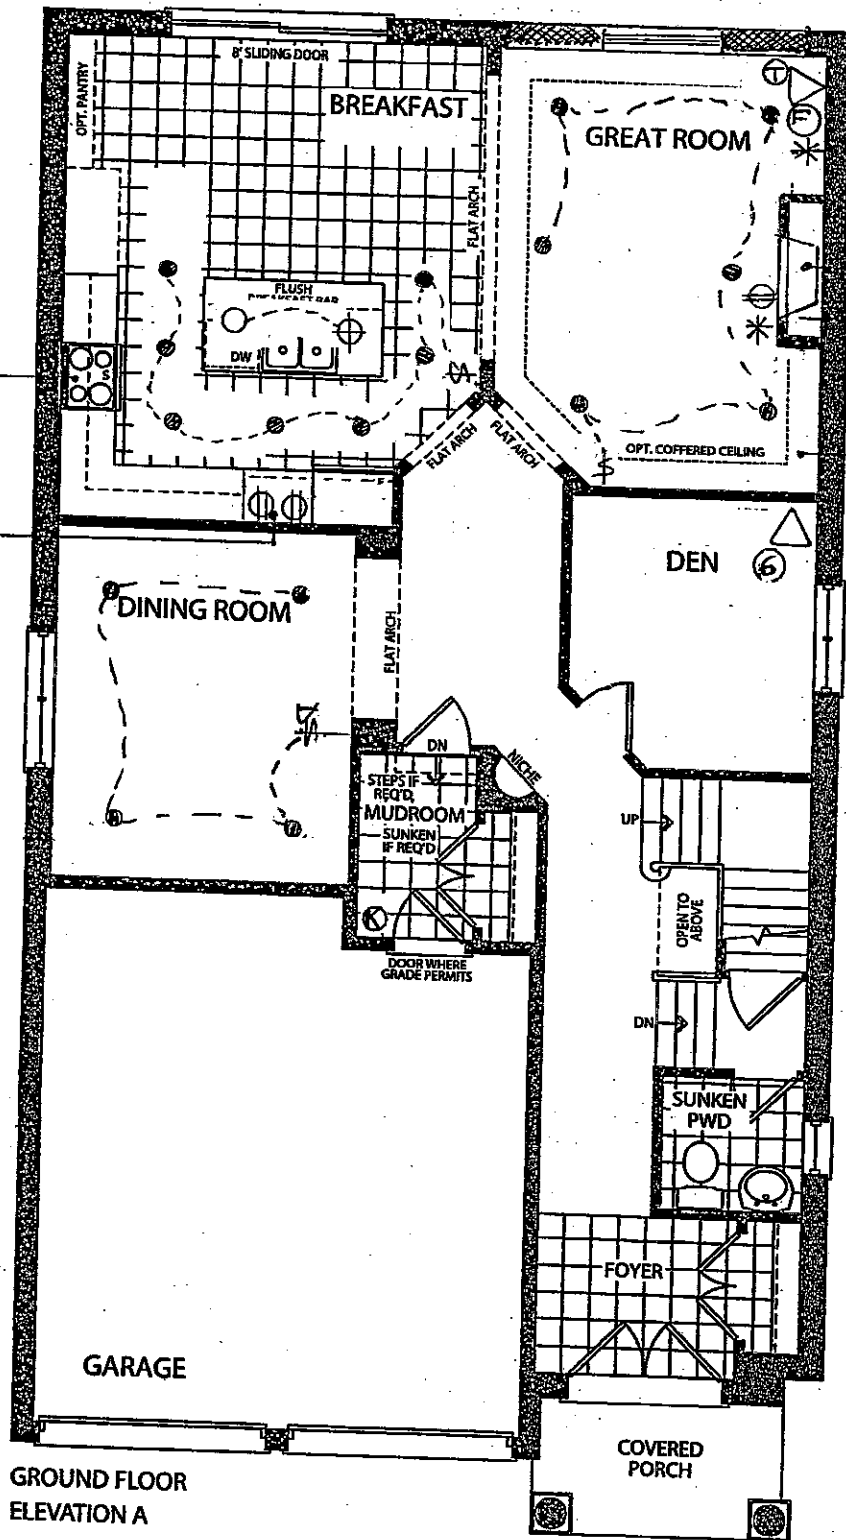

LEGEND.

● POTLIGHT

○ STD CEILING
LIGHT

⊕ COFFERED CEILING
OUTLET

⊕ ELECT. OUTLET

* CONDUIT

Ⓢ FIBRE OPTIC


Ⓢ CAT 6

Ⓢ PHONE

Ⓢ R/IN KEYPAD


\$ SINGLE POLE
SWITCH

D\$ DIMMER SWITCH.

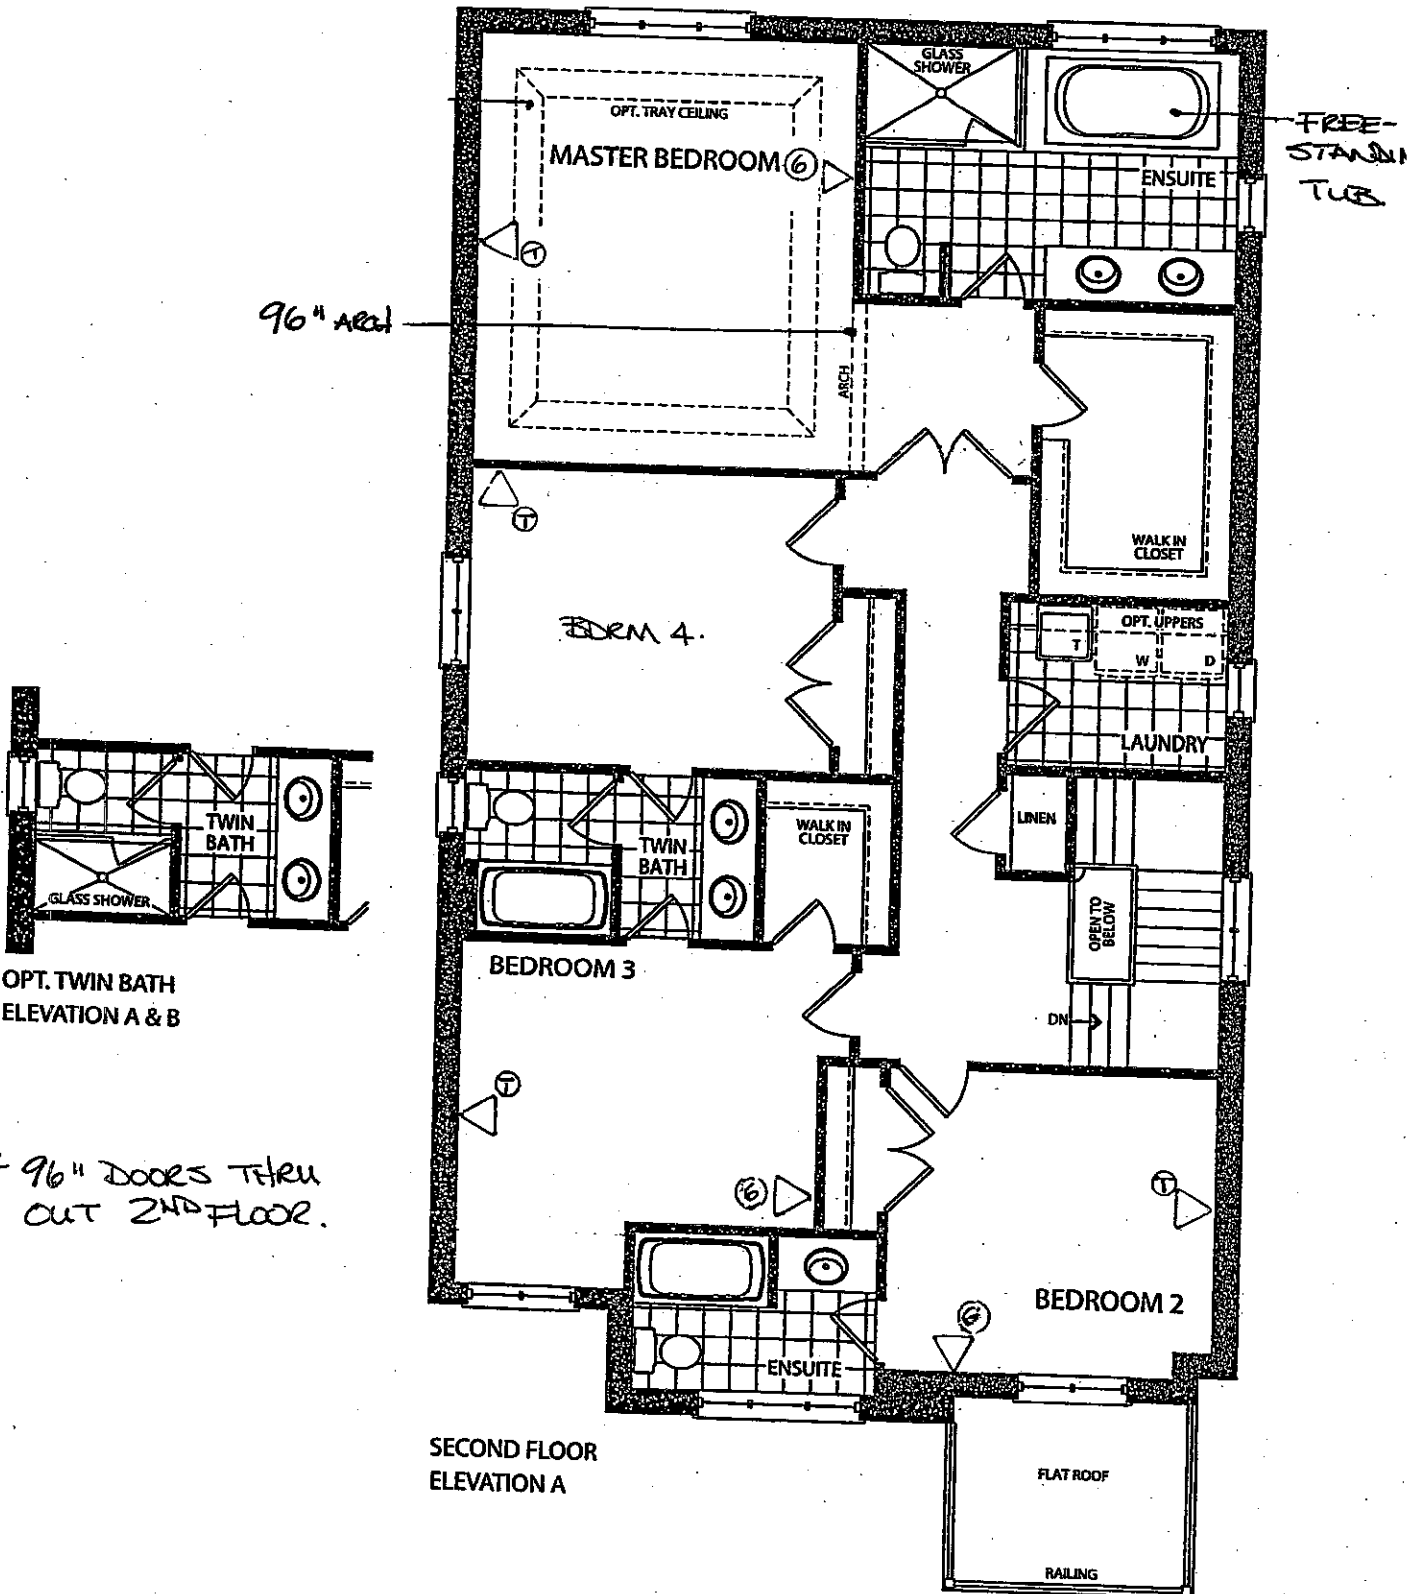

* 96" DOORS THRU
OUT 2ND FLOOR.

SECOND FLOOR
ELEVATION A

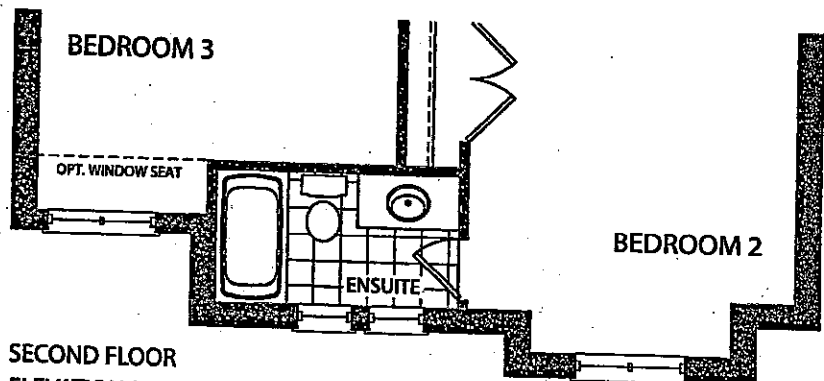

SECOND FLOOR
ELEVATION B

* Colour match
basement
windows

