

Kleinburg Glen - 80 - 1 - 38-6 Elev.A WYNDHAM OPT - SFA5

CENTRAL VAC AND WIRING

Inv.804	1 - CONDUIT PIPING: CONDUIT from attic to basement
Line11387	Note:
6Sep16 / 28Nov16	

CERAMIC

Inv.804	1 - TWIN BATH: CONVERT FROM TUB TO FULLY TILED SHOWER, COMPLETE WITH CURTAIN ROD.
Line14711	Note:
6Sep16 / 28Nov16	

Inv.1,119	1 - KITCHEN FLOOR TILE: Upgrade 5 - 24x24" Polished - laid in straight, stacked pattern. See plan for tile direction.
Line16418	Note:
23Jan17 / 6Apr17	

Inv.1,119	1 - FOYER FLOOR TILE: Upgrade 5 - 24x24" Polished - laid in straight, stacked pattern.
Line16419	Note:
23Jan17 / 6Apr17	

Inv.1,119	1 - POWDER ROOM FLOOR TILE: Upgrade 5 - 24x24" Polished - laid in straight, stacked pattern. See plan for tile direction.
Line16420	Note:
23Jan17 / 6Apr17	

Inv.1,119	1 - MASTER ENSUITE WALL TILE: Shower wall / Tub Skirt/Deck/Splash: Upgrade 1 wall tile - 4x12" Chess Bevelled - laid in horizontal stacked pattern.
Line16426	Note:
23Jan17 / 6Apr17	

ELECTRICAL

Inv.804	1 - KITCHEN: 110V WALL RECEPTACLE ON DEDICATED CIRCUIT - GAS FIRED APPLIANCE - FOR AUX. EQUIPMENT - NOT A STOVE PLUG *gas line to be completed by purchaser after closing*
Line10923	Note:
6Sep16 / 28Nov16	

Inv.804	1 - KITCEHN: 110V WALL RECEPTACLE ON DEDICATED CIRCUIT - For future 600+ cfm hood fan.
Line10924	Note:
6Sep16 / 28Nov16	

Inv.804	3 - KITCHEN: ROUGH - IN CEILING OUTLET ON SAME SWITCH - DOES NOT INCLUDE FIXTURE - Locate approx. center above island, see plan for location. In addition to builders standard light
Line10928	Note:
6Sep16 / 28Nov16	

Inv.804	1 - KITCHEN: Single pole switch for pendant lights above island. See plan for location.
Line10929	Note:
6Sep16 / 28Nov16	

Inv.804	1 - GREAT ROOM: 110V WALL RECEPTACLE ON NORMAL CIRCUIT - Locate approx. 60" A.F.F. for future tv. See plan for location.
Line10940	Note:
6Sep16 / 28Nov16	

Inv.804	1 - MASTER BEDROOM: 110V WALL RECEPTACLE ON NORMAL CIRCUIT - locate approx. 60" A.F.F. See plan for location.
Line10950	Note:
6Sep16 / 28Nov16	

Kleinburg Glen - 80 - 1 - 38-6 Elev.A WYNDHAM OPT - SFA5

Inv.804	1 - MASTER ENSUITE: Move builder's standard light to be centered above 1 sink + ADD 1 electrical rough-in for 2nd vanity light above other sink. See plan for location.
Line11389	Note:
6Sep16 / 28Nov16	
Inv.804	1 - KITCHEN: 240v/40a electrical for future wall oven/microw combo
Line11390	Note:
6Sep16 / 28Nov16	
Inv.804	1 - KITCHEN: REVISE LAYOUT, MOVE SINK AND DISHWASHER FROM ISLAND TO BY FRIDGE. See plan for layout.
Line14705	Note:
6Sep16 / 28Nov16	
Inv.804	1 - TWIN BATH: CONVERT FROM TUB TO FULLY TILED SHOWER, COMPLETE WITH CURTAIN ROD.
Line14710	Note:
6Sep16 / 28Nov16	
Inv.1,119	1 - Electrical changes were purchased at structural but custom cabinetry was not purchased to accommodate them. Homeowner to revise cabinetry at own expense and warranty after closing.
Line20584	Note:
23Jan17 / 6Apr17	

EXTERIOR COLOURS

Inv.804	1 - EXTERIOR COLOUR PACKAGE 1
Line14703	Note:
6Sep16 / 28Nov16	

FRAMING

Inv.804	1 - KITCHEN: REVISE LAYOUT, MOVE SINK AND DISHWASHER FROM ISLAND TO BY FRIDGE. See plan for layout.
Line10919	Note:
6Sep16 / 28Nov16	
Inv.804	1 - MAIN HALL: CREATE CURVED ARCH IN MAIN HALL. See plan for location.
Line10926	Note:
6Sep16 / 28Nov16	
Inv.804	1 - KITCHEN: Extend wall by fridge approx. 12" for future 36" depth fridge. See plan for location.
Line10927	Note:
6Sep16 / 28Nov16	
Inv.804	2 - MAIN FLOOR: FRAME MAIN FLOOR ARCHES AT 96 INCH, See plan for location.
Line10932	Note:
6Sep16 / 28Nov16	
Inv.804	1 - DINING ROOM: REDUCE width of archway to meet tile, see plan for location.
Line10934	Note:
6Sep16 / 28Nov16	
Inv.804	1 - MAIN HALL/KITCHEN: Create curved archway leading to kitchen. See plan for location.
Line10935	Note:
6Sep16 / 28Nov16	
Inv.804	6 - MAIN FLOOR: FRAME MAIN FLOOR DOORS AT 96 INCH - ADDED WITH THE ADDITION OF TALLER INTERIOR DOORS
Line10943	Note:
6Sep16 / 28Nov16	

Kleinburg Glen - 80 - 1 - 38-6 Elev.A WYNDHAM OPT - SFA5

Inv.804	1 - TWIN BATH: CONVERT FROM TUB TO FULLY TILED SHOWER, COMPLETE WITH CURTAIN ROD.
Line11283	Note:
6Sep16 / 28Nov16	

GLASS AND MIRROR

Inv.1,119	1 - Thru Out: Do *NOT* install mirrors!
Line16425	Note:
23Jan17 / 6Apr17	

HARDWOOD

Inv.1,119	1 - GREAT ROOM / DINING ROOM / DEN / MAIN HALL HARDWOOD FLOOR: Upgrade 3 - Vintage 3/4 x 4-3/8" Red Oak (smooth)
Line16421	Note:
23Jan17 / 6Apr17	

HVAC

Inv.804	1 - KITCHEN: UPGRADE VENTING FOR STOVE TO 8 INCH PIPE EXTERIOR WALL
Line10922	Note:
6Sep16 / 28Nov16	

INTERIOR TRIM AND DOORS

Inv.804	2 - MAIN FLOOR: EXTENDED HEIGHT ARCHWAY (PRICE PER DOORWAY) - INCLUDE FRAMING NOTE
Line10933	Note:
6Sep16 / 28Nov16	

Inv.804	6 - MAIN FLOOR: STANDARD DOOR EXTENDED HEIGHT 96 INCH (PRICE PER DOOR) - GROUND FLOOR 2 STOREY MODELS
Line10944	Note:
6Sep16 / 28Nov16	

Inv.804	1 - MAIN HALL: CREATE CURVED ARCH IN MAIN HALL. See plan for location.
Line14707	Note:
6Sep16 / 28Nov16	

KITCHEN AND BATH CABINETS

Inv.804	1 - KITCHEN: REVISE LAYOUT, MOVE SINK AND DISHWASHER FROM ISLAND TO BY FRIDGE. See plan for layout.
Line14706	Note:
6Sep16 / 28Nov16	

Inv.1,119	1 - KITCHEN CABINETS: Move sink and dishwasher from island to left of fridge. See plan for location.
Line16391	Note: SINK AND FAUCET WILL NOT BE CENTERED IN NEW SPACE!
23Jan17 / 6Apr17	

Inv.1,119	1 - KITCHEN CABINETS: Do NOT install hardware, or drill holes in Bathroom Vanities - Standard hardware installed in kitchen.
Line17331	Note:
23Jan17 / 6Apr17	

Inv.1,119	1 - KITCHEN CABINETS:
Line16414	Note: Electrical changes were purchased at structural but custom cabinetry was not purchased to accommodate them. Homeowner to revise cabinetry at own expense and warranty after closing.
23Jan17 / 6Apr17	

Kleinburg Glen - 80 - 1 - 38-6 Elev.A WYNDHAM OPT - SFA5

Inv.1,119	1 - Purchaser Accepts Standard Appliance Openings: Fridge - 37-1/2"W x 73-1/2" High Approx. Range - 30-1/2"D x 31-1/2"W Approx. Dishwasher - 24" W Approx.
Line17332	Note:
23Jan17 / 6Apr17	

MISC.

Inv.804	1 - Purchasers are aware & accepts that ANY changes made to upgrades after signing this Purchasers Extra Form are subject to a minimum administration fee of \$500. PLUS a 10% holdback fee.
Line11380	Note:
6Sep16 / 28Nov16	

Inv.804	1 - Purchaser has attended a Structural appointment at the Decor Centre & has DECLINED any additional upgrades and accepts and acknowledges that there will be no further structural changes/additions/deletions to be made upon signing on September 15, 2016.
Line11379	Note:
6Sep16 / 28Nov16	

Inv.804	1 - BONUS PACKAGE: \$7,500.00 (INCLUDING TAXES) WORTH OF UPGRADES FROM GOLD PARK HOMES DÉCOR CENTRE IS BEING APPLIED TOWARD THE STRUCTURAL APPOINTMENT. PURCHASER HAS A REMAINING AMOUNT OF \$00 (INCLUDING TAXES) TO BE USED TOWARD THE COLOUR APPOINTMENT
Line11381	Note:
6Sep16 / 28Nov16	

Inv.1,119	1 - Purchaser has attended a Colour appointment at the Decor Centre & has DECLINED any additional upgrades and accepts and acknowledges that there will be no further changes/additions/deletions to be made upon signing on January 23 2017.
Line16428	Note:
23Jan17 / 6Apr17	

Inv.1,119	1 - Purchasers are aware & accepts that ANY changes made to upgrades after signing this Purchasers Extra Form are subject to a minimum administration fee of \$500. PLUS a 10% holdback fee.
Line16429	Note:
23Jan17 / 6Apr17	

PAINTING

Inv.1,119	1 - MAIN STAIRS: Stain stairs to match hardwood floors (including landings stained on site)
Line16422	Note:
23Jan17 / 6Apr17	

Inv.1,119	1 - MAIN STAIRS: Paint White risers and stringers
Line16424	Note:
23Jan17 / 6Apr17	

PLUMBING

Inv.804	1 - MASTER ENSUITE & TWIN ENSUITE 4/5: Locate toe tester approx. 18" from shower floor.
Line10939	Note:
6Sep16 / 28Nov16	

Inv.804	1 - KITCHEN: REVISE LAYOUT, MOVE SINK AND DISHWASHER FROM ISLAND TO BY FRIDGE. See plan for layout.
Line14704	Note:
6Sep16 / 28Nov16	

Inv.804	1 - TWIN BATH: CONVERT FROM TUB TO FULLY TILED SHOWER, COMPLETE WITH CURTAIN ROD.
Line14709	Note:
6Sep16 / 28Nov16	

Kleinburg Glen - 80 - 1 - 38-6 Elev.A WYNDHAM OPT - SFA5**STAIRS AND RAILINGS**

Inv.1,119	1 - MAIN STAIRS: Euroline 2 + V Groove
Line16423	Note:
23Jan17 / 6Apr17	

TRIM AND DOORS

Inv.804	1 - MAIN HALL/KITCHEN: Create curved archway leading to kitchen. See plan for location.
Line14708	Note:
6Sep16 / 28Nov16	

WINDOWS - BASEMENT

Inv.804	4 - BASEMENT WINDOWS - UPGRADE EXISTING BASEMENT WINDOW TO 30 INCH X 24 INCH - MAY REQUIRE INSTALLATION OF WINDOW WELL
Line10941	Note:
6Sep16 / 28Nov16	

WINDOWS AND DOORS

Inv.804	1 - BREAKFAST: GARDEN DOORS IN LIEU OF PATIO SLIDERS - 6FT X 80 INCH WITH CLEAR GLASS
Line11278	Note:
6Sep16 / 28Nov16	

Inv.804	1 - SIDELITES - 1 PAIR - 12 INCH x 80 INCH HEIGHT - MUST ADD WITH 6 FOOT DOORS IN LIEU OF 8 FOOT SLIDERS
Line11280	Note:
6Sep16 / 28Nov16	

Purchasers: Rohini Gandhi & Sridhar S Alagianambi

Property: 80

Telephone Res. / Bus: (905) 417-5358

Project: Burkshire Holdings Inc.

Decor Advisor: Yolande Somerville

Model and Elevation: 38-6 Elev.A WYNDHAM OPT - SFA5

Layout Changes: Yes No Sketch Attached: Yes No Exterior Colour Scheme:

1. Cabinetry

	Style and Colour	Counter	Hardware
Kitchen / Breakfast	varese pvc 'mystic'	Granite: Grigio Sardo	cs1-24
Laundry Room	n/a	n/a	n/a
Powder Room	n/a	n/a	n/a
Twin 2/3	varese pvc 'crystal white'	P-Lam #4925k-07 'Calcutta Marble'	*none
Master Ensuite Bathroom	varese pvc 'mystic'	P-Lam #4925k-07 'Calcutta Marble'	*none
Second Ensuite Bathroom (If Applicable)	n/a	n/a	n/a
Twin 4/5	varese pvc 'choco maple'	P-Lam #7735-58 'Portico Marble'	*none
Dishwasher Cabinet	n/a		

Comment

2. Floor Tile

	Selection	Grout	Threshold
Entrance Vestibule	24x24" Volkas pol 'White'	n/a	n/a
Main Hall	n/a	n/a	n/a
Kitchen / Breakfast	24x24" Volkas pol 'White'	n/a	n/a
Laundry Room	13x13" Carrara 'Whitey/Grey'	n/a	n/a
Powder Room	24x24" Volkas pol 'White'	n/a	n/a
Twin 2/3	13x13" New Reeds 'Brown'	n/a	n/a
Master Ensuite Bathroom	13x13" Serpentine 'Beyaz-white'	n/a	n/a
Second Ensuite Bathroom (If Applicable)	n/a	n/a	n/a
Lower Landing (If Applicable)	n/a	n/a	n/a
Twin 4/5	13x13" Reflex 'White'	n/a	n/a

Comment

Grout lines as small as possible!

3. Wall Tile

	Selection	Listello/Inserts	Describe
M. Ens. Tub skirt/splash	*4x12" Chess 'Arctic White'	<input type="radio"/> Yes <input checked="" type="radio"/> No	
Master Ensuite Bathroom			
Tub Deck	*4x12" Chess 'Arctic White'	<input type="radio"/> Yes <input checked="" type="radio"/> No	
Shower Stall	*4x12" Chess 'Arctic White'	<input type="radio"/> Yes <input checked="" type="radio"/> No	
Bathroom Walls	n/a	<input type="radio"/> Yes <input checked="" type="radio"/> No	
Second Ensuite Bathroom (If Applicable)	n/a	<input type="radio"/> Yes <input checked="" type="radio"/> No	
Twin 2/3	8x10" Weave 'White'	<input type="radio"/> Yes <input checked="" type="radio"/> No	

Kitchen Backsplash

Yes No

Backsplash Behind Fridge

Comment

Twin 4/5: 8x10" Reflex 'White'

AS B

Purchasers: Rohini Gandhi & Sridhar S Alagianambi **Property:** 80
Telephone Res. / Bus: (905) 417-5358 **Project:** Burkshire Holdings Inc.
Decor Advisor: Yolande Somerville **Model and Elevation:** 38-6 Elev.A WYNDHAM OPT - SFA5

4. Plumbing Fixtures

<input type="checkbox"/>	Second Ensuite	<input type="checkbox"/>	Powder Room	<input type="checkbox"/>
<input type="checkbox"/>	Master Ensuite Bathroom	<input type="checkbox"/>	Other Room - Specify	<input type="checkbox"/>
		<input type="checkbox"/>	Other Washroom	<input type="checkbox"/>

Comment

Standard Plumbing thru out
 Note: location of sink and dishwasher

5. Hardwood Flooring

	Type and Stain		Type and Stain
Main Hall	*Vintage Red Oak 'Eclipse'	Upper Landing	n/a
Kitchen / Breakfast	n/a	Upper Hall	n/a
Living Room	n/a	Master Bedroom	n/a
Dining Room	*Vintage Red Oak 'Eclipse'	Bedroom #2	n/a
Family Room	*Vintage Red Oak 'Eclipse'	Bedroom #3	n/a
Den/Library	*Vintage Red Oak 'Eclipse'	Bedroom #4	n/a
Entrance Vestibule	n/a	Bedroom #5	n/a
Lower Landing (If Applicable)	n/a	Other Room - Specify	n/a
		n/a	

Comment

6. Carpeting

	Upgrade	Description
Main Hall	<input type="checkbox"/>	n/a
Living Room	<input type="checkbox"/>	n/a
Dining Room	<input type="checkbox"/>	n/a
Family Room	<input type="checkbox"/>	n/a
Den/Library	<input type="checkbox"/>	n/a
Upper Hall	<input type="checkbox"/>	T-04
Master Bedroom	<input type="checkbox"/>	T-04
Bedroom #2	<input type="checkbox"/>	T-04
Bedroom #3	<input type="checkbox"/>	T-04
Bedroom #4	<input type="checkbox"/>	T-04
Bedroom #5	<input type="checkbox"/>	T-04
<input type="checkbox"/>	<input type="checkbox"/>	
Upper Landing (If Applicable)	<input type="checkbox"/>	n/a
Lower Landing (If Applicable)	<input type="checkbox"/>	n/a

Upgrade Underpad	Type	Area
	n/a	n/a
Carpet on Stairs	Capped	Runner - *Upgrade
	n/a	n/a

Comment

Standard carpet and standard underpad in bedrooms and upper hall

AS PS

Purchasers: Rohini Gandhi & Sridhar S Alagianambi

Property: 80

Telephone Res. / Bus: (905) 417-5358

Project: Burkshire Holdings Inc.

Decor Advisor: Yolande Somerville

Model and Elevation: 38-6 Elev.A WYNDHAM OPT - SFA5

7. Fireplace

	Living Room			Family Room			Other Room - Specify		
	Purchased	As Per Plan	N/A	Purchased	As Per Plan	N/A	Purchased	As Per Plan	N/A
	<input type="radio"/>	<input type="radio"/>	<input checked="" type="radio"/>	<input type="radio"/>	<input checked="" type="radio"/>	<input type="radio"/>	<input type="radio"/>	<input type="radio"/>	<input checked="" type="radio"/>
Fireplace Type	<input type="text"/>			Standard Gas			<input type="text"/>		
Mantle Type	<input type="text"/>			Standard Mediterranean			<input type="text"/>		
Colour / Stain	<input type="text"/>			Standard			<input type="text"/>		
Surround	<input type="text"/>			None			<input type="text"/>		
Hearth	<input type="text"/>			None			<input type="text"/>		
Comment	<input type="text"/>								

8. Trim Carpentry

Interior Doors Front Door Glass Inserts Door Handles

Interior Trim

Comment

9. Plaster Mouldings and Medallions

Entrance Vestibule	<input type="text"/>	<input type="text"/>	Kitchen/Breakfast	<input type="text"/>	<input type="text"/>
Main Hall	<input type="text"/>	<input type="text"/>	Den/Library	<input type="text"/>	<input type="text"/>
Living Room	<input type="text"/>	<input type="text"/>	Lower Landing	<input type="text"/>	<input type="text"/>
Dining Room	<input type="text"/>	<input type="text"/>	Other Room - Specify	none	<input type="text"/>
Family Room	<input type="text"/>	<input type="text"/>	Thru Out	<input type="text"/>	<input type="text"/>
Comment	<input type="text"/>				

10. Railings and Spindles

Railing Package

Railing Colour Spindle Colour

Stringer / Riser Treads

Comment

Oak Stairs Yes No

11. Wall Paint

Main & Upper Hall	<input type="text"/>	Master Bedroom	<input type="text"/>
Living Room	<input type="text"/>	Bedroom #2	<input type="text"/>
Dining Room	<input type="text"/>	Bedroom #3	<input type="text"/>
Kitchen / Breakfast	<input type="text"/>	Bedroom #4	<input type="text"/>
Family Room	<input type="text"/>	Bedroom #5	<input type="text"/>
Powder Room	<input type="text"/>	Master Ensuite	<input type="text"/>
Laundry Room	<input type="text"/>	Second Ensuite	<input type="text"/>
Den/Library	<input type="text"/>	Thru Out	<input type="text" value="Cool White"/>
Trim Paint	<input type="text"/>		
Comment	Smooth Ceilings First Floor <input type="text"/>		

(AS) (RS)

Scheduled Closing Date: Wednesday, February 08, 2017

Purchasers: Rohini Gandhi & Sridhar S Alagianambi

Property: 80

Telephone Res. / Bus: (905) 417-5358

Project: Burkshire Holdings Inc.

Decor Advisor: Yolande Somerville

Model and Elevation: 38-6 Elev.A WYNDHAM OPT - SFA5

12. Electrical

Plugs and Switches White Ivory Above Kitchen Cabinet Light Yes No
 Hood Fan White Ivory Below Kitchen Cabinet Light Yes No
 Appliances Built in Cooktop Built in Oven Gas Stove Microwave
 Yes No Yes No Yes No Yes No

Comment

Standard Stainless Steel Hood Fan
 *Extra electrical was purchased, but cabinetry customization was not! Electrical will not match cabinetry!

13. Heating and Air Conditioning

Air Conditioning Gas Provisions Stove
 Gas Provisions Dryer Gas Provisions Barbecue

Comment

Standard Gas BBQ Gas Line


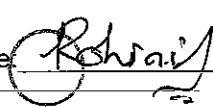
14. Additional Comments

[Empty box for additional comments]

15. Disclaimers and Notes

- 1) Colours of all materials are as close as possible to builder's selection, but not necessarily identical due to variances in manufacturing.
- 2) Any extras listed above are null and void unless accompanied by a separate invoice/amendment. Said invoice must be paid in full.
- 3) The Purchaser acknowledges that after Interior Colour Selection form is signed and dated, no further changes will be permitted other than re-selection due to unavailability. _____ Purchaser's Initials
- 4) The Purchaser acknowledges reading and accepting the "Gold Park Homes Decor Centre Disclaimers" form. This document contains other miscellaneous disclaimers.

This Interior Colour Selection is final and approved by:


Signature:  Date: Feb 9/17 Signature:  Date: Feb 9/17

GARDEN DOOR
+ SIDE LOT

Elevation A • 2,951 sq.ft.

Elevation B • 2,954 sq.ft.

No PHONE
in KITCHEN

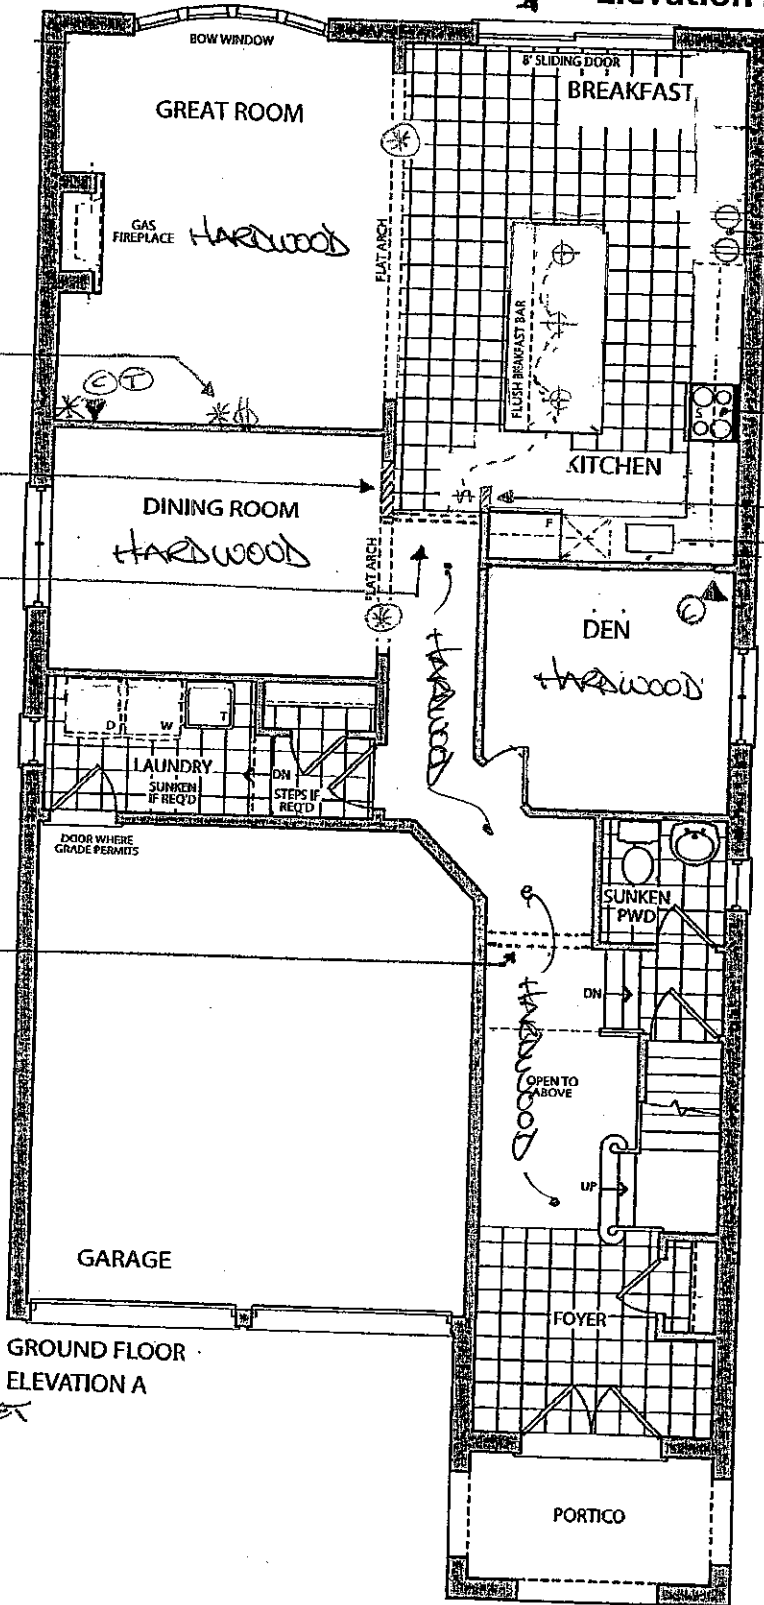


MICRO
WALL OVEN *CABINETS
NOT PURCHASED

GAS LINE
+
DED. ELECT.

EXTEND WALL 12"

RELOCATE
SINK, D/W

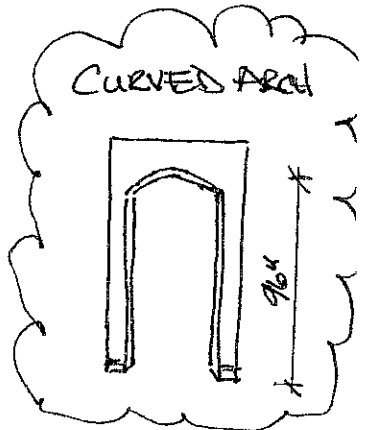

60" AFF
EXTEND WALL
ADD:
CURVED
ARCH.

ADD:
CURVED
ARCH.

⊕ R/in Capped
CEILING outlet

\$ SINGLE POLE
SWITCH


⊕ ELECTRICAL outlet

⊗ 96" ARCH.

Ⓜ CABLE

Ⓟ PHONE

GROUND FLOOR
ELEVATION A

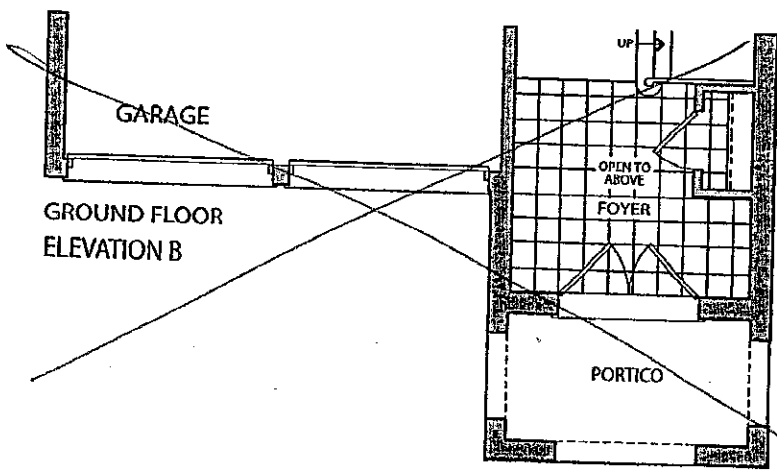

GROUND FLOOR
ELEVATION B

SEPT 15 2016

LOT 80

AS AS

KG-80


FEB 9 2017

AS AS

Prices, figures, illustrations, sizes, features and finishes are subject to change without notice. E.&O.E. Areas and dimensions are approximate and actual usable floor space may vary from the stated area. Layout may be reverse of the unit purchased. E. & O.E.

Elevation A • 2,951 sq.ft.

Elevation B • 2,954 sq.ft.

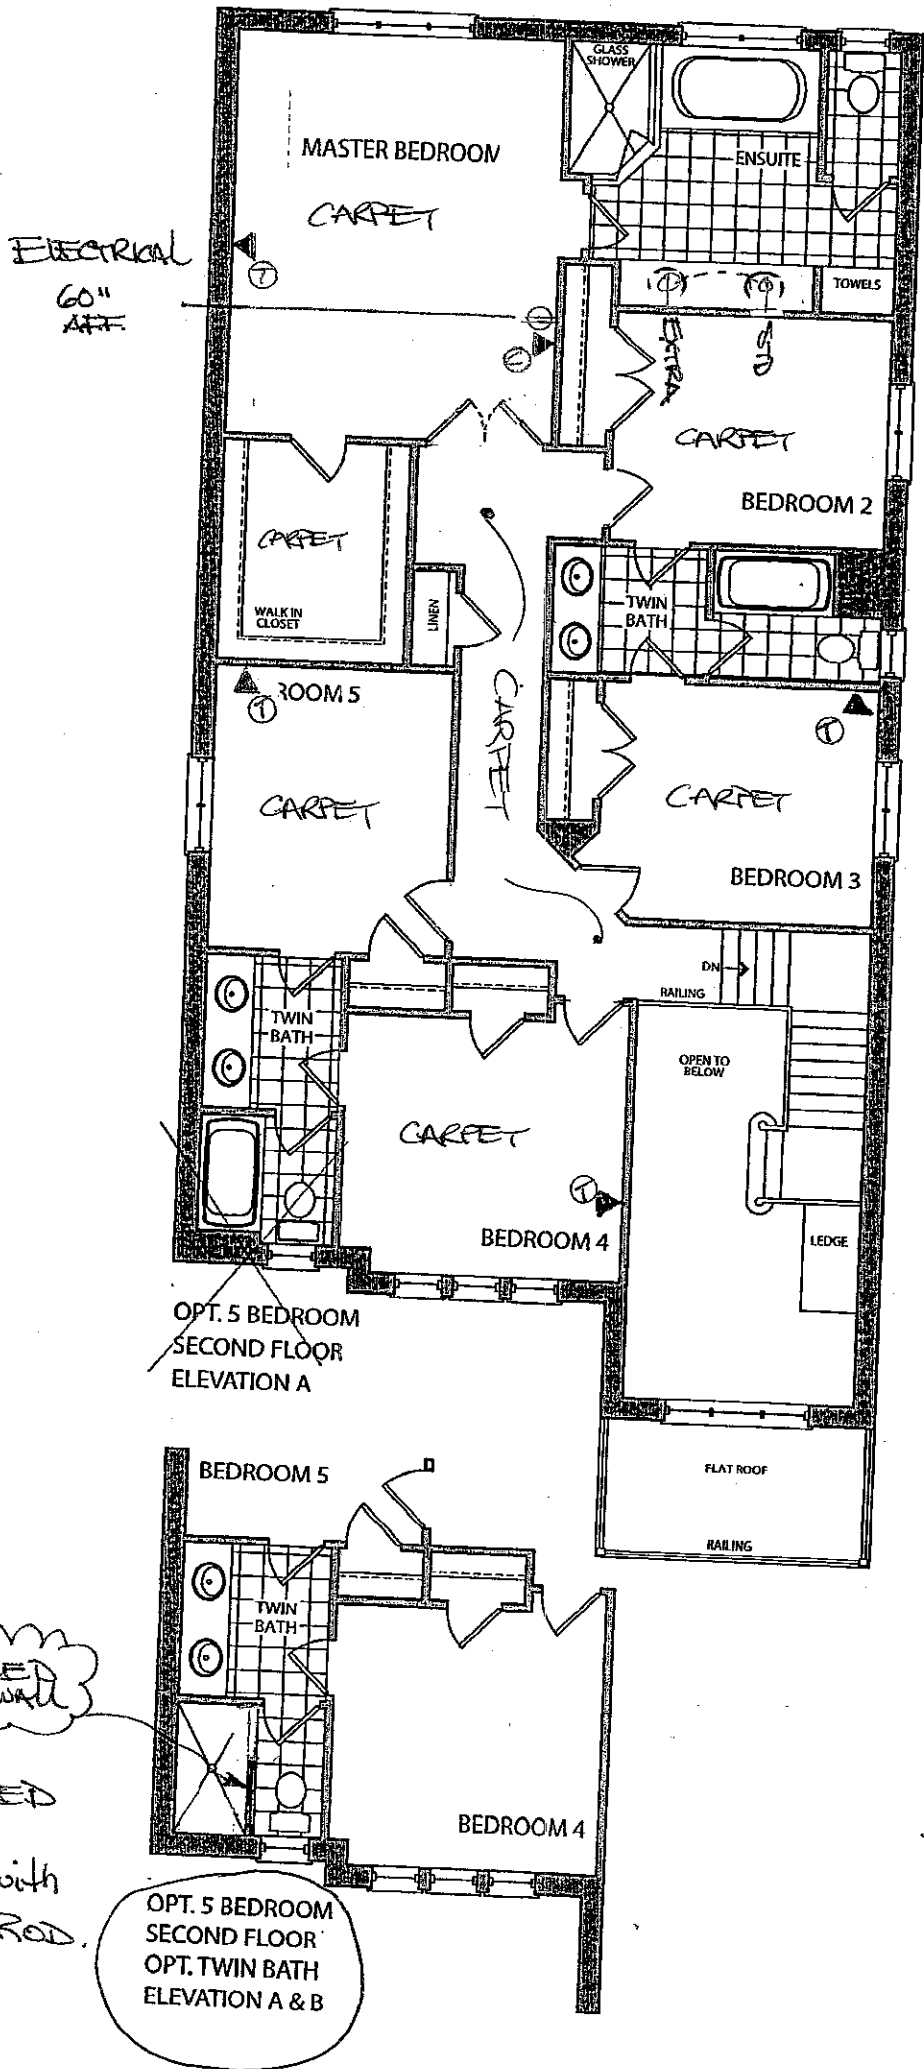

OPT. 5 BEDROOM
SECOND FLOOR
ELEVATION A

OPT. 5 BEDROOM
SECOND FLOOR
OPT. TWIN BATH
ELEVATION A & B


AS (P)
KG-80
FEB 9 2017

(P) AS
SEPT 12 2016
LOT 80

Prices, figures, illustrations, sizes, features and finishes are subject to change without notice. E.&O.E. Areas and dimensions are approximate and actual usable floor space may vary from the stated area. Layout may be reverse of the unit purchased. E. & O.E.

Elevation A • 2,951 sq.ft.

Elevation B • 2,954 sq.ft.

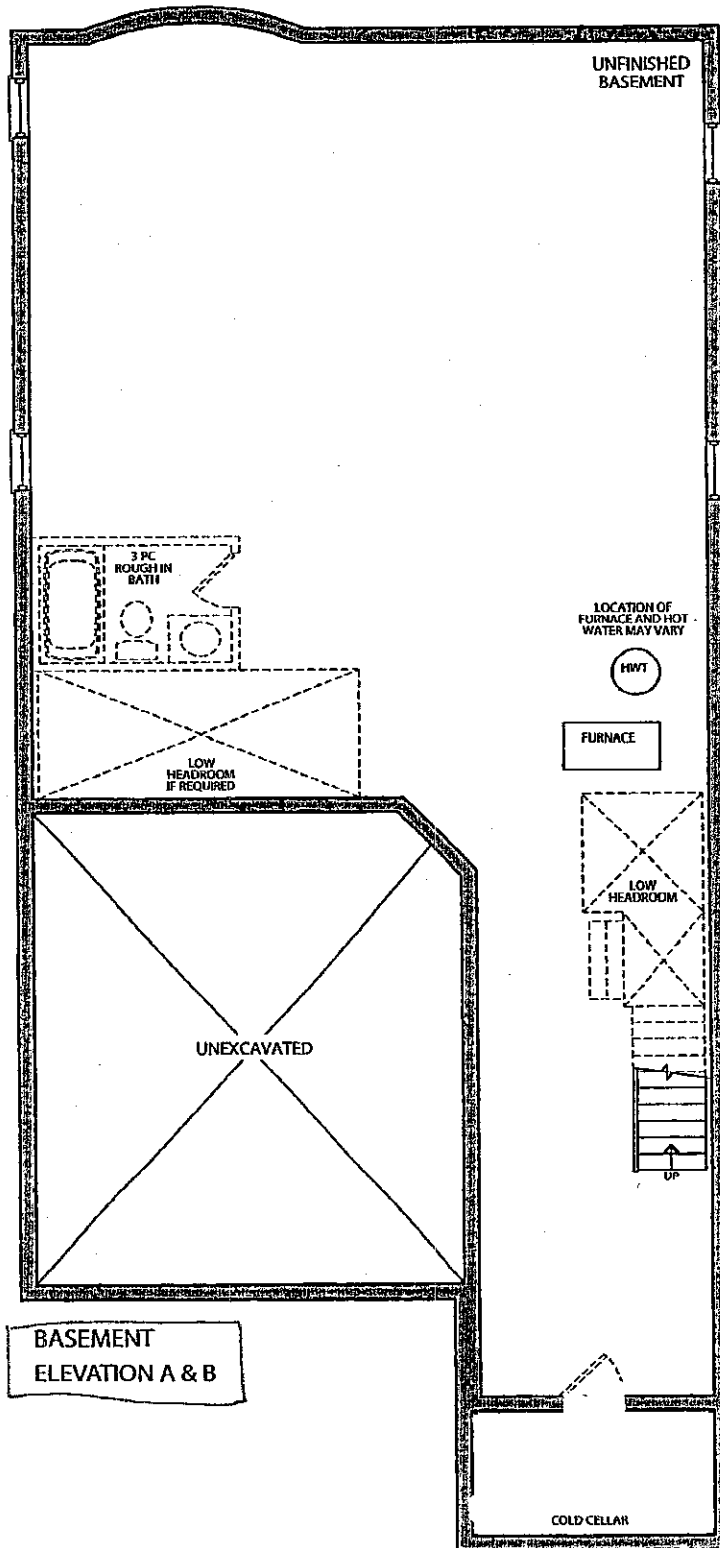


KG-80
FEB 9 2017
AS (P)
SEPT 15 2016
LOT 80

(P) (AS)

Trade Name: Gold Park Homes	Site location:	Model: 38-6
Address:	Project: Kleinburg Glen	Phase:

This layout has been explained to the purchaser by Cortina Kitchens Inc. and is understood by the purchaser.

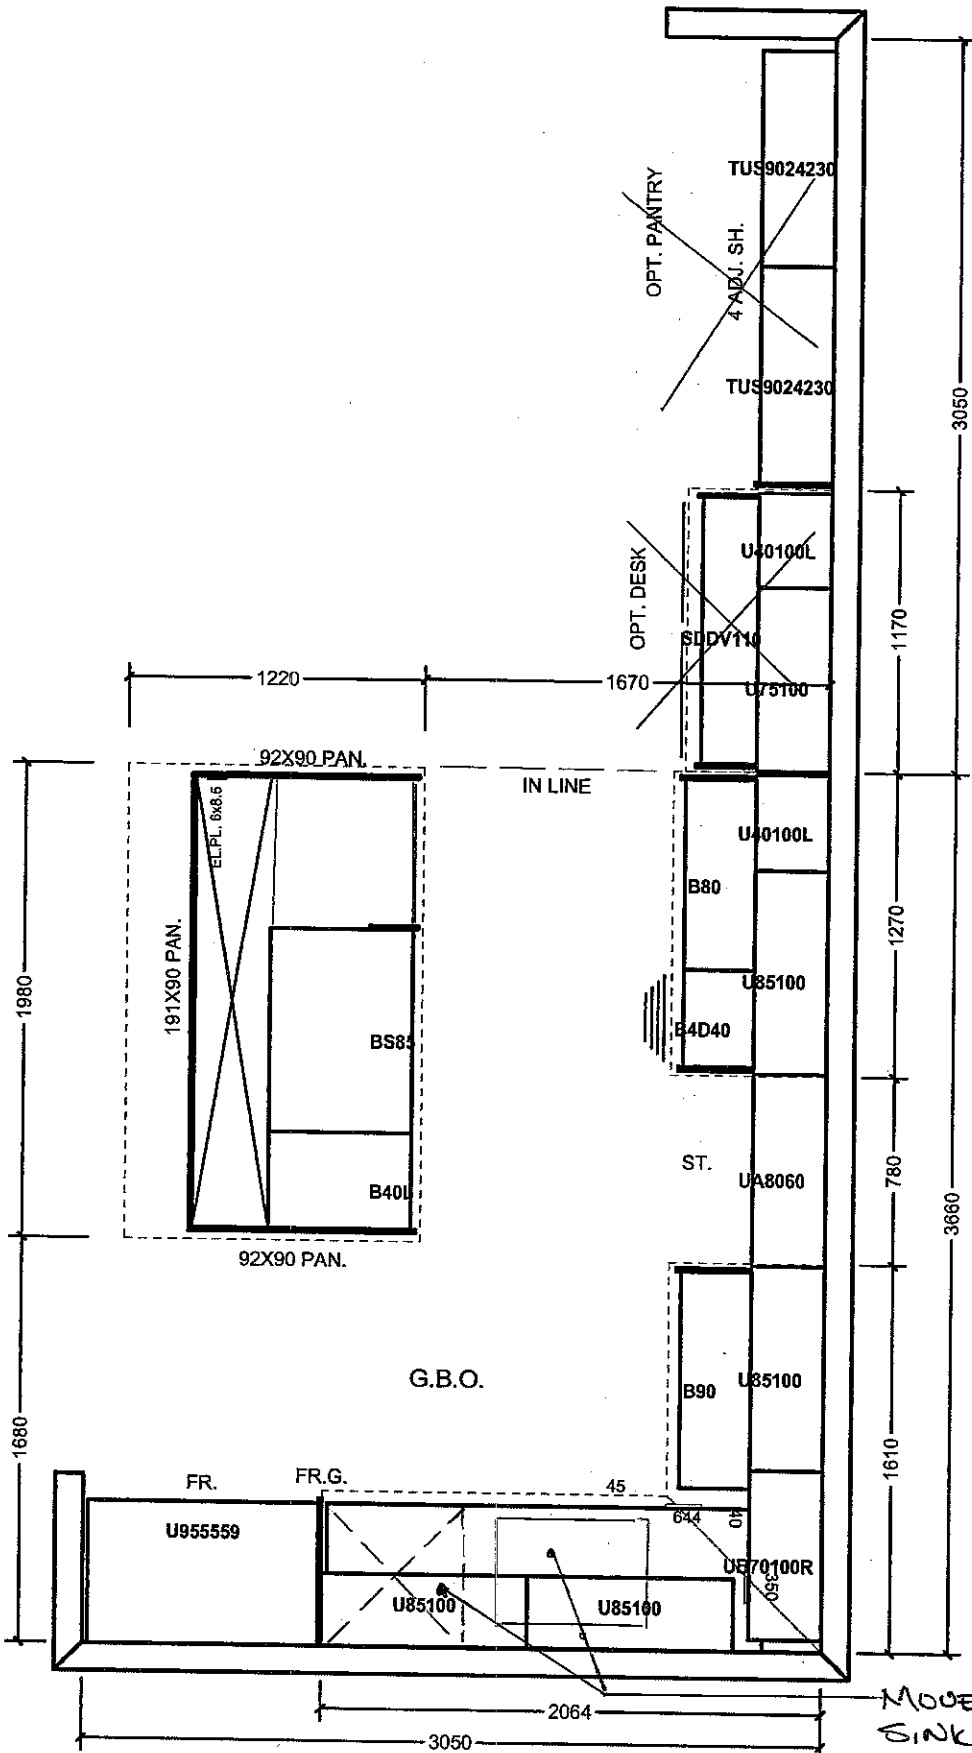

MOVE STD SINK & DW to here
*will NOT be CENTERED!

All prices subject to confirmation from head office.
This quotation is subject to the terms & conditions set out

ACCEPTED DATE: _____


All agreements are contingent upon strikes, accidents, and delays beyond our control.
Please provide our installer with template for sinkholes or \$150.00 will be charged for callback.

Item A. Wood grain and colour are characteristics of the product. We cannot guarantee that such grain and colour will always match.
Item B. Cortina Kitchens Inc. reserves the right to alter dimensions and make technical changes without notice.


Trade Name: Gold Park Homes	Site location:	Model: 38-6
Address:	Project: Kleinburg Glen	Phase:

This layout has been explained to the purchaser by Cortina Kitchens Inc. and is understood by the purchaser.

*** No HARDWARE in BATHROOMS ONLY***

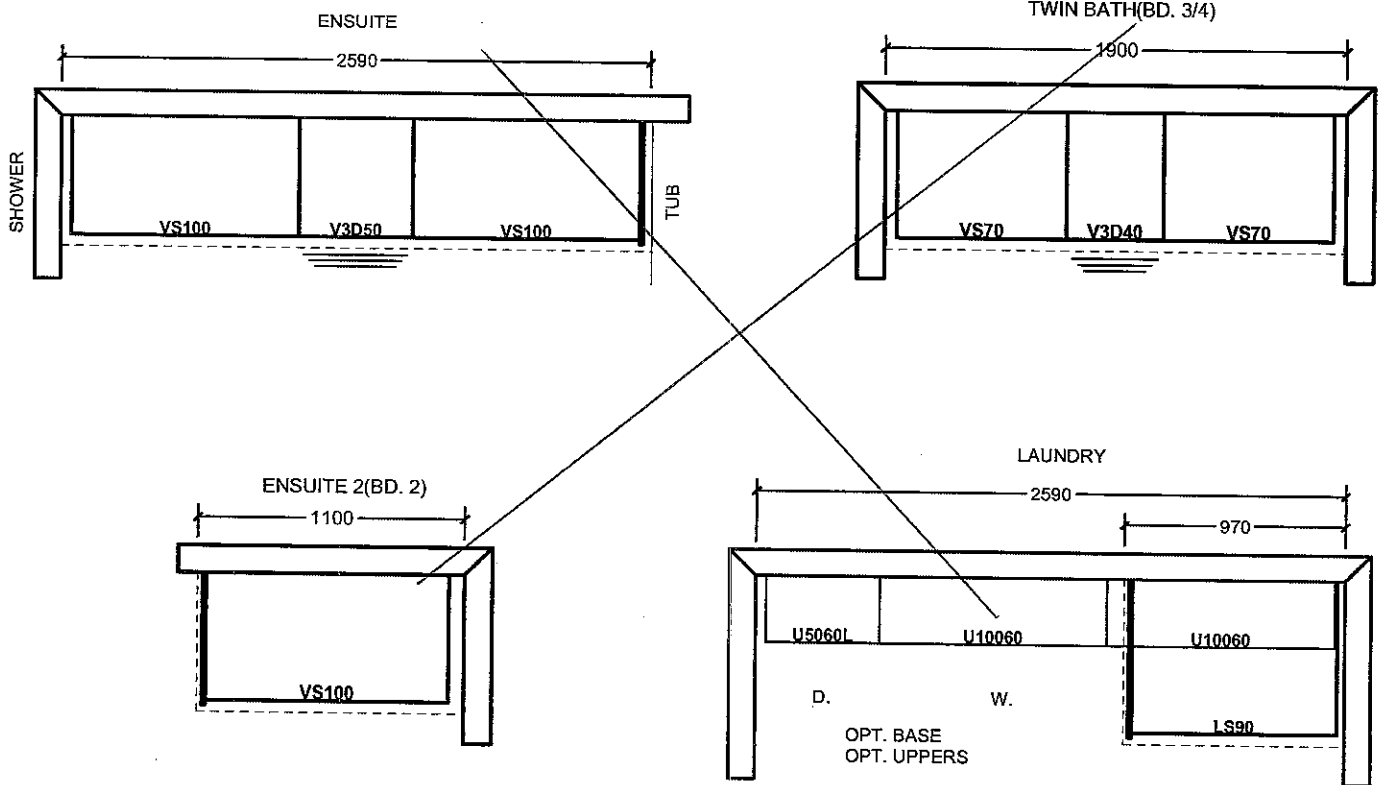

OPT. 5 BED. SECOND FLOOR

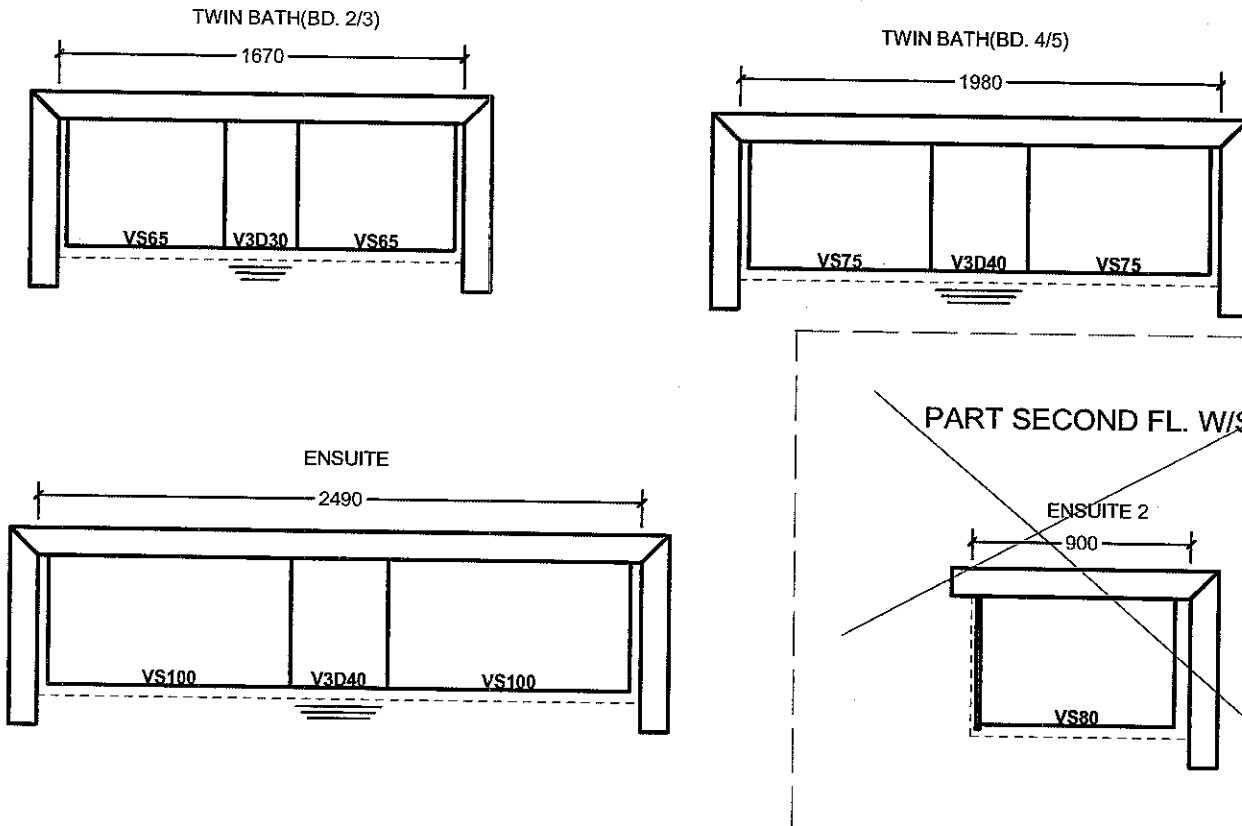

All prices subject to confirmation from head office.
This quotation is subject to the terms & conditions set out

All agreements are contingent upon strikes, accidents, and delays beyond our control.
Please provide our installer with template for sinkholes or \$150.00 will be charged for callback.

ACCEPTED DATE: _____

CORTINA KITCHENS INC.

70 Regina Road, Woodbridge, ON L4L 8L6
Tel:(905) 264-6464 Fax:(905) 264-0664

December, 2008

POLICY MEMO FOR BUILDERS

DRILLING FOR KNOB AND HANDLE HARDWARE

Builder: GOLDPARK Project: KLEINBURG
Lot #: 80 Date: FEB 9 2017

Cortina Kitchens' cabinetry doors and drawer fronts will be drilled to accept a standard knob or handle selected from Cortina's hardware boards. This drilling comes standard with the order, and is done ONLY in our shop, not on the job site.

For those not wanting Cortina's standard drilling, the following applies:

No holes to be drilled on the doors and drawer fronts should be specified in writing on the order. If while in production, Cortina Kitchens misses this request, Cortina Kitchens and the Builder will not be held responsible to replace any or all doors and drawer fronts affected, and the customer agrees to accept the product as is. No hardware will be supplied or credited by Cortina Kitchens. No charge will apply for this request.

I, _____, have read and agree to the above information.

Customer Signature:

John [Signature]

Date:

Feb 9 2017

* THRU OUT ALL BATHS!
BATHROOMS ONLY.

KG-800

FEB. 9 2017


MS
B

- Standard 2CM & 3CM
- Upgrade 1 2CM & 3CM
- Upgrade 1 4CM
- Upgrade 2


20mm (3/4") Profiles



30mm (1 1/4") Profiles

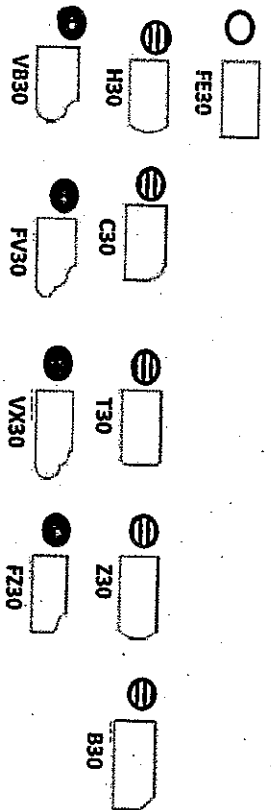

40mm (1 1/2") Profiles

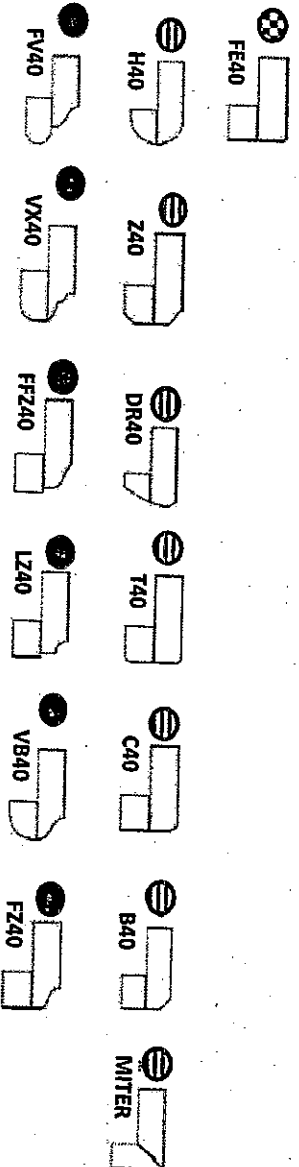

Note: All colours may not be available in 30mm at time ordered. Vendor reserves the right to use 40 mm edges (by lamination process).

*Mitre edge is available in Upgrade 1 for an overall thickness of 2". All other Mitre edge options will be an Upgrade 2 Edge.

* STD SINK & FAUCET.

CORTINA

KITCHENS INC.

70 Regina Road Woodbridge ON L4L 8L6
905-264-6464

INFORMATION - PVC DOORS

Builder Gold Park Homes Project..... Lot # 80.....

All cabinets with PVC (Thermofoil) Doors come with melamine gables, panels and kick. The doors, crown moulding and light valance are PVC wrapped. Open shelves incorporated in design will only be available with melamine interiors. There will be variations in colour shades between the PVC parts (doors, crown and Light valance) and the melamine parts (open shelves, Gables, Panels and Kick) due to the difference in material.

Furring Panel with crown moulding to the ceiling is not available on all PVC door styles due to subtle variations in colour shades between the PVC parts (moulding) and the melamine parts (furring panel) due to the difference in material. Grain directions in wood grain pattern melamine, vary between the furring panel, crown moulding (horizontal) and the PVC doors (vertical).

Thank you for your understanding.

I am well informed of this information, and agree to the purchase of the above.

Purchaser: (A.S) (PJ)
~~_____~~ Rehna

Date: Feb 9 2017