

April 7, 2017

CONSTRUCTION ADDITION

LOT 13- Kleinburg Glen

PROJECT- Kleinburg Glen

Install:

ELECTRICAL

Install Kitchen – 10 pot lights

Do not install standard ceiling light, but use standard switch for pot lights

Install Great Room – 6 pot lights

In lieu of purchased capped outlet with switch – Please advise if this can be turned that into a 6th pot light


Use switch for the pot lights

See attached floorplan

Thank you


DATE ISSUED: 4/7/17

ISSUED BY: Stacey Carlete

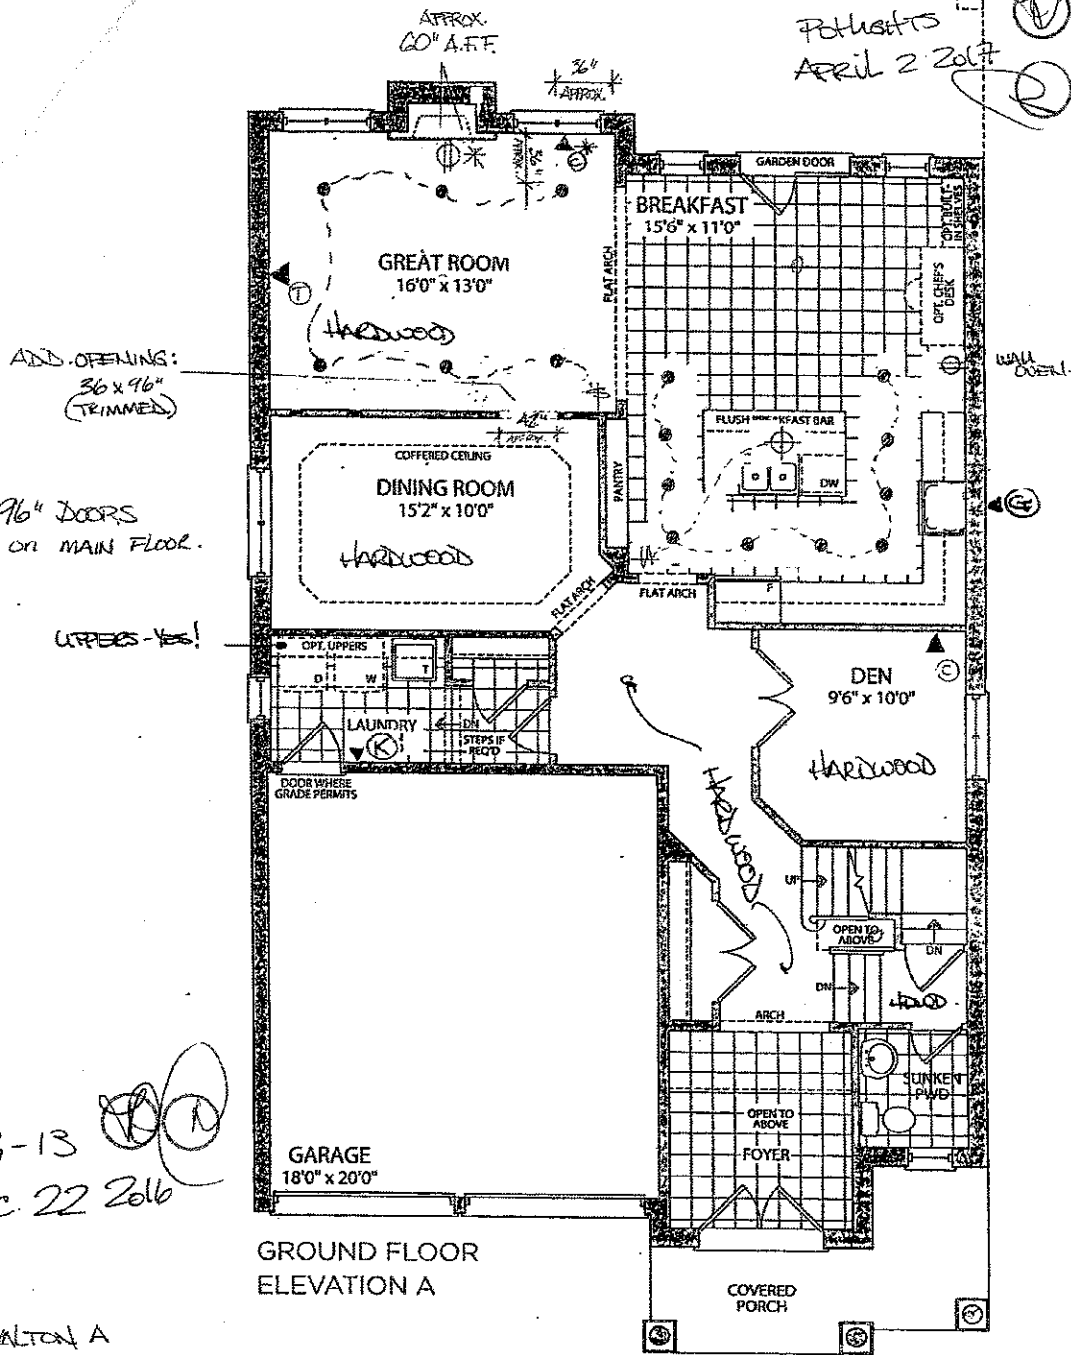

GROUND FLOOR
ELEVATION A

ROYALTON A
LOT 13
JUNE 28 2016

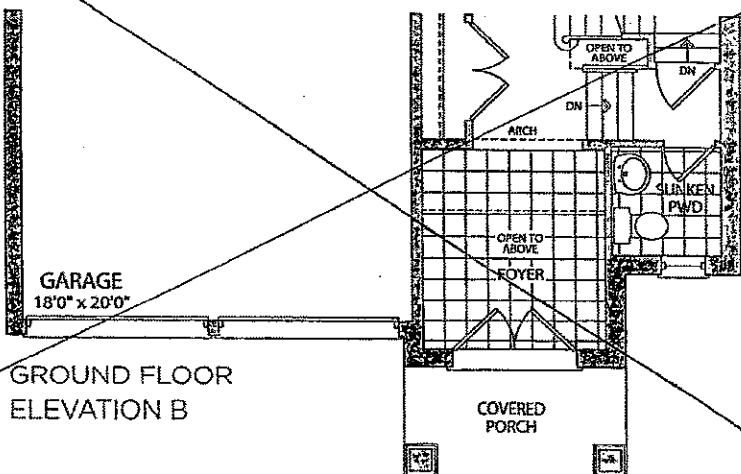

GROUND FLOOR
ELEVATION B