

**Kleinburg Glen - 83R - 1 - 25-2 Elev.B HUDSON
CENTRAL VAC AND WIRING**

Inv. 784	1 - FAMILY ROOM: CONDUIT PIPE - FOR TELEVISION - Locate approx. 66" A.F.F. above fireplace, terminating right of fireplace by cable. See plan for location.
Line11125	Note:
25Aug16 / 14Nov16	
Inv. 784	1 - FAMILY ROOM: ROUGH - IN FIBER OPTIC CABLE - HOME RUN TO ELECTRICAL PANEL - Locate right of fireplace. See plan for location.
Line11126	Note:
25Aug16 / 14Nov16	

CERAMIC

Inv.1,141	1 - FOYER / POWDER ROOM FLOOR TILE: Upgrade 5 - Timeless 24x24" polished - laid in striaght, stacked pattern.
Line16868	Note:
30Jan17 / 10Apr17	
Inv.1,141	1 - MASTER ENSUITE FLOOR TILE: Upgrade 4 - 12x24" polished - laid in straight, stacked pattern. - See plan for tile direction
Line16869	Note:
30Jan17 / 10Apr17	
Inv.1,141	1 - MASTER ENSUITE WALL TILE - SHOWER WALL + TUB SKIRT/DECK/SPLASH: Upgrade 1 - 2x8" CDC bright. Lay in horizontal stacked pattern, see sketch for tile direction at tub.
Line16870	Note:
30Jan17 / 10Apr17	
Inv.1,141	1 - LAUNDRY ROOM FLOOR TILE: Upgrade 4 - 12x24" polished - laid in straight, stacked pattern. - See plan for tile direction
Line16873	Note:
30Jan17 / 10Apr17	
Inv.1,298	1 - MASTER ENSUITE: *DELETE* ITEM 9 FROM ORDER PE-1.141 (FLOOR TILE) - LAYOUT HAS BEEN REVISED
Line20347	Note:
4Apr17 / 10Apr17	
Inv.1,298	1 - MASTER ENSUITE: *DELETE* ITEM 10 FROM ORDER PE.1.141 (WALL TILE) - LAYOUT HAS BEEN REVISED
Line20348	Note:
4Apr17 / 10Apr17	
Inv.1,298	1 - MASTER ENSUITE: *REVISE LAYOUT* MOVE TOILET TO BY WINDOW AND INCREASE SHOWER TO FULL WIDTH OF BATHROOM - SEE PLAN FOR LOCATION.
Line20349	Note:
4Apr17 / 10Apr17	
Inv.1,298	1 - MASTER ENSUITE: UPGRADE 4 FLOOR TILE - 12X24" LAID IN STRAIGHT, STACKED PATTERN. SEE PLAN FOR TILE DIRECTION.
Line20350	Note:
4Apr17 / 10Apr17	
Inv.1,298	1 - MASTER ENSUITE: UPGRADE 1 WALL TILE - 2X8" LAID IN HORIZONTAL, STACKED PATTERN.
Line20351	Note:
4Apr17 / 10Apr17	

ELECTRICAL

Inv.784	1 - FAMILY ROOM: 110V WALL RECEPTACLE ON NORMAL CIRCUIT Locate approx. 66" A.F.F. above fireplace.
Line11127	Note:
25Aug16 / 14Nov16	
Inv.784	1 - KITCHEN: 110V WALL RECEPTACLE ON DEDICATED CIRCUIT - GAS FIRED APPLIANCE - FOR AUX. EQUIPMENT - NOT A STOVE PLUG
Line11129	Note:
25Aug16 / 14Nov16	

EXTERIOR COLOURS

Inv.784	1 - EXTERIOR COLOUR PACKAGE 9
Line13877	Note:
25Aug16 / 14Nov16	

FRAMING

Inv.784	3 - MAIN FLOOR: FRAME MAIN FLOOR ARCHES AT 96 INCH. See plan for location.
Line11130	Note:
25Aug16 / 14Nov16	
Inv.1,298	1 - ATTENTION**MASTER ENSUITE: *REVISE LAYOUT* MOVE TOILET TO BY WINDOW AND INCREASE SHOWER TO FULL WIDTH OF BATHROOM - SEE PLAN FOR LOCATION.
Line20822	Note: *NEW
4Apr17 / 10Apr17	

HARDWOOD

Inv.1,141	1 - LIVING / DINING / FAMILY ROOM HARDWOOD: Upgrade 5 - Vintage 5" White Oak Hand Scraped
Line16866	Note:
30Jan17 / 10Apr17	
Inv.1,141	1 - KITCHEN HARDWOOD: Upgrade 5 - Vintage 5" White Oak Hand Scraped
Line16867	Note:
30Jan17 / 10Apr17	
Inv.1,261	1 - UPPER HALL: Upgrade 5 hardwood floor - VINTAGE 3/4 x 5" White Oak Hand Scraped 'Gotham'
Line19449	Note:
21Mar17 / 10Apr17	

HVAC

Inv.784	1 - KITCHEN: GAS LINE ROUGH - GROUND FLOOR
Line11128	Note:
25Aug16 / 14Nov16	

INTERIOR TRIM AND DOORS

Inv.784	3 - MAIN FLOOR: EXTENDED HEIGHT ARCHWAY (PRICE PER DOORWAY) - 96"
Line11131	Note:
25Aug16 / 14Nov16	

KITCHEN AND BATH CABINETRY

Inv.1,141	1 - KITCHEN CABINETRY: Upgrade 3 profile (pvc lacquer)
Line16858	Note:
30Jan17 / 10Apr17	

Inv.1,141	1 - KITCHEN CABINETRY: Cabinetry Slide-in stove prep
Line16859	Note:
30Jan17 / 10Apr17	
Inv.1,141	1 - KITCHEN CABINETRY: Delete uppers above range, finish sides of cabinets. Leave approx. 36" between uppers for future 30" chimney-style hood fan.
Line16861	Note:
30Jan17 / 10Apr17	
Inv.1,141	1 - KITCHEN CABINETRY: Raise cabinets 3/4 for hardwood flooring in kitchen
Line16864	Note:
30Jan17 / 10Apr17	
Inv.1,141	1 - KITCHEN CABINETRY: Do *NOT* install hardware, do not drill holes.
Line16865	Note: *kitchen only*
30Jan17 / 10Apr17	
Inv.1,298	1 - MASTER ENSUITE: *REVISE LAYOUT* MOVE TOILET TO BY WINDOW AND INCREASE SHOWER TO FULL WIDTH OF BATHROOM - SEE PLAN FOR LOCATION. REQUIRES ADDED GABLE
Line20825	Note: *NEW
4Apr17 / 10Apr17	

MISC.

Inv.784	1 - Purchaser has attended a Structural appointment at the Decor Centre & has DECLINED any additional upgrades and accepts and acknowledges that there will be no further structural changes/additions/deletions to be made upon signing on September 8, 2016.
Line11132	Note:
25Aug16 / 14Nov16	
Inv.784	1 - Purchasers are aware & accepts that ANY changes made to upgrades after signing this Purchasers Extra Form are subject to a minimum administration fee of \$500. PLUS a 10% holdback fee.
Line11133	Note:
25Aug16 / 14Nov16	
Inv.784	1 - BONUS PACKAGE: \$5,000.00 (INCLUDING TAXES) WORTH OF UPGRADES FROM GOLD PARK HOMES DÉCOR CENTRE IS BEING APPLIED TOWARD THE STRUCTURAL APPOINTMENT. PURCHASER HAS A REMAINING AMOUNT OF \$2451.85 (INCLUDING TAXES) TO BE USED TOWARD THE COLOUR APPOINTMENT.
Line11134	Note:
25Aug16 / 14Nov16	
Inv.1,141	1 - Purchaser has attended a Colour appointment at the Decor Centre & has DECLINED any additional upgrades and accepts and acknowledges that there will be no further changes/additions/deletions to be made upon signing on January 30 2017.
Line16874	Note:
30Jan17 / 10Apr17	
Inv.1,141	1 - Purchasers are aware & accepts that ANY changes made to upgrades after signing this Purchasers Extra Form are subject to a minimum administration fee of \$500. PLUS a 10% holdback fee.
Line16875	Note:
30Jan17 / 10Apr17	
Inv.1,141	1 - STAIRCASE - The purchaser was advised and therefore accepts and acknowledges that the wood species of the staircase and flooring chosen do not match. This difference may result in a stain colour variance.
Line16876	Note: The purchaser agrees that the vendor is to be exempt from any and all claims by the purchaser regarding this colour variance.
30Jan17 / 10Apr17	

Kleinburg Glen - 83R - 1 - 25-2 Elev.B HUDSON

Inv.1,141	1 - KITCHEN - Purchasers request to NOT INSTALL builder's standard hood fan and standard cabinets above stove. DELETE. Do not supply, install, and/or credit. Purchasers are installing their own hood fan after closing.
Line16877	Note: Purchasers accept and acknowledge that the exhaust fan duct hole may be off-centered with stove in kitchen due to purchasers installing their own hood fan after closing. The vendor is exempt.
30Jan17 / 10Apr17	

PAINTING

Inv.1,141	1 - MAIN STAIRS: Stain stairs 'Vintage Pewter'
Line16872	Note: Stairs will not match hardwood floors in colour/texture/species.
30Jan17 / 10Apr17	

PLUMBING

Inv.1,298	1 - MASTER ENSUITE: *REVISE LAYOUT* MOVE TOILET TO BY WINDOW AND INCREASE SHOWER TO FULL WIDTH OF BATHROOM - SEE PLAN FOR LOCATION.
Line20823	Note: *NEW
4Apr17 / 10Apr17	
Inv.1,298	1 - ATTENTION: STRUCTURAL CHANGE: DELETE TUB
Line20824	Note: *NEW
4Apr17 / 10Apr17	

STAIRS AND RAILINGS

Inv.1,141	1 - MAIN STAIRS: Euroline 1 + V Groove
Line16871	Note:
30Jan17 / 10Apr17	

Purchasers: Olga Ferro & Fausto Ferro

Property: 83R

Telephone Res. / Bus: (416) 788-8900

Project: Burkshire Holdings Inc.

Decor Advisor: Yolande Somerville

Model and Elevation: 25-2 Elev.B HUDSON

Layout Changes: ☒ Yes ☐ No Sketch Attached: ☒ Yes ☐ No Exterior Colour Scheme:

1. Cabinetry

	Style and Colour	Counter	Hardware
Kitchen / Breakfast	*aston pvclacq 'wht matt'	Granite: Grigio Sardo Edge: FE-20	*NONE
Laundry Room	n/a	n/a	n/a
Powder Room	n/a	n/a	n/a
n/a	n/a	n/a	n/a
Master Ensuite Bathroom	varese pvc 'crystal white'	P-Lam # P-344-LM 'Inukshuk Grey'	cs1-23
Second Ensuite Bathroom (If Applicable)	n/a	n/a	n/a
Main Bathroom	P-400 pvc 'mystic'	P-Lam #4925K-07 'Calcutta Marble'	cs1-23
Dishwasher Cabinet	n/a		
Comment			

2. Floor Tile

	Selection	Grout	Threshold
Entrance Vestibule	*24x24" Himalaya polished 'Grey'	n/a	n/a
Main Hall	n/a	n/a	n/a
Kitchen / Breakfast	n/a	n/a	n/a
Laundry Room	*12x24" Carrara X pol. 'White/Grey'	n/a	n/a
Powder Room	*24x24" Himalaya polished 'Grey'	n/a	n/a
Main Bathroom	*12x24" Carrara X pol. 'White/Grey'	n/a	n/a
Master Ensuite Bathroom	*12x24" Timeless pol. 'Dark Grey'	n/a	n/a
Second Ensuite Bathroom (If Applicable)	n/a	n/a	n/a
Lower Landing (If Applicable)	n/a	n/a	n/a
n/a	n/a	n/a	n/a
Comment			

Grout lines as small as possible, please!

3. Wall Tile

	Selection	Listello/Inserts	Describe
M. Ens Tub skirt/splash	*2x8" CDC 'Taupe' Bright	☐ Yes ☒ No	
Master Ensuite Bathroom			
Tub Deck	*2x8" CDC 'Taupe' Bright	☐ Yes ☒ No	
Shower Stall	*2x8" CDC 'Taupe' Bright	☐ Yes ☒ No	
Bathroom Walls	n/a	☐ Yes ☒ No	
Second Ensuite Bathroom (If Applicable)	n/a	☐ Yes ☒ No	
Main Bathroom	8x10" Weave 'White'	☐ Yes ☒ No	
Kitchen Backsplash	☐ Yes ☒ No	Backsplash Behind Fridge	none
Comment			

*** NOTE: This is not an approved document. Document must be locked ***

Scheduled Closing Date: Monday, February 13, 2017

Agents: Olga Ferro & Fausto Ferro

Property: 83R

Phone Res. / Bus: (416) 788-8900

Project: Burkshire Holdings Inc.

For Advisor: Yolande Somerville

Model and Elevation: 25-2 Elev.B HUDSON

4. Plumbing Fixtures

Master Ensuite Bathroom	☐	Second Ensuite	☐	Powder Room	☐
Other Room - Specify	☐	Other Room - Specify	☐	Other Washroom	☐

Comment

Standard Plumbing thru out

5. Hardwood Flooring

	Type and Stain	Upper Landing	Type and Stain
Main Hall	n/a	Upper Hall	n/a
Kitchen / Breakfast	Vintage 5" Hand Scraped 'Gotham'	Upper Hall	n/a - VINTAGE 5" 'Gotham'
Living Room	Vintage 5" Hand Scraped 'Gotham'	Master Bedroom	n/a HAND SCRAPED
Dining Room	Vintage 5" Hand Scraped 'Gotham'	Bedroom #2	n/a
Family Room	Vintage 5" Hand Scraped 'Gotham'	Bedroom #3	n/a
Den/Library	n/a	Bedroom #4	n/a
Entrance Vestibule	n/a	Bedroom #5	n/a
Lower Landing (if Applicable)	n/a	Other Room - Specify	n/a

Comment

Hardwood Selection: Vintage: 3/4 x 5" White Oak Hand Scraped 'Gotham'

6. Carpeting

	Upgrade	Description
Main Hall	☐	n/a
Living Room	☐	n/a
Dining Room	☐	n/a
Family Room	☐	n/a
Den/Library	☐	n/a
Upper Hall	☐	T-04 N/A
Master Bedroom	☐	T-04
Bedroom #2	☐	T-04
Bedroom #3	☐	T-04
Bedroom #4	☐	n/a
Bedroom #5	☐	n/a
Upper Landing (if Applicable)	☐	n/a
Lower Landing (if Applicable)	☐	n/a

Upgrade Underpad	Type	Area
	n/a	n/a
Carpet on Stairs	Capped	Runner - Upgrade
	n/a	n/a

Comment

Standard Carpet + Standard Underpad on 2nd floor - RESEALANTS.

Purchasers: Olga Ferro & Fausto Ferro
Telephone Res. / Bus: (416) 788-8900
Decor Advisor: Yolande Somerville

Property: 83R
Project: Burkshire Holdings Inc.
Model and Elevation: 25-2 Elev.B HUDSON

7. Fireplace

	Living Room		Family Room		Other Room - Specify	
	Purchased	As Per Plan	N/A	Purchased	As Per Plan	N/A
Fireplace Type	☐	☐	☒	☐	☐	☒
Mantle Type	Standard Gas					
Colour / Stain	Standard Mediterranean					
Surround	Standard					
Hearth	None					
Comment	None					

8. Trim Carpentry

Interior Doors	Standard	Front Door Glass Inserts	Standard	Door Handles	Standard
Interior Trim	Standard				
Comment					

9. Plaster Mouldings and Medallions

		Kitchen/Breakfast	
Entrance Vestibule			
Main Hall		Den/Library	
Living Room		Lower Landing	
Dining Room		Other Room - Specify	none
Family Room		Thru Out	
Comment			

10. Railings and Spindles

Railing Package	*Euroline 1 + V Groove	Spindle Colour	*Black
Railing Colour	*Vintage 'Pewter'	Treads	*Vintage 'Pewter'
Stringer / Riser	*Vintage 'Pewter'	Oak Stairs	☒ Yes ☐ No
Comment			

11. Wall Paint

	Master Bedroom
Main & Upper Hall	
Living Room	Bedroom #2
Dining Room	Bedroom #3
Kitchen / Breakfast	Bedroom #4
Family Room	Bedroom #5
Powder Room	Master Ensuite
Laundry Room	
Den/Library	Second Ensuite
Trim Paint	Thru Out
Comment	Smooth Ceilings First Floor

--	--

*** NOTE: This is not an approved document. Document must be locked ***
Scheduled Closing Date: Monday, February 13, 2017

Purchasers: Olga Ferro & Fausto Ferro
Telephone Res. / Bus: (416) 788-8900
Decor Advisor: Yolande Somerville

Property: 83R
Project: Burkshire Holdings Inc.
Model and Elevation: 25-2 Elev.B HUDSON

12. Electrical

Plugs and Switches ☒ White ☐ Ivory

Hood Fan ☐ White ☐ Ivory

Appliances ☐ Yes ☒ No

Built in Cooktop ☐ Yes ☒ No

Built in Oven ☐ Yes ☒ No

Above Kitchen Cabinet Light ☐ Yes ☒ No

Below Kitchen Cabinet Light ☐ Yes ☒ No

Gas Stove ☒ Yes ☐ No

Microwave ☐ Yes ☒ No

Comment

*Chimney-style hood fan

13. Heating and Air Conditioning

Air Conditioning

Gas Provisions Stove

Gas Provisions Dryer

Gas Provisions Barbecue

Comment

Standard Gas BBQ Line

14. Additional Comments

15. Disclaimers and Notes

- 1) Colours of all materials are as close as possible to builder's selection, but not necessarily identical due to variances in manufacturing.
- 2) Any extras listed above are null and void unless accompanied by a separate invoice/amendment. Said invoice must be paid in full.
- 3) The Purchaser acknowledges that after Interior Colour Selection form is signed and dated, no further changes will be permitted other than re-selection due to unavailability. Purchaser's Initials
- 4) The Purchaser acknowledges reading and accepting the "Gold Park Homes Decor Centre Disclaimers" form. This document contains other miscellaneous disclaimers.


This Interior Colour Selection is final and approved by:

Signature:  Date: Signature:  Date:


Elevation A • 1,898 sq.ft.

Elevation B • 1,898 sq.ft.

No Phone
in
Kitchen

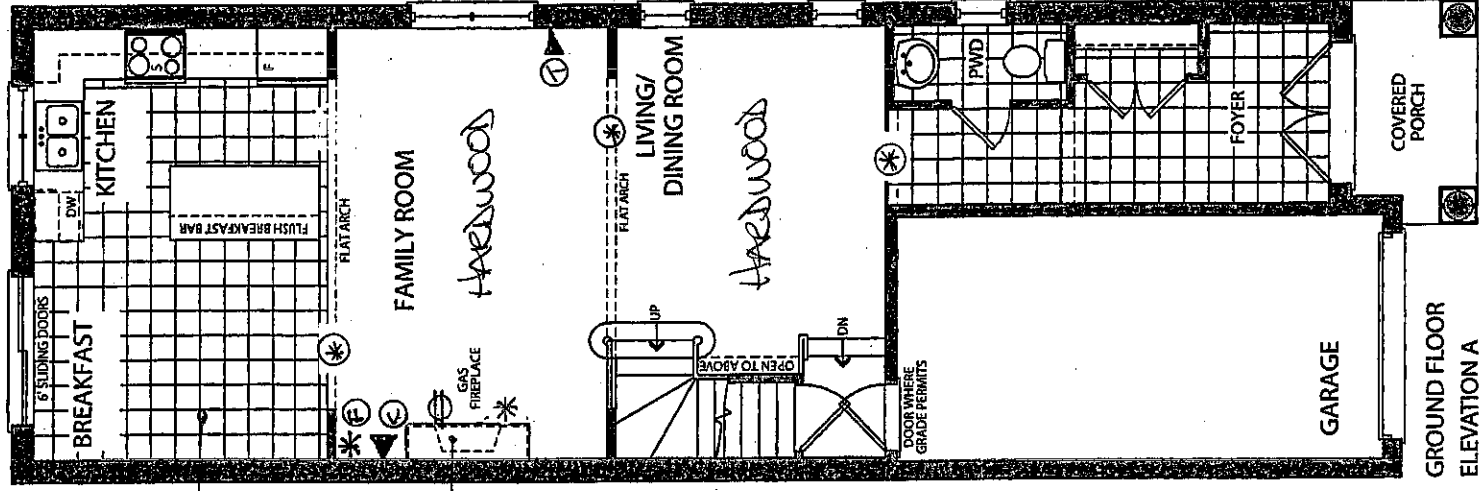

GROUND FLOOR
ELEVATION A

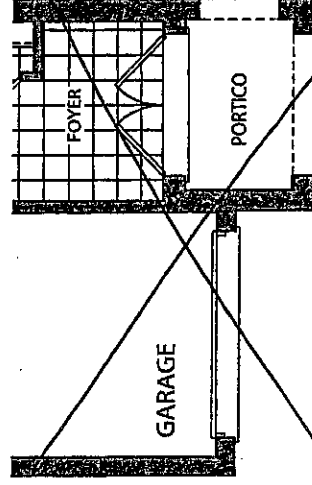

GROUND FLOOR
ELEVATION B

Hardwood
in
Kitchen

66" AFF

LEGEND

⊙ 96" Arch

⊕ ELECTRICAL OUTLET

▲ ⊕ CABLE

▲ ⊕ PHONE

▲ ⊕ FIBER OPTIC

* CONDUIT

[Handwritten signature]

KG-83R 2017
JAN. 30

SET 8 2016


LOT 83R





the Hudson

Elevation A • 1,898 sq.ft.
Elevation B • 1,898 sq.ft.


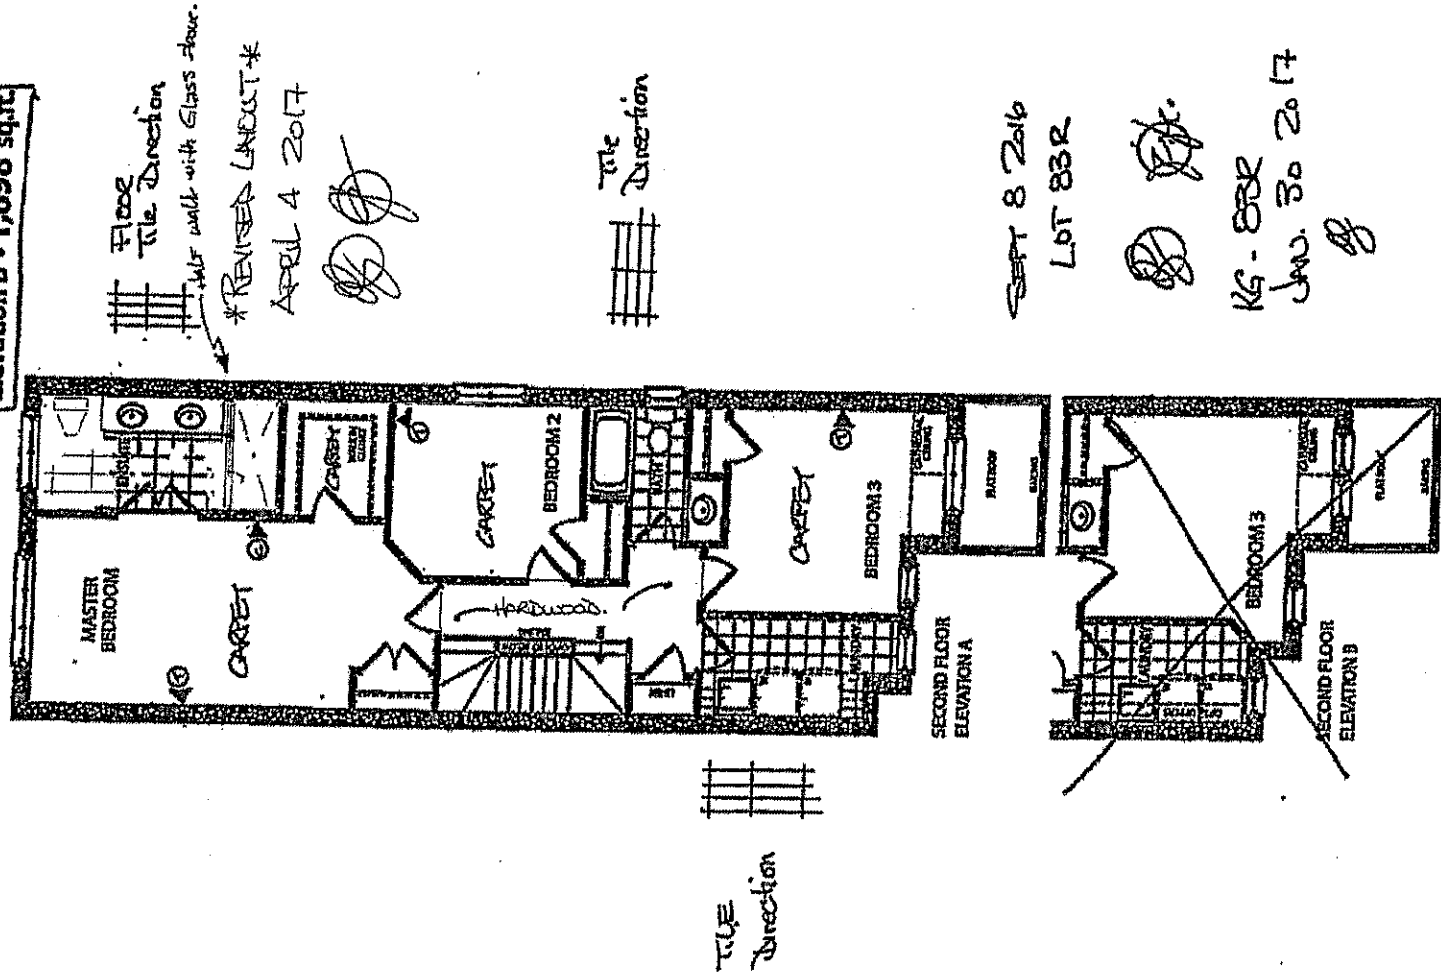


Notes: Elevation A, B, C, D, E, F, G, H, I, J, K, L, M, N, O, P, Q, R, S, T, U, V, W, X, Y, Z, AA, AB, AC, AD, AE, AF, AG, AH, AI, AJ, AK, AL, AM, AN, AO, AP, AQ, AR, AS, AT, AU, AV, AW, AX, AY, AZ, BA, BB, BC, BD, BE, BF, BG, BH, BI, BJ, BK, BL, BM, BN, BO, BP, BQ, BR, BS, BT, BU, BV, BW, BX, BY, BZ, CA, CB, CC, CD, CE, CF, CG, CH, CI, CJ, CK, CL, CM, CN, CO, CP, CQ, CR, CS, CT, CU, CV, CW, CX, CY, CZ, DA, DB, DC, DD, DE, DF, DG, DH, DI, DJ, DK, DL, DM, DN, DO, DP, DQ, DR, DS, DT, DU, DV, DW, DX, DY, DZ, EA, EB, EC, ED, EE, EF, EG, EH, EI, EJ, EK, EL, EM, EN, EO, EP, EQ, ER, ES, ET, EU, EV, EW, EX, EY, EZ, FA, FB, FC, FD, FE, FF, FG, FH, FI, FJ, FK, FL, FM, FN, FO, FP, FQ, FR, FS, FT, FU, FV, FW, FX, FY, FZ, GA, GB, GC, GD, GE, GF, GG, GH, GI, GJ, GK, GL, GM, GN, GO, GP, GQ, GR, GS, GT, GU, GV, GW, GX, GY, GZ, HA, HB, HC, HD, HE, HF, HG, HH, HI, HJ, HK, HL, HM, HN, HO, HP, HQ, HR, HS, HT, HU, HV, HW, HX, HY, HZ, IA, IB, IC, ID, IE, IF, IG, IH, II, IJ, IK, IL, IM, IN, IO, IP, IQ, IR, IS, IT, IU, IV, IW, IX, IY, IZ, JA, JB, JC, JD, JE, JF, JG, JH, JI, JJ, JK, JL, JM, JN, JO, JP, JQ, JR, JS, JT, JU, JV, JW, JX, JY, JZ, KA, KB, KC, KD, KE, KF, KG, KH, KI, KJ, KK, KL, KM, KN, KO, KP, KQ, KR, KS, KT, KU, KV, KW, KX, KY, KZ, LA, LB, LC, LD, LE, LF, LG, LH, LI, LJ, LK, LL, LM, LN, LO, LP, LQ, LR, LS, LT, LU, LV, LW, LX, LY, LZ, MA, MB, MC, MD, ME, MF, MG, MH, MI, MJ, MK, ML, MM, MN, MO, MP, MQ, MR, MS, MT, MU, MV, MW, MX, MY, MZ, NA, NB, NC, ND, NE, NF, NG, NH, NI, NJ, NK, NL, NM, NN, NO, NP, NQ, NR, NS, NT, NU, NV, NW, NX, NY, NZ, OA, OB, OC, OD, OE, OF, OG, OH, OI, OJ, OK, OL, OM, ON, OO, OP, OQ, OR, OS, OT, OU, OV, OW, OX, OY, OZ, PA, PB, PC, PD, PE, PF, PG, PH, PI, PJ, PK, PL, PM, PN, PO, PP, PQ, PR, PS, PT, PU, PV, PW, PX, PY, PZ, QA, QB, QC, QD, QE, QF, QG, QH, QI, QJ, QK, QL, QM, QN, QO, QP, QQ, QR, QS, QT, QU, QV, QW, QX, QY, QZ, RA, RB, RC, RD, RE, RF, RG, RH, RI, RJ, RK, RL, RM, RN, RO, RP, RQ, RR, RS, RT, RU, RV, RW, RX, RY, RZ, SA, SB, SC, SD, SE, SF, SG, SH, SI, SJ, SK, SL, SM, SN, SO, SP, SQ, SR, SS, ST, SU, SV, SW, SX, SY, SZ, TA, TB, TC, TD, TE, TF, TG, TH, TI, TJ, TK, TL, TM, TN, TO, TP, TQ, TR, TS, TT, TU, TV, TW, TX, TY, TZ, UA, UB, UC, UD, UE, UF, UG, UH, UI, UJ, UK, UL, UM, UN, UO, UP, UQ, UR, US, UT, UY, UZ, VA, VB, VC, VD, VE, VF, VG, VH, VI, VJ, VK, VL, VM, VN, VO, VP, VQ, VR, VS, VT, VU, VV, VW, VX, VY, VZ, WA, WB, WC, WD, WE, WF, WG, WH, WI, WJ, WK, WL, WM, WN, WO, WP, WQ, WR, WS, WT, WU, WV, WW, WX, WY, WZ, XA, XB, XC, XD, XE, XF, XG, XH, XI, XJ, XK, XL, XM, XN, XO, XP, XQ, XR, XS, XT, XU, XV, XW, XX, XY, XZ, YA, YB, YC, YD, YE, YF, YG, YH, YI, YJ, YK, YL, YM, YN, YO, YP, YQ, YR, YS, YT, YU, YV, YW, YX, YY, YZ, ZA, ZB, ZC, ZD, ZE, ZF, ZG, ZH, ZI, ZJ, ZK, ZL, ZM, ZN, ZO, ZP, ZQ, ZR, ZS, ZT, ZU, ZV, ZW, ZX, ZY, ZZ.

GOLDPARK HOMES

Elevation A • 1,898 sq.ft.

Elevation B • 1,898 sq.ft.

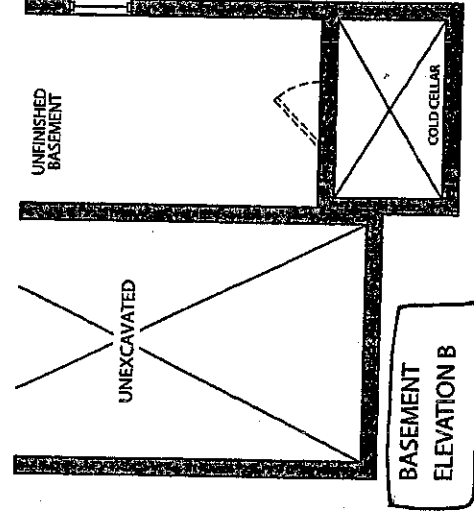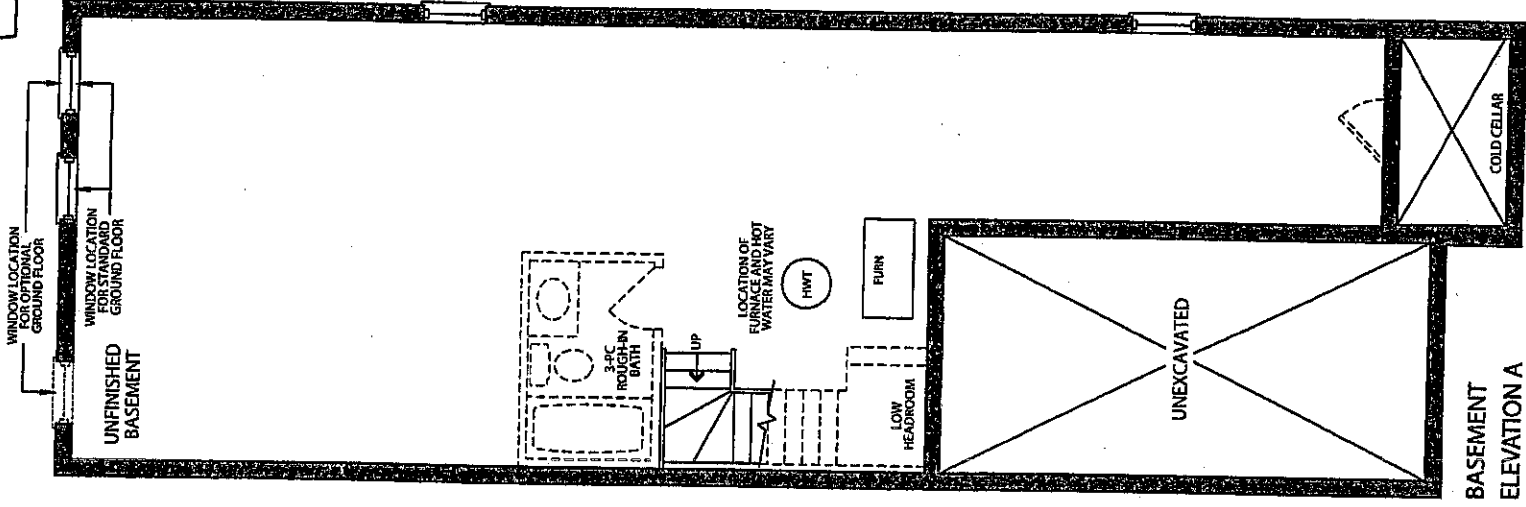

SEPT 8 2016

LOT 83R



KG-83R

JAN 30 2017

[Handwritten signature]

Trade Name: Gold Park Homes





Model: 25-2

Address:

Project: Kleinburg Glen

Phase:

This layout has been explained to the purchaser by Cortina Kitchens Inc. and is understood by the purchaser.

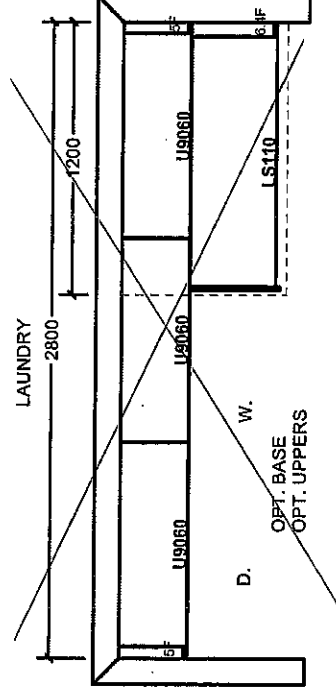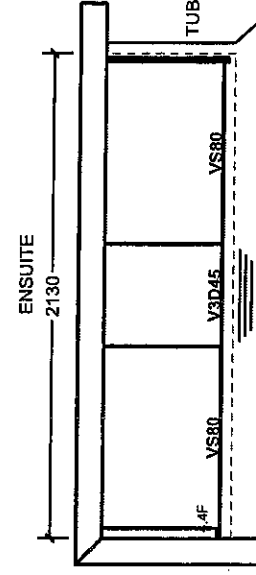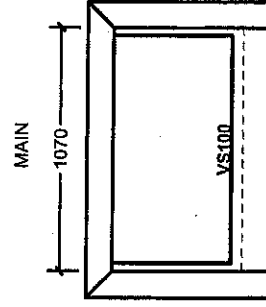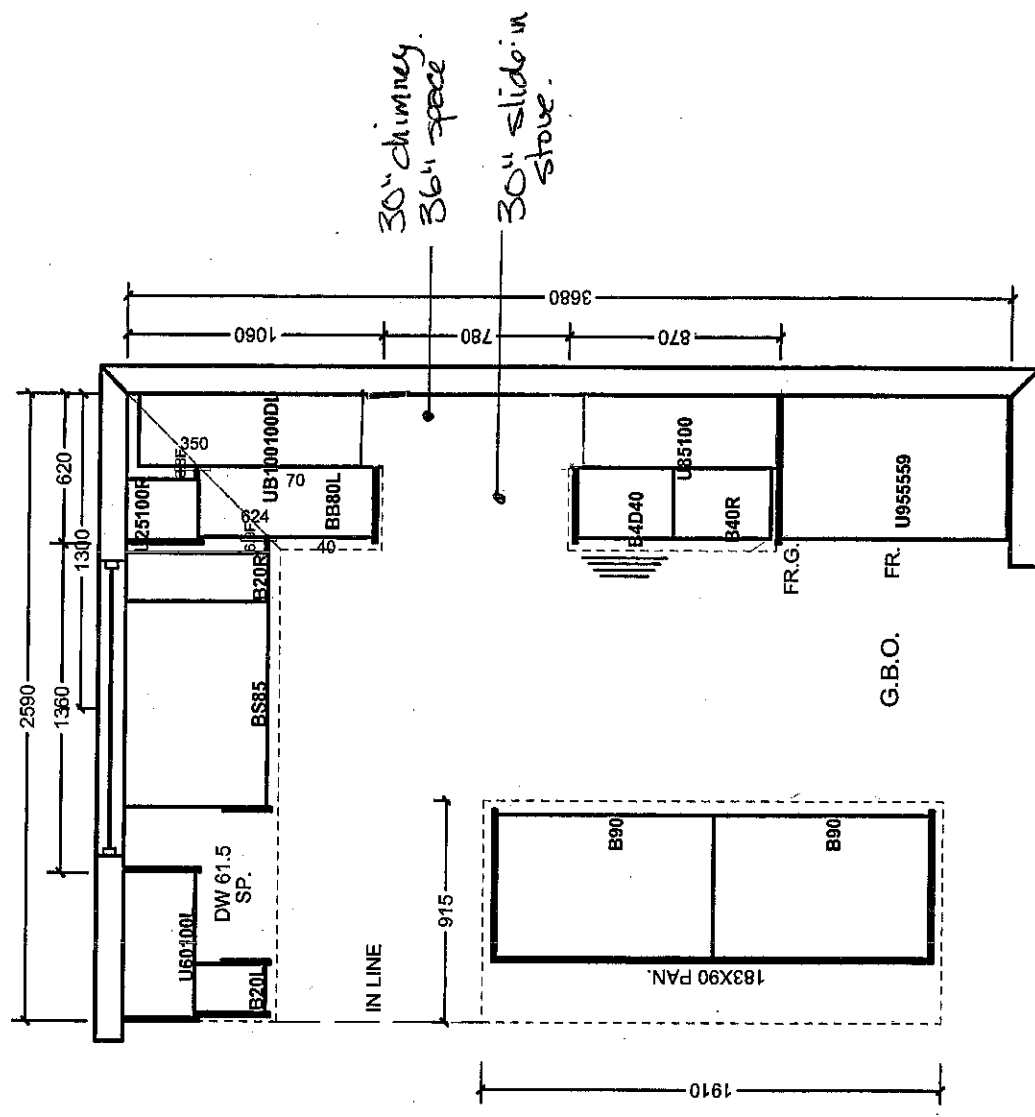

**All prices subject to confirmation from head office.
This quotation is subject to the terms & conditions set out**

ACCEPTED DATE:

All agreements are contingent upon strikes, accidents, and delays beyond our control. Please provide our installer with template for sinkholes or \$150.00 will be charged for callback.

item A. Wood grain and colour are characteristics of the product. We cannot guarantee that such grain and colour will always match.
item B. Corina Kitchens Inc. reserves the right to alter dimensions and make technical changes without notice.

Granite, Marble, Engineered Surfaces


-  Standard 2CM & 3CM
-  Upgrade 1 2CM & 3CM
-  Upgrade 1 4 CM
-  Upgrade 2

20mm (3/4") Profiles




30mm (1-1/4") Profiles

KITCHEN

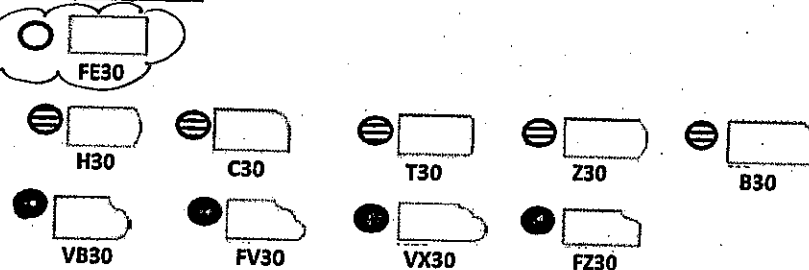

40mm (1-1/2") Profiles

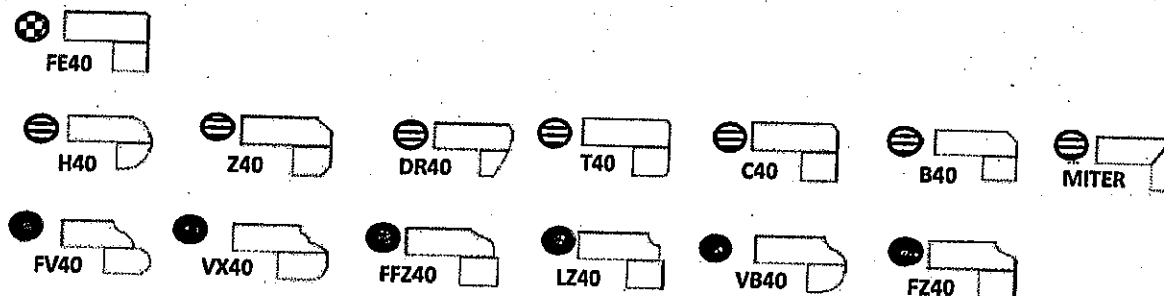


Note: All colours may not be available in 30mm at time ordered. Vendor reserves the right to use 40 mm edges (by lamination process).

*Mitre edge is available in Upgrade 1 for an overall thickness of 2". All other Mitre edge options will be an Upgrade 2 Edge.

*STD SINK & FAUCET

KG-83R

JAN 30 2017

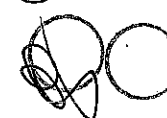


CORTINA

STANDARD HARDWARE


RG-83R
JAN 30 2017

MODIFIED: 19/03/16


STANDARD HARDWARE

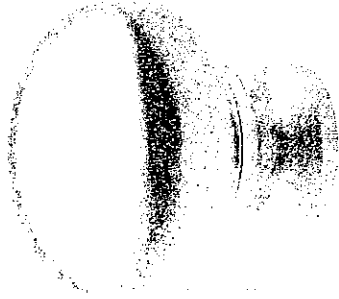


CSI-6

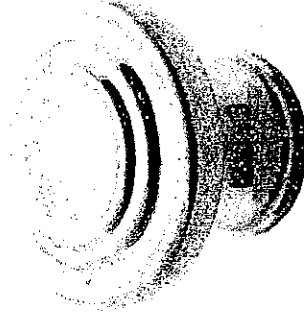


CSI-10

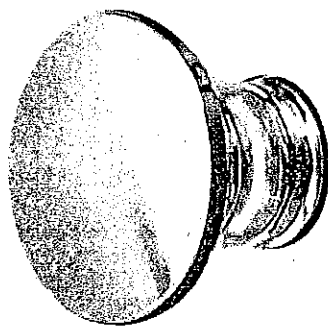


CSI-14

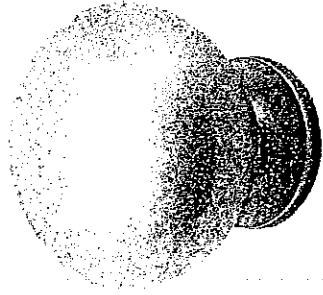


CSI-16

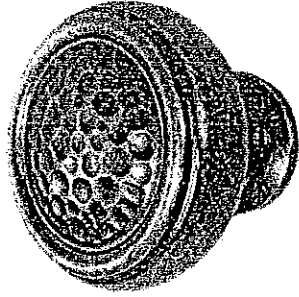


CSI-18

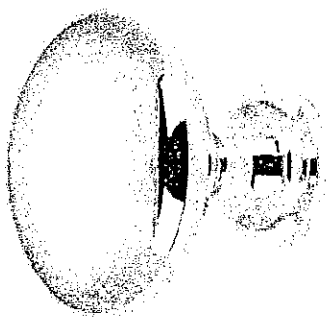


CSI-19

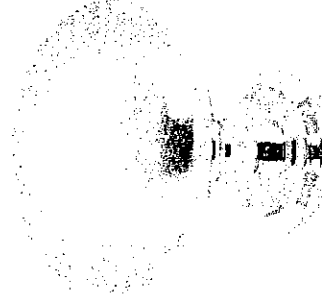

CSI-20

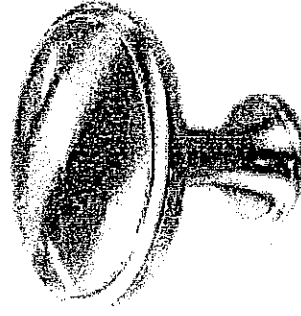


CSI-21

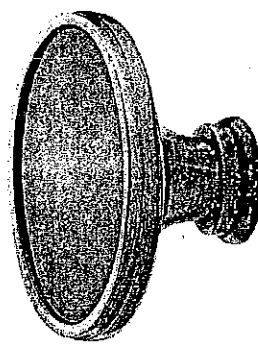


CSI-22


MASTER ENSUITE
+
MAIN

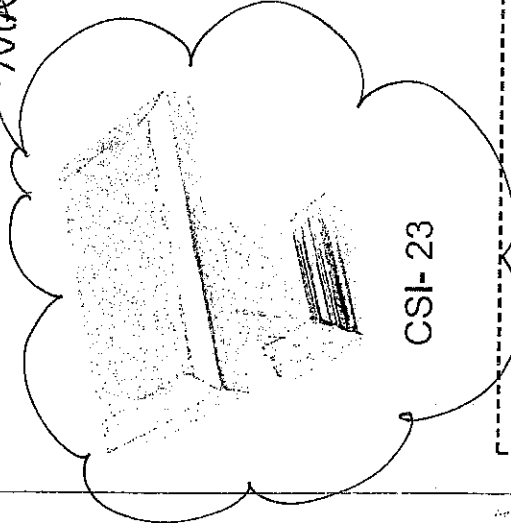

CSI-23

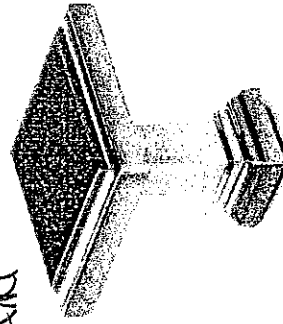

CSI-24

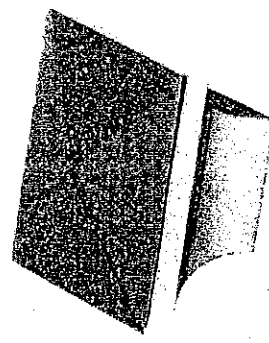

CSI-25

*NOTES:

- IMAGES ARE FOR QUICK REFERENCE PURPOSES ONLY
- ACTUAL SIZES AND FINISHES AS PER HARDWARE
- SAMPLE BOARD PROVIDED TO DECOR CENTRE

CORTINA KITCHENS INC.

70 Regina Road Woodbridge ON L4L 8L6
905-264-6464

INFORMATION - PVC DOORS

Builder: Gold Park Homes Project Lot # 83R

All cabinets with PVC (Thermofoil) Doors come with melamine gables, panels and kick. The doors, crown moulding and light valance are PVC wrapped. Open shelves incorporated in design will only be available with melamine interiors. There will be variations in colour shades between the PVC parts (doors, crown and Light valance) and the melamine parts (open shelves, Gables , Panels and Kick) due to the difference in material.

Furring Panel with crown moulding to the ceiling is not available on all PVC door styles due to subtle variations in colour shades between the PVC parts (moulding) and the melamine parts (furring panel) due to the difference in material. Grain directions in wood grain pattern melamine , vary between the furring panel, crown moulding (horizontal) and the PVC doors (vertical).

Thank you for your understanding.

I am well informed of this information, and agree to the purchase of the above.

Purchaser:  Date: JAN 30 2017