



## **CONSTRUCTION ADDITION**

## **LOT 20R- Kleinburg Glen**

PROJECT- Kleinburg Glen
ELECTRICAL
INSERT:
4 NEW INSULATED POTLIGHTS ON SECOND FLOOR- 2 IN HALLWAY 2 IN MASTER ENSUITE
See attached floorplan
Thank you
DATE ISSUED: 4/11/17
ISSUED BY: Stacey Carlete
•




## the Riverstone

Elevation A • 1,849 sq.ft.

LOT 20R @ C July 7 2016

KG-20R (2) Nov. 24 2016

KG. - ZOR MARCH 302017

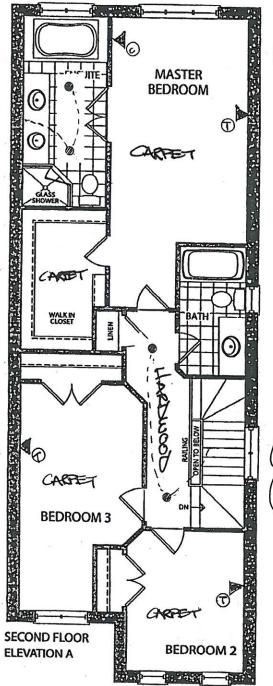

on some switch os

HALL POTLIGHTS (x2) ~ on some switch as STD LIGHT ABOUT STAIRS

