

Brampton Encore - 82 - 2 - 41-6 Elev.A VERDI
CENTRAL VAC AND WIRING

Inv.1,322	1 - TELEPHONE AND CABLE ROUGH-IN LOCATION SKETCH
Line20945	Note:
12Apr17 / 29May17	
Inv.1,322	1 - KITCHEN: INSTALL VAC PAN UNDER KITCHEN SINK
Line20946	Note:
12Apr17 / 29May17	
Inv.1,322	1 - GROUND FLOOR: INSTALL ROUGH-IN FOR EXTRA SECURITY KEY PAD AT MANDOOR
Line20947	Note:
12Apr17 / 29May17	
Inv.1,322	1 - MASTER BEDROOM: INSTALL ROUGH-IN FOR EXTRA SECURITY KEY PAD. TO GO BESIDE LIGHT SWITCH
Line20948	Note:
12Apr17 / 29May17	
Inv.1,322	1 - FAMILY ROOM: INSTALL CONDUIT PIPE- FOR TELEVISION- MUST SPECIFY LOCATION AND TERMINATION POINT
Line20949	Note:
12Apr17 / 29May17	

CERAMIC

Inv.1,322	1 - MASTER ENSUITE: INSTALL SHOWER STALL SHAMPOO SHELF 12 X 30" H
Line21830	Note:
12Apr17 / 29May17	

DRYWALL

Inv.1,322	1 - DINING ROOM: DELETE HALF WALL IN DINING ROOM AND INSTALL RAILING AND NOSING. PRICE IS FOR A STANDARD RAILING.
Line20965	Note:
12Apr17 / 29May17	
Inv.1,322	1 - MASTER ENSUITE: INSTALL SHOWER STALL SHAMPOO SHELF 12 X 30" H
Line21829	Note:
12Apr17 / 29May17	

ELECTRICAL

Inv.1,322	1 - FAMILY ROOM: INSTALL 110V WALL RECEPTACLE ON DEDICATED CIRCUIT - FOR TV ABOVE FIREPLACE
Line20950	Note:
12Apr17 / 29May17	
Inv.1,322	1 - BASEMENT: INSTALL 200 AMP ELECTRICAL SERVICE
Line20951	Note:
12Apr17 / 29May17	
Inv.1,322	1 - KITCHEN: INSTALL ADDITIONAL CEILING FIXTURE ROUGH-IN WITH SWITCH - ABOVE KITCHEN ISLAND.
Line20953	Note: IN ADDITION TO THE STANDARD KITCHEN LIGHT
12Apr17 / 29May17	
Inv.1,322	2 - KITCHEN: INSTALL TWO (X2) ADDITIONAL CEILING ROUGH-INS ON SAME SWITCH AS THE NEW ROUGH-IN ABOVE KITCHEN ISLAND
Line20954	Note: IN ADDITION TO THE STANDARD LIGHT
12Apr17 / 29May17	

Brampton Encore - 82 - 2 - 41-6 Elev.A VERDI

Inv.1,322	1 - LIVING ROOM: INSTALL CEILING ROUGH-IN ON SAME SWITCH AS SWITCH CONTROLLED RECEPICAL
Line20955	Note:
12Apr17 / 29May17	
Inv.1,322	1 - KITCHEN: INSTALL 240V WALL RECEPICAL ON DEDICATED CIRCUIT- FOR 4 WIRE BUILT-IN WALL OVEN / MICROWAVE UNIT
Line20957	Note:
12Apr17 / 29May17	

Exterior Colours

Inv.1,322	1 - EXTERIOR COLOUR PACKAGE 3
Line21835	Note:
12Apr17 / 29May17	

FORMING

Inv.1,322	1 - BASEMENT: INSTALL COLD CELLAR
Line20958	Note:
12Apr17 / 29May17	

FRAMING

Inv.1,322	1 - MANDOOR- AVAILABLE IF GRADE PERMITS
Line20959	Note:
12Apr17 / 29May17	
Inv.1,322	1 - MASTER ENSUITE: INSTALL SHOWER STALL SHAMPOO SHELF 12 X 30" H
Line20960	Note:
12Apr17 / 29May17	
Inv.1,322	1 - KITCHEN: INSTALL UPGRADE VENTING FOR STOVE TO 8" PIPE INTERIOR WALL
Line21825	Note:
12Apr17 / 29May17	
Inv.1,322	1 - DEN: INSTALL ONE (X1) STANDARD FRENCH DOOR EXTENDED HEIGHT 96" (PRICE PER DOOR) MAIN FLOOR 3 STOREY MODELS
Line21831	Note:
12Apr17 / 29May17	
Inv.1,322	1 - MAIN FLOOR: INSTALL FOUR (X4) STANDARD DOOR EXTENDED HEIGHT 96" (PRICE PER DOOR) MAIN FLOOR 3 STOREY MODELS
Line21832	Note:
12Apr17 / 29May17	
Inv.1,322	1 - DINING ROOM: DELETE HALF WALL IN DINING ROOM AND INSTALL RAILING AND NOSING. PRICE IS FOR A STANDARD RAILING.
Line21833	Note:
12Apr17 / 29May17	

HVAC

Inv.1,322	1 - EXTERIOR: MOVE GAS LINE FOR BBQ TO THE DECK OFF THE KITCHEN DECK.
Line20952	Note:
12Apr17 / 29May17	
Inv.1,322	1 - KITCHEN: INSTALL UPGRADE VENTING FOR STOVE TO 8" PIPE INTERIOR WALL
Line20956	Note:
12Apr17 / 29May17	

Brampton Encore - 82 - 2 - 41-6 Elev.A VERDI

Inv.1,322	1 - KITCHEN: INSTALL GAS LINE ROUGH - MAIN FLOOR - (3 STOREY MODELS) INCLUDES 110V RECEPTICAL FOR STOVE
Line20961	Note:
12Apr17 / 29May17	

INTERIOR TRIM AND DOORS

Inv.1,322	1 - DEN: INSTALL ONE (X1) STANDARD FRENCH DOOR EXTENDED HEIGHT 96" (PRICE PER DOOR) MAIN FLOOR 3 STOREY MODELS
Line20962	Note:
12Apr17 / 29May17	

Inv.1,322	4 - MAIN FLOOR: INSTALL FOUR (X4) STANDARD DOOR EXTENDED HEIGHT 96" (PRICE PER DOOR) MAIN FLOOR 3 STOREY MODELS
Line20963	Note:
12Apr17 / 29May17	

Inv.1,322	1 - BASEMENT: INSTALL COLD CELLAR
Line21827	Note:
12Apr17 / 29May17	

MISC.

Inv.1,322	1 - BONUS PACKAGE: \$10,000.00 (INCLUDING TAXES) WORTH OF UPGRADES FROM GOLD PARK HOMES DÉCOR CENTRE IS BEING APPLIED TOWARD THE STRUCTURAL APPOINTMENT. PURCHASER HAS A REMAINING AMOUNT OF \$00 (INCLUDING TAXES) TO BE USED TOWARD THE COLOUR APPOINTMENT.
Line20966	Note:
12Apr17 / 29May17	

Inv.1,322	1 - Purchaser has attended a Structural appointment at the Decor Centre & has DECLINED any additional upgrades and accepts and acknowledges that there will be no further structural changes/additions/deletions to be made upon signing on April 11, 2017
Line20967	Note:
12Apr17 / 29May17	

Inv.1,322	1 - Purchasers are aware & accepts that ANY changes made to upgrades after signing this Purchasers Extra Form are subject to a minimum administration fee of \$500. PLUS a 10% holdback fee
Line20968	Note:
12Apr17 / 29May17	

STAIRS AND RAILINGS


Inv.1,322	1 - DINING ROOM: DELETE HALF WALL IN DINING ROOM AND INSTALL RAILING AND NOSING. PRICE IS FOR A STANDARD RAILING.
Line21834	Note:
12Apr17 / 29May17	

WINDOWS - BASEMENT

Inv.1,322	2 - BASEMENT: INSTALL TWO (X2) BASEMENT WINDOWS - UPGRADE EXISTING BASEMENT WINDOW TO 30 INCH X 24 INCH - MAY REQUIRE INSTALLATION OF WINDOW WELL
Line20964	Note:
12Apr17 / 29May17	

WINDOWS AND DOORS

Inv.1,322	1 - MANDOOR- AVAILABLE IF GRADE PERMITS
Line21828	Note:
12Apr17 / 29May17	

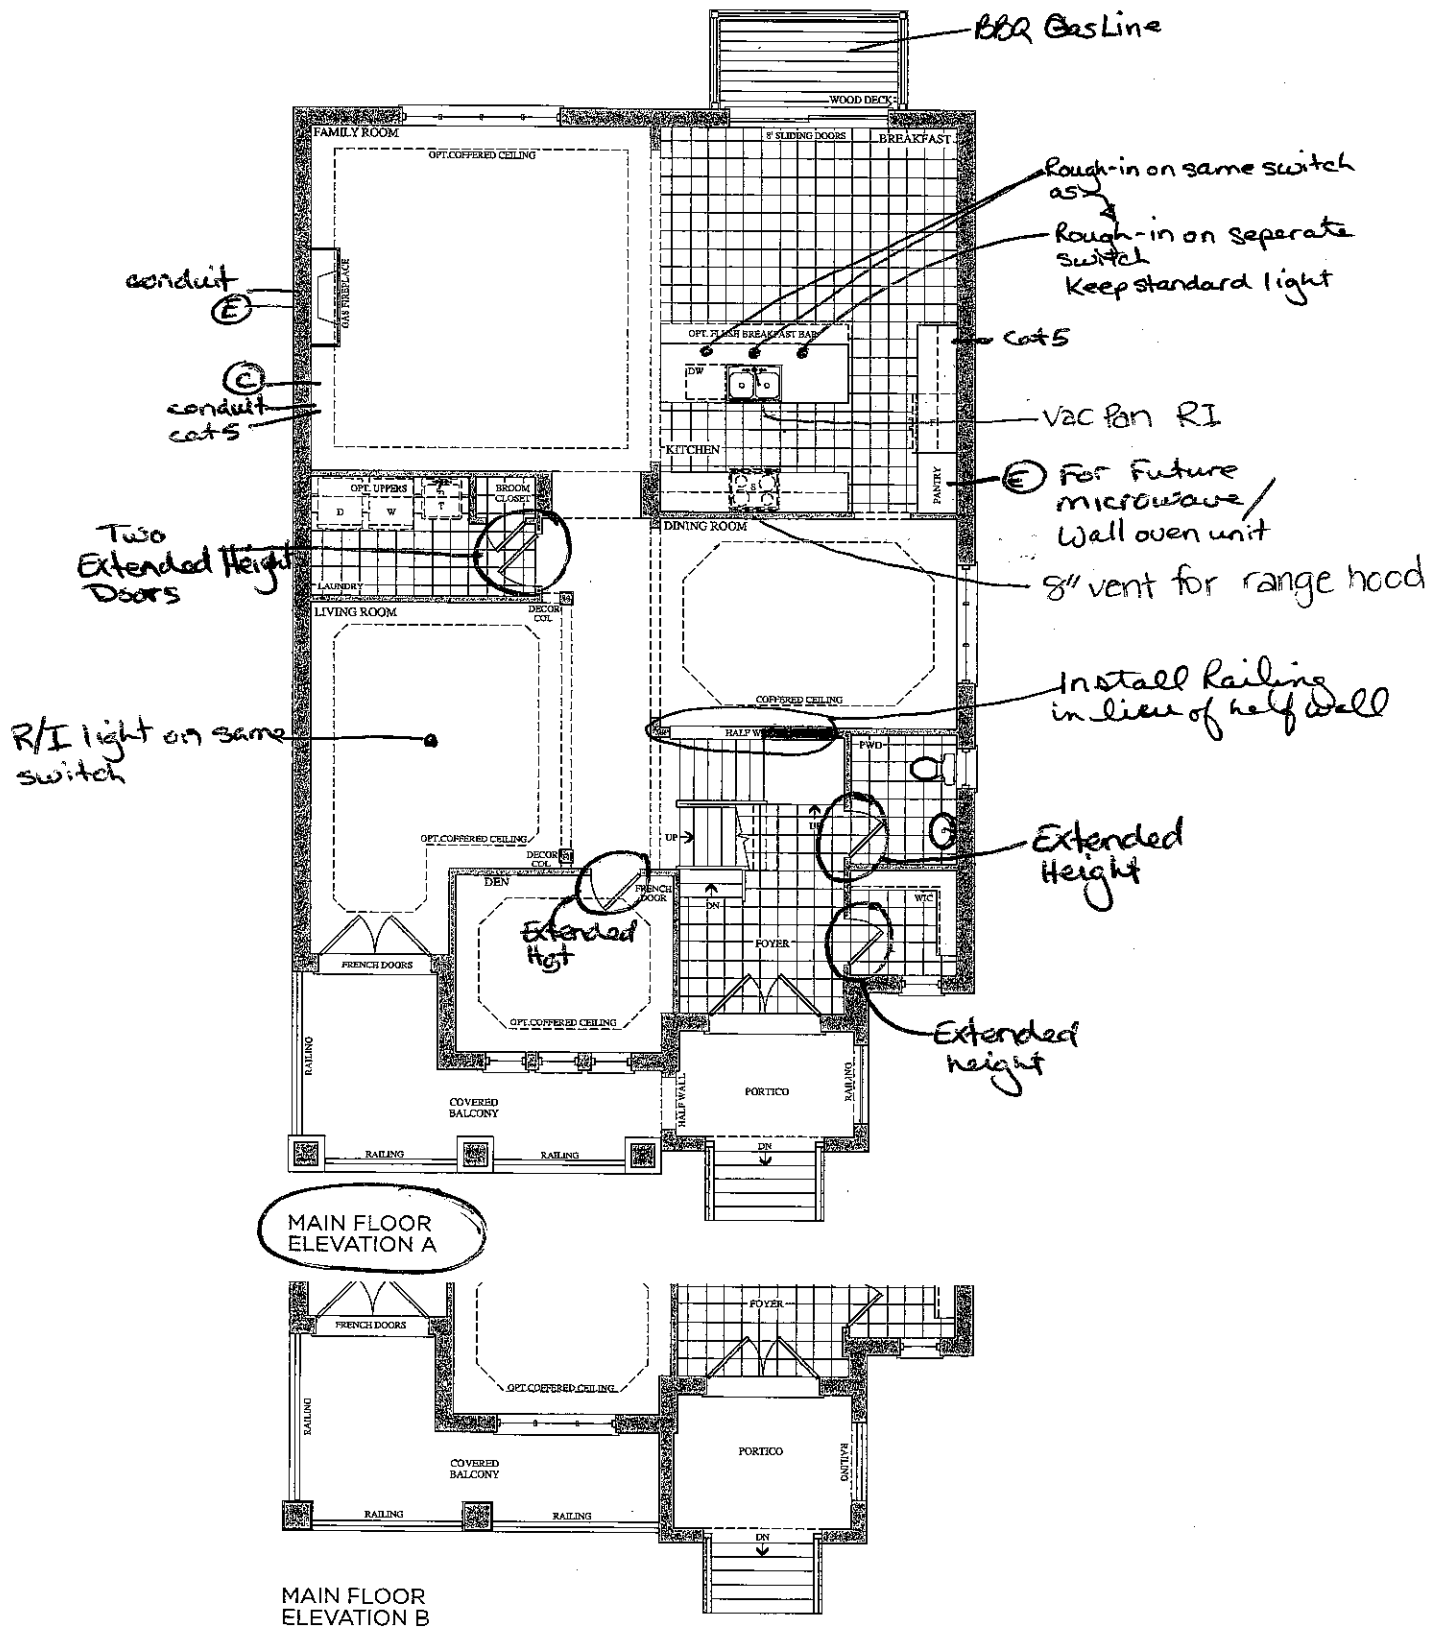

Lot 82
Apr. 12, 17

DS PRA


encore
BRAMPTON

Telephone Cat 5 — (T)
Cable RG6 — (C)


The
Verdi
41' SERIES

Elevation A • 3,940 sq.ft. | Elevation B • 3,940 sq.ft.

Shampoo
shelf

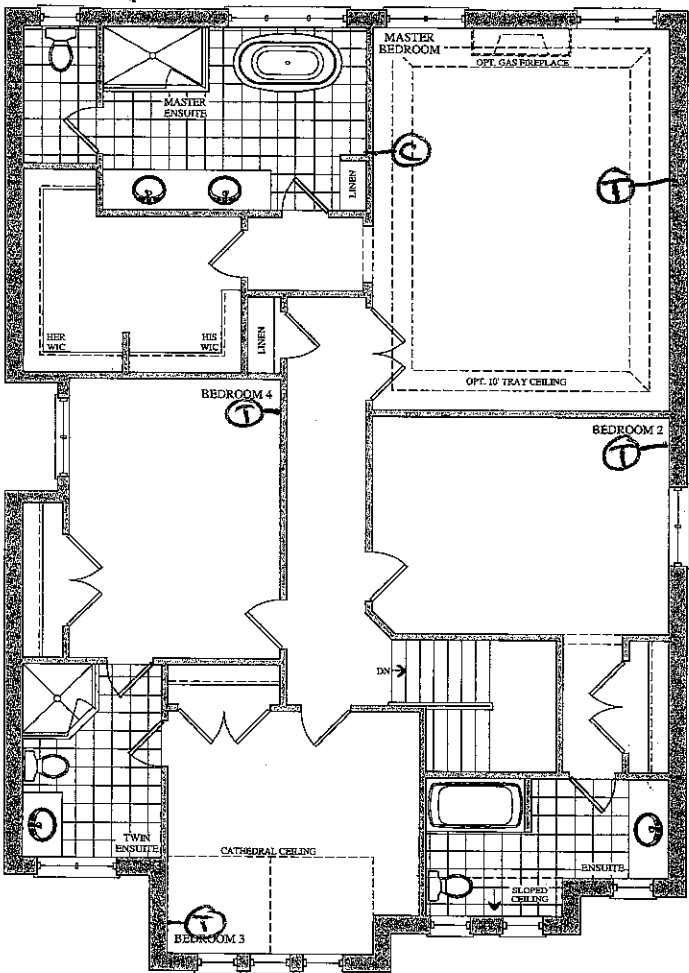

SECOND FLOOR
ELEVATION A

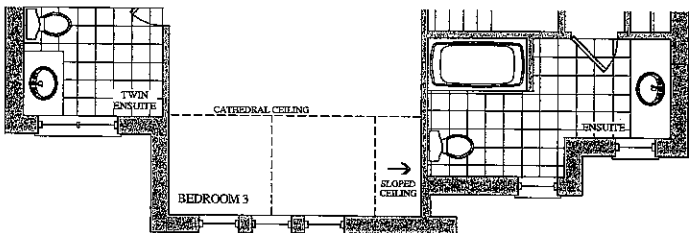


SECOND FLOOR
ELEVATION B

Prices, figures, illustrations, sizes, features and finishes are subject to change without notice. E.&O.E. Areas and dimensions are approximate and actual usable floor space may vary from the stated area. Layout may be reverse of the unit purchased. E. & O.E.

GOLDPARK
HOMES

Lot 82
Apr. 12, 17

(S) (S)

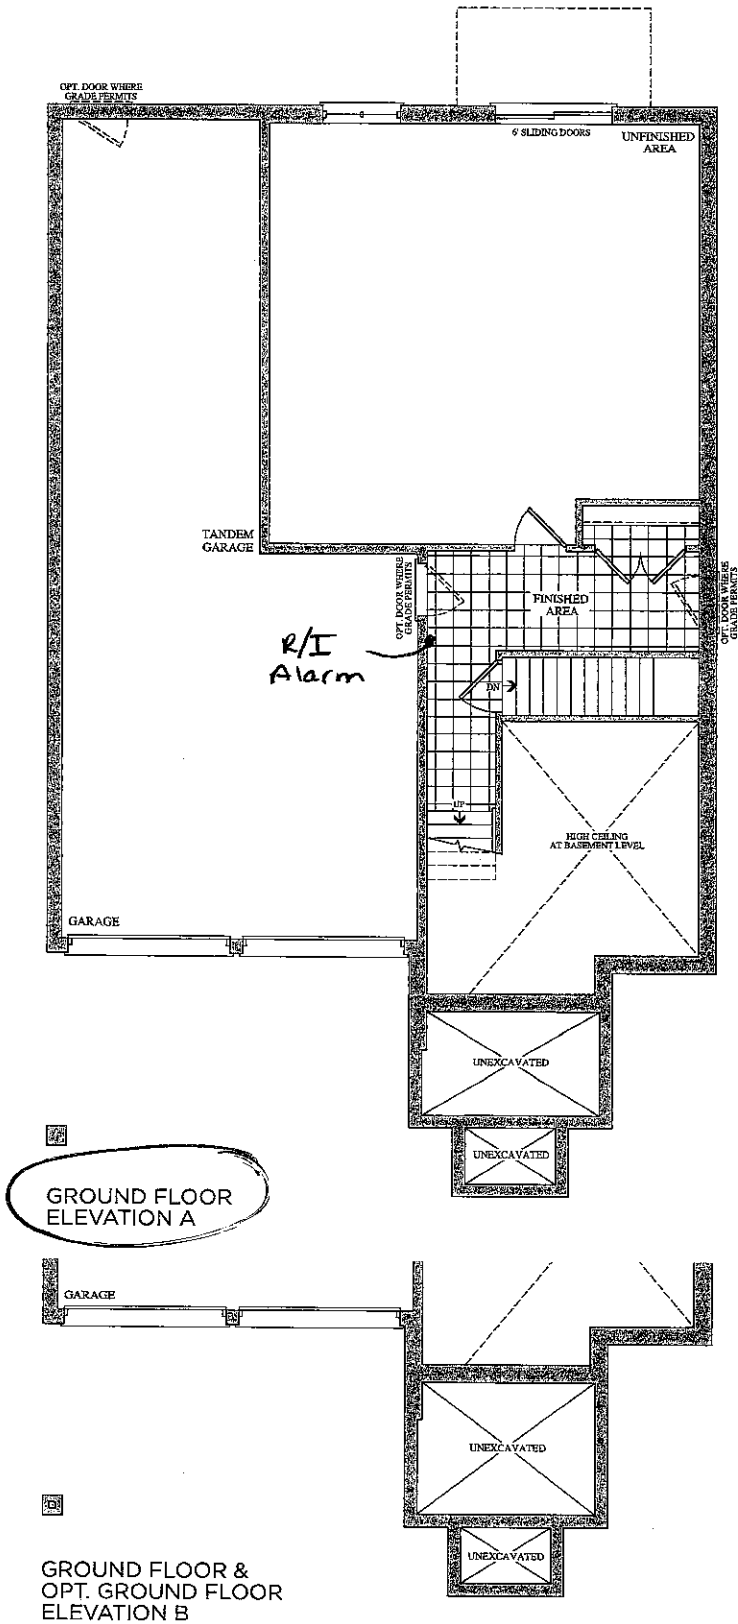


Prices, figures, illustrations, sizes, features and finishes are subject to change without notice. E.&O.E. Areas and dimensions are approximate and actual usable floor space may vary from the stated area. Layout may be reverse of the unit purchased. E. & O.E.

GOLDPARK
HOMES

Lot 82
Apr. 12, 17
DS

BSMNT WINDOW 2
2x 30"x24"

Elevation A • 3,940 sq.ft. | Elevation B • 3,940 sq.ft.

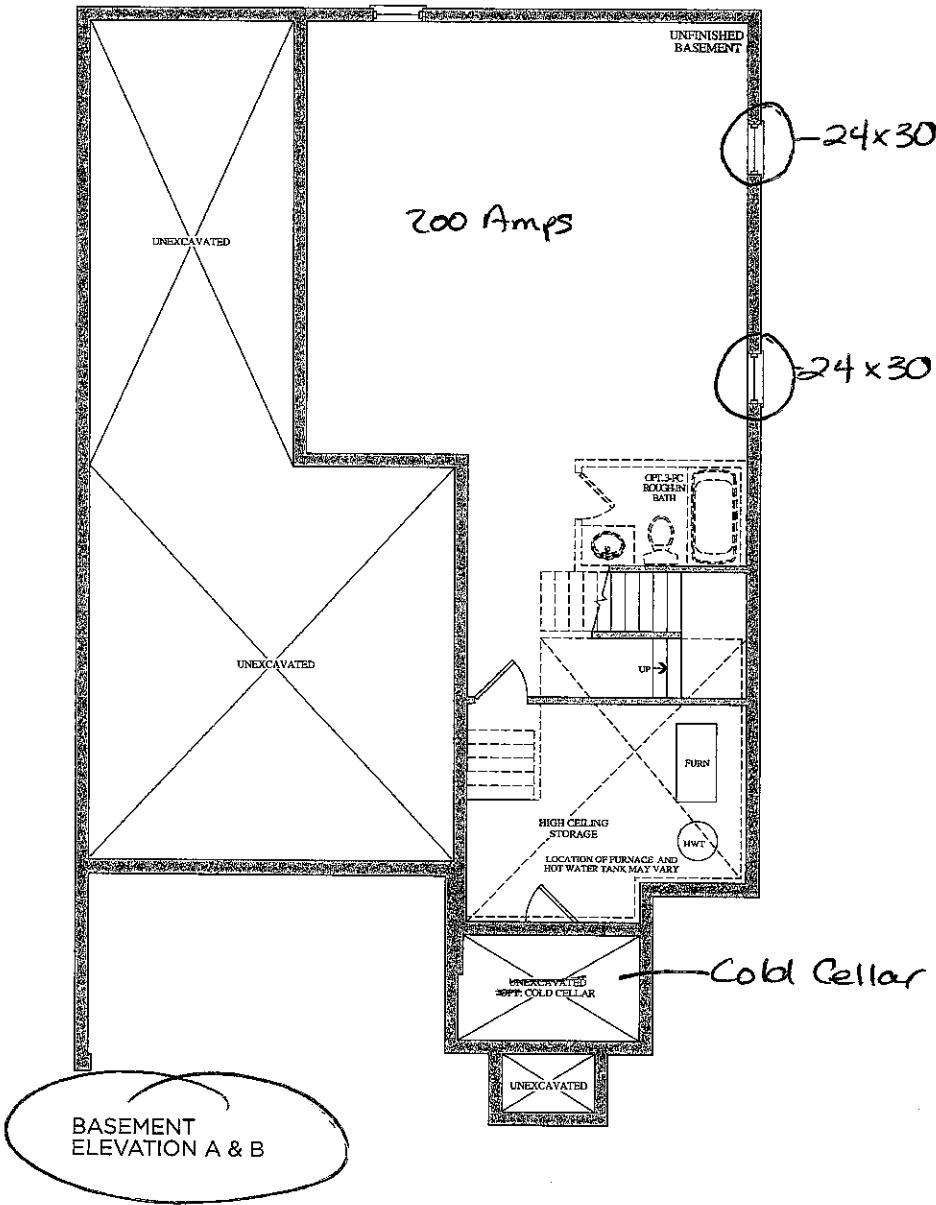

Prices, figures, illustrations, sizes, features and finishes are subject to change without notice. E.&O.E. Areas and dimensions are approximate and actual usable floor space may vary from the stated area. Layout may be reverse of the unit purchased. E. & O.E.

GOLDPARK
HOMES

Lot 82
Apr. 12, 17
DS



Stacey Carlete
Project Coordinator



Claude Azzopardi
Contracts Manager



Nancy Mc
Corporate C

82
Lot #



38.1 The Bizet			
Model			
Elevation	Circle One	A	2189.6 Square Feet
		B	2186.7 Square Feet
Optional Layouts	Circle All that Apply		

38.2 The Ravel			
Model			
Elevation	Circle One	A	2271.5 Square Feet
		B	2273.7 Square Feet
Optional Layouts	Circle All that Apply		

38.3 The Haydn			
Model			
Elevation	Circle One	A	2394.5 Square Feet
		B	2388.3 Square Feet
Optional Layouts	Circle All that Apply		

38.4 The Vivaldi			
Model			
Elevation	Circle One	A	2459.1 Square Feet
		B	2459.1 Square Feet
Optional Layouts	Circle All that Apply		

38.5 The Handel			
Model			
Elevation	Circle One	A	2549.2 Square Feet
		B	2554.7 Square Feet
Optional Layouts	Circle All that Apply		

38.9 The Puccini			
Model			
Elevation	Circle One	A	3628.0 Square Feet
		B	3634.7 Square Feet
Optional Layouts	Circle All that Apply	GFA1	GROUND FLOOR Optional Alternative Layout

38.6 The Scarlatti			
Model			
Elevation	Circle One	A	3521.1 Square Feet
		B	3508.1 Square Feet
Optional Layouts	Circle All that Apply	GFA1	GROUND FLOOR Optional Alternative Layout

38.7 The Schubert			
Model			
Elevation	Circle One	A	3593.8 Square Feet
		B	3610.5 Square Feet
Optional Layouts	Circle All that Apply	GFA1	GROUND FLOOR Optional Alternative Layout
		SFA4	SECOND FLOOR Additional Bedroom
Optional Layouts	Circle All that Apply		

38.8 The Corelli			
Model			
Elevation	Circle One	A	3801.5 Square Feet
		B	3801.5 Square Feet
Optional Layouts	Circle All that Apply	GFA1	GROUND FLOOR Optional Alternative Layout
		SFA4	SECOND FLOOR Additional Bedroom w/ Ensuite
Optional Layouts	Circle All that Apply		

41.1 The Strauss			
Model			
Elevation	Circle One	A	2554.2 Square Feet
		B	2571.2 Square Feet
Optional Layouts	Circle All that Apply	SFA1	SECOND FLOOR Shower In Lieu of Tub B2

41.2 The Mozart			
Model			
Elevation	Circle One	A	2725.9 Square Feet
		B	2711.1 Square Feet
Optional Layouts	Circle All that Apply	SFA1	SECOND FLOOR Shower In Lieu of Tub B2

41.3 The Chopin			
Model			
Elevation	Circle One	A	2800.0 Square Feet
		B	2810.5 Square Feet
Optional Layouts	Circle All that Apply		

41.4 The Bach			
Model			
Elevation	Circle One	A	2894.4 Square Feet
		B	2894.5 Square Feet
Optional Layouts	Circle All that Apply		

41.5 The Brahms			
Model			
Elevation	Circle One	A	3948.1 Square Feet
		B	3949.1 Square Feet
Optional Layouts	Circle All that Apply	GFA1	GROUND FLOOR Optional Alternative Layout
		SFA2	SECOND FLOOR Shower In Lieu of Tub B4
Optional Layouts	Circle All that Apply	SFA3	SECOND FLOOR Optional Laundry Layout

41.6 The Verdi			
Model			
Elevation	Circle One	A	3862.5 Square Feet
		B	3866.4 Square Feet
Optional Layouts	Circle All that Apply	GFA1	GROUND FLOOR Optional Alternative Layout
		SFA3	SECOND FLOOR Optional Laundry Layout
Optional Layouts	Circle All that Apply		

Apr. 12, 17

PS. [Signature]