

CLARIFICATION

	LOT 47R- KLEINBURG GLEN
PROJECT- Kleinburg Glen	
KITCHEN AND BATH CABINETRY	
Install Soft Close in kitchen	

• Install 4 exterior potlight's as per attached

ELECTRICAL

Thank you	
DATE ISSUED:	6/02/17
ISSUED BY:	Słacey Carlete




LOT 47R.

the Wiltshire

Elevation A • 2,187 sq.ft.



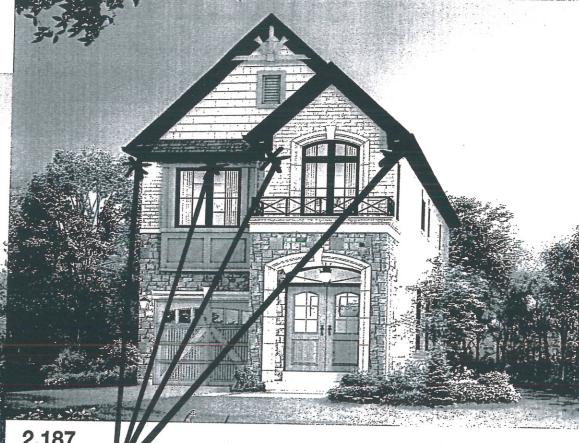

SUPPLY & INSTALL 4.
EXTERIOR POTZIGHTS.





VENDOR PURCHASER PURCHASER

SCHEDULE 'E