

June 26, 2017

---

**ADDITION**

**LOT 27- Brampton Encore**

**PROJECT-** Brampton Encore

Electrical

- Please install 6 exterior potlights (Per attached drawing)


Thank you

DATE ISSUED: 6/26/17


ISSUED BY: Stacey Carlete

The

Elevation A • 3,591 sq.ft. 38.06

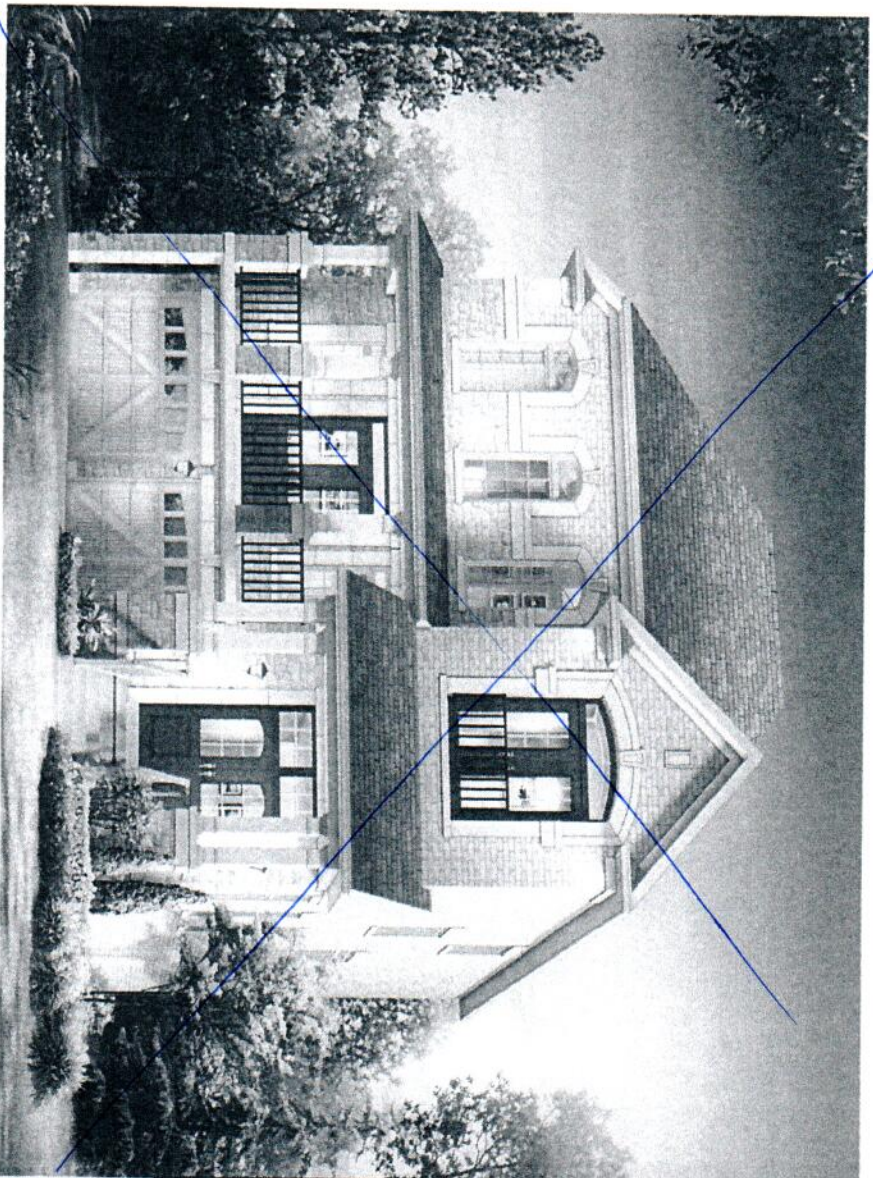

encore

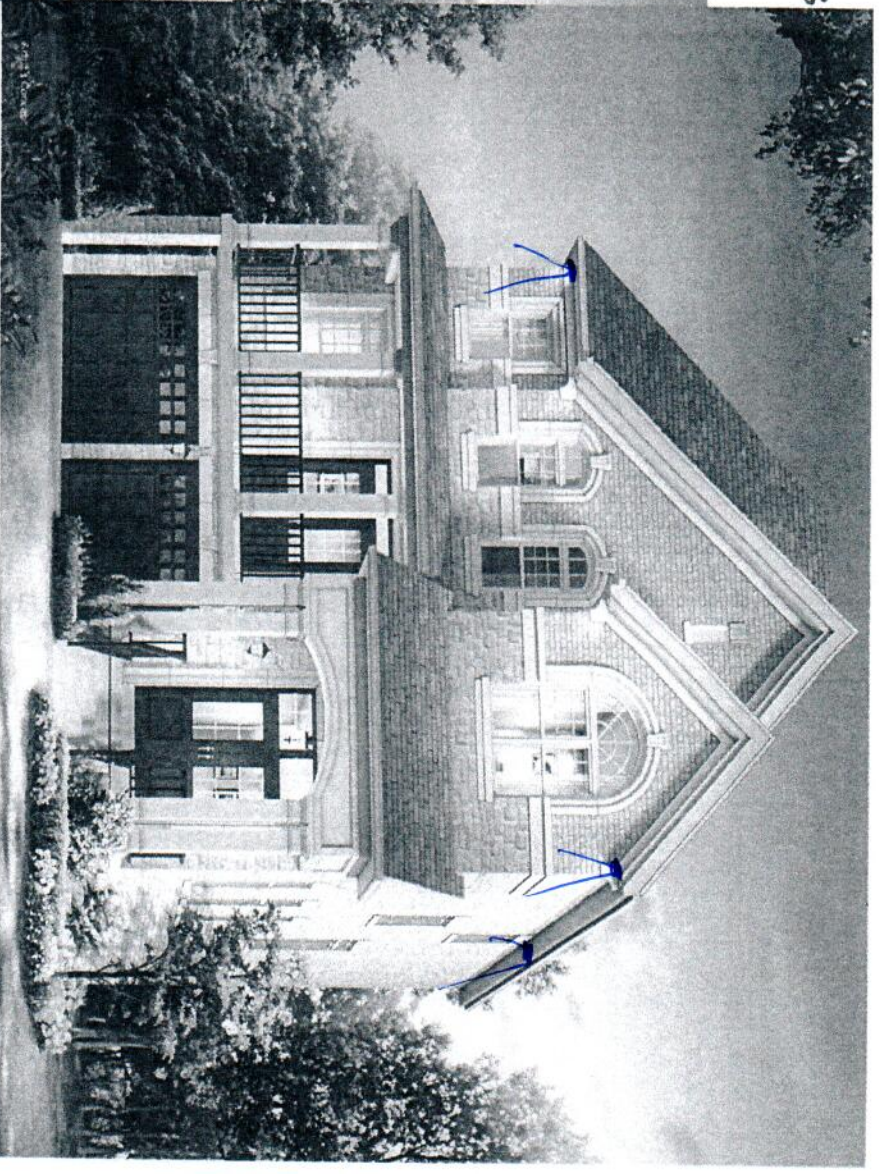

Elevation B • 3,578 sq.ft.

38'  
SERIES

SCHEDULE 'E'

GOLD

WORTH MORE™

BE-27

June 20 2017


VENDOR

PURCHASER

PURCHASER
