

ADDITION

LOT 27- Brampton Encore

PROJECT- Brampton Encore

Electrical

- Please install 6 exterior potlights (Per attached drawing)
 - 2 soffit potlight's at front elevation (at corners per drawings)
 - 1 (2x) soffit light on either side of side elevation in the center point of the soffit
 - 2 soffit potlight's at rear elevation (at corners per drawings)


Thank you

DATE ISSUED: 6/26/17


ISSUED BY: Stacey Carlete

The

Elevation A • 3,591 sq.ft. 38.06

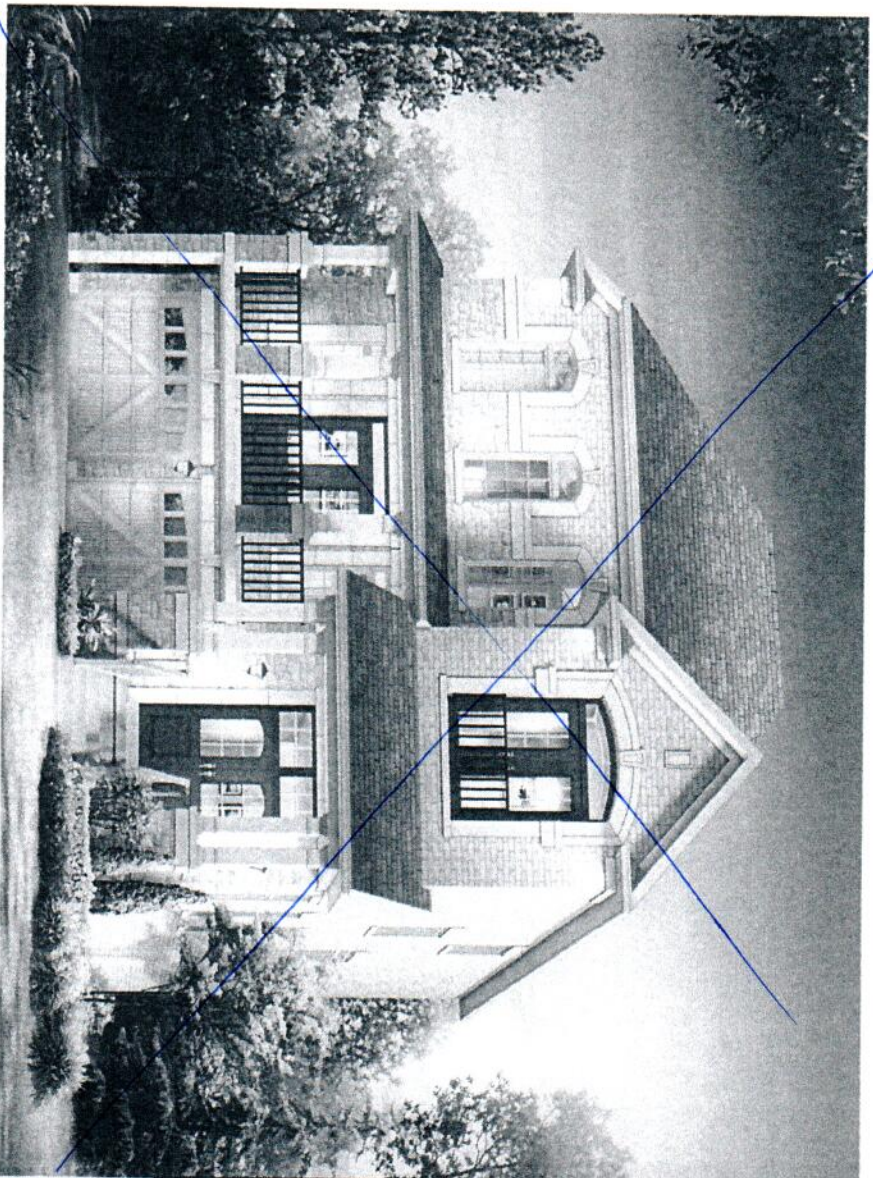

encore

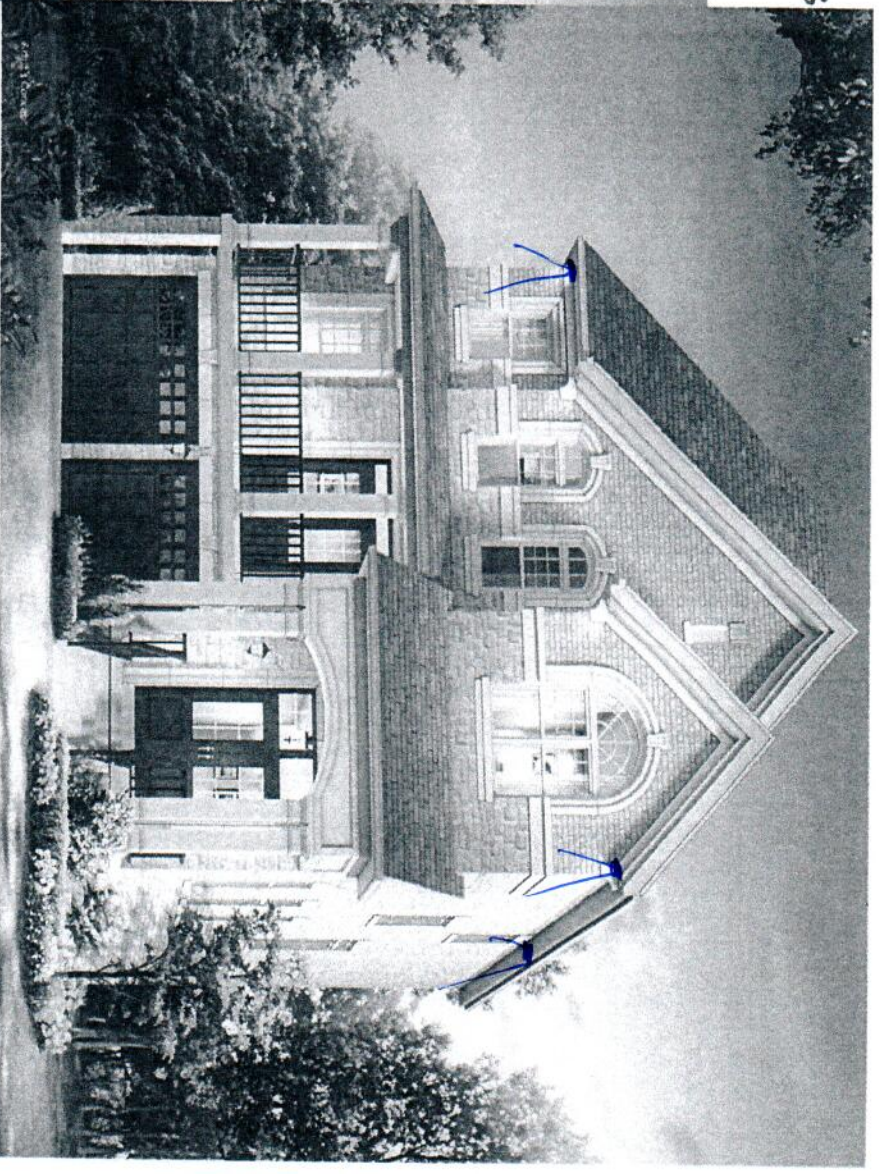

Elevation B • 3,578 sq.ft.

38'
SERIES

SCHEDULE 'E'

GOLD

WORTH MORE™

BE-27
June 20 2017




VENDOR

PURCHASER

PURCHASER
