## **Schedule 1: Designer Information**

Use one form for each individual who reviews and takes responsibility for design activities with respect to the project. **Project Information** Building number, street name Unit no. Lot/con. 42-05 'A' 7 Municipality Postal code Plan number/ other description **VAUGHAN** Individual who reviews and takes responsibility for design activities Name Julio Pinzon **RN Design Limited** Street address Unit no. Lot/con. 8395 Jane Street 203 Municipality Postal code Province E-mail Vaughan L4K 5Y2 **Ontario** juliop@rndesign.com Telephone number Fax number Cell number (905) 738-3177 (905) 738-5449 Design activities undertaken by individual identified in Section B. [Building Code Division C, Part 3 Table 3.5.2.1 ☐ HVAC – House Building Structural ☐ Small Buildings **Building Services** ☐ Plumbing – House Large Buildings Detection, Lighting and Power ☐ Plumbing – All Buildings ☐ Complex Buildings ☐ Fire Protection ☐ On-site Sewage Systems Description of designer's work Review of the site plan design and working drawings for Lot 7 model MADISON 42-05 'A' STD. Design responsibility excludes any structural design and specifications outside of the scope of Part 9 of the OBC. **Declaration of Designer** 1 Julio Pinzon declare that (choose one as appropriate): (print name) I review and take responsibility for the design work on behalf of a firm registered under Division C, Part 3, subsection 3.2.4. of the Building Code. I am qualified, and the firm is registered, in the appropriate classes/categories: Individual BCIN: 38688 Firm BCIN: 26995 ☐ I review and take responsibility for the design work and am qualified in the appropriate category as an "other designer" under Division C. Part 3, subsection 3.2.5 of the Building Code. Individual BCIN: Basis for exemption from registration: — The design work is exempt from the registration and qualification requirements of the Building Code. Basis for exemption from registration and qualification: I certify that: The information contained in this schedule is true to the best of my knowledge. 2. I have authority to bind the corporation or partnership (if applicable). March 16, 2017 Signature of Designer

\*For the purposes of this form, "individual" means the "person" referred to in Division C, Part 3, Clause 3.2.4.7. (1)(d), Division C, Part 3, Article 3.2.5.1. and all other persons who are exempt from qualification under Division C, Part 3, Subsections 3.2.4. and 3.2.5.

### NOTE

- 1. Firm and Individual BCIN numbers are not required for building permit applications submitted prior to January 1, 2006
- Schedule 1 does not need to be completed by architects, or holders of a Certificate of Practice or a Temporary License under the Architects
  Act

It is the builder's complete responsibility to ensure that all plans submitted for approval fully comply with the Architectural Guidelines and all applicable regulations and requirements including zoning provisions and any provisions in the subdivision agreement. The Control Architect is not responsible in any way for examining or approving site (lotting) plans or working drawings with respect to any zoning or building code or permit matter or that any house can be properly built or located on its lot.

This is to certify that these plans comply with the applicable Architectural Design Guidelines approved by the City of VAUGHAN.


ARCHITECTURAL REVIEW & APPROVAL

John G. Williams Limited, Architect

NOTE:

BUILDER TO CONNECT REAR DOWN SPOUTS TO THE INFILTRATION TRENCH BY A 125MM DIA. PIPE.



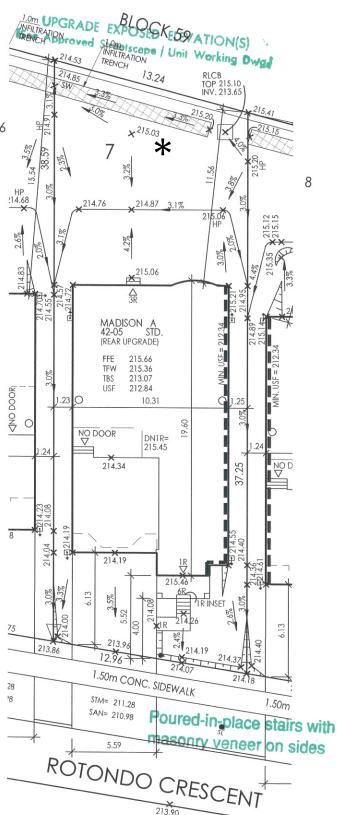

NOTE: BUILDER TO VERIFY LOCATION OF ALL HYDRANTS, STREET LIGHTS, TRANSFORMERS AND OTHER SERVICES. IF MINI, DIMENSIONS ARE NOT MAINTAINED BUILDER IS TO RELOCATE AT HIS OWN EXPENSE

#### REG. PLAN No. ZONE RD3 LOT NUMBER LOT 7 LOT AREA(m)<sup>2</sup> 485.25 BLDG AREA(m) $^2$ 195.6 LOT COVERAGE(%) 40.3% No. OF STOREYS 10.00 MEAN HEIGHT(m) PEAK HEIGHT(m) DECK LINE(m)

	LEG	END			
FFE	FINISHED FLOOR ELEVATION	$\boxtimes$	BELL PEDESTAL		
TFW	TOP OF FOUNDATION		CABLE PEDESTAL		
	WALL		CATCH BASIN		
TBS	TOP OF BASEMENT SLAB		DBL. CATCH BASIN		
USF	UNDER SIDE FOOTING	*	ENGINEERED FILL		
USFR	UNDER SIDE FOOTING @		HYDRO CONNECTION		
USFG	UNDER SIDE FOOTING @		FIRE HYDRANT		
TEE	GARAGE TOP OF ENGINEERED	SL	STREET LIGHT		
TEF	FILL	$\geq \leq$	MAIL BOX		
R	NUMBER OF RISERS TO GRADE		TRANSFORMER		
WOD	WALKOUT DECK	$\nabla$	SEWER CONNECTIONS 2 LOTS		
LOB	LOOKOUT BASEMENT	7	SEWER CONNECTIONS 1		
WOB	WALK OUT BASEMENT	4	WATER CONNECTION		
REV	REVERSE PLAN	Θ	WATER VALVE		
STD	STANDARD PLAN	$\wedge$	CHAMBER HYDRANT AND		
Δ	DOOR		VALVE		
0	WINDOW	H	HYDRO METER		
AC	AIR CONDITIONING	•	GAS METER		
•	DOWN SPOUT TO SPLASH PAD	$\circ$	MANHOLE - STORM		
$\rightarrow$	SWALE DIRECTION		MANHOLE - SANITARY		
SP	SUMP PUMP	•	POTENTIAL HIGH WATER TABLE (SEE NOTE ON THIS DRAWING)		
	————X———— CHAINLINK FENCE				
		PRIVACY			
		SOUND BA			
		TO 1.22 (A	TO BE EXTENDED MIN) BELOW GRADE		
	ISSUED OR REVI	20110	OLALAFAITC		
	DOUGL OF REAL	). ) PIL JIC	MANALIATY.		

NO.	DESCRIPTION	DATE	DWN	СНК
1.	ISSUED FOR REVIEW	FEB.13/17	ET	JP
2.	REVISED PER ENG COMM - FINAL	MAR 6/17	ET	JP
_				
			-	

# Imagine - Inspire - Create

## RN DESIGN LTD.

8395 JANE STREET, SUITE 203 VAUGHAN, ONTARIO. L4K 5Y2 T:905-738-3177 | F: 905-738-5449

I. JULIO PINZON DECLARETHAT I HAVE REVIEWED AND TAKEN DESIGN RESPONSIBILITY FOR THE DESIGN WORK ON BEHALF OF RN DESIGN LID. UNDER DIVISION C.PART-3 SUBSECTION-3.2.4 OF THE BUILDING CODE. I AM QUALIFIED AND THE FIRM IS REGISTERED IN THE APPROPRIATE CLASSES / CATEGORIES.

QUALIFIED DESIGNER BCIN:

FIRM BCIN: DATE: MAR. 6/17 3868

SIGNATURE:

CLIENT

GOLD PARK HOMES

ROJECT/LOCATION

KLEINBURG GLEN-PH2 VAUGHAN, ON

DRAWING

SITE PLAN

DRAWN BY ET	SCALE 1:250
PROJECT No.	LOT NUMBER
14043	LOT 7

## SITE PLAN REVIEW

THE PROPOSED LOT GRADING AND DRAINAGE IS APPROVED AS BEING IN CONFORMITY WITH THE OVERALL APPROVED GRADING PLANS FOR THE SUBDIVISION.

THIS REVIEW DOES NOT WARRANT THAT OTHER INFORMATION SHOWN ON THIS DRAWING IS ACCURATE OR COMPLETE. SOLE RESPONSIBILITY FOR THE DESIGN AND DETAILS SHALL REMAIN WITH THE DESIGNER.

NO COMMENT

REVIEWED BY SK

COMMENTS AS NOTED

□ DATE ... Mar. 13, 2017



