

**ADDITION: LOT 83R Kleinburg Glen**

**PROJECT-** Kleinburg Glen

**INSERT**

**Drywall**


- Install smooth ceilings on second floor

**Electrical**


- Install 6 potlight's in family room as per sketch attached

**DATE ISSUED:** 7/24/17

**ISSUED BY:** Stacey Carlete


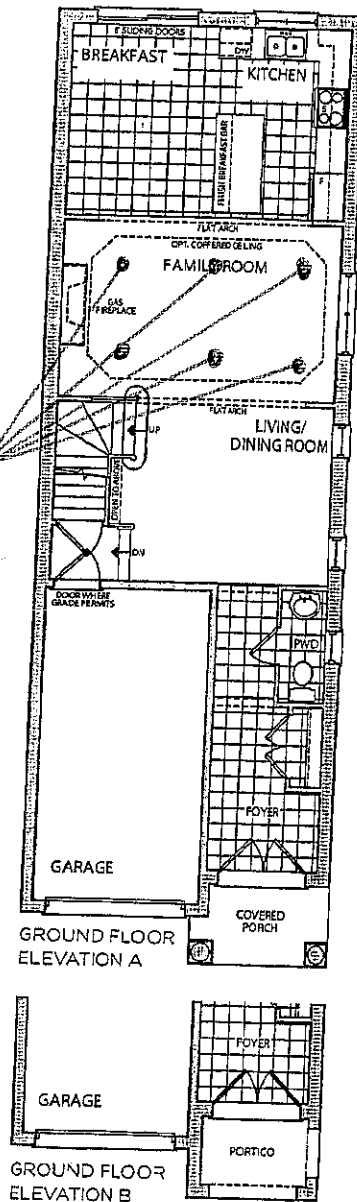


Lot 83R.  
**the Hudson**  
 Elevation A • 1,898 sq.ft.  
 Elevation B • 1,898 sq.ft.

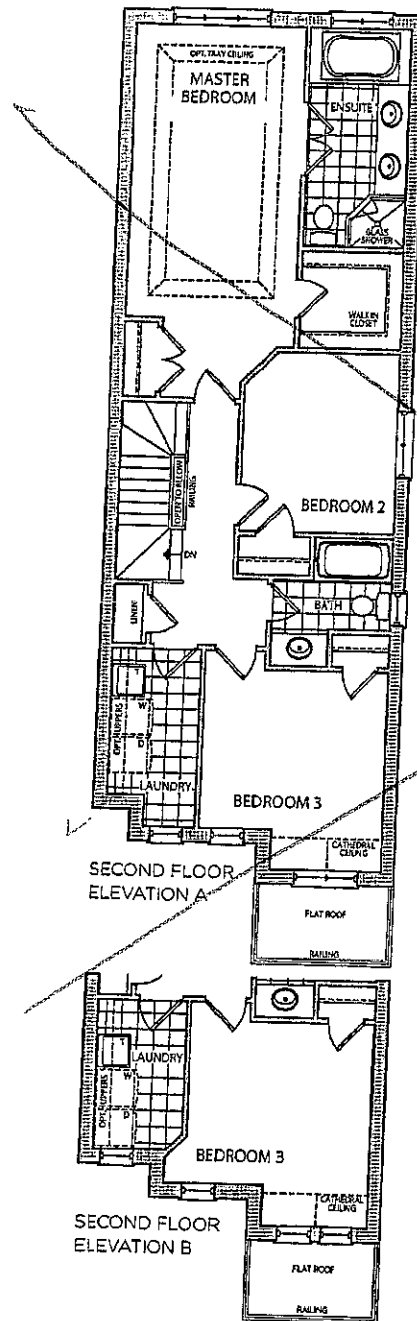

VENDOR  
 PURCHASER  
 PURCHASER

**Kleinburg**  
 GLEN

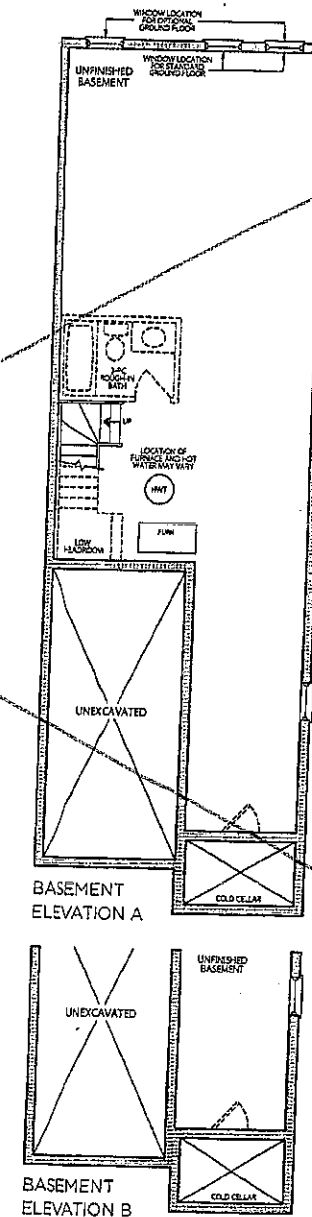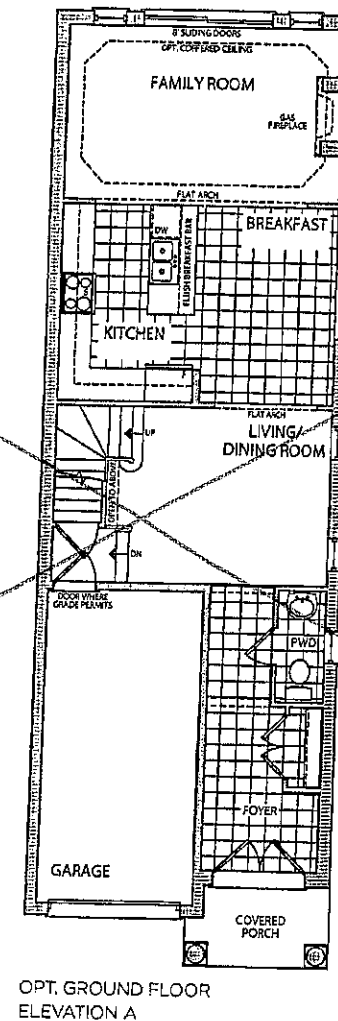

**GOLDPARK**  
 HOMES

Prices, figures, illustrations, sizes, features and finishes are subject to change without notice. E.&O.E. Areas and dimensions are approximate and actual usable floor space may vary from the stated area. Layout may be reverse of the unit purchased. Models on 25' lots may be linked below grade at basement footings. E. & O.E.

SCHEDULE 'F'