

Brampton Encore - 1 - LOT SPECIFIC MODEL- 41-7

CENTRAL VAC AND WIRING

Inv.1,540	1 - CAT 6 WIRING - UPGRADE AN OUTLET TO CAT 6- MUST SPECIFY LOCATION
Line23714	Note:
2Aug17 / 2Aug17	
Inv.1,541	1 - CONDUIT PIPE- FOR TELEVISION- MUST SPECIFY LOCATION AND TERMINATION POINT- SEE FLOORPLAN ABOVE MAIN FLOOR FIREPLACE
Line23716	Note:
3Aug17 / 3Aug17	

CONCRETE AND DRAIN

Inv.1,540	1 - COLD CELLAR
Line23710	Note:
2Aug17 / 2Aug17	
Inv.1,540	1 - ROUGH-IN - 3PC BASEMENT ROUGH-IN
Line23711	Note:
2Aug17 / 2Aug17	

DRYWALL

Inv.1,540	1 - SMOOTH CEILINGS SECOND FLOOR
Line23697	Note:
2Aug17 / 2Aug17	
Inv.1,540	1 - SMOOTH CEILINGS MAIN FLOOR
Line23701	Note:
2Aug17 / 2Aug17	

ELECTRICAL

Inv.1,540	1 - 110V RECEPTACLE FOR FUTURE GAS STOVE IN KITCHEN
Line23699	Note:
2Aug17 / 2Aug17	
Inv.1,540	1 - CENTER STD LIGHT FIXTURE AS BEST AS POSSIBLE IN DINING ROOM
Line23704	Note:
2Aug17 / 2Aug17	
Inv.1,540	1 - ADD CAPPED LIGHT FIXTURE IN LIVING ROOM- CENTER TO CEILING AS BEST AS POSSIBLE ON SEPERATE SWITCH
Line23705	Note:
2Aug17 / 2Aug17	
Inv.1,540	1 - 220V WALL RECEPTICAL ON DEDICATED CIRCUIT- FOR 4 WIRE BUILT-IN WALL OVEN - MUST SPECIFY LOCATION
Line23707	Note:
2Aug17 / 2Aug17	
Inv.1,541	1 - 110V WALL RECEPTACLE ON NORMAL CIRCUIT-MUST SPECIFY LOCATION
Line23717	Note:
3Aug17 / 3Aug17	

Exterior Colours

Inv.1,540	1 - EXTERIOR COLOUR PACKAGE #10
Line23706	Note:
2Aug17 / 2Aug17	

Brampton Encore - 1 - LOT SPECIFIC MODEL- 41-7

FORMING

Inv.1,540	1 - COLD CELLAR
Line23712	Note:
2Aug17 / 2Aug17	

FRAMING

Inv.1,540	1 - MAN DOOR- GARAGE TO HOUSE- GRADE PERMITTING
Line23709	Note:
2Aug17 / 2Aug17	

Inv.1,541	4 - MAIN FLOOR TALLER DOORS
Line23715	Note:
3Aug17 / 3Aug17	

HVAC

Inv.1,540	1 - GAS LINE - FOR FUTURE GAS STOVE IN KITCHEN
Line23698	Note:
2Aug17 / 2Aug17	

Inv.1,540	1 - 8" STOVE VENT IN KITCHEN ON EXTERIOR WALL
Line23703	Note:
2Aug17 / 2Aug17	

PLUMBING

Inv.1,540	1 - ROUGH-IN - 3PC BASEMENT ROUGH-IN
Line23713	Note:
2Aug17 / 2Aug17	

WINDOWS - BASEMENT

Inv.1,540	3 - UPGRADE 3 REAR BASEMENT WINDOWS- 30" x 16"
Line23700	Note:
2Aug17 / 2Aug17	

WINDOWS AND DOORS

Inv.1,540	1 - MAN DOOR- GARAGE TO HOUSE- GRADE PERMITTING
Line23708	Note:
2Aug17 / 2Aug17	

Lot 1
3,243 sq. ft.



Artist's Concept



Artist's Concept




SCHEDULE 'E'

GOLD PARK
WORTH MORE™

VENDOR	<input type="text"/>
PURCHASER	<input type="text"/>
PURCHASER	<input type="text"/>

• smooth ceilings main floor

• smooth ceilings 2nd floor

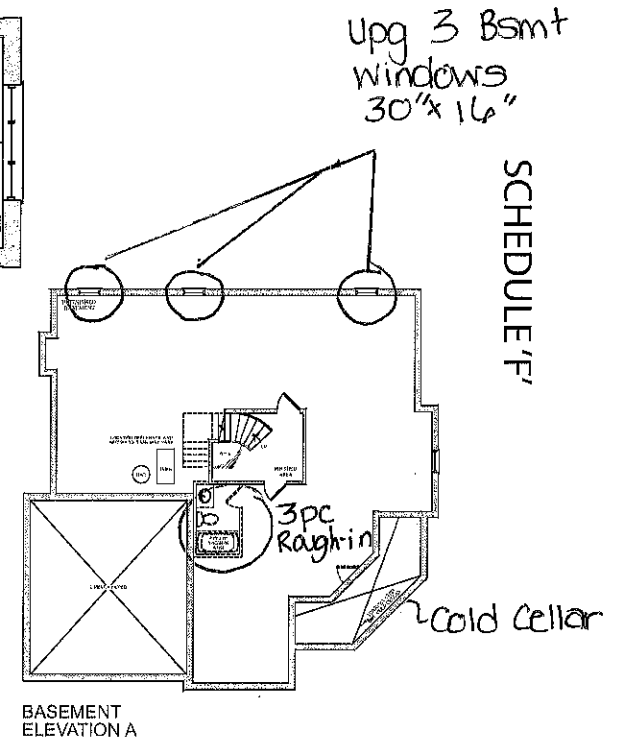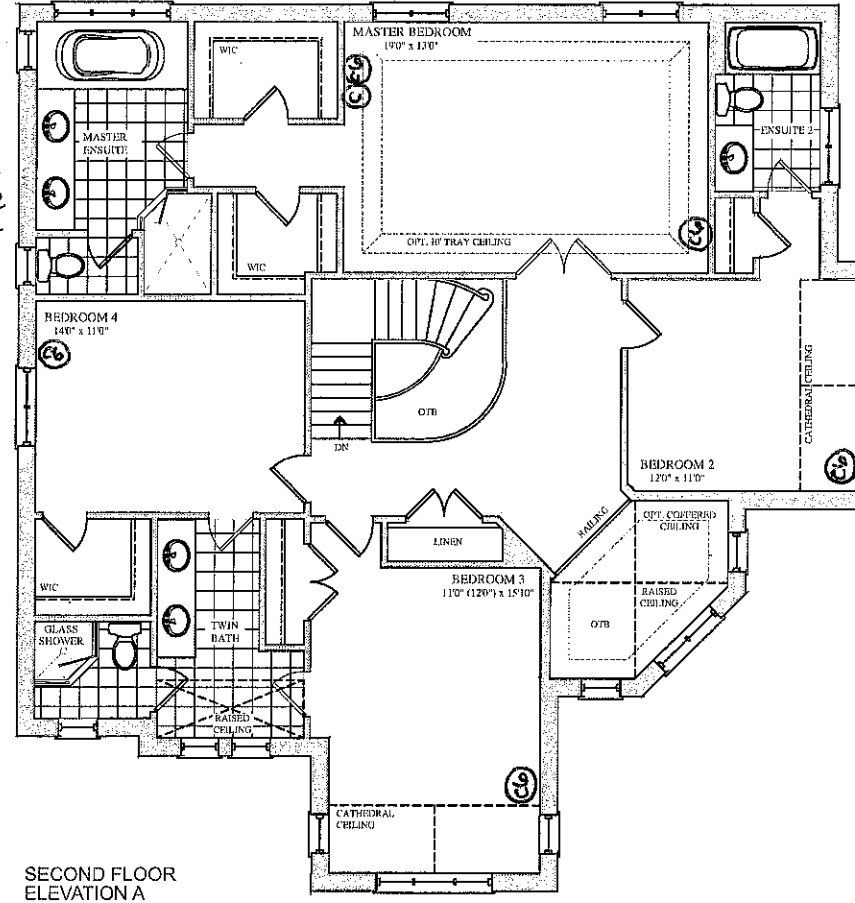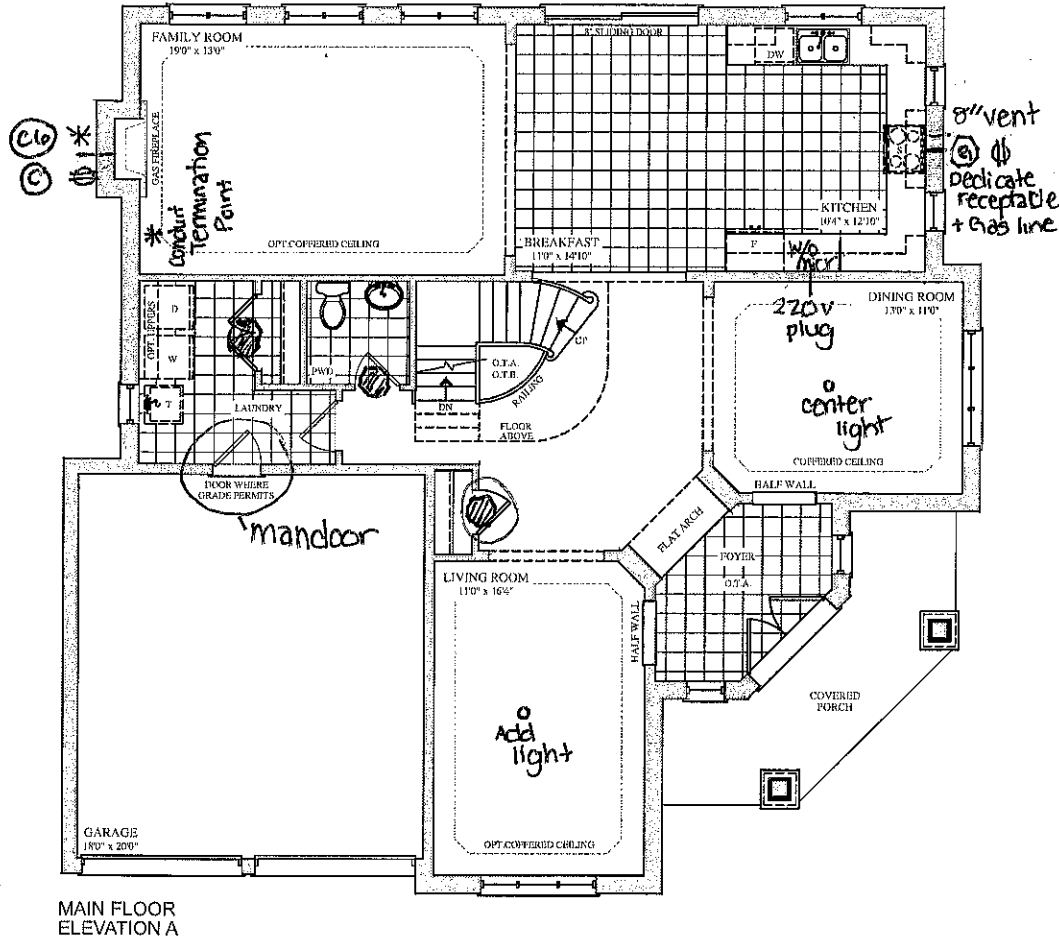

VENDOR

PURCHASER

PURCHASER

- ▨ - 96" taller door
- Ⓣ - telephone
- Ⓢ - cable
- Ⓢ - CAT 6
- Ⓢ - Gas line
- Ⓢ - Receptacle
- o - light fixture
- * Conduit

GOLDPARK
WORTH MORE™

Prices, figures, illustrations, sizes, features and finishes are subject to change without notice. Areas and dimensions are approximate and actual usable floor space may vary from the stated area. Layout may be reverse of the unit purchased. E. & O.E.