

Brampton Encore - BLK 137 - 2 - 41-5 Elev.A BRAHMS OPT - GFA1

CENTRAL VAC AND WIRING

Inv.1,542	1 - TELEPHONE AND CABLE ROUGH-IN LOCATION SEE FLOOR PLAN
Line23740	Note:
3Aug17 / 3Aug17	
Inv.1,542	1 - SMART ETHERNET PACKAGE: INSTALL FOUR (X4) CAT 6 LOCATIONS IN LIEU OF THE FOUR (X4) STANDARD CAT5 LOCATIONS SEE SKETCH
Line23741	Note:
3Aug17 / 3Aug17	
Inv.1,542	1 - CONDUIT PIPE- FOR TELEVISION- MUST SPECIFY LOCATION AND TERMINATION POINT
Line23762	Note:
3Aug17 / 3Aug17	

CONCRETE AND DRAIN

Inv.1,542	1 - ROUGH-IN - 3PC BASEMENT ROUGH-IN
Line23743	Note:
3Aug17 / 3Aug17	
Inv.1,542	1 - INSTALL COLD CELLAR
Line23753	Note:
3Aug17 / 3Aug17	

ELECTRICAL

Inv.1,542	1 - 240V WALL RECEPTICAL ON DEDICATED CIRCUIT- FOR 4 WIRE BUILT-IN WALL OVEN - MUST SPECIFY LOCATION
Line23742	Note:
3Aug17 / 3Aug17	
Inv.1,542	1 - RELOCATE STANDARD FIXTURE IN KITCHEN TO ABOVE ISLAND. SEE SKETCH
Line23746	Note:
3Aug17 / 3Aug17	
Inv.1,542	1 - GAS LINE ROUGH - MAIN FLOOR - (3 STOREY MODELS) INCLUDES 110 V PLUG FOR STOVE
Line23748	Note:
3Aug17 / 3Aug17	
Inv.1,542	1 - 110V WALL RECEPTACLE ON DEDICATED CIRCUIT - FOR WINE FRIDGE- LOCATION ON FLOOR PLAN
Line23758	Note:
3Aug17 / 3Aug17	
Inv.1,542	1 - INSTALL ROUGH-IN CEILING OUTLET & ON SEPERATE SWITCH (WITH COVER PLATE) DOES NOT INLCUDE FIXTURE- TO GO ABOVE ISLAND
Line23760	Note:
3Aug17 / 3Aug17	
Inv.1,542	2 - INSTALL TWO (X2) ROUGH-IN CEILING OUTLET (WITH COVER PLATE) DOES NOT INLCUDE FIXTURE- TO GO ABOVE ISLAND- SEE FLOOR PLAN
Line23761	Note:
3Aug17 / 3Aug17	
Inv.1,542	1 - KITCHEN CABINET VALANCE LIGHTS (UNDER CABINETS) - WITH STRIP LIGHTS - DOES NOT INCLUDE (AND REQUIRES) KITCHEN UPGRADE PRICING
Line23763	Note:
3Aug17 / 3Aug17	

FORMING

Brampton Encore - BLK 137 - 2 - 41-5 Elev.A BRAHMS OPT - GFA1

Inv.1,542	1 - INSTALL COLD CELLAR
Line23754	Note:
3Aug17 / 3Aug17	
Inv.1,547	1 - SIDE DOOR TO HOUSE - OPTIONAL - GRADE PERMITS
Line23862	Note:
15Aug17 / 15Aug17	

FRAMING

Inv.1,542	5 - MAIN FLOOR: INSTALL FIVE (5x) STANDARD DOOR EXTENDED HEIGHT 96" (PRICE PER DOOR) 3 STOREY MODEL
Line23749	Note:
3Aug17 / 3Aug17	
Inv.1,542	2 - DEN: INSTALL TWO (2X) STANDARD FRENCH DOORS EXTENDED HEIGHT 96"
Line23750	Note:
3Aug17 / 3Aug17	
Inv.1,547	1 - MANDOOR- GARAGE TO HOUSE
Line23860	Note:
15Aug17 / 15Aug17	
Inv.1,547	1 - SIDE DOOR TO HOUSE - OPTIONAL - GRADE PERMITS
Line23861	Note:
15Aug17 / 15Aug17	

GRANITE MARBLE QUARTZ

Inv.1,542	1 - INSTALL OPTIONAL UNDERMOUNT BAR SINK IN SERVERY
Line23756	Note:
3Aug17 / 3Aug17	

HVAC

Inv.1,542	1 - GAS LINE ROUGH - MAIN FLOOR - (3 STOREY MODELS) INCLUDES 110 V PLUG FOR STOVE
Line23747	Note:
3Aug17 / 3Aug17	
Inv.1,542	1 - UPGRADE VENTING FOR STOVE TO 8" PIPE INTERIOR WALL - ACCOMODATED TO FIT STANDARD RANGE HOOD
Line23759	Note:
3Aug17 / 3Aug17	

INTERIOR TRIM AND DOORS

Inv.1,542	1 - MAIN FLOOR: INSTALL FIVE (5x) STANDARD DOOR EXTENDED HEIGHT 96" (PRICE PER DOOR) 3 STOREY MODEL
Line23751	Note:
3Aug17 / 3Aug17	
Inv.1,542	1 - DEN: INSTALL TWO (2X) STANDARD FRENCH DOORS EXTENDED HEIGHT 96"
Line23752	Note:
3Aug17 / 3Aug17	

KITCHEN AND BATH CABINETRY

Inv.1,542	1 - INSTALL OPTIONAL UNDERMOUNT BAR SINK IN SERVERY
Line23757	Note:
3Aug17 / 3Aug17	



CONSTRUCTION SUMMARY

Brampton Encore - BLK 137 - 2 - 41-5 Elev.A BRAHMS OPT - GFA1

PLUMBING

Inv.1,542	1 - ROUGH-IN - WATERLINE FOR FIRDGE
Line23745	Note:
3Aug17 / 3Aug17	
Inv.1,542	1 - INSTALL OPTIONAL UNDERMOUNT BAR SINK IN SERVERY
Line23755	Note:
3Aug17 / 3Aug17	

WINDOWS - BASEMENT

Inv.1,542	3 - BASEMENT WINDOWS - UPGRADE EXISTING BASEMENT WINDOW TO 30 INCH X 24 INCH - MAY REQUIRE INSTALLATION OF WINDOW WELL
Line23744	Note:
3Aug17 / 3Aug17	


WINDOWS AND DOORS

Inv.1,547	1 - MANDOOR- GARAGE TO HOUSE
Line23858	Note:
15Aug17 / 15Aug17	
Inv.1,547	1 - SIDE DOOR TO HOUSE - OPTIONAL - GRADE PERMITS
Line23859	Note:
15Aug17 / 15Aug17	


encore
BRAMPTON

The Brahms 41' SERIES

Elevation A • 4,038 sq.ft. Elevation B • 4,038 sq.ft.

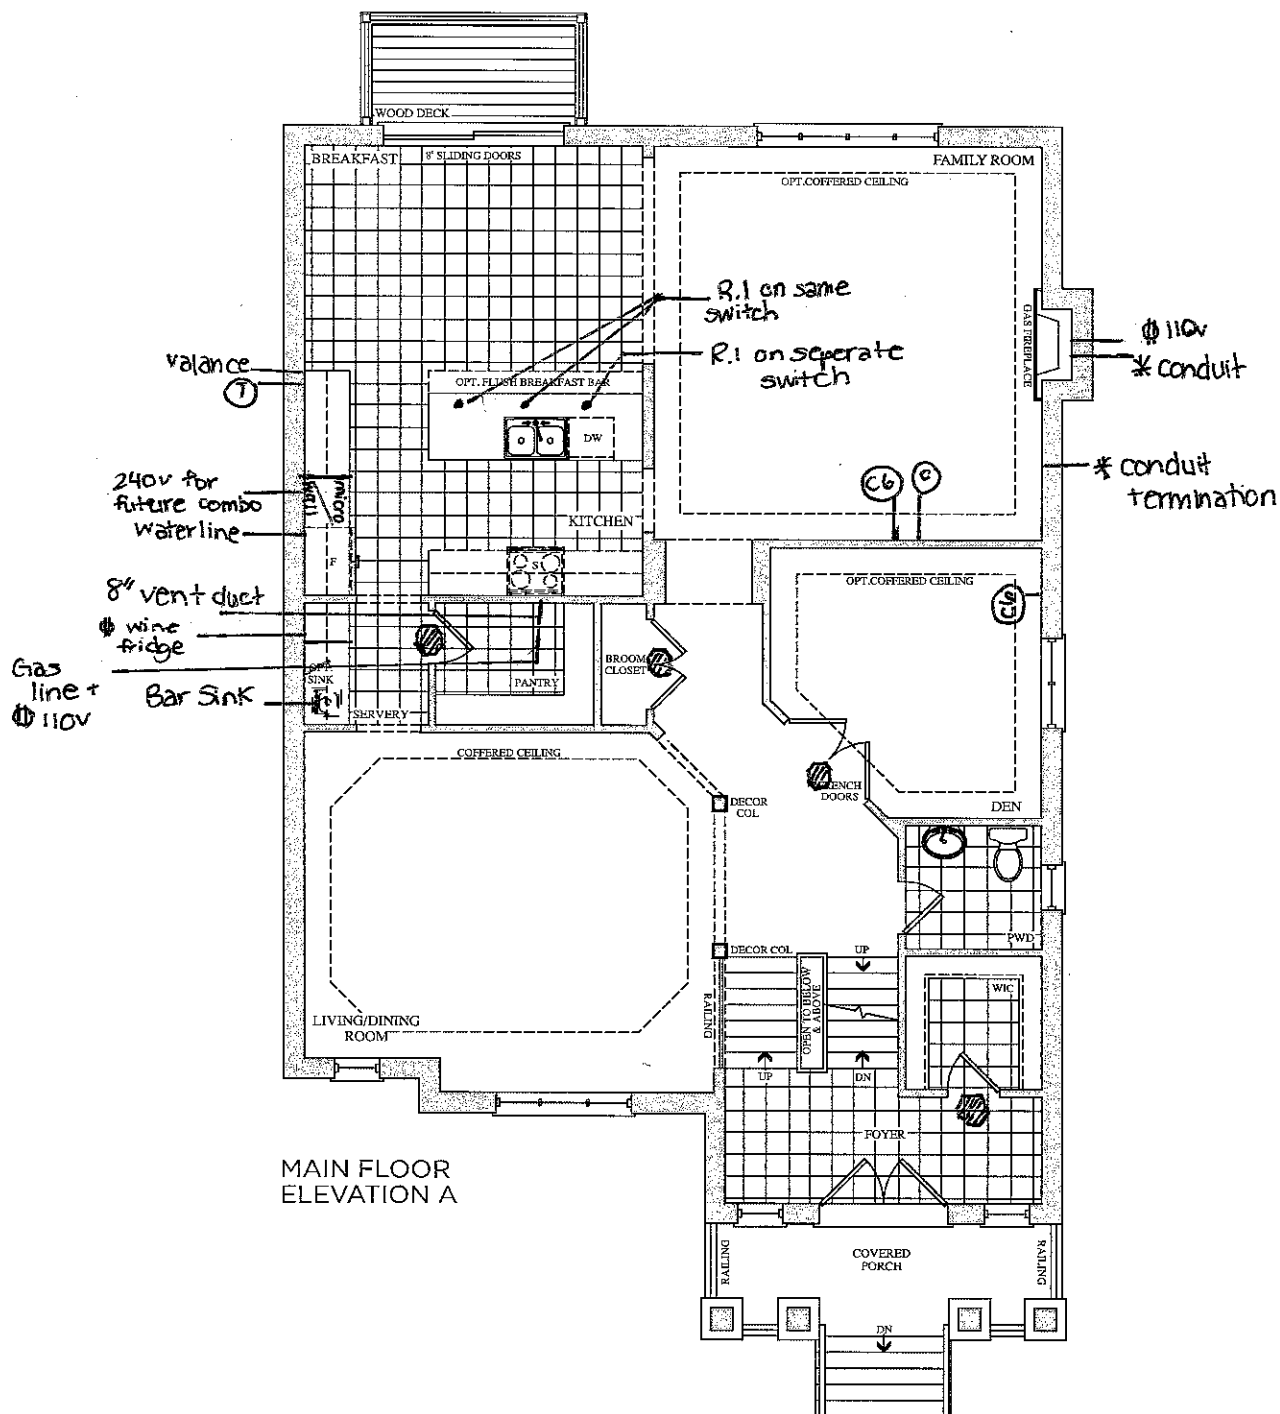

- ⊗ - 96" taller doors
- Ⓢ - Cat 6
- Ⓢ - cable
- Ⓢ - telephone
- ⊕ - 110v

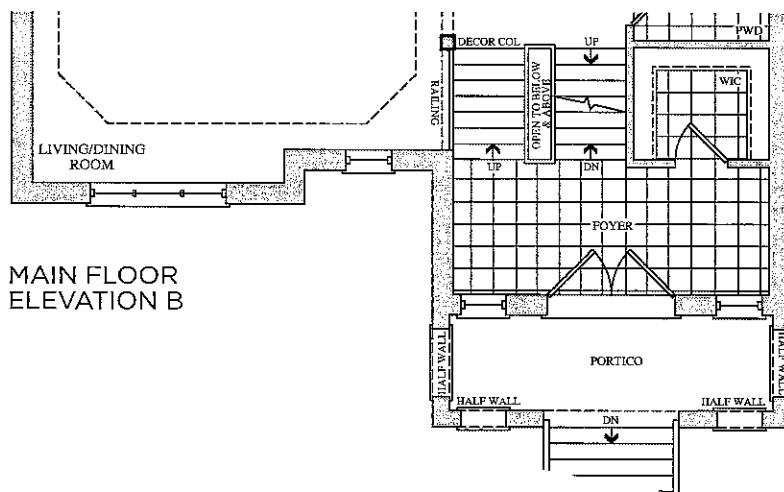


Prices, figures, illustrations, sizes, features and finishes are subject to change without notice. E.&O.E. Areas and dimensions are approximate and actual usable floor space may vary from the stated area. Layout may be reverse of the unit purchased. E. & O.E.


GOLDPARK
HOMES

The
Brahms
41' SERIES


Elevation A • 4,038 sq.ft. Elevation B • 4,038 sq.ft.

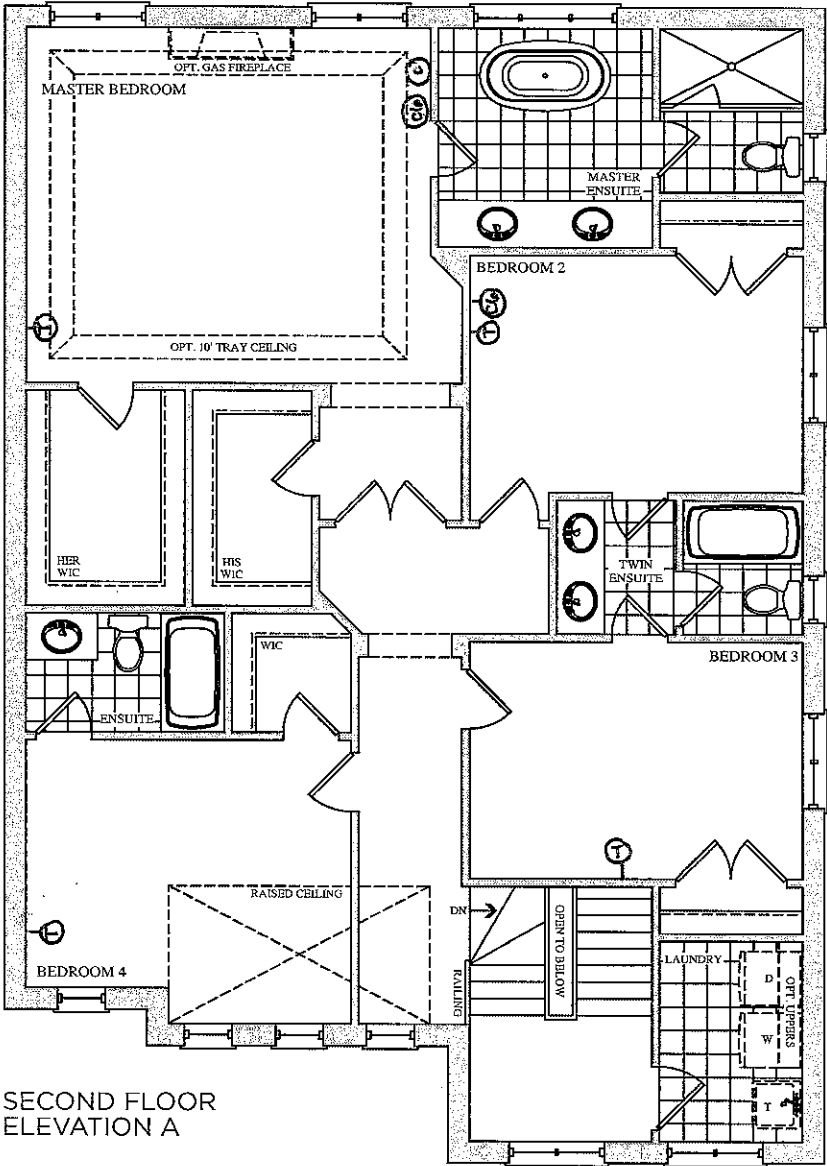

SECOND FLOOR
ELEVATION A

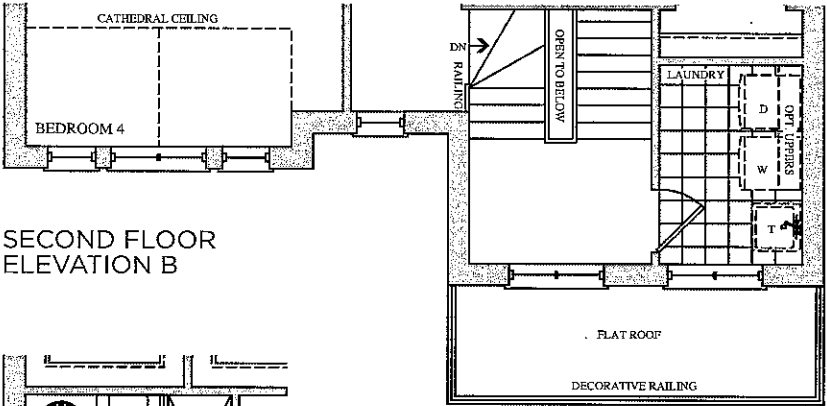

SECOND FLOOR
ELEVATION B

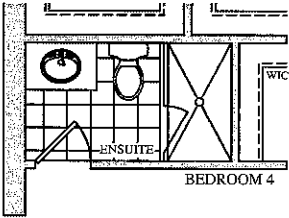


SECOND FLOOR
ELEVATION A & B
OPT. ENSUITE

Prices, figures, illustrations, sizes, features and finishes are subject to change without notice. E.&O.E. Areas and dimensions are approximate and actual usable floor space may vary from the stated area. Layout may be reverse of the unit purchased. E. & O.E.



The
Brahms
41' SERIES

Elevation A • 4,038 sq.ft. | Elevation B • 4,038 sq.ft.

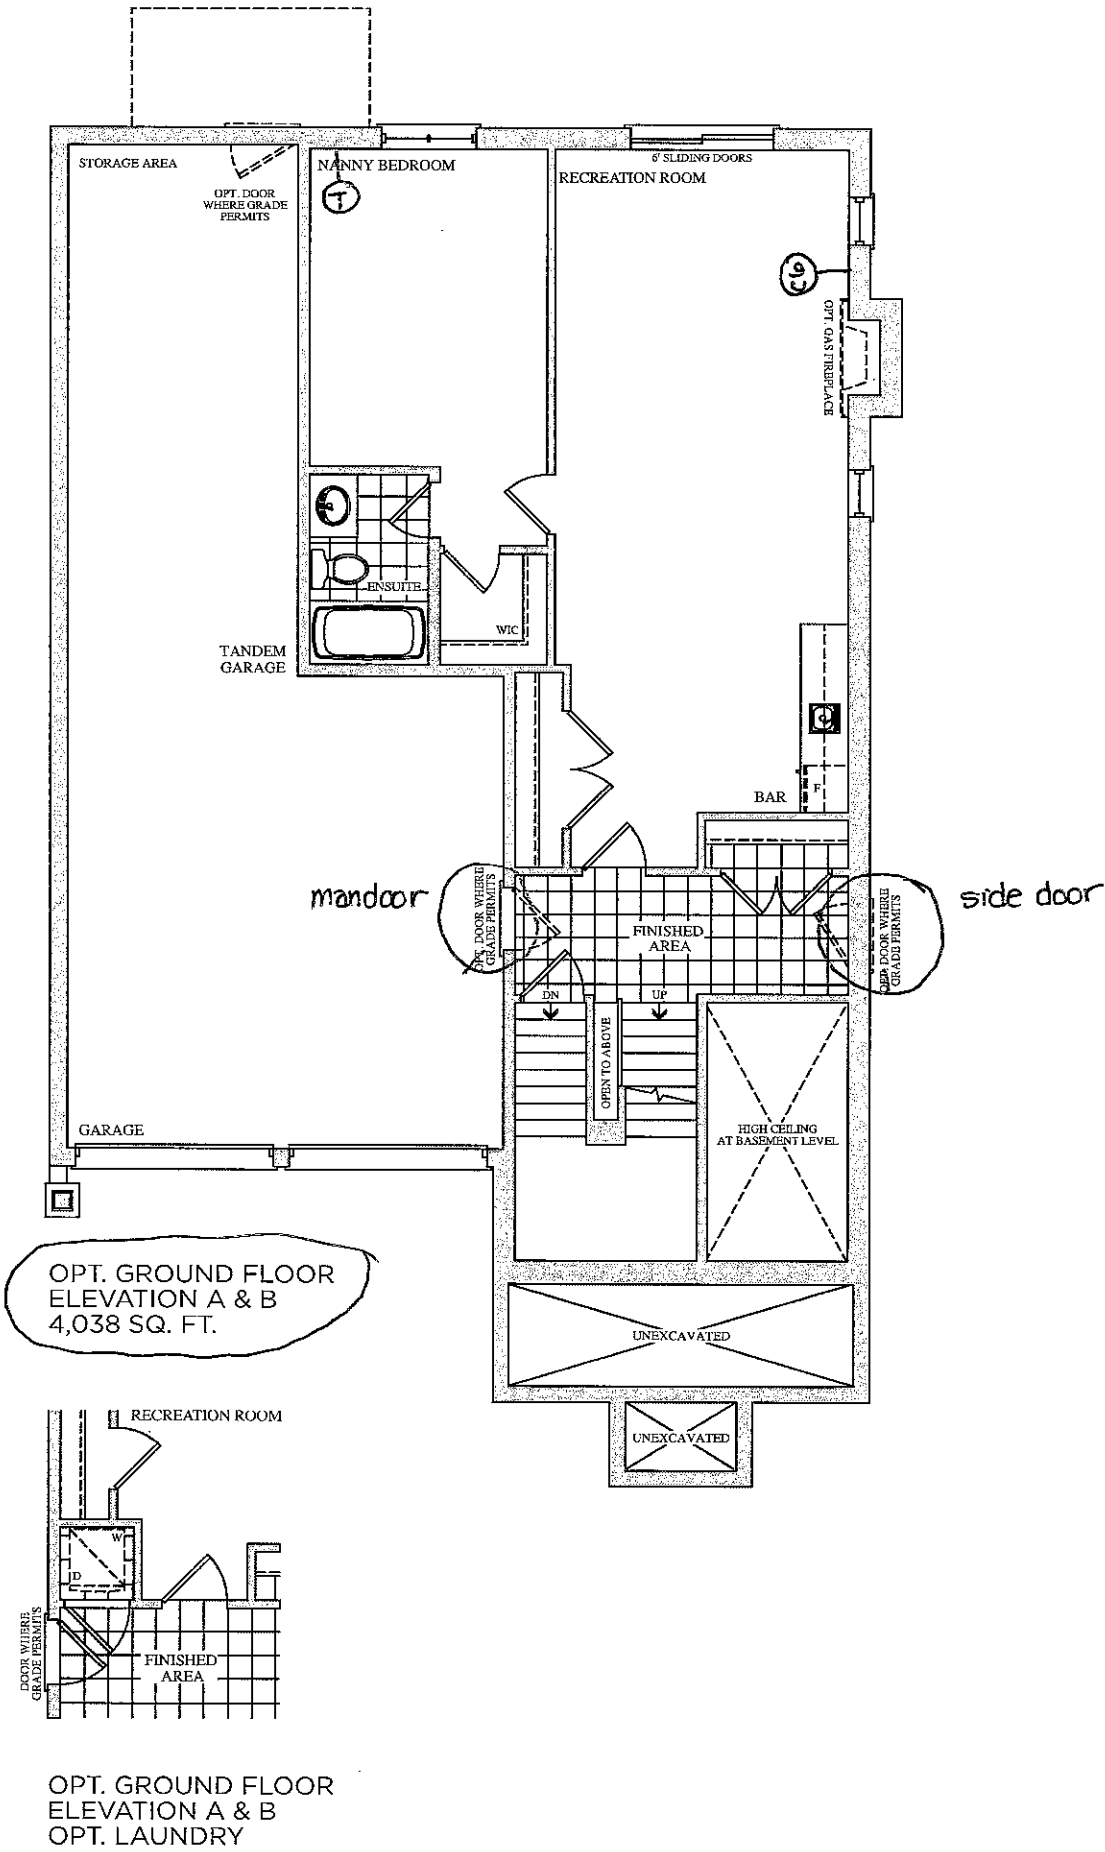

The
Brahms
41' SERIES

Elevation A • 4,038 sq.ft. | Elevation B • 4,038 sq.ft.

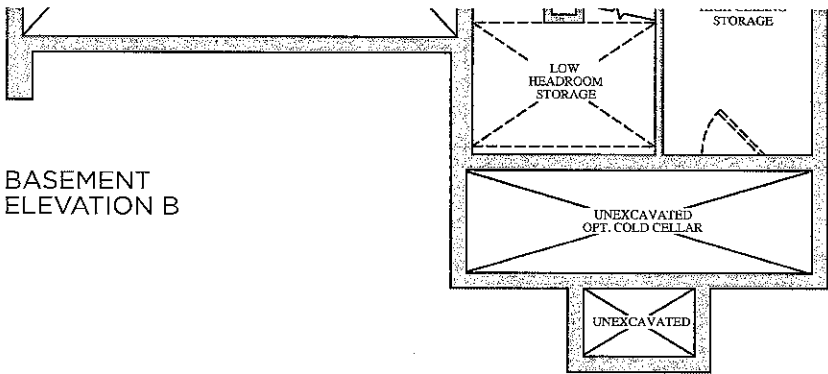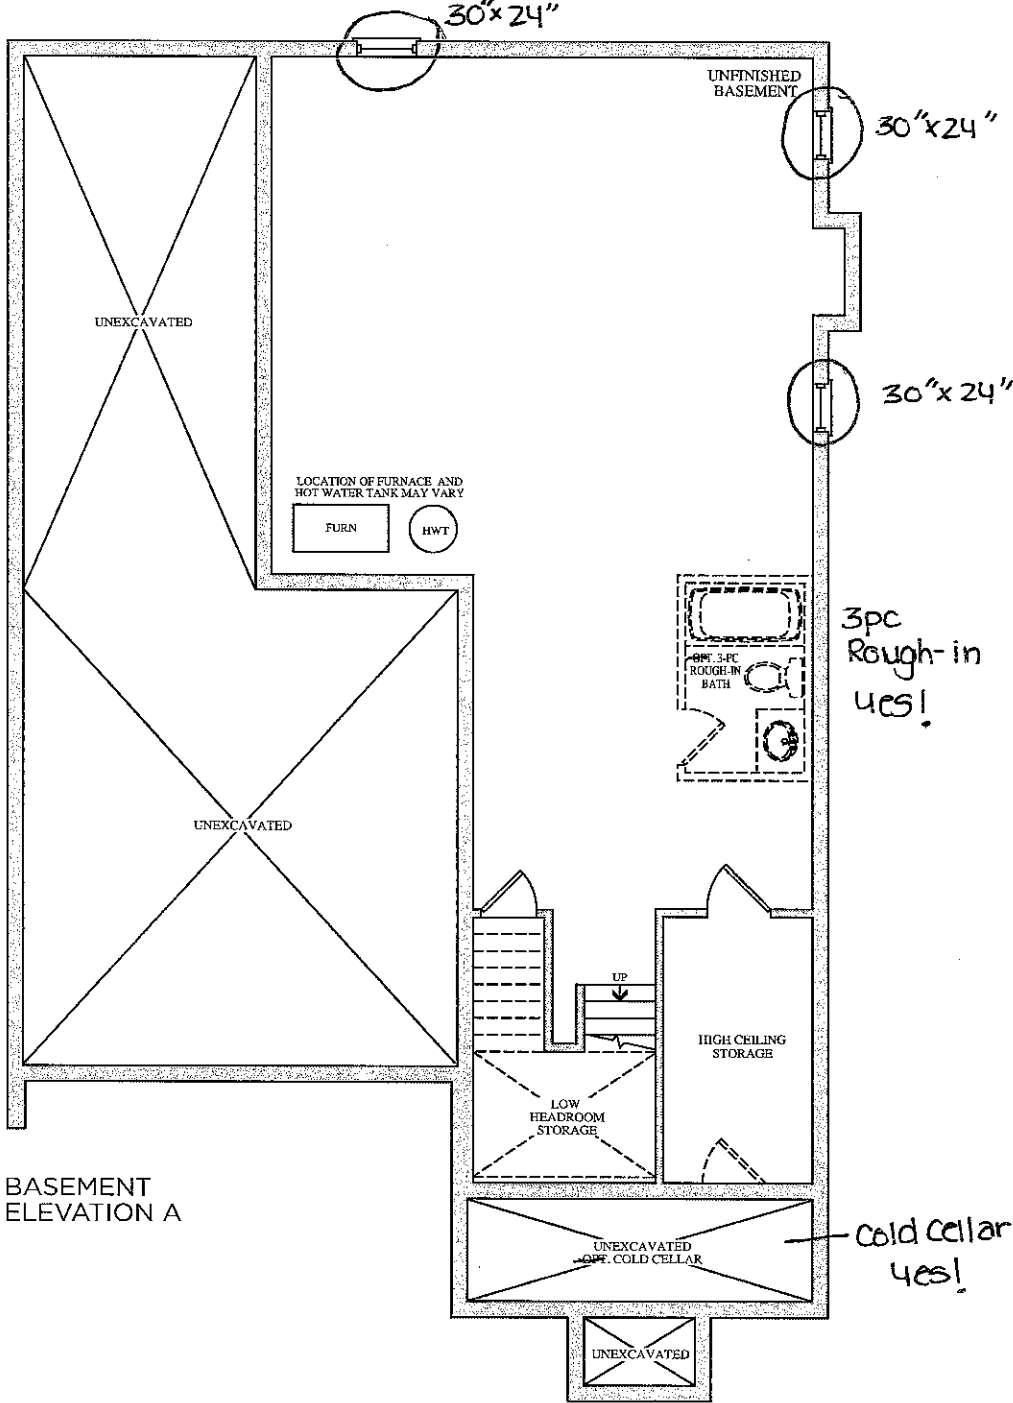

Prices, figures, illustrations, sizes, features and finishes are subject to change without notice. E.&O.E. Areas and dimensions are approximate and actual usable floor space may vary from the stated area. Layout may be reverse of the unit purchased. E. & O.E.