

Kleinburg Glen - 3 - 2 - 42-5 Elev.A MADISON

CENTRAL VAC AND WIRING

Inv.1,240	1 - GREAT ROOM: CONDUIT PIPE - FOR TELEVISION - Locate approx 66" A.F.F. above fireplace, terminating by cable. See plan for location.
Line18854	Note:
13Mar17 / 31Aug17	
Inv.1,240	1 - GREAT ROOM / DEN / MASTER BEDROOM / BEDROOM 2: ROUGH IN- 4X- CAT 6 CONNECTIONS- see plan for location.
Line18856	Note:
13Mar17 / 31Aug17	
Inv.1,240	2 - MUD ROOM & UPPER HALL: ROUGH - IN FOR EXTRA SECURITY KEY PAD
Line18857	Note:
13Mar17 / 31Aug17	

CERAMIC

Inv.1,241	1 - FOYER FLOOR TILE: Upgrade 5 - 24x24" polished - laid in straight, stacked pattern.
Line18886	Note:
13Mar17 / 31Aug17	
Inv.1,241	1 - POWDER ROOM FLOOR TILE: Upgrade 5 - 24x24" polished - laid in straight, stacked pattern.
Line18887	Note:
13Mar17 / 31Aug17	
Inv.1,241	1 - KITCHEN FLOOR TILE: Upgrade 5 - 24x24" polished - laid in straight, stacked pattern.
Line18888	Note:
13Mar17 / 31Aug17	

DRYWALL

Inv.1,240	1 - 2ND FLOOR: SMOOTH CEILINGS - (2 - Story Design) 2ND FLOOR
Line18858	Note:
13Mar17 / 31Aug17	
Inv.1,240	1 - MAIN FLOOR CEILING 10FT, 8FT TALLER INTERIOR DOORS, TALLER FLAT ARCHES, REAR AND FRONT WINDOWS WITH TRANSOM, TALLER KITCHEN CABINETS WITH CROWN AND FURRING PANEL, ADDED STAIRS AND PICKETS
Line24048	Note:
13Mar17 / 31Aug17	

ELECTRICAL

Inv.1,240	1 - GREAT ROOM: Additional Interior Receptacle (not separate circuit). Locate approx. 66" A.F.F. above fireplace for tv
Line18855	Note:
13Mar17 / 31Aug17	
Inv.1,240	1 - 200 AMP Service
Line18859	Note:
13Mar17 / 31Aug17	
Inv.1,240	1 - KITCHEN: Move standard ceiling light to above island. See plan for location.
Line18865	Note:
13Mar17 / 31Aug17	
Inv.1,240	2 - KITCHEN: Rough in light on existing switch- Capped (doesn't include fixture)Locate above island, use same switch as standard.
Line18863	Note:
13Mar17 / 31Aug17	

Kleinburg Glen - 3 - 2 - 42-5 Elev.A MADISON

Inv.1,240	1 - LIVING ROOM: Rough in light on separate switch- Capped (doesn't include fixture)
Line18864	Note:
13Mar17 / 31Aug17	
Inv.1,240	1 - KITCHEN: 240V Wall Recepticle on dedicated circuit - For future wall ovens
Line18874	Note:
13Mar17 / 31Aug17	
Inv.1,240	1 - KITCHEN: Additional Separate Circuit Receptacle for future warming drawer
Line18875	Note:
13Mar17 / 31Aug17	
Inv.1,240	1 - KITCHEN: 50 AMP Circuit for future wall ovens
Line18876	Note:
13Mar17 / 31Aug17	
Inv.1,240	1 - KITCHEN: Electrical is changed for *future* appliances, homeowner has declined upgraded cabinetry to match electrical. Electrical will be accessible thru standard cabinetry. Homeowner to replace kitchen at own cost and warranty after closing.
Line18877	Note:
13Mar17 / 31Aug17	
Inv.1,240	1 - KITCHEN: Relocate appliance- See floorplan for new location - REVERSE LOCATION OF FRIDGE AND PANTRY (future ovens)
Line18885	Note:
13Mar17 / 31Aug17	
Inv.1,240	1 - KITCHEN: GAS LINE ROUGH - 2ND FLOOR - (2 - STOREY MODELS) for future gas range with 110v plug
Line24052	Note:
13Mar17 / 31Aug17	

Exterior Colours

Inv.1,240	1 - EXTERIOR COLOUR PACKAGE #10
Line24054	Note:
13Mar17 / 31Aug17	

FRAMING

Inv.1,240	1 - MAIN FLOOR CEILING 10FT, 8FT TALLER INTERIOR DOORS, TALLER FLAT ARCHES, REAR AND FRONT WINDOWS WITH TRANSOM, TALLER KITCHEN CABINETS WITH CROWN AND FURRING PANEL, ADDED STAIRS AND PICKETS
Line18866	Note:
13Mar17 / 31Aug17	
Inv.1,240	1 - ENSUITE 2: UPGRADE TO **FRAMELESS** GLASS SHOWER ENCLOSURE
Line18867	Note:
13Mar17 / 31Aug17	
Inv.1,240	1 - FRAMING NOTE: 96" doors and arches thru out
Line18881	Note:
13Mar17 / 31Aug17	
Inv.1,241	1 - MANDOOR FROM GARAGE TO HOUSE- GRADE PERMITS
Line24056	Note:
13Mar17 / 31Aug17	

GLASS AND MIRROR

Kleinburg Glen - 3 - 2 - 42-5 Elev.A MADISON

Inv.1,240	1 - MASTER ENSUITE: CONVERT FRAMED SHOWER TO 10MM FRAMLESS SHOWER ENCLOSURE WITH DOOR AND 10MM SIDE PANEL
Line18868	Note:
13Mar17 / 31Aug17	

HARDWOOD

Inv.1,241	1 - GREAT ROOM / LIVING/ DINING / DEN / MAIN HALL: Upgrade 3 hardwood - Vintage Red Oak smooth 3/4 x 4-3/8"
Line18889	Note:
13Mar17 / 31Aug17	

Inv.1,241	1 - UPPER HALL: Upgrade 3 hardwood - Vintage Red Oak smooth 3/4 x 4-3/8"
Line18890	Note:
13Mar17 / 31Aug17	

HVAC

Inv.1,240	1 - 4.0 TON AIR CONDITIONER
Line18871	Note:
13Mar17 / 31Aug17	

Inv.1,240	1 - HUMIDIFIER: WB3 - 17 (UP TO 3,000 SQ.FT.)
Line18872	Note:
13Mar17 / 31Aug17	

Inv.1,240	1 - KITCHEN: GAS LINE ROUGH - 2ND FLOOR - (2 - STOREY MODELS) for future gas range with 110v plug
Line18873	Note:
13Mar17 / 31Aug17	

INTERIOR TRIM AND DOORS

Inv.1,240	1 - EXTENDED HEIGHT ARCHWAY (PRICE PER DOORWAY) - INCLUDE FRAMING NOTE
Line18878	Note:
13Mar17 / 31Aug17	

Inv.1,240	19 - 2ND FLOOR: STANDARD DOOR EXTENDED HEIGHT 96 INCH (PRICE PER DOOR) - SECOND FLOOR 2 STOREY MODELS
Line18879	Note:
13Mar17 / 31Aug17	

Inv.1,240	3 - 2ND FLOOR: EXTENDED HEIGHT ARCHWAY (PRICE PER DOORWAY) - 96"
Line18880	Note:
13Mar17 / 31Aug17	

Inv.1,240	1 - MAIN FLOOR CEILING 10FT, 8FT TALLER INTERIOR DOORS, TALLER FLAT ARCHES, REAR AND FRONT WINDOWS WITH TRANSOM, TALLER KITCHEN CABINETS WITH CROWN AND FURRING PANEL, ADDED STAIRS AND PICKETS
Line24047	Note:
13Mar17 / 31Aug17	

Inv.1,241	1 - MAIN FLOOR & 2ND FLOOR: Upgrade trim package 1
Line18893	Note:
13Mar17 / 31Aug17	

KITCHEN AND BATH CABINETRY

Kleinburg Glen - 3 - 2 - 42-5 Elev.A MADISON

Inv.1,240	1 - MAIN FLOOR CEILING 10FT, 8FT TALLER INTERIOR DOORS, TALLER FLAT ARCHES, REAR AND FRONT WINDOWS WITH TRANSOM, TALLER KITCHEN CABINETS WITH CROWN AND FURRING PANEL, ADDED STAIRS AND PICKETS
Line24049	Note:
13Mar17 / 31Aug17	
Inv.1,240	1 - KITCHEN: Electrical is changed for *future* appliances, homeowner has declined upgraded cabinetry to match electrical. Electrical will be accessible thru standard cabinetry. Homeowner to replace kitchen at own cost and warranty after closing.
Line24053	Note:
13Mar17 / 31Aug17	

MISC.

Inv.1,240	1 - Purchaser has attended an appointment at the Decor Centre & has DECLINED any additional upgrades and accepts and acknowledges that there will be no further changes/additions/deletions to be made upon signing on March 13 2017.
Line18882	Note:
13Mar17 / 31Aug17	
Inv.1,240	1 - Purchasers are aware & accepts that ANY changes made to upgrades after signing this Purchasers Extra Form are subject to a minimum administration fee of \$500. PLUS a 10% holdback fee.
Line18883	Note:
13Mar17 / 31Aug17	
Inv.1,240	1 - BONUS PACKAGE: \$20,000.00 (INCLUDING TAXES) WORTH OF UPGRADES FROM GOLD PARK HOMES DÉCOR CENTRE IS BEING APPLIED TOWARD THE STRUCTURAL APPOINTMENT. PURCHASER HAS A REMAINING AMOUNT OF \$00 (INCLUDING TAXES) TO BE USED TOWARD THE COLOUR APPOINTMENT.
Line18884	Note:
13Mar17 / 31Aug17	
Inv.1,241	1 - Purchaser has attended an appointment at the Decor Centre & has DECLINED any additional upgrades and accepts and acknowledges that there will be no further changes/additions/deletions to be made upon signing on March 13 2017.
Line18896	Note:
13Mar17 / 31Aug17	
Inv.1,241	1 - Purchasers are aware & accepts that ANY changes made to upgrades after signing this Purchasers Extra Form are subject to a minimum administration fee of \$500. PLUS a 10% holdback fee.
Line18897	Note:
13Mar17 / 31Aug17	
Inv.1,241	1 - Purchaser Accepts Standard Appliance Openings: Fridge - 37-1/2"W x 73-1/2" High Approx. Range - 30-1/2"D x 31-1/2"W Approx. Dishwasher - 24" W Approx.
Line18898	Note:
13Mar17 / 31Aug17	

PAINTING

Inv.1,240	1 - MAIN FLOOR CEILING 10FT, 8FT TALLER INTERIOR DOORS, TALLER FLAT ARCHES, REAR AND FRONT WINDOWS WITH TRANSOM, TALLER KITCHEN CABINETS WITH CROWN AND FURRING PANEL, ADDED STAIRS AND PICKETS
Line24050	Note:
13Mar17 / 31Aug17	
Inv.1,241	1 - MAIN STAIRS: Stain stairs to match hardwood, as close as possible.
Line18895	Note:
13Mar17 / 31Aug17	

PLUMBING FIXTURES



CONSTRUCTION SUMMARY

Kleinburg Glen - 3 - 2 - 42-5 Elev.A MADISON

Inv.1,241	1 - MASTER ENSUITE: Delta Arzo 3-Function shower system (rainshower from wall, not ceiling) chrome #T17T267/50570/T11867/R1100/R10000-UNBXHF
Line18891	Note:
13Mar17 / 31Aug17	

Inv.1,241	1 - MASTER ENSUITE: DELTA Arzo 4-piece roman tub filler chrome #T4786/R4716
Line18892	Note:
13Mar17 / 31Aug17	

STAIRS AND RAILINGS

Inv.1,241	1 - MAIN STAIRS: R6 railing + V Groove
Line18894	Note:
13Mar17 / 31Aug17	

WINDOWS AND DOORS

Inv.1,240	1 - MAIN FLOOR CEILING 10FT, 8FT TALLER INTERIOR DOORS, TALLER FLAT ARCHES, REAR AND FRONT WINDOWS WITH TRANSOM, TALLER KITCHEN CABINETS WITH CROWN AND FURRING PANEL, ADDED STAIRS AND PICKETS
Line24051	Note:
13Mar17 / 31Aug17	

Inv.1,241	1 - MANDOOR FROM GARAGE TO INTERIOR- GRADE PERMITS
Line24055	Note:
13Mar17 / 31Aug17	

Scheduled Closing Date:

Purchaser: Yanhong Wang

Property: 3

Telephone Res. / Bus: (647) 830-1999

Project: Berkshire Holdings Inc.

Decor Advisor: Yolande Somerville

Model and Elevation: 42-5 Elev.A MADISON

Layout Changes: ☐ Yes ☒ No Sketch Attached: ☒ Yes ☐ No Exterior Colour Scheme:

1. Cabinetry

	Style and Colour	Counter	Hardware
Kitchen / Breakfast	varese pvc 'white crystal'	Granite: Grigio Sardo Edge: FE-20	cs1-23
Laundry Room	n/a		n/a
Powder Room	varese pvc 'white crystal'	P-Lam #P-344-LM 'Inukshuk Grey'	cs1-23
Mud Room	varese pvc 'white crystal'	P-Lam #P-344-LM 'Inukshuk Grey'	cs1-23
Master Ensuite Bathroom	varese pvc 'white crystal'	P-Lam #P-344-LM 'Inukshuk Grey'	cs1-23
Second Ensuite Bathroom (If Applicable)	varese pvc 'white crystal'	P-Lam #P-344-LM 'Inukshuk Grey'	cs1-23
Twin 3/4	varese pvc 'white crystal'	P-Lam #P-344-LM 'Inukshuk Grey'	cs1-23
Dishwasher Cabinet	n/a		

Comment

2. Floor Tile

	Selection	Grout	Threshold
Entrance Vestibule	*24x24" Arya pol 'white/grey' upg 5	n/a	n/a
Main Hall	n/a	n/a	n/a
Kitchen / Breakfast	*24x24" Arya pol 'white/grey' upg 5	n/a	n/a
Laundry Room	13x13" Serpentine 'Beyaz-white'	n/a	n/a
Powder Room	*24x24" Arya pol 'white/grey' upg 5	n/a	n/a
Twin 3/4	13x13" Serpentine 'Beyaz-white'	n/a	n/a
Master Ensuite Bathroom	13x13" Serpentine 'Beyaz-white'	n/a	n/a
Second Ensuite Bathroom (If Applicable)	13x13" Serpentine 'Beyaz-white'	n/a	n/a
Lower Landing (If Applicable)	*24x24" Arya pol 'white/grey' (by powder rm) upg 5	n/a	n/a
n/a	n/a	n/a	n/a

Comment

Grout lines as small as possible!

3. Wall Tile

	Selection	Listello/Inserts	Describe
	n/	<input type="radio"/> Yes <input checked="" type="radio"/> No	
Master Ensuite Bathroom			
Tub Deck	n/a	<input type="radio"/> Yes <input checked="" type="radio"/> No	
Shower Stall	8x10" Weave 'White'	<input type="radio"/> Yes <input checked="" type="radio"/> No	
Bathroom Walls	n/a	<input type="radio"/> Yes <input checked="" type="radio"/> No	
Second Ensuite Bathroom (If Applicable)	8x10" Serpentine 'Beyaz-white'	<input type="radio"/> Yes <input checked="" type="radio"/> No	
Twin 3/4	8x10" Serpentine 'Beyaz-white'	<input type="radio"/> Yes <input checked="" type="radio"/> No	

Kitchen Backsplash ☐ Yes ☒ No

Backsplash Behind Fridge n/a

Comment

Purchaser: Yanhong Wang
Telephone Res. / Bus: (647) 830-1999
Decor Advisor: Yolande Somerville

Scheduled Closing Date:
Property: 3
Project: Burkshire Holdings Inc.
Model and Elevation: 42-5 Elev.A MADISON

4. Plumbing Fixtures

Second Ensuite

Powder Room

Master Ensuite Bathroom

Other Room - Specify

Other Washroom

Comment

Standard Thru Out, except Master Ensuite

5. Hardwood Flooring

	Type and Stain		Type and Stain
Main Hall	*Vintage Red Oak 'Eclipse'	Upper Landing	n/a
Kitchen / Breakfast	n/a	Upper Hall	*Vintage Red Oak 'Eclipse'
Living Room	*Vintage Red Oak 'Eclipse'	Master Bedroom	n/a
Dining Room	*Vintage Red Oak 'Eclipse'	Bedroom #2	n/a
Family Room	*Vintage Red Oak 'Eclipse'	Bedroom #3	n/a
Den/Library	*Vintage Red Oak 'Eclipse'	Bedroom #4	n/a
Entrance Vestibule	n/a	Bedroom #5	n/a
Lower Landing (If Applicable)	n/a	Other Room - Specify	n/a
			n/a

Comment

Hardwood Selection: Vintage 3/4 x 4-3/8" Red Oak (smooth) 'Eclipse'

6. Carpeting

	Upgrade	Description
Main Hall	<input type="checkbox"/>	n/a
Living Room	<input type="checkbox"/>	n/a
Dining Room	<input type="checkbox"/>	n/a
Family Room	<input type="checkbox"/>	n/a
Den/Library	<input type="checkbox"/>	n/a
Upper Hall	<input type="checkbox"/>	n/a
Master Bedroom	<input type="checkbox"/>	T-04
Bedroom #2	<input type="checkbox"/>	T-04
Bedroom #3	<input type="checkbox"/>	T-04
Bedroom #4	<input type="checkbox"/>	T-04
Bedroom #5	<input type="checkbox"/>	n/a
<input type="text"/>	<input type="checkbox"/>	n/a
Upper Landing (If Applicable)	<input type="checkbox"/>	n/a
Lower Landing (If Applicable)	<input type="checkbox"/>	n/a

Upgrade Underpad	Type none	Area n/a
Carpet on Stairs	Capped n/a	Runner - *Upgrade n/a

Comment

standard carpet and underpad in bedrooms

VW

Scheduled Closing Date:

Purchaser: Yanhong Wang
Telephone Res. / Bus: (647) 830-1999
Decor Advisor: Yolande Somerville

Property: 3
Project: Burkshire Holdings Inc.
Model and Elevation: 42-5 Elev.A MADISON

7. Fireplace

	Living Room			Family Room			Other Room - Specify		
	Purchased	As Per Plan	N/A	Purchased	As Per Plan	N/A	Purchased	As Per Plan	N/A
	<input type="radio"/>	<input type="radio"/>	<input checked="" type="radio"/>	<input type="radio"/>	<input checked="" type="radio"/>	<input type="radio"/>	<input type="radio"/>	<input type="radio"/>	<input checked="" type="radio"/>
Fireplace Type				Standard Gas					
Mantle Type				Standard Mediterranean					
Colour / Stain				Standard					
Surround				none					
Hearth				none					
Comment									

8. Trim Carpentry

Interior Doors	**Standard	Front Door Glass Inserts	standard	Door Handles	standard
Interior Trim	*Upgrade 1 package				
Comment	**Standard profile, but 96" thru out				

9. Plaster Mouldings and Medallions

Entrance Vestibule			Kitchen/Breakfast		
Main Hall			Den/Library		
Living Room			Lower Landing		
Dining Room			Other Room - Specify	none	
Family Room			Thru Out		
Comment					

10. Railings and Spindles

Railing Package	*R6 + V Groove		
Railing Colour	*Eclipse	Spindle Colour	*Black
Stringer / Riser	*Eclipse	Treads	*Eclipse
Comment	Oak Stairs <input checked="" type="radio"/> Yes <input type="radio"/> No		

11. Wall Paint

Main & Upper Hall		Master Bedroom	
Living Room		Bedroom #2	
Dining Room		Bedroom #3	
Kitchen / Breakfast		Bedroom #4	
Family Room		Bedroom #5	
Powder Room		Master Ensuite	
Laundry Room			
Den/Library		Second Ensuite	
Trim Paint		Thru Out	Warm Grey
Comment	Smooth Ceilings First Floor		



Scheduled Closing Date:

Purchaser: Yanhong Wang

Property: 3

Telephone Res. / Bus: (647) 830-1999

Project: Burkshire Holdings Inc.

Decor Advisor: Yolande Somerville

Model and Elevation: 42-5 Elev.A MADISON

12. Electrical

Plugs and Switches ☒ White ☐ Ivory

Above Kitchen Cabinet Light ☐ Yes ☒ No

Hood Fan ☐ White ☐ Ivory

Below Kitchen Cabinet Light ☐ Yes ☒ No

Appliances Built in Cooktop

Built in Oven

Gas Stove

Microwave

☐ Yes ☒ No

☐ Yes ☒ No

☒ Yes ☐ No

☐ Yes ☒ No

Comment

Electrical will not match cabinetry - homeowner to replace kitchen after close as own expense and warranty.

13. Heating and Air Conditioning

Air Conditioning

Gas Provisions Stove

Gas Provisions Dryer

Gas Provisions Barbecue

Comment

Standard Gas BBQ Line

14. Additional Comments

15. Disclaimers and Notes

- 1) Colours of all materials are as close as possible to builder's selection, but not necessarily identical due to variances in manufacturing.
- 2) Any extras listed above are null and void unless accompanied by a separate invoice/amendment. Said invoice must be paid in full.
- 3) The Purchaser acknowledges that after Interior Colour Selection form is signed and dated, no further changes will be permitted other than re-selection due to unavailability. _____ Purchaser's Initials
- 4) The Purchaser acknowledges reading and accepting the "Gold Park Homes Decor Centre Disclaimers" form. This document contains other miscellaneous disclaimers.

This Interior Colour Selection is final and approved by:

Signature:  Date: _____

Elevation A • 3,622 sq.ft.

Elevation B • 3,623 sq.ft.

KG2-3

MARCH 13 2017




Gasline +
110V Ⓢ


FUTURE
OVERS/WHEELING
DEALER

MOVE FRIDGE
to here

~ 10' main
Floor pkg

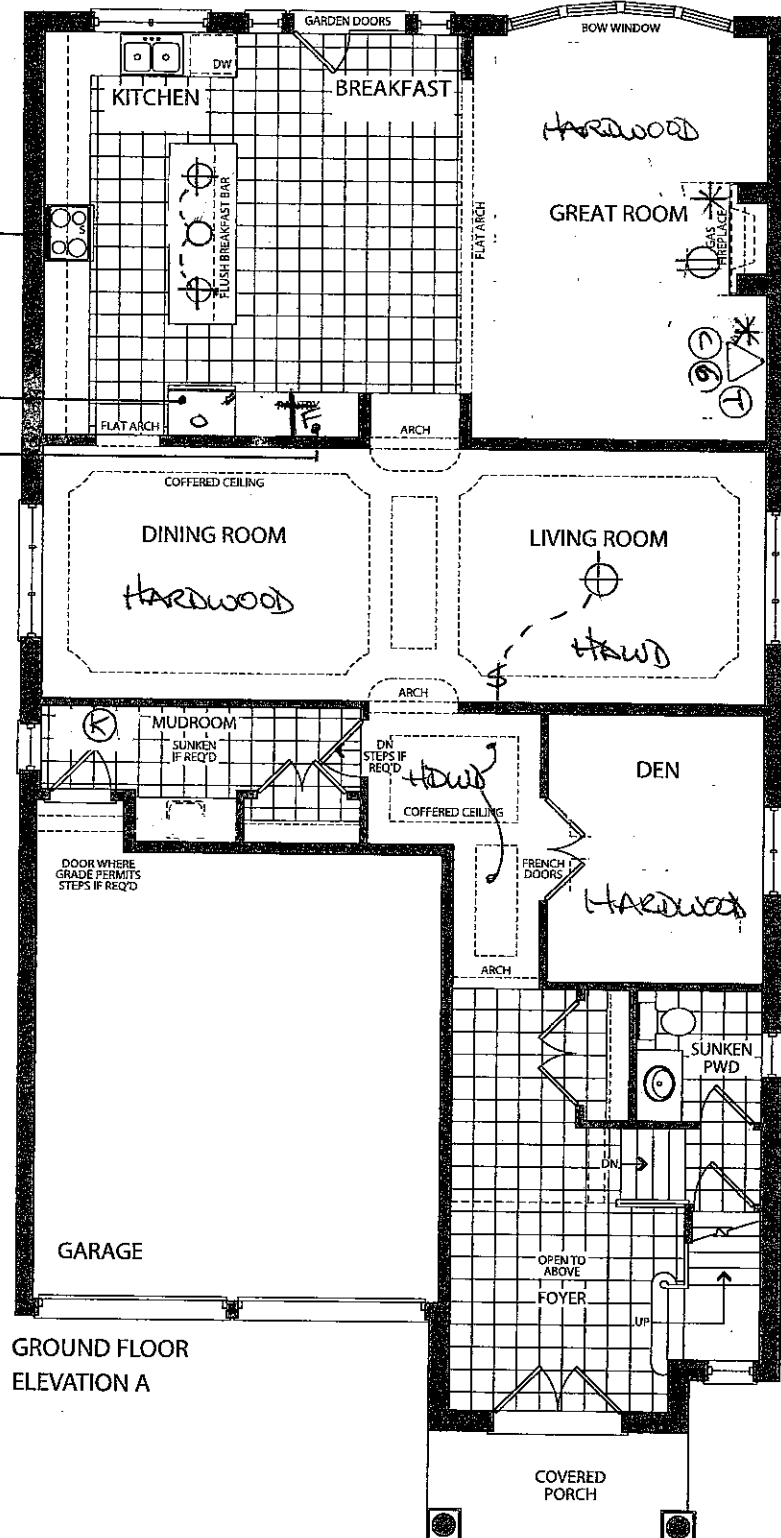

GROUND FLOOR
ELEVATION A


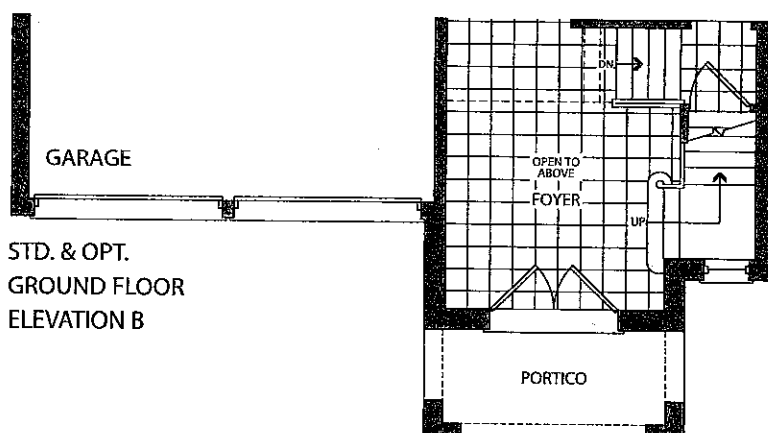


STD. & OPT.
GROUND FLOOR
ELEVATION B



• smooth ceiling

* TALLER
DOORS +
ARCHES!

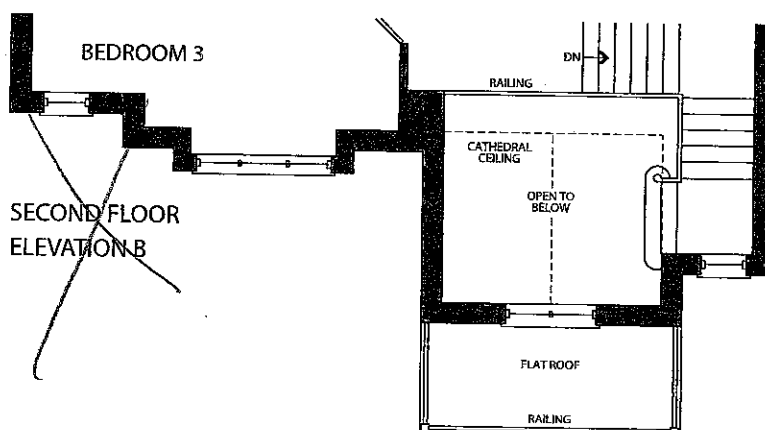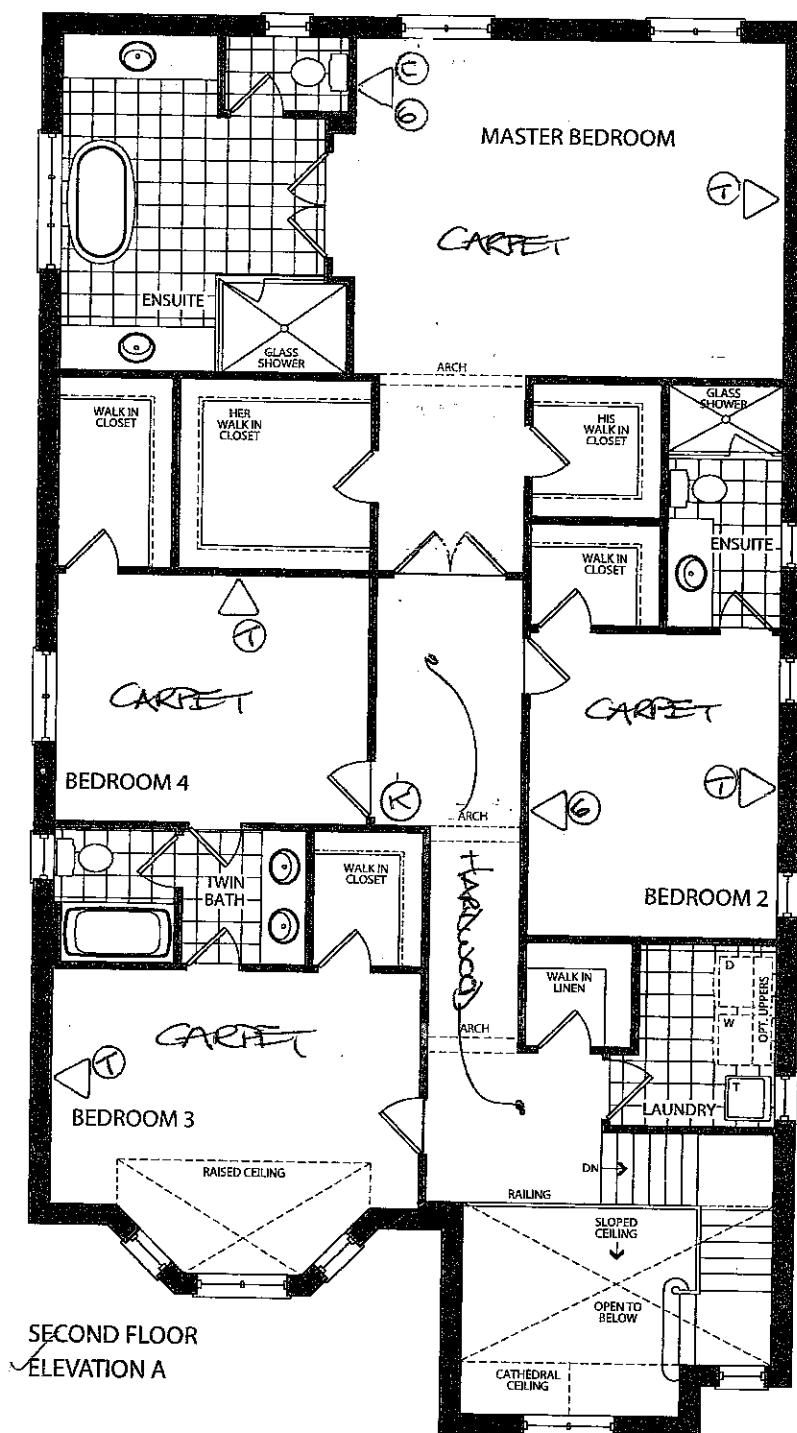

KG2-3


MARCH 13 2017



the Madison


Elevation A • 3,622 sq.ft.

~~Elevation B • 3,623 sq.ft.~~

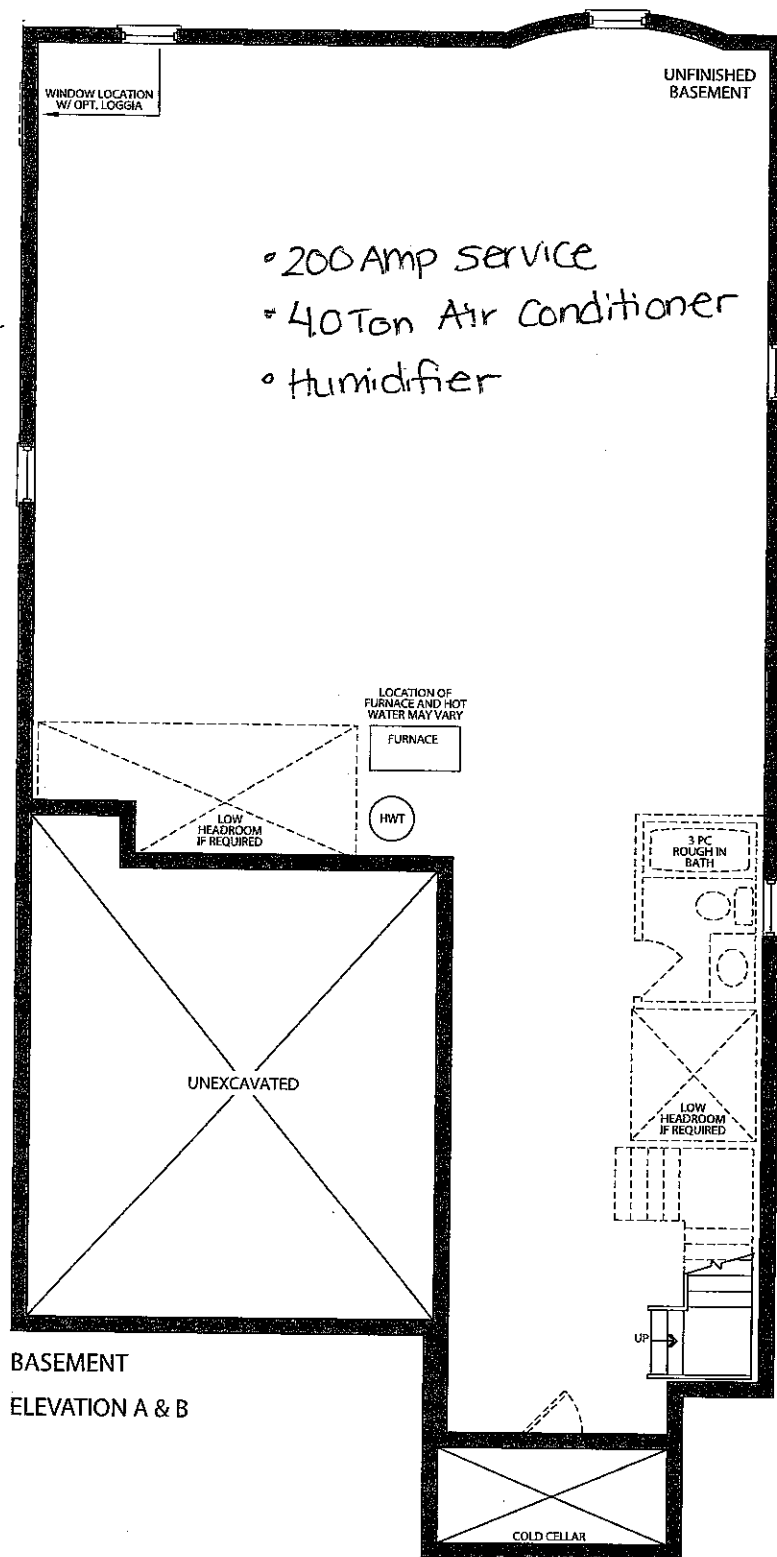


Trade Name: Gold Park Homes	Site location: Kleinburg	Model: 42-5
Address:	Project: Kleinburg Glen	Phase:

This layout has been explained to the purchaser by Cortina Kitchens Inc. and is understood by the purchaser.

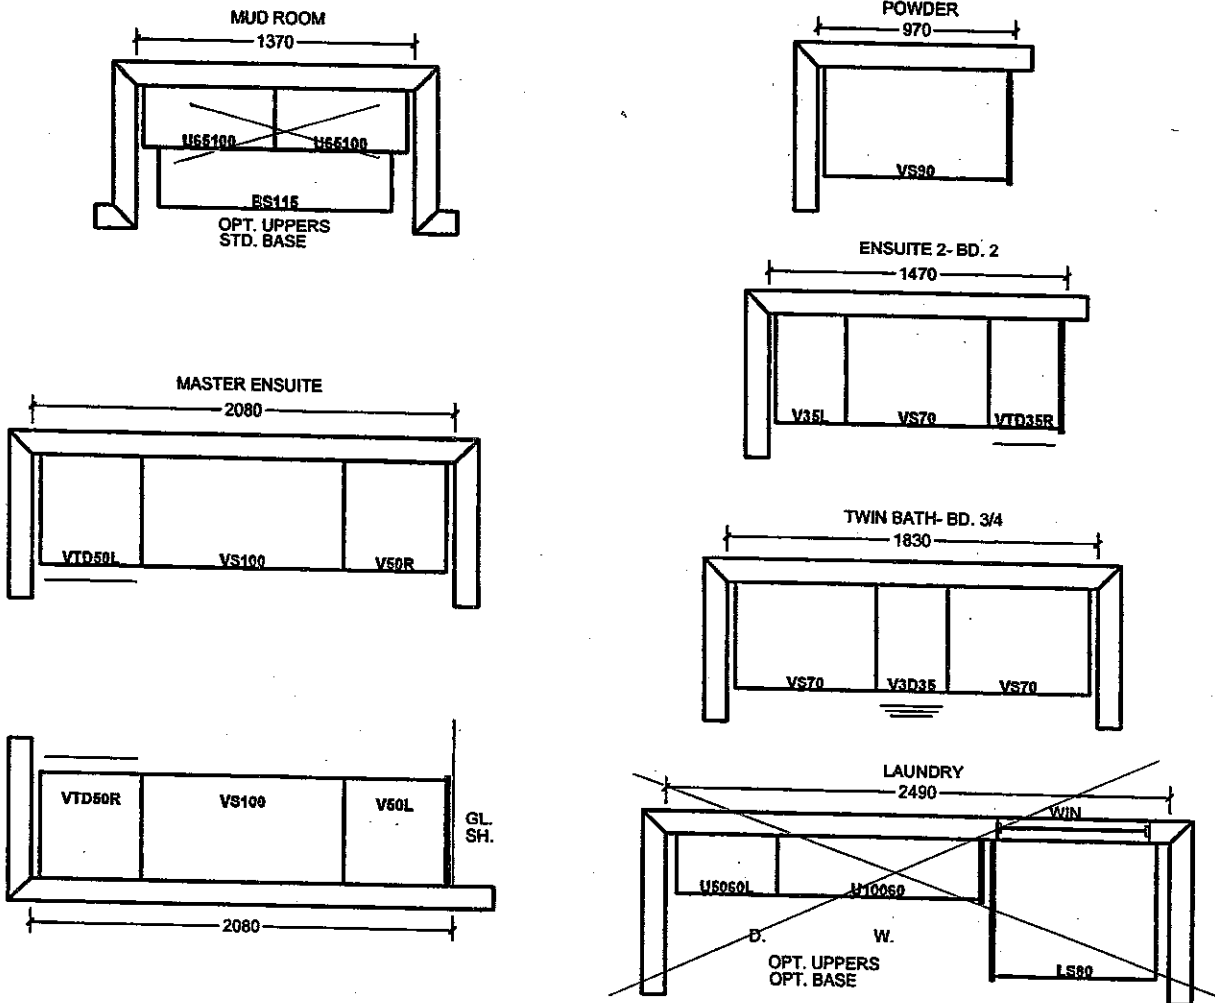

OPT. 2ND FLOOR

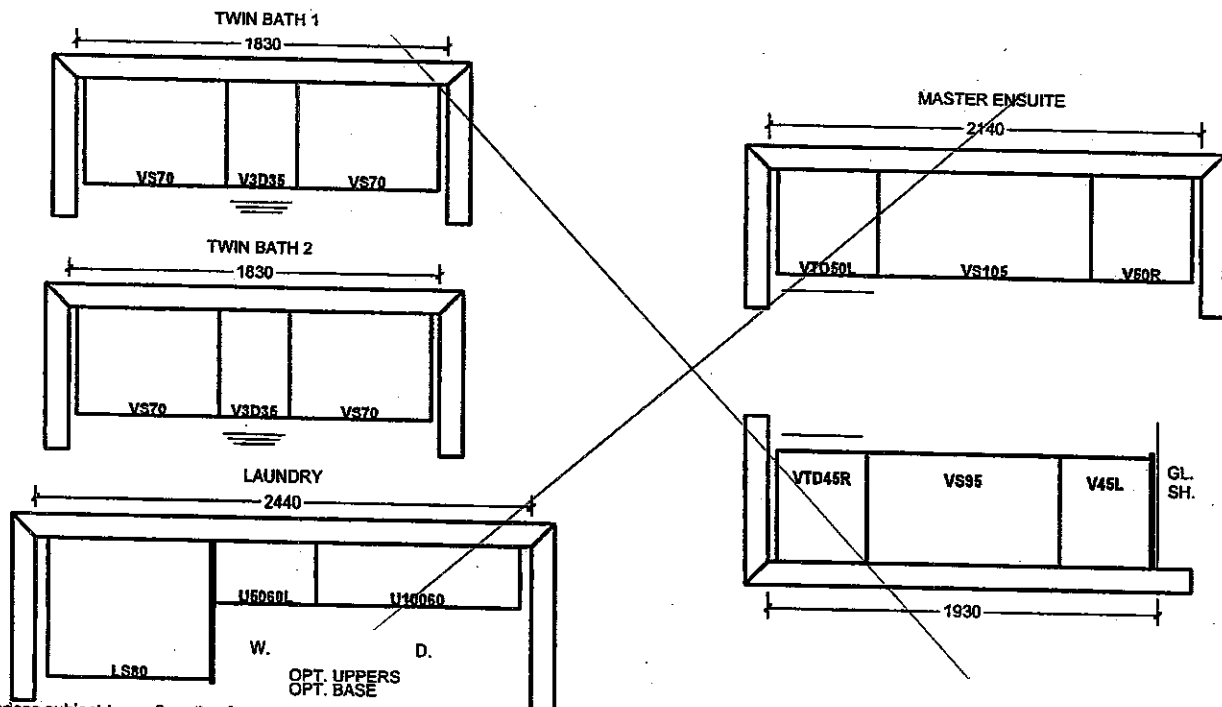


All prices subject to confirmation from head office.
This quotation is subject to the terms & conditions set out

All agreements are contingent upon strikes, accidents, and delays beyond our control.
Please provide our installer with template for sinkholes or \$150.00 will be charged for callback.

ACCEPTED DATE: _____

Trade Name: Gold Park Homes	Site location: Kleinburg	Model: 42-5
Address:	Project: Kleinburg Glen	Phase:

This layout has been explained to the purchaser by Cortina Kitchens Inc. and is understood by the purchaser.

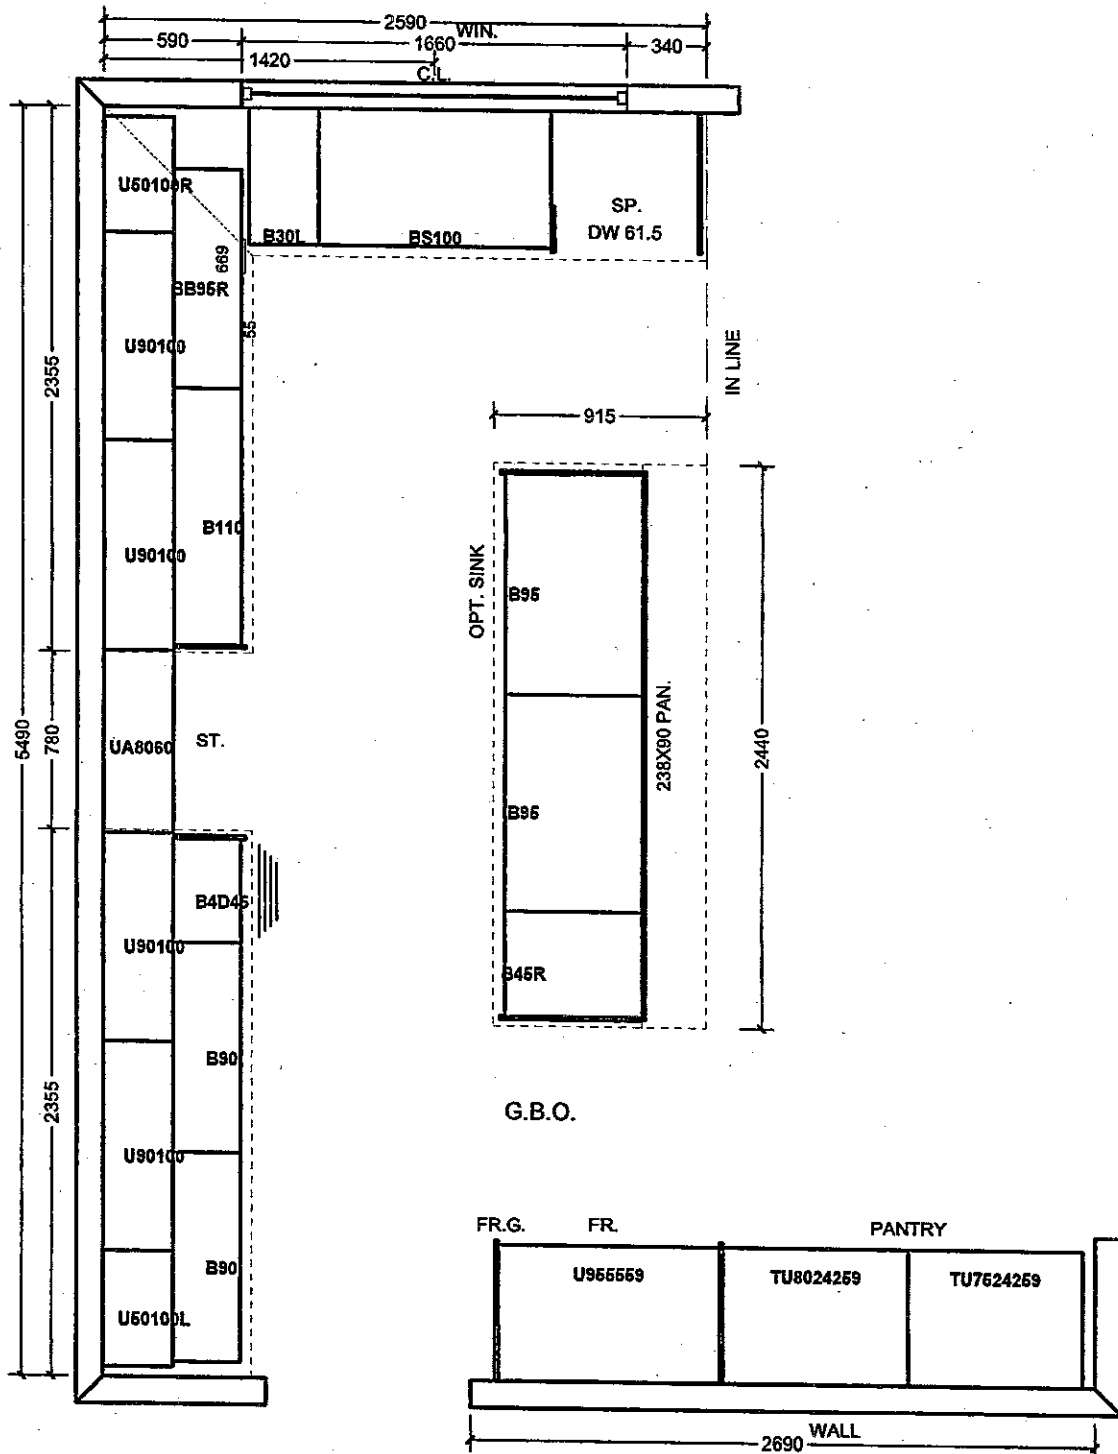





All prices subject to confirmation from head office.
This quotation is subject to the terms & conditions set out

ACCEPTED DATE: _____


All agreements are contingent upon strikes, accidents, and delays beyond our control.
Please provide our installer with template for sinkholes or \$150.00 will be charged for callback.

Item A. Wood grain and colour are characteristics of the product. We cannot guarantee that such grain and colour will always match.
Item B. Cortina Kitchens Inc. reserves the right to alter dimensions and make technical changes without notice.

Arzo 4 Piece Roman Tub faucet (chrome) #T4786/R4716

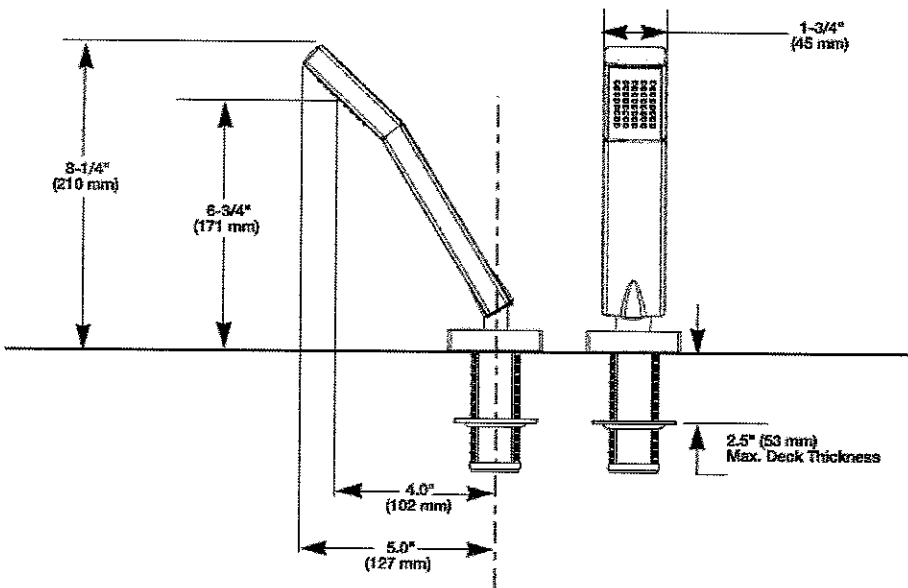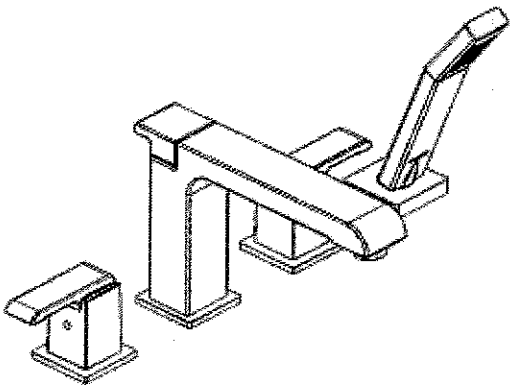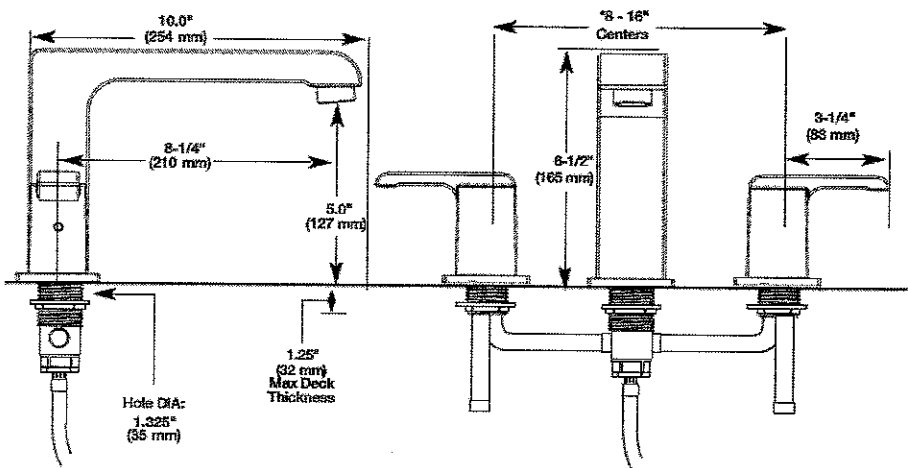
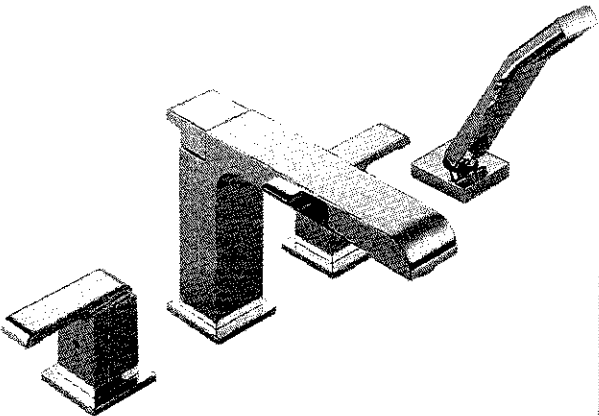



T4786

LOT # 2-3	
ROOM: M. ENSUITE	SIGNATURE: 
DATE: March 13 2017	SIGNATURE:

Arzo TempAssure 3 Function Shower System

#T17T267/50570//T11867/R1100/R10000-UNBXHF (chrome)

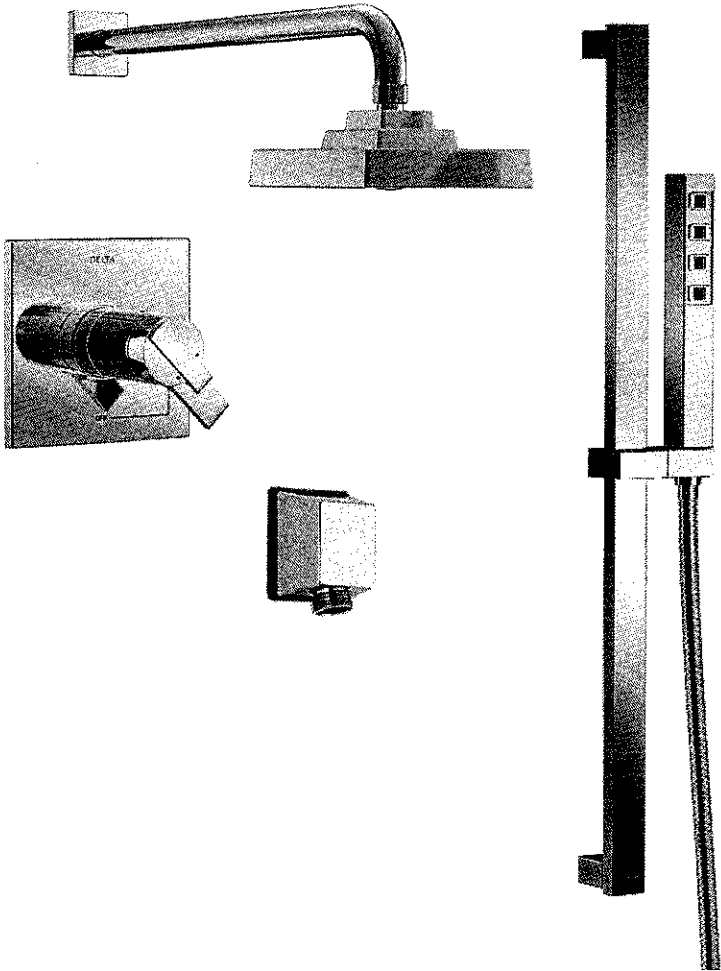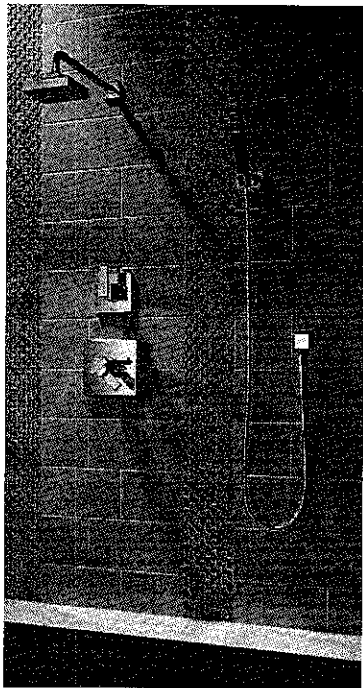

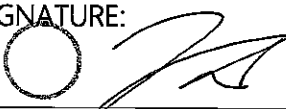LOT # 2-3	
ROOM: MASTER ENSUITE	SIGNATURE: 
DATE: MARCH 13 2017	SIGNATURE:


KG2-3

March 13 2017


(12)

- Standard 2CM & 3CM
- ⊖ Upgrade 1.2CM & 3CM
- ⊗ Upgrade 1.4CM
- Upgrade 2


20mm (3/4") Profiles

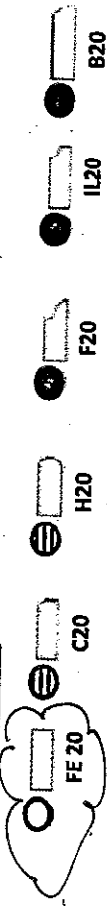

30mm (1-1/4") Profiles

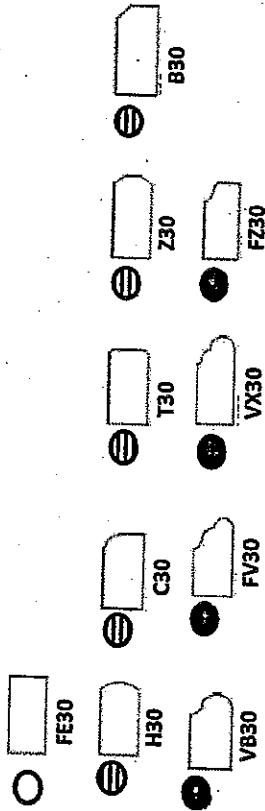

40mm (1-1/2") Profiles

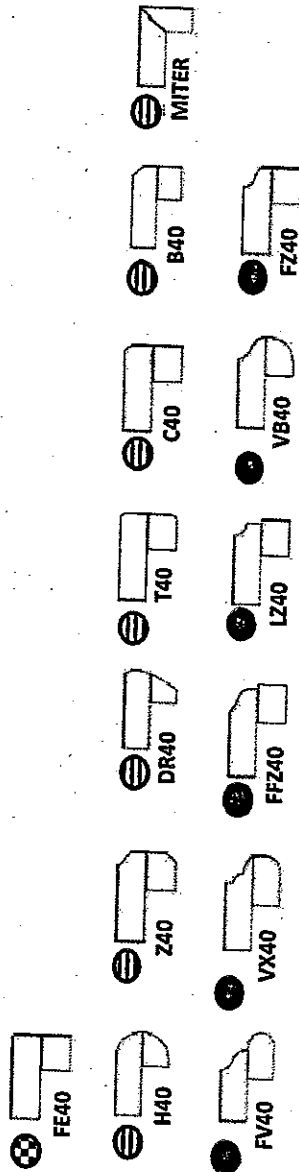

* STANDARD SINK + FAUCET

Note: All colours may not be available in 30mm at time ordered. Vendor reserves the right to use 40 mm edges (by lamination process).

*Mitre edge is available in Upgrade 1 for an overall thickness of 2". All other Mitre edge options will be an Upgrade 2 Edge.

CORTINA


STANDARD HARDWARE

KG2-3
MAR 13 2017



MODIFIED: 19/05/16

STANDARD HARDWARE

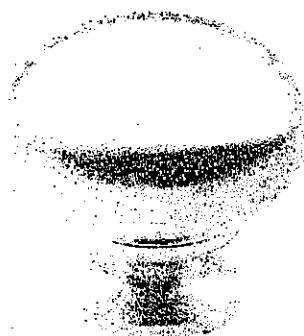


CSI-6



CSI-10




CSI-14

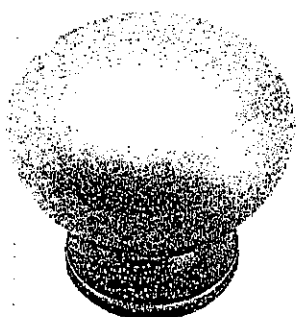


CSI-16




CSI-18

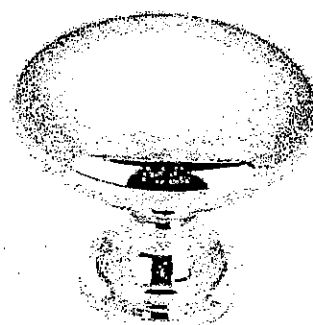


CSI-19

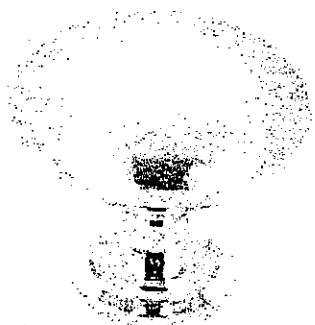


CSI-20

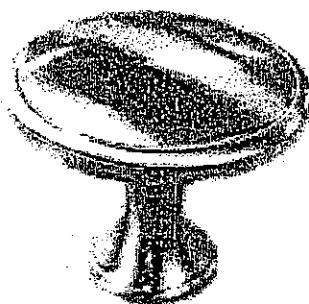


CSI-21

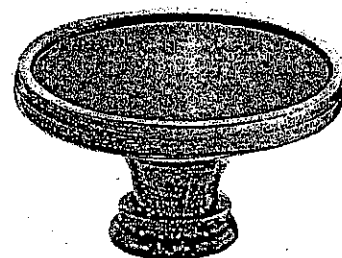


CSI-22

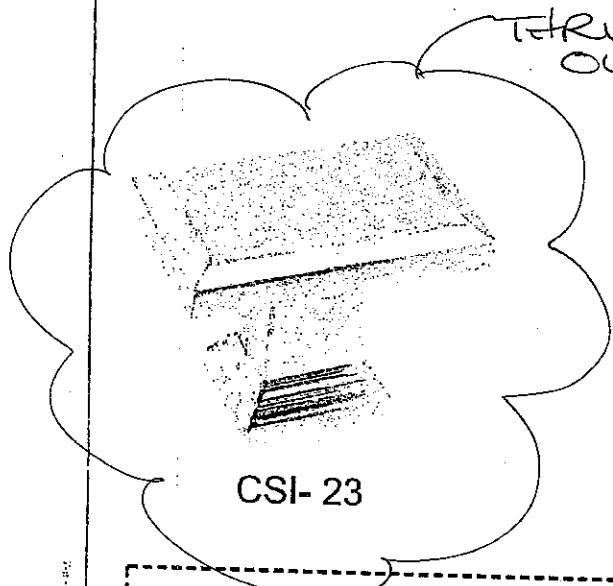

CSI-23

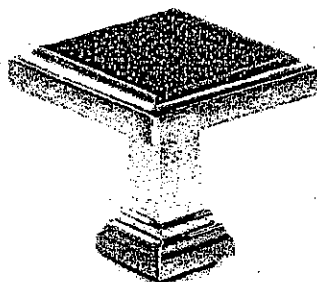


CSI-24

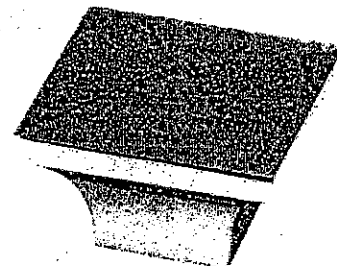

CSI-25


*NOTES:

- IMAGES ARE FOR QUICK REFERENCE PURPOSES ONLY
- ACTUAL SIZES AND FINISHES AS PER HARDWARE
- SAMPLE BOARD PROVIDED TO DECOR CENTRE

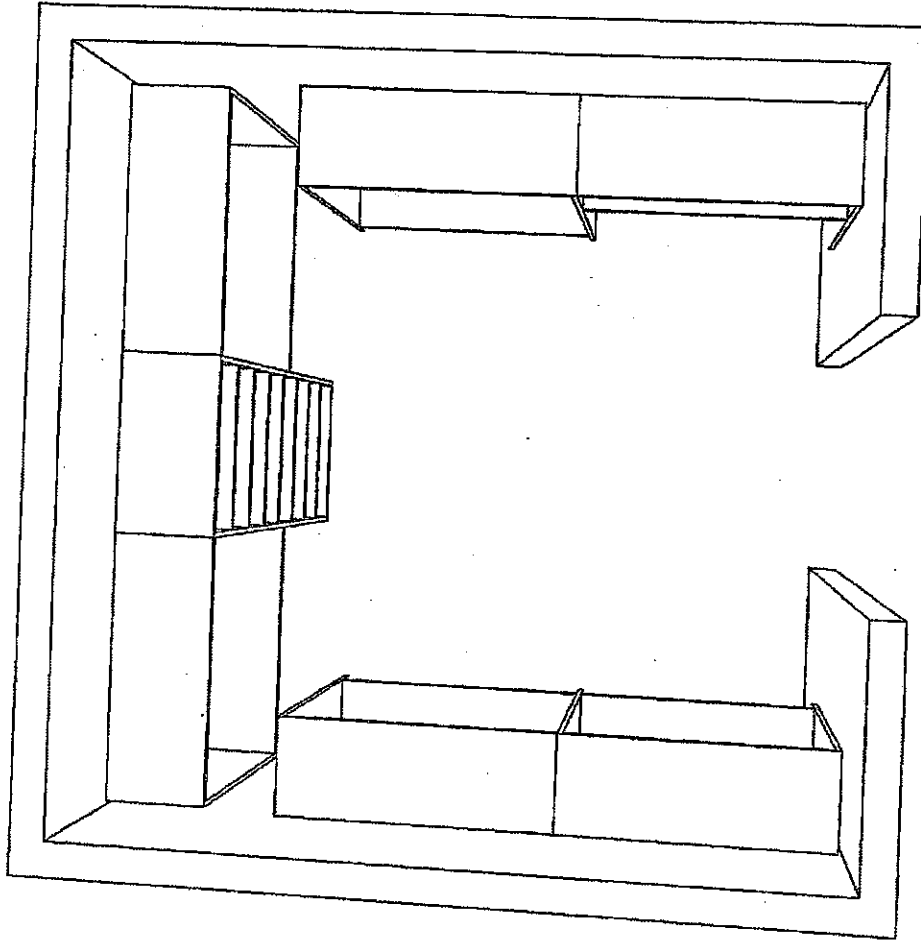

KG2-3
 March 13 2017


The Home Organizer <YOUR ADDRESS> PHONE: <YOUR PHONE NUMBER> FAX: <YOUR FAX NUMBER>	GPH MODEL 42 - 5 EL GPH MODEL 42 - 5 EL A Room 1	Perspective Current Date: Feb 07, 2017 Scale: NTS
---	---	---

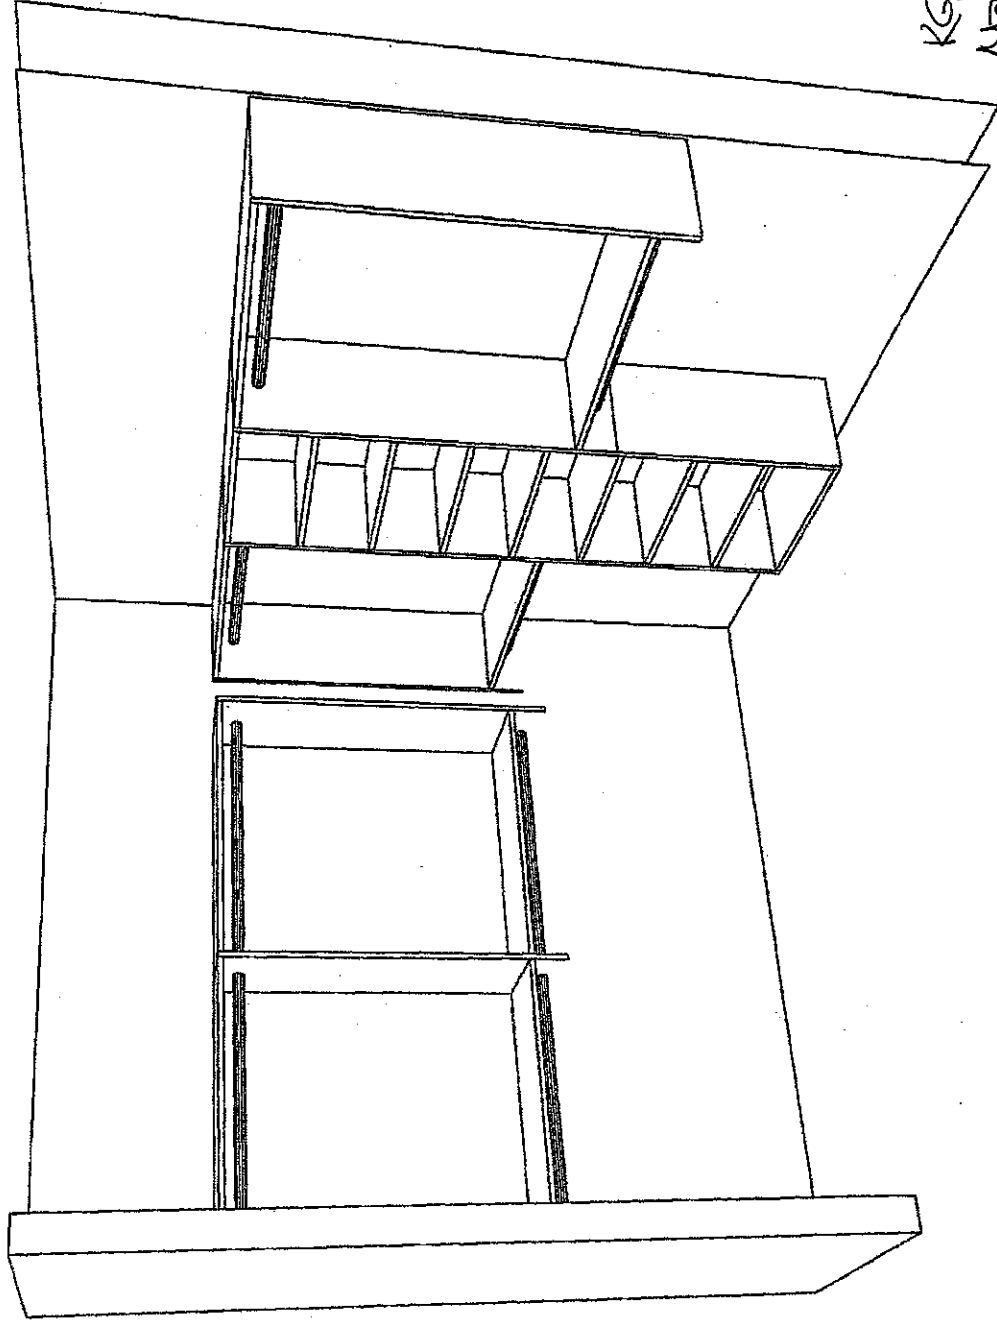

(1/1)

KG2-3
March 13
2017

The Home Organizer <YOUR ADDRESS> <YOUR CITY AND STATE> PHONE: <YOUR PHONE NUMBER> FAX: <YOUR FAX NUMBER>	GPH MODEL 42 - 5 EL	Perspective	
	GPH MODEL 42 - 5 EL A Room 1	Current Date: Feb 07, 2017	Scale: NTS

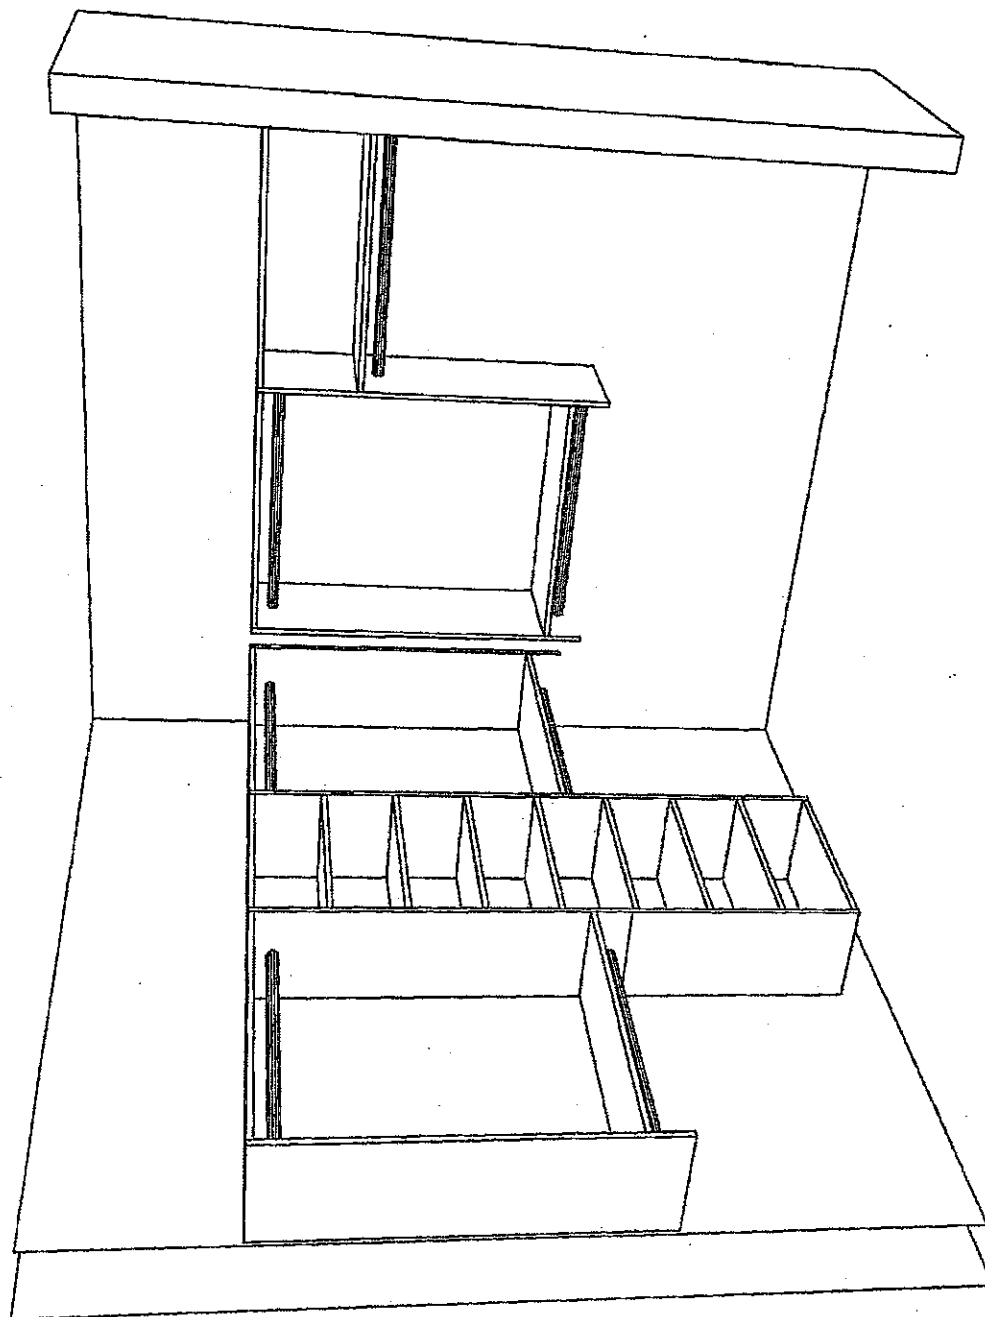

1/2

KGZ-3

March 13 2017

The Home Organizer <YOUR ADDRESS> <YOUR CITY AND STATE> Phone: <YOUR PHONE NUMBER> Fax: <YOUR FAX NUMBER>	GPH MODEL 42 - 5 EL	Perspective
	GPH MODEL 42 - 5 EL A Room 1	Current Date: Feb 07, 2017 Scale: NTS

Gold Park Homes Décor

GOLDPARK
WORTH MORE™

Centre Disclaimers

Through years of doing business, we at Gold Park Homes have encountered issues beyond our control. The following disclaimers apply to all instances of Purchaser's Extras forms and all Interior Colour Scheme forms.

FIREPLACES

Fireplace Marble: Due to the many variables that can affect the pattern and/or design, frequently the marble installed on the fireplace will not be identical to the samples. We will make every attempt to come as close to the samples as possible, but cannot be responsible for results which differ from the samples.

CERAMIC FLOOR TILE

Many variables including variegation can affect tile colour, pattern and/or design which mean installed tiles may not be identical to the samples. We will make every attempt to come as close as possible, but cannot be responsible for results which differ from the samples.

HARDWOOD FLOORING

The purchaser is advised that cupping and shrinkage are characteristics of hardwood flooring normally appearing after installation, especially when humidity levels are not regulated, and no warranty is provided by the flooring supplier with respect to such cupping and shrinkage. Furthermore, hardwood floors may also heave and warp when located at or close to entrance points of the home, where rain could make its way to the flooring. The vendor agrees to install any hardwood flooring ordered by the purchaser in a good and workmanlike manner, but shall not be responsible for, and is hereby released by the purchaser from responsibility and liability for cupping, shrinkage, heaving and warping of hardwood flooring in the above mentioned circumstances.

STAIRCASE VS FLOORING WOOD SPECIES DIFFERENCE

The purchaser is aware and therefore accepts and acknowledges that the wood species of the staircase and flooring chosen do not match. This difference might result in an undesirable colour variance.

The purchaser is aware and therefore accepts and acknowledges that though the flooring is of the same species as the staircase the difference in product finishing may result in a stain colour variance.

The purchaser agrees that the vendor is to be exempt from any and all claims by the purchaser regarding this colour variance.

RAILINGS

All railings, pickets, posts, nosing's and stairs come from solid wood and veneered wood materials sourced from multiple locations and sources. As such there will be variations in grains and shades between the various natural components beyond our control. Due to this variance in material, all components will stain with colour or natural finish differently.

Iron pickets are wrought in nature and depending on the manufacturing process will have differences from picket to picket which is normal. Also the finish of the iron pickets is of a powder coated nature. This process can produce minor colour variations or tones. Furthermore, the assembly of the metal pickets can develop a natural rattle over time from vibration in the railing. Minor rattling is normal and is a part of the wrought iron picket assembly.

HOUSE EXTERIORS

Variations in subcontractors across different sites and varying site conditions may result in house exteriors that differ from the artist renderings. We cannot be responsible for results which differ from the artists renderings of elevations.

PLASTER MOULDINGS AND MEDALLIONS

Plaster mouldings will not be installed in open to above areas or areas with 2 storey elements.

STAIN COLOURS

Due to the many variables that can affect the outcome of a stain colour on wood, staircases, railings, and fireplaces, the colour may not be identical to samples. Factors such as density, age, humidity, air temperature, and the uniqueness of each piece of wood can result in wide variations in darkness or lightness. We will make every attempt to come as close to the sample as possible, but cannot be responsible for results which differ from the samples.

Stain on pre-finished hardwood floors will not be an exact match to the stain colours available on stairs, pickets and rails. The purchaser is responsible for choosing the stain on these areas to their satisfaction.

IN-WALL CONDUIT FOR AUDIO/VIDEO CABLES

It is important to note that due to the variation in framing requirements in different parts of your home, conduit lengths and routing can vary. In virtually all instances of ground floor installation (I.e. above a fireplace), conduit will first travel down into the basement below the floor joists, over to the termination point and back up into the main floor. As a result, it is best to measure the length of the conduit after occupancy with a "pull wire" before



purchasing your cables. For above-fireplace installations, the conduit wall plate will be installed approximately 10" above the Fireplace Mantle, unless otherwise specified in the Construction Summary.

APPLIANCE SPECIFICATIONS

All appliance openings are set to builder's standard openings. Please advise Décor Centre at time of your structural appointment if custom sizing of cabinets is required for any built - in appliances. The purchaser is responsible for costs and fees associated with changes to pre-manufactured kitchens made subsequent to colour appointments.

Purchaser accepts & acknowledges that in order to accommodate upgraded appliances, all appliance specifications should be provided at the time of their structural appointment, should this not occur they must be provided to the Décor Center within one (1) week of completion of structural chart. Failure to do so may result in the need to revert to the standard appliance openings or in a delay in construction of your dwelling, as well as a cost of \$500 to re-open your structural file should changes be required. As a result we may be forced to extend the closing of your transaction. Due to failure to complete the above-mentioned selections and at no fault of our own, we reserve our right to hold you responsible for this delayed closing, including charging extra administration cost and interest on the balance due on closing.

Purchasers Accept Standard Appliance Openings (unless otherwise specified):

Fridge - 37-1/2"W x 73-1/2" High Approx.

Range - 30-1/2"D x 31-1/2"W Approx.

Dishwasher - 24" W Approx.

DELETION OF HOODFAN & CABINETS ABOVE STOVE:

The purchasers are aware that in requesting NOT TO INSTALL builder's standard hood fan and standard cabinets above stove they will receive NO STANDARD HOOD FAN and NO CREDIT. Purchasers are installing their own hood fan after closing and accept that it may waive any warranty associated with such a change.

Purchasers accept and acknowledge that the exhaust fan duct hole may be off-centered with the stove in the kitchen due to purchasers installing their own hood fan after closing. The vendor is exempt from adjusting such openings for the purchasers range hood.

ELECTRICAL FOR APPLIANCES

Pricing is subject to change based on the appliance specifications provided. Purchasers should provide proper appliance specifications and cut-out sheets in order for Gold Park to price extras accordingly.

KITCHEN CABINETS

The kitchen you order/purchase will undoubtedly contain slight colour variations. The degree of these variations is virtually impossible to determine before the kitchen is installed in its intended location. The amount of and type of lighting will also affect various highlights in the finish. Note: No two pieces of wood are identical. Variations in colour tone and grain patterns make a perfect colour match virtually impossible. It is generally agreed that these variations add to the natural beauty of a wood kitchen.

STAIN

Charcoal is a spray stain applied to Oak and Maple products with several characteristics that are important to be aware of when purchasing this product.

1. Shadow lines may be visible at the interior profile edges of a door or drawer front. If movement occurs shadow lines may increase or decrease, depending on the style and/or size of a door or drawer front.
2. Variation and unevenness may be visible in the finish.
3. Hairline cracks at the joints are created over time due to the nature of natural wood, caused by usage, humidity**, or dryness. They tend to be more visible to darker stains, than lighter wood stains.

** Relative humidity is recommended to be between 45% and 55%. Please refer to Cortina Kitchens "Cleaning, Care, Maintenance, & Warranty Information" guide.

Please be advised that Cortina Kitchens will not replace doors and/or parts that exhibit the above characteristics associated with this finish. These characteristics are not avoidable and are a result of the natural characteristics of wood and wood veneer, and the characteristics of darker stains on wood. The Charcoal stain is not available on doors in Group IV, Group IVA, Group V and Group VA.

Cortina Kitchens offers a wide variety of finishes, applied to oak and maple products. The subject finishes include the spray stains Cocoa, Espresso, Graphite as well as wiping stain Ebony.

Due to the very dark stains applied on natural maple and oak doors and joints, several characteristics are important to be noted when purchasing these products.

1. Shadow lines may be visible at the interior profile edges of a door or drawer front. If movement occurs shadow lines may increase or decrease, depending on the style and/or size of a door or drawer front.
2. Variation and unevenness may be visible in the finish.
3. Hairline cracks at the joints are created over time due to the nature of natural wood, caused by usage, humidity, or dryness. They tend to be more visible to darker stains, than lighter wood stains.

Please be advised that Cortina Kitchens will not replace doors nor parts that exhibit the above characteristics associated with this finish. These characteristics are not avoidable and are a result of the natural characteristics of wood and wood veneer, and the characteristics of darker stains on wood.

VW

CABINETRY DOOR HARDWARE

Cortina Kitchens' cabinetry doors and drawer fronts will be drilled to accept a standard knob or handle selected from Cortina's hardware boards. This drilling comes standard with the order, and is done ONLY in our shop, not on the job site.

For those not wanting Cortina's hardware drilling, the following applies:

No holes to be drilled on the doors and drawer fronts should be specified in writing on the colour chart and the P.O. If while in production, Cortina Kitchens misses this request, Cortina Kitchens and the Builder will not be held responsible to replace any or all doors and drawer fronts affected, and the customer agrees to accept the product as is. No hardware will be supplied or credited by Cortina Kitchens with this request. No charge will apply for this request.

PVC DOORS

All cabinets with PVC (Thermofoil) Doors come with melamine gables, panels and kick. The doors, crown moulding and light valance are PVC wrapped. Open shelves incorporated in design will only be available with melamine interiors. There will be variations in colour shades between the PVC parts (doors, crown and Light valance) and the melamine parts (open shelves, Gables, Panels and Kick) due to the difference in material.

Furring Panel with crown moulding to the ceiling is not available on all PVC door styles due to subtle variations in colour shades between the PVC parts (moulding) and the melamine parts (furring panel) due to the difference in material. Grain directions in wood grain pattern melamine, vary between the furring panel, crown moulding (horizontal) and the PVC doors (vertical).

GRANITE, MARBLE ENGINEERED SURFACES WAIVER

Granite and marble are naturally occurring products, and due to the many variables that can affect the pattern, colour and/or design and "pitting" of natural products slabs installed will not be identical to the samples displayed. We will make every attempt to come as close to the samples as possible, but cannot be responsible for results which differ from the samples. Every effort is made to provide granite counter tops as close as possible but the vendor is not responsible for results which differ from the sample displayed. All countertop surfaces may have seams & product pattern & shade can change in areas containing seams.

RESELECTIONS

It is not uncommon for flooring, such as tile, to become discontinued prior to its installation. Therefore it may be necessary to make a reselection of certain materials sometime during the build process. We cannot assure you that another choice approximating your selection will be available.

PLANS

Plans are subject to change without notice. Actual usable floor space may vary from the stated floor area. Layout for kitchen, furnace, HWT and laundry tub may vary from plan. Vertical and horizontal bulkhead, which are not shown on plan, may be required for plumbing and heating runs. E.& O.E.

PLEASE NOTE:

In the event the work on the house has progressed beyond the point where the items covered by these invoices cannot be installed without entailing any unusual expense, then this order is to be cancelled and any deposit paid in connection with the same is to be refunded to the purchaser.

The vendor will undertake to incorporate the work covered by the sales extra in the construction of the house but will not be liable to the purchaser in any way, if for any reason the work covered by the extra is not carried out. In that event, any monies paid in connection with the same shall be returned to the purchaser.

It is understood and agreed that if for any reason whatsoever the transaction of Purchase and Sale is not completed, the total cost of extras ordered are not refundable to the Purchaser(s).

Extras or changes will not be processed unless signed by the Vendor.

These extras may not be amended without the written consent of Gold Park Homes.

The purchaser(s) and the builder acknowledge and agree that this "Purchaser's Extra" form shall not be deemed to be part of the agreement of purchase and sale entered into between them, nor an addendum thereto.

No postdated cheques will be accepted.

No estimates or orders will be accepted once construction has commenced.

Should a refund be requested on any extras purchased, an 80% reimbursement of the purchase price will be given. (a \$50.00 minimum charge and a maximum \$250.00 charge will apply)

Estimates will only be considered when resubmitted on a signed Purchaser Extras form, accompanied by payment in full.

All prices are estimates only and may be subject to change. Should a change in price occur Gold Park Homes reserves the right to request from the purchaser an adjustment of the price or a refund limited to that item.

Purchasers are aware & accept that ANY changes made to upgrades after signing the Purchasers Extra Form are subject to a minimum administration fee of \$500. PLUS a 10% holdback fee.

Purchasers are aware that any request to add a percentage of upgrades from the purchaser's extras form will be processed only after the builder receives approval letter from the bank.

VW

Please be advised that your failure to finalize your structural or colour selections may result in a delay in construction of your dwelling and we may have to extend closing of your transaction. Due to failure to complete the above-mentioned selections and at no fault of us, we reserve our right to hold you responsible for a delayed closing, including charging extra administration cost and interest on the balance due on closing.

Purchaser has attended a Colour appointment at the Decor Centre & has DECLINED any additional upgrades and accepts and acknowledges that there will be no further structural changes/additions/deletions to be made upon signing.

I hereby acknowledge reading and understanding the above copy and will not hold Gold Park Homes responsible for any issues in relation to above.

Purchasers Signatures



Date MARCH 13 2017

KG2-3