

Brampton Encore - BLK 147 - 2 - Unknown

CERAMIC

Inv.1,516	1 - FREESTANDING TUB IN MASTER ENSUITE
Line24134	Note:
21Jul17 / 20Sep17	

CONCRETE AND DRAIN

Inv.1,516	1 - INSTALL COLD CELLAR IN BASEMENT
Line23463	Note:
21Jul17 / 20Sep17	

Inv.1,516	1 - 3 PIECE PLUMBING ROUGH-IN IN BASEMENT
Line23464	Note:
21Jul17 / 20Sep17	

DRYWALL

Inv.1,516	1 - SMOOTH CEILINGS MAIN FLOOR
Line24143	Note:
21Jul17 / 20Sep17	

Inv.1,516	1 - SMOOTH CEILINGS SECOND FLOOR
Line24144	Note:
21Jul17 / 20Sep17	

ELECTRICAL

Inv.1,516	1 - KITCHEN- GAS LINE ROUGH FOR STOVE INCLUDE 110V PLUG
Line24141	Note:
21Jul17 / 20Sep17	

Inv.1,516	1 - ADDITIONAL STANDARD FIXTURE ON SAME SWITCH <i>above breakfast bar</i>
Line24145	Note: <i>see plan</i>
21Jul17 / 20Sep17	

Inv.1,516	1 - ADDITIONAL STANDARD FIXTURE WITH SWITCH - MUST SPECIFY LOCATION <i>above breakfast bar</i>
Line24146	Note: <i>see plan</i>
21Jul17 / 20Sep17	

Exterior Colours

Inv.1,516	1 - EXTERIOR PACKAGE 8
Line24142	Note:
21Jul17 / 20Sep17	

FRAMING

Inv.1,516	1 - INSTALL GARAGE TO HOUSE MANDOOR
Line23466	Note:
21Jul17 / 20Sep17	

Inv.1,516	1 - FREESTANDING TUB IN MASTER ENSUITE
Line24133	Note:
21Jul17 / 20Sep17	

Inv.1,516	4 - TALLER INTERIOR MAIN FLOOR DOORS
Line24135	Note:
21Jul17 / 20Sep17	

Brampton Encore - BLK 147 - 2 - Unknown

Inv.1,516	1 - FRENCH DOORS IN LIEU OF PATIO SLIDERS - 6FT X 80 INCH FRENCH DOORS - NO SCREEN- GRILLED GLASS
Line24138	Note:
21Jul17 / 20Sep17	

HVAC

Inv.1,516	1 - KITCHEN- GAS LINE ROUGH FOR STOVE INCLUDE 110V PLUG
Line24139	Note:
21Jul17 / 20Sep17	

Inv.1,516	1 - UPGRADE VENTING FOR STOVE TO 8" PIPE EXTERIOR WALL
Line24140	Note:
21Jul17 / 20Sep17	

INTERIOR TRIM AND DOORS

Inv.1,516	4 - TALLER INTERIOR MAIN FLOOR DOORS
Line24136	Note:
21Jul17 / 20Sep17	

PLUMBING

Inv.1,516	1 - FREESTANDING TUB IN MASTER ENSUITE
Line24132	Note:
21Jul17 / 20Sep17	




WINDOWS - BASEMENT

Inv.1,516	3 - BASEMENT WINDOWS - UPGRADE EXISTING BASEMENT WINDOW TO 30 INCH X 16 INCH
Line23462	Note:
21Jul17 / 20Sep17	

WINDOWS AND DOORS

Inv.1,516	1 - INSTALL GARAGE TO HOUSE MANDOOR
Line23465	Note:
21Jul17 / 20Sep17	

Inv.1,516	1 - FRENCH DOORS IN LIEU OF PATIO SLIDERS - 6FT X 80 INCH FRENCH DOORS - NO SCREEN- GRILLED GLASS
Line24137	Note:
21Jul17 / 20Sep17	

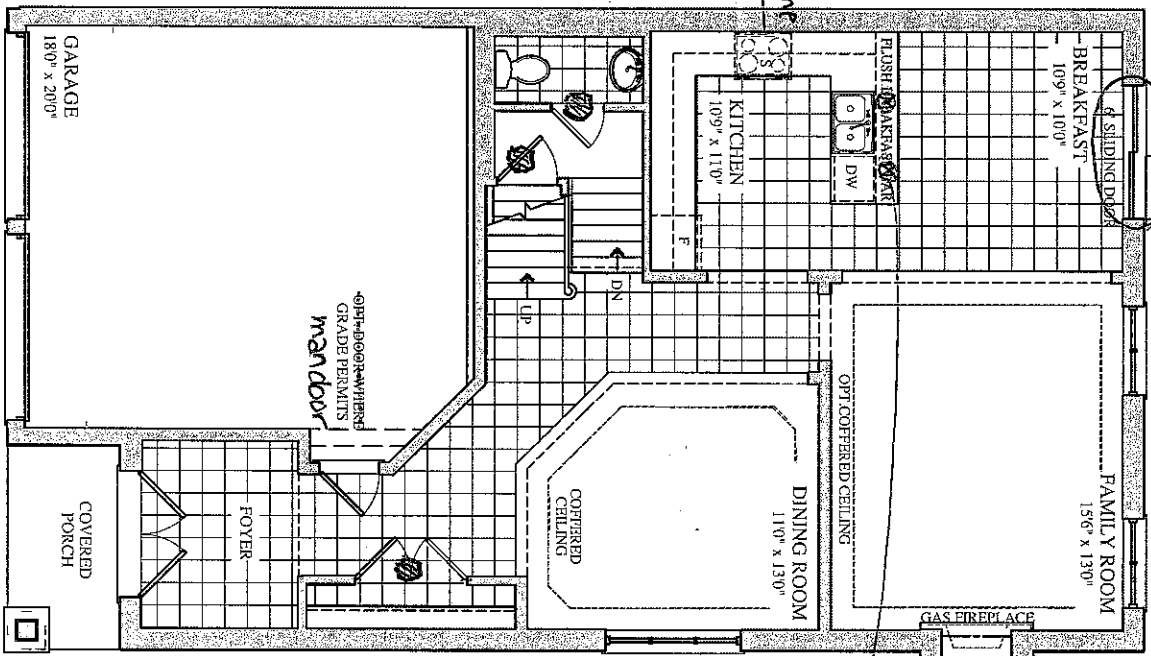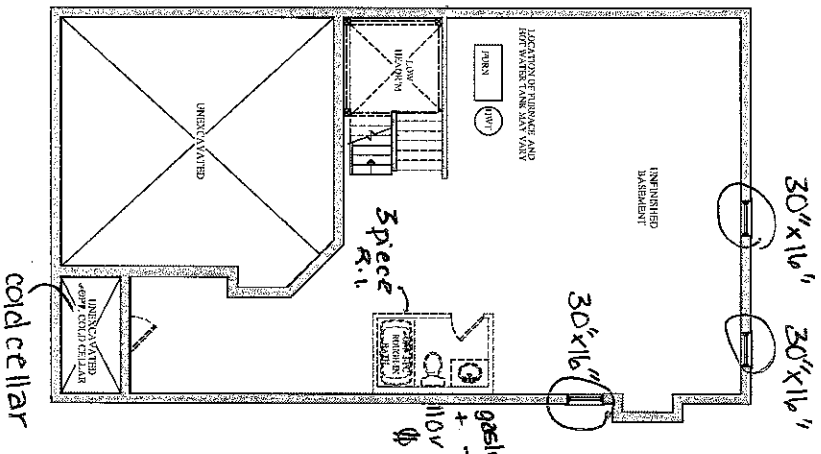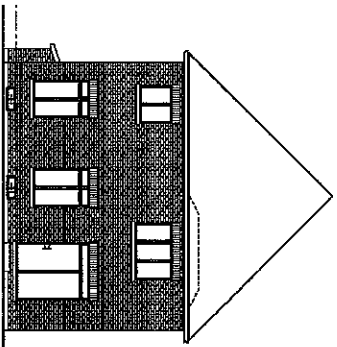


French doors

smooth ceiling

capped pendant lights on same switch

9'6" taller doors

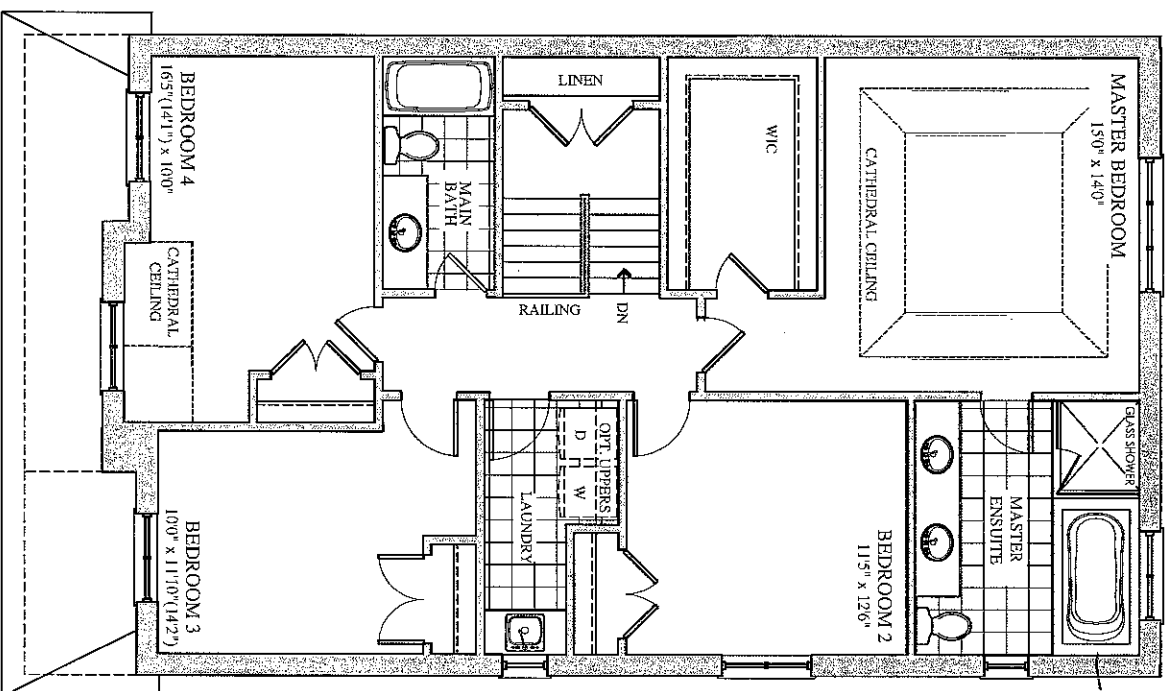




Free standing tub

smooth ceiling

Lot 147
36' SERIES
2,374 sq.ft.

Prices, figures, illustrations, sizes, features and finishes are subject to change without notice. E&O.E. Areas and dimensions are approximate and actual usable floor space may vary from the stated area. Layout may be reverse of the unit purchased. E. & O.E.


Lot 147
2,374 sq.ft.

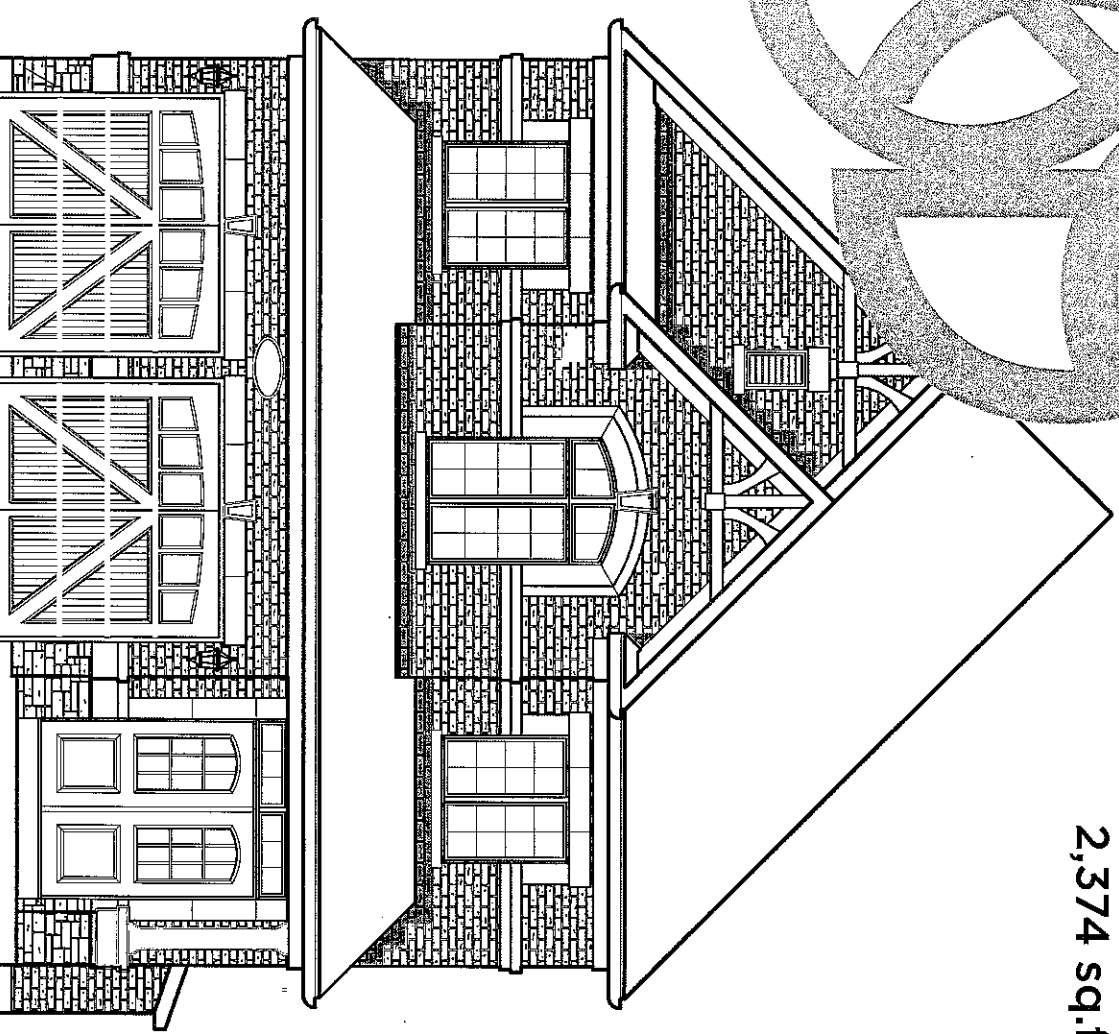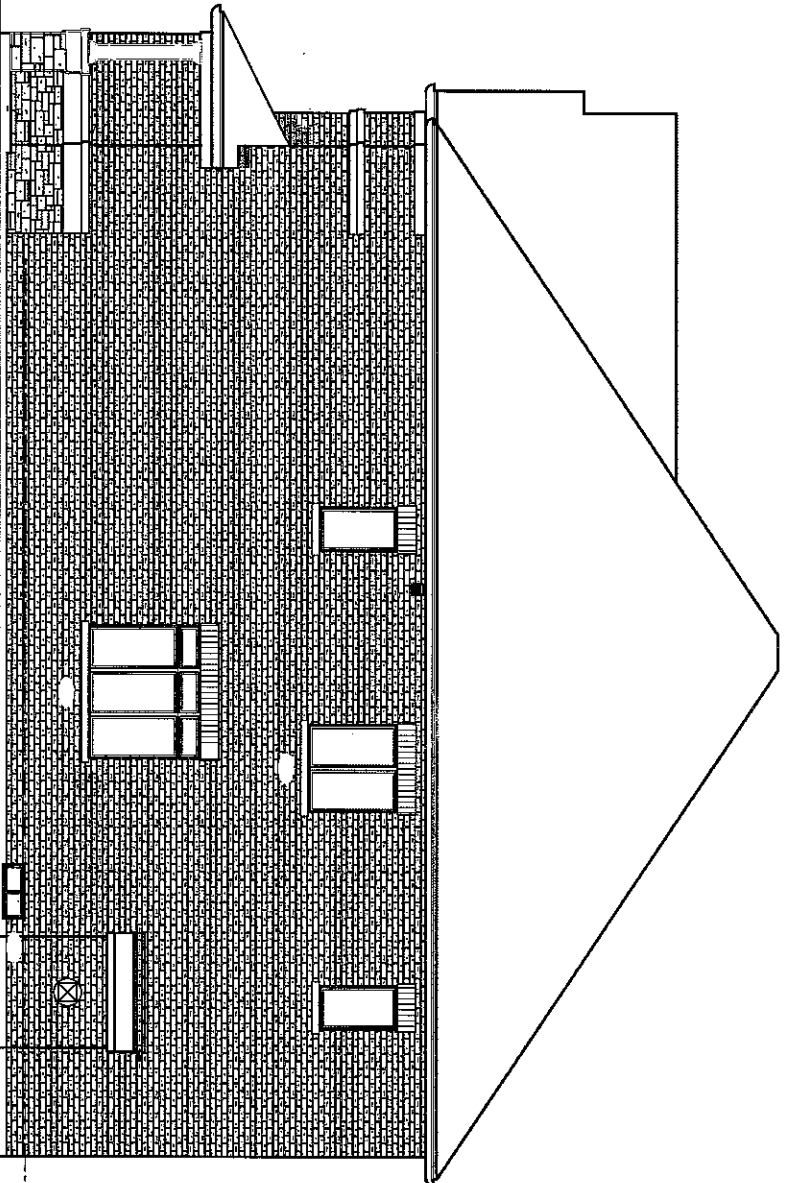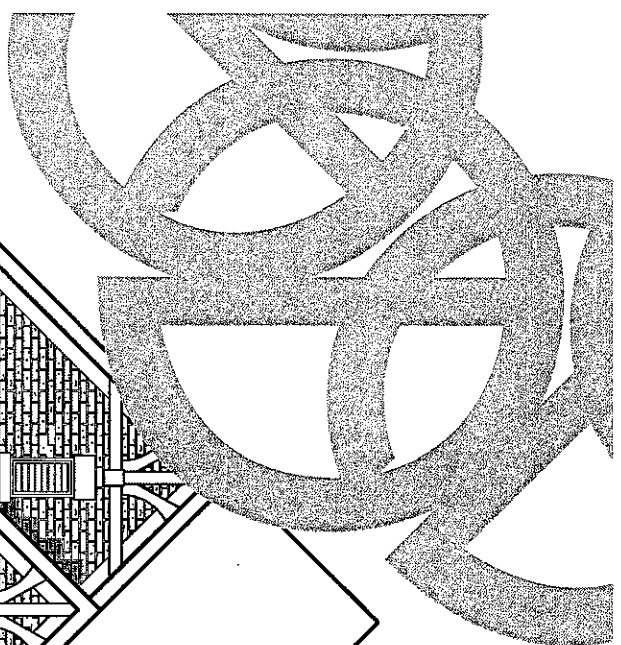

GOLD PARK
WORTH MORE™

Artist's Concept

Artist's Concept

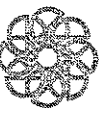
encore²
BRAMPTON

36'
SERIES