



CONSTRUCTION SUMMARY

Brampton Encore - 21L - 2 - 28-8 Elev.A BEETHOVEN
CENTRAL VAC AND WIRING

Inv.1,364	1 - TELEPHONE AND CABLE ROUGH-IN LOCATIONS
Line21443	Note:
15May17 / 13Jul17	
Inv.1,364	1 - FAMILY ROOM: INSTALL CONDUIT PIPE- FOR TELEVISION- MUST SPECIFY LOCATION AND TERMINATION POINT, ABOVE FIREPLACE
Line21444	Note:
15May17 / 13Jul17	
Inv.1,364	1 - MASTER BEDROOM: INSTALL CONDUIT PIPE- FOR TELEVISION- MUST SPECIFY LOCATION AND TERMINATION POINT. SEE SKETCH
Line21446	Note: INSTALL 5 FEET ABOVE FINISHED FLOOR
15May17 / 13Jul17	

DRYWALL

Inv.1,364	1 - SECOND FLOOR: INSTALL SMOOTH CEILINGS - (2-Story Design) 2ND FLOOR
Line22414	Note:
15May17 / 13Jul17	
Inv.1,364	1 - KITCHEN/MAIN HALL: DELETE CLOSET IN MAIN HALL. ENLARGE KITCHEN AND LAUNDRY ROOM ACCORDINGLY. SEE SKETCH FOR NEW LAYOUT
Line22413	Note:
15May17 / 13Jul17	

ELECTRICAL

Inv.1,364	1 - FAMILY ROOM: INSTALL 110V WALL RECEPTACLE ON DEDICATED CIRCUIT - ABOVE FIREPLACE FOR TV
Line21445	Note:
15May17 / 13Jul17	
Inv.1,364	1 - MASTER BEDROOM: INSTALL 110V WALL RECEPTACLE ON DEDICATED CIRCUIT - FOR TV, SEE SKETCH
Line21447	Note: INSTALL 5 FEET ABOVE FINISHED FLOOR
15May17 / 13Jul17	
Inv.1,364	1 - LIVING/DINING ROOM: RELOCATE STANDARD FIXTURE -TO THE CENTRE OF THE LIVING/ DINING ROOM, IN ADDITION TO THE STANDARD SWITCH CONTROLLED RECEPTICLE
Line21448	Note:
15May17 / 13Jul17	
Inv.1,364	1 - KITCHEN: RELOCATE STANDARD FIXTURE - TO GO OVER ISLAND
Line21449	Note:
15May17 / 13Jul17	
Inv.1,364	1 - KITCHEN: INSTALL 110V WALL RECEPTACLE ON DEDICATED CIRCUIT - IN ISLAND FOR FUTURE BAR FRIDGE
Line21450	Note:
15May17 / 13Jul17	
Inv.1,364	1 - KITCHEN: INSTALL 240V WALL RECEPTICAL ON DEDICATED CIRCUIT- FOR 4 WIRE BUILT-IN WALL OVEN - IT IS A MICRO/WALL OVEN COMBO
Line22415	Note:
15May17 / 13Jul17	
Inv.1,364	1 - KITCHEN: MOVE FRIDGE OVER BY APPROX. 1 FOOT TO ACCOMODATE A WALL OVEN, SEE SKETCH
Line23341	Note:
15May17 / 13Jul17	

Brampton Encore - 21L - 2 - 28-8 Elev.A BEETHOVEN

Inv.1,364	1 - KITCHEN: INSTALL GAS LINE ROUGH - 2ND FLOOR- (2-STOREY MODELS) FOR STOVE. INCLUDES 110v PLUG
Line23343	Note:
15May17 / 13Jul17	

Exterior Colours

Inv.1,364	1 - EXTERIOR COLOUR PACKAGE 4
Line23345	Note:
15May17 / 13Jul17	

FRAMING

Inv.1,364	1 - KITCHEN: MOVE FRIDGE OVER BY APPROX. 1 FOOT TO ACCOMODATE A WALL OVEN, SEE SKETCH
Line22416	Note:
15May17 / 13Jul17	
Inv.1,364	1 - KITCHEN/MAIN HALL: DELETE CLOSET IN MAIN HALL. ENLARGE KITCHEN AND LAUNDRY ROOM ACCORDINGLY. SEE SKETCH FOR NEW LAYOUT
Line23339	Note:
15May17 / 13Jul17	
Inv.1,364	1 - MAIN FLOOR: INSTALL THREE (X3) STANDARD DOORS EXTENDED HEIGHT 96" (PRICE PER DOOR)- GROUND FLOOR 2 STOREY MODELS
Line23344	Note:
15May17 / 13Jul17	
Inv.1,576	1 - MANDOOR- AS PER PLAN GRADE PERMITS
Line24147	Note:
21Sep17 / 21Sep17	

HVAC

Inv.1,364	1 - KITCHEN: INSTALL GAS LINE ROUGH - 2ND FLOOR- (2-STOREY MODELS) FOR STOVE. INCLUDES 110v PLUG
Line22417	Note:
15May17 / 13Jul17	

INTERIOR TRIM AND DOORS

Inv.1,364	3 - MAIN FLOOR: INSTALL THREE (X3) STANDARD DOORS EXTENDED HEIGHT 96" (PRICE PER DOOR)- GROUND FLOOR 2 STOREY MODELS
Line22419	Note:
15May17 / 13Jul17	
Inv.1,364	1 - KITCHEN/MAIN HALL: DELETE CLOSET IN MAIN HALL. ENLARGE KITCHEN AND LAUNDRY ROOM ACCORDINGLY. SEE SKETCH FOR NEW LAYOUT
Line23340	Note:
15May17 / 13Jul17	

KITCHEN AND BATH CABINETRY

Inv.1,364	1 - KITCHEN: MOVE FRIDGE OVER BY APPROX. 1 FOOT TO ACCOMODATE A WALL OVEN, SEE SKETCH
Line23342	Note:
15May17 / 13Jul17	

MISC.

Brampton Encore - 21L - 2 - 28-8 Elev.A BEETHOVEN

Inv.1,364	1 - Purchaser has attended a Structural appointment at the Decor Centre & has DECLINED any additional upgrades and accepts and acknowledges that there will be no further structural changes/additions/deletions to be made upon signing on June 12, 2017.
Line22422	Note:
15May17 / 13Jul17	
Inv.1,364	1 - Purchasers are aware & accepts that ANY changes made to upgrades after signing this Purchasers Extra Form are subject to a minimum administration fee of \$500. PLUS a 10% holdback fee
Line22423	Note:
15May17 / 13Jul17	

PLUMBING

Inv.1,364	1 - KITCHEN: INSTALL ROUGH-IN - WATERLINE FOR FRIDGE
Line22418	Note:
15May17 / 13Jul17	




WINDOWS AND DOORS

Inv.1,576	1 - MANDOOR-AS PER PLAN GRADE PERMITS
Line24148	Note:
21Sep17 / 21Sep17	

The Beethoven SEMI SERIES

Elevation A • 2,372 sq.ft.
 Elevation B • 2,372 sq.ft.
 Elevation C • 2,372 sq.ft.
 Elevation D • 2,372 sq.ft.

Delete Closet in main hall. Enlarge Kitchen to make room for wall oven.

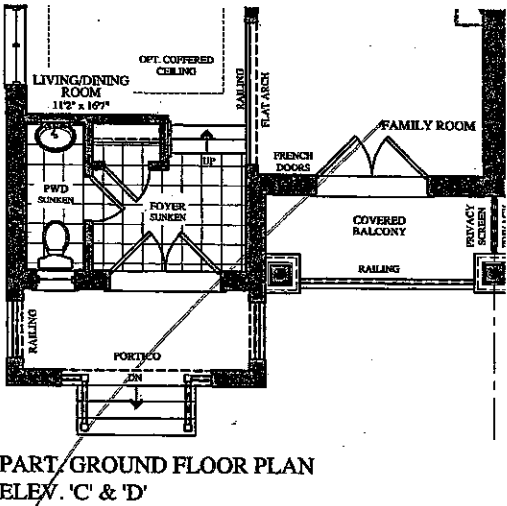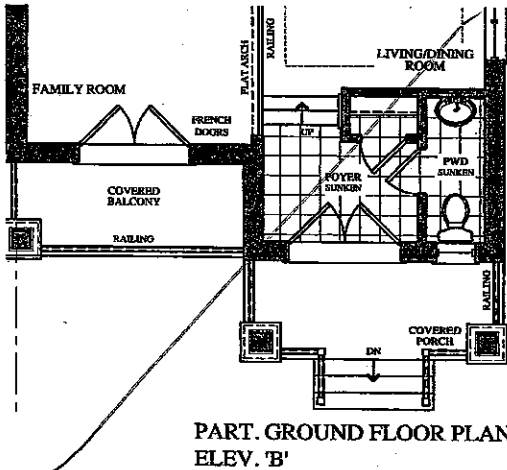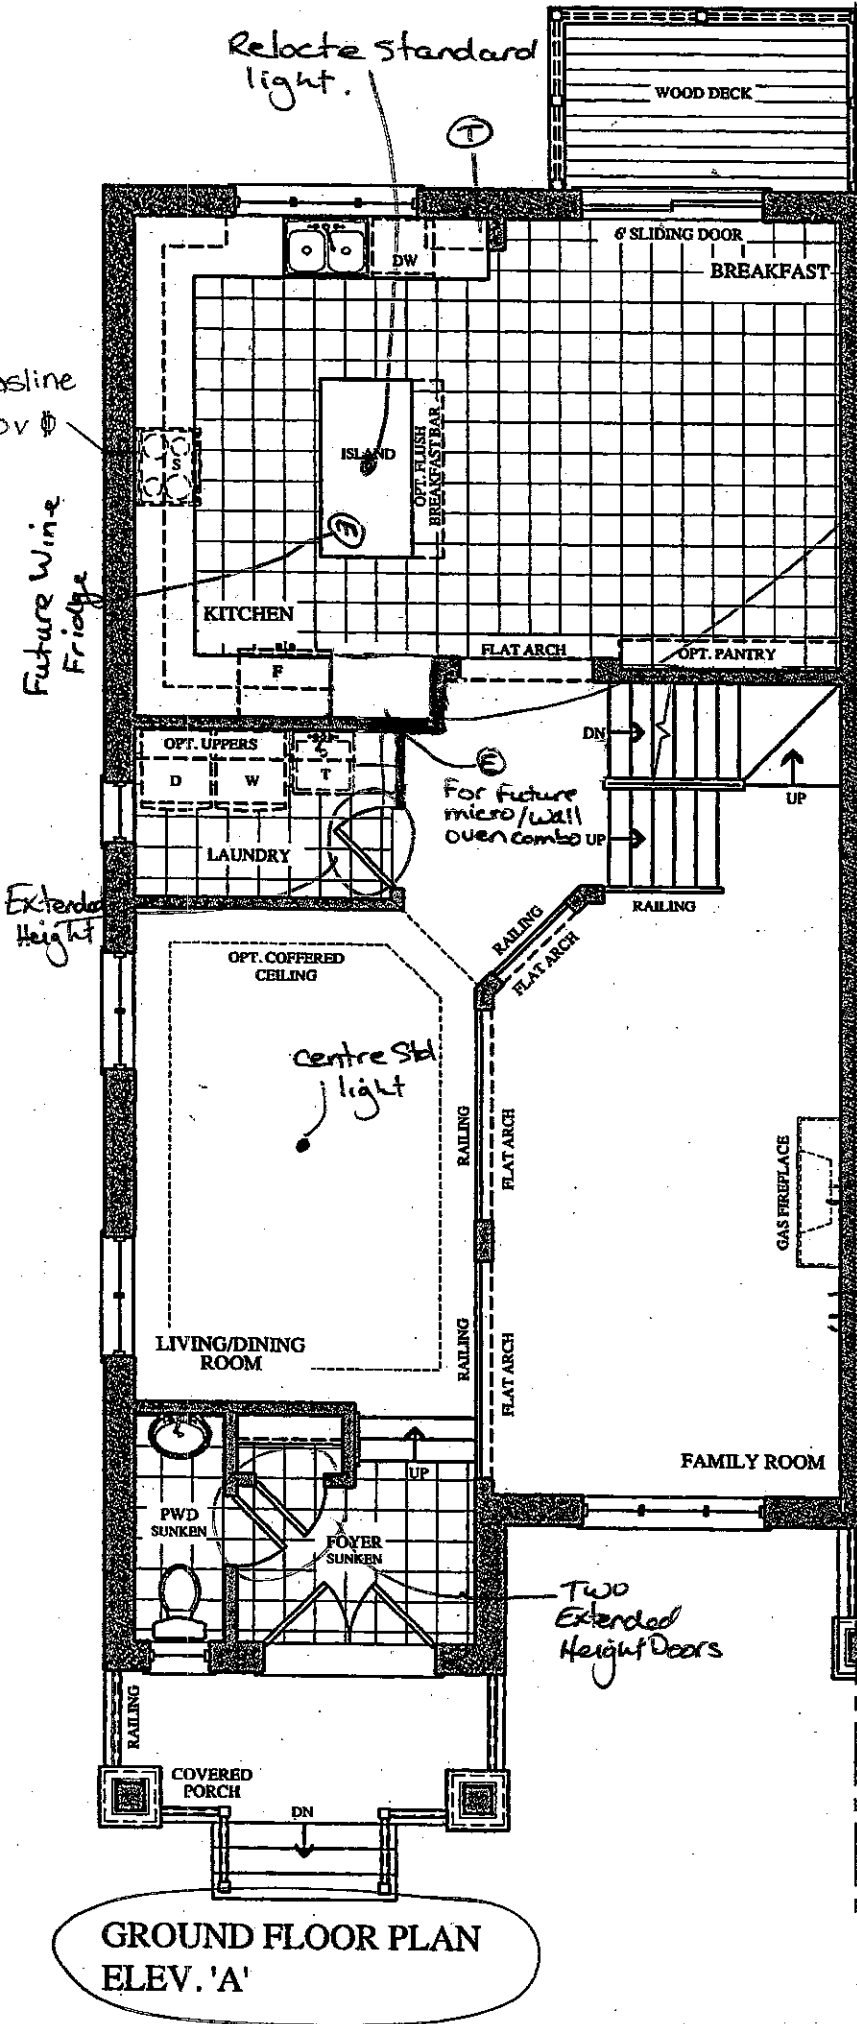

Lot 21 L
 June 12, 17



Handwritten mark or signature.

The Beethoven


SEMI SERIES

Elevation A • 2,372 sq.ft.
 Elevation B • 2,372 sq.ft.
 Elevation C • 2,372 sq.ft.
 Elevation D • 2,372 sq.ft.


• Smooth Ceiling

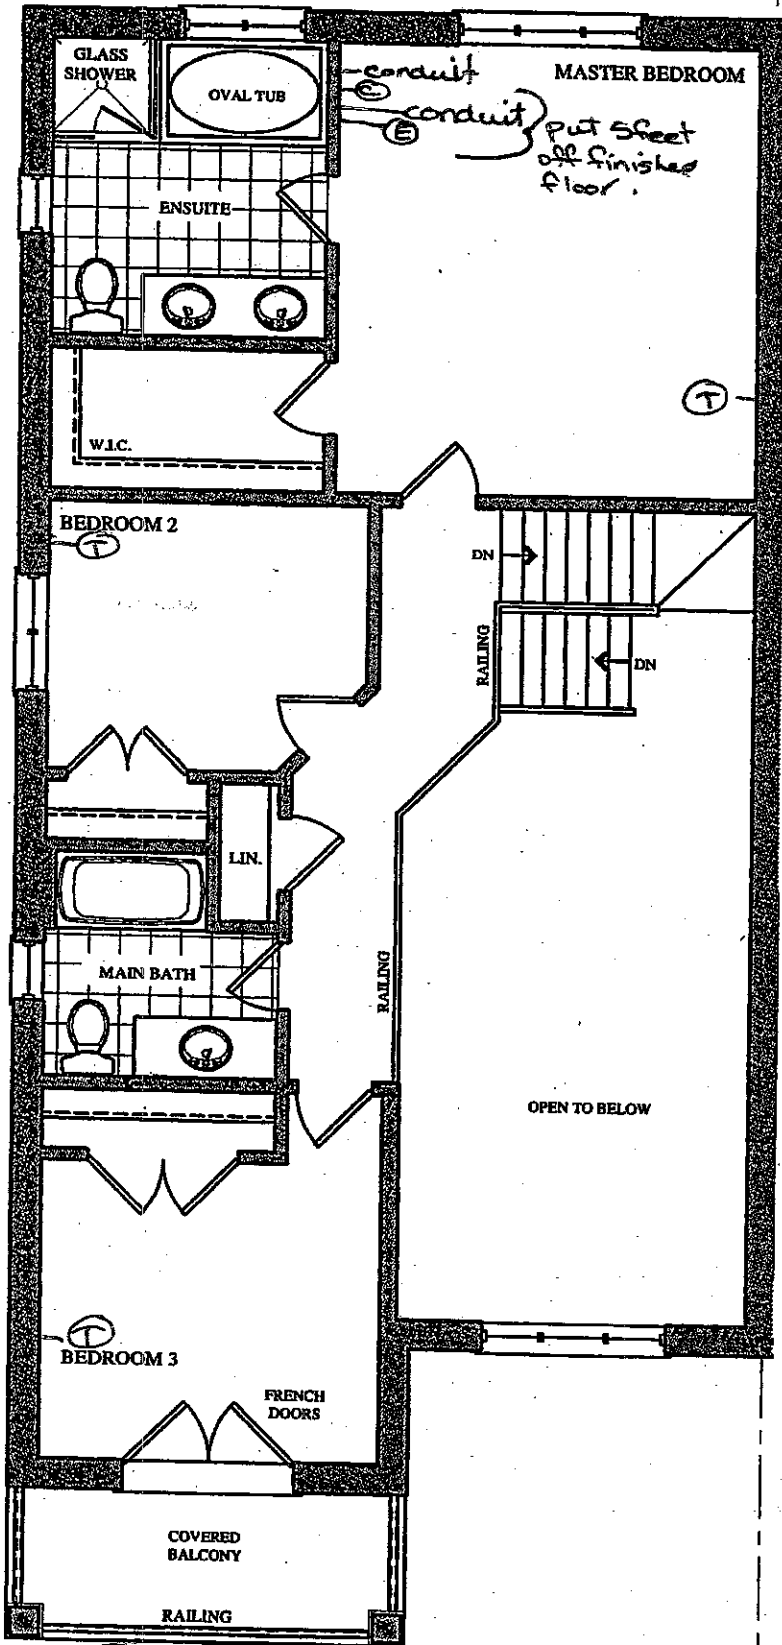

SECOND FLOOR PLAN
 ELEV. 'A'

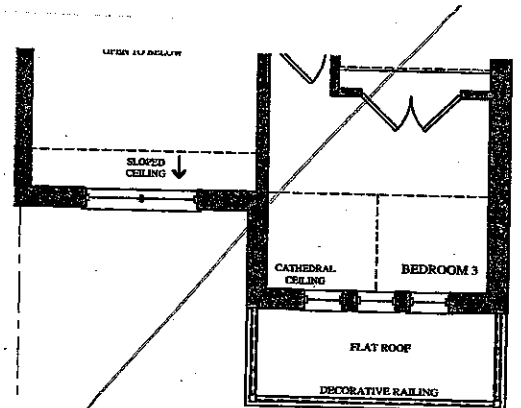

PART. SECOND FLOOR PLAN
 ELEV. 'B'

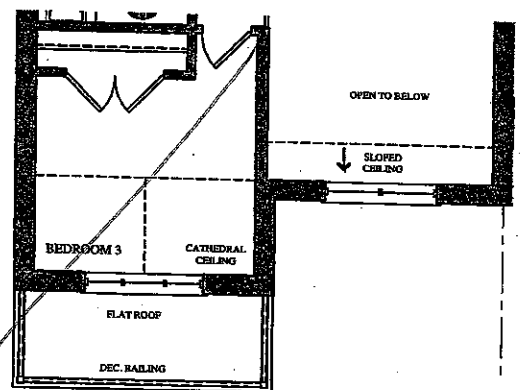


PART. SECOND FLOOR PLAN
 ELEV. 'C' & 'D'

Lot 21 L
 June 12, 17

The Beethoven

SEMI SERIES

Elevation A • 2,372 sq.ft.
 Elevation B • 2,372 sq.ft.
 Elevation C • 2,372 sq.ft.
 Elevation D • 2,372 sq.ft.

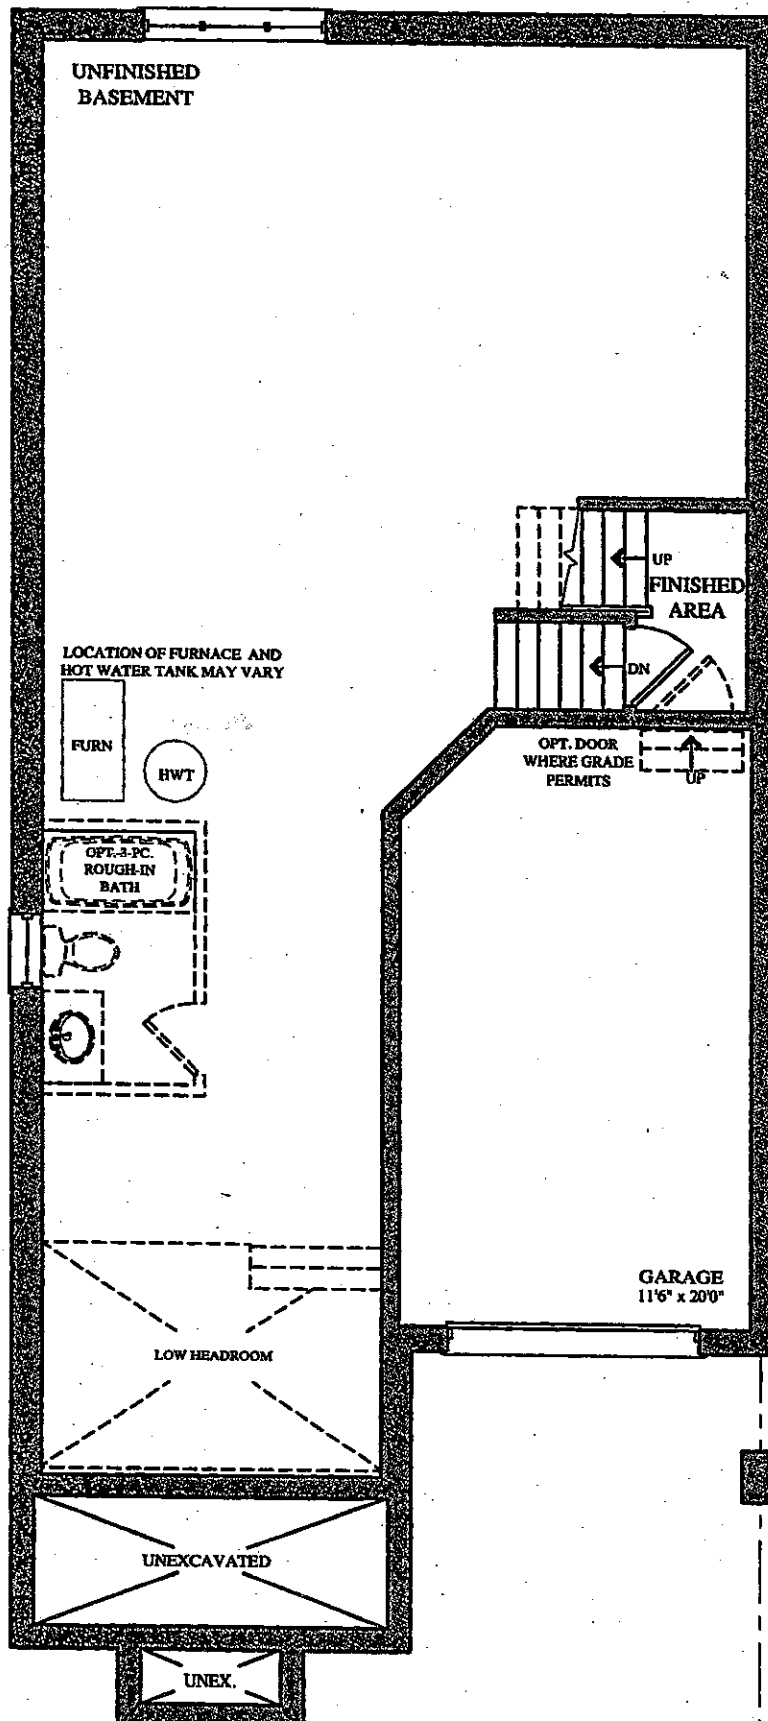

Lot 21L
June 21, 17

BASEMENT FLOOR PLAN
 ELEV. 'A', 'B', 'C' & 'D'

Lot 21L

30" (76.2 CM) AND 36" (91.4 CM) GAS BUILT-IN COOKTOP

PRODUCT MODEL NUMBERS

KCGS950E	KCGS956E	MKG9530E	WGS9500E
KCGS956E	KCGS956E	MKG9500E	WGS9500E
KCGS950E	MKG9530E	WGS9500E	WGS9500E
KCGS956E	MKG956E	WGS9500E	

GAS SUPPLY REQUIREMENTS

Type of Gas

Natural Gas:

- This cooktop is factory set for use with Natural gas. If converting to LP gas, see the "LP Gas Conversion" instructions provided in the package containing literature. The model/serial rating plate located on the underside of the cooktop base has information on the types of gas that can be used. If the types of gas listed do not include the type of gas available, check with the local gas supplier.

LP Gas Conversion:

Conversion must be done by a qualified service technician.

No attempt shall be made to convert the cooktop from the gas specified on the model/serial rating plate for use with a different gas without consulting the serving gas supplier. See the Gas Conversion instructions provided in the package containing literature.

Gas Supply Line

- Provide a gas supply line of 3/4" (1.9 cm) rigid pipe to the cooktop location. A smaller size pipe on longer runs may result in insufficient gas supply. Pipe-joint compounds that resist the action of LP gas must be used. Do not use TEFLON® tape. With LP gas, piping or tubing size should be 1/2" minimum. Usually, LP gas suppliers determine the size and materials used in the system.

Flexible metal appliance connector:


- If local codes permit, use a 1/2" or 3/4" I.D. flexible stainless steel tubing gas connector, designed by CSA to connect the cooktop to the rigid gas supply line.



- A 1/2" male pipe thread is needed for connection to the female pipe threads of the inlet to the cooktop pressure regulator.
- Do not kink or damage the flexible metal tubing when moving the cooktop.

• Must include a shutoff valve:

The supply line must be equipped with a manual shutoff valve. This valve should be located in the same room but external to the cooktop opening, such as an adjacent cabinet. It must be accessible without removing the cooktop, and it should be in a location that allows ease of opening and closing. Do not block access to shutoff valve. The valve is for turning on or shutting off gas to the cooktop.

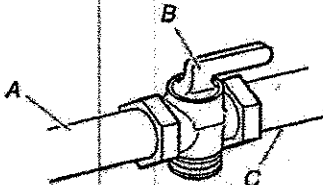

A. Gas supply line
B. Shutoff valve "open" position
C. To cooktop


*TEFLON is a registered trademark of E.I. Du Pont De Nemours and Company.

ELECTRICAL REQUIREMENTS

- A 120-volt, 60 Hz, AC only, 15-amp, fused electrical circuit is required. A time-delay fuse or circuit breaker is also recommended. It is recommended that a separate circuit serving only this cooktop be provided.
- Electronic ignition systems operate within wide voltage limits, but proper grounding and polarity are necessary. Check that the outlet provides 120-volt power and is correctly grounded.


PRODUCT DIMENSIONS

KCGS550ESS and KCGS950ESS Models

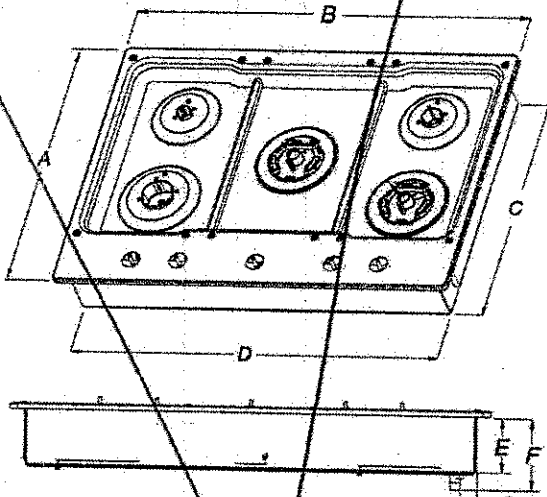


- A. 21" (53.3 cm)
- B. 30" (76.2 cm)
- C. 19 3/8" (49.2 cm)
- D. 28 3/8" (72.1 cm)
- E. 3 3/8" (9.2 cm)
- F. 4 1/8" (11.6 cm)
- G. 1 3/8" (3.4 cm)

KCGS556ESS and KCGS956ESS Models

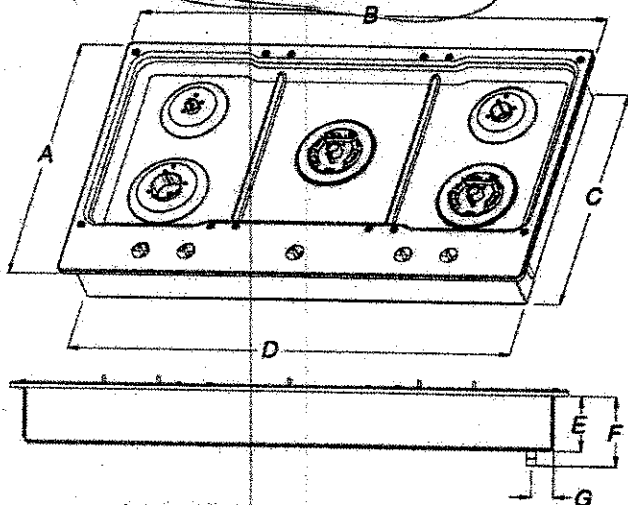


- A. 21" (53.3 cm)
- B. 36 1/2" (92.0 cm)
- C. 19 3/8" (49.2 cm)
- D. 34 3/8" (88.1 cm)
- E. 3 3/8" (9.2 cm)
- F. 4 1/8" (11.6 cm)
- G. 1 3/8" (3.6 cm)

All Other 30" (76.2 cm) Models

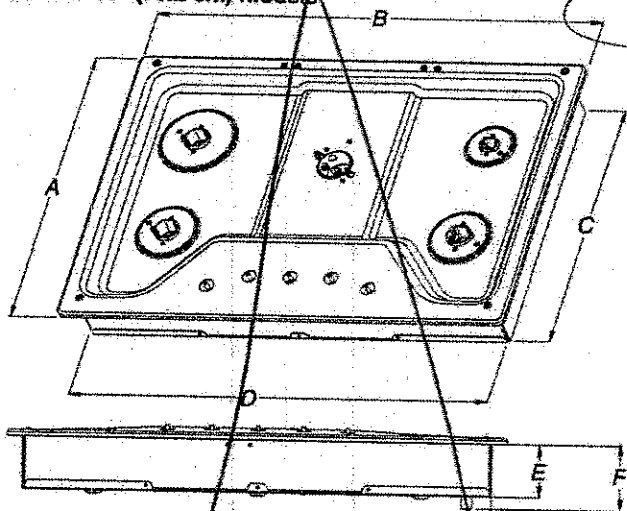


- A. 21" (53.3 cm)
- B. 30" (76.2 cm)
- C. 18 7/8" (48.0 cm)
- D. 28 3/8" (72.1 cm)
- E. 3 3/8" (8.6 cm)
- F. 4 1/8" (10.5 cm)
- G. 1 1/2" (3.8 cm)

All Other 36" (91.4 cm) Models

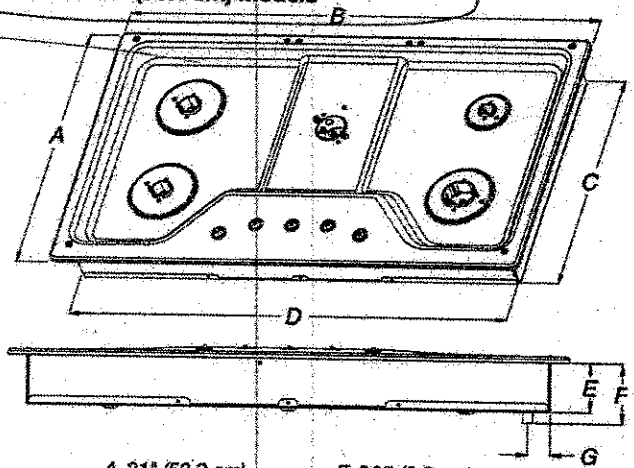


- A. 21" (53.3 cm)
- B. 36" (91.4 cm)
- C. 18 7/8" (48.0 cm)
- D. 33 3/4" (85.7 cm)
- E. 3 3/8" (8.6 cm)
- F. 4 1/8" (10.5 cm)
- G. 1 1/2" (3.8 cm)

CABINET DIMENSIONS

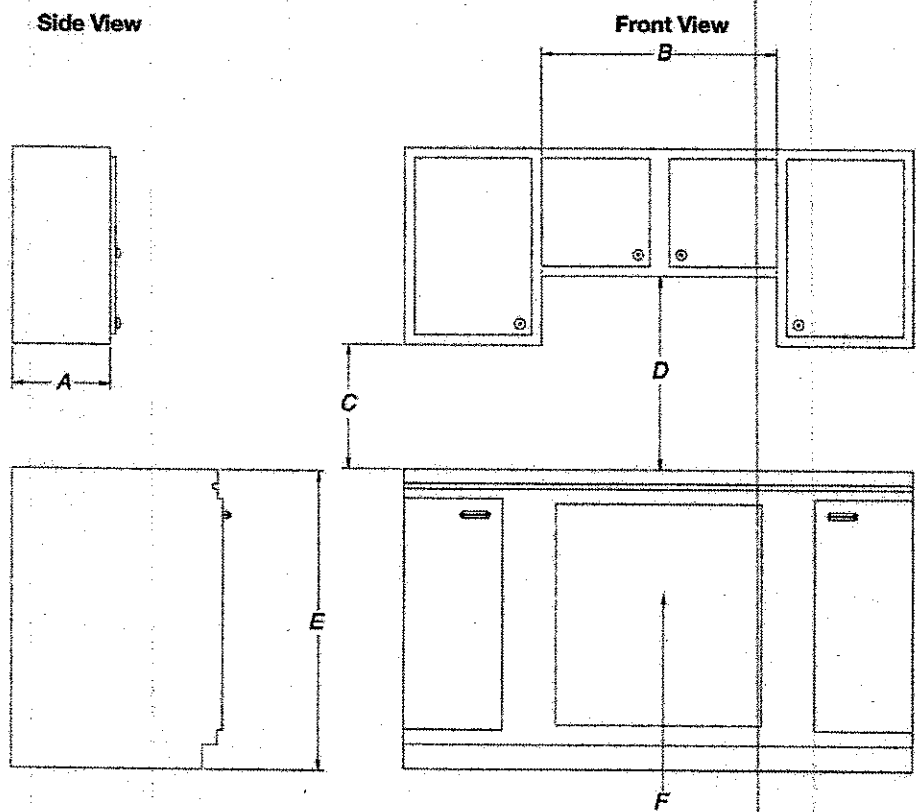

- A. 13" (33.0 cm) recommended upper cabinet depth.
- B. 30" (76.2 cm) for 30" models; 36" (91.4 cm) for 36" models.
- C. 18" (45.7 cm) minimum clearance from upper cabinet to countertop within minimum horizontal clearances to cooktop.
- D. 30" (76.2 cm) minimum clearance between top of cooktop platform and bottom of uncovered wood or metal cabinet. 24" (61 cm) minimum clearance if bottom of wood or metal cabinet is covered by not less than 1/4" (0.6 cm) flame retardant millboard covered with not less than No. 28 MSG sheet steel, 0.015" (0.04 cm) stainless steel, or 0.024" (0.06 cm) aluminum or 0.020" (0.05 cm) copper.
- E. 36" (91.4 cm) top of countertop to floor.
- F. Gas line opening - Wall: anywhere 5" (12.7 cm) below underside of countertop. Cabinet floor: anywhere within 6" (15.2 cm) of rear wall is recommended.

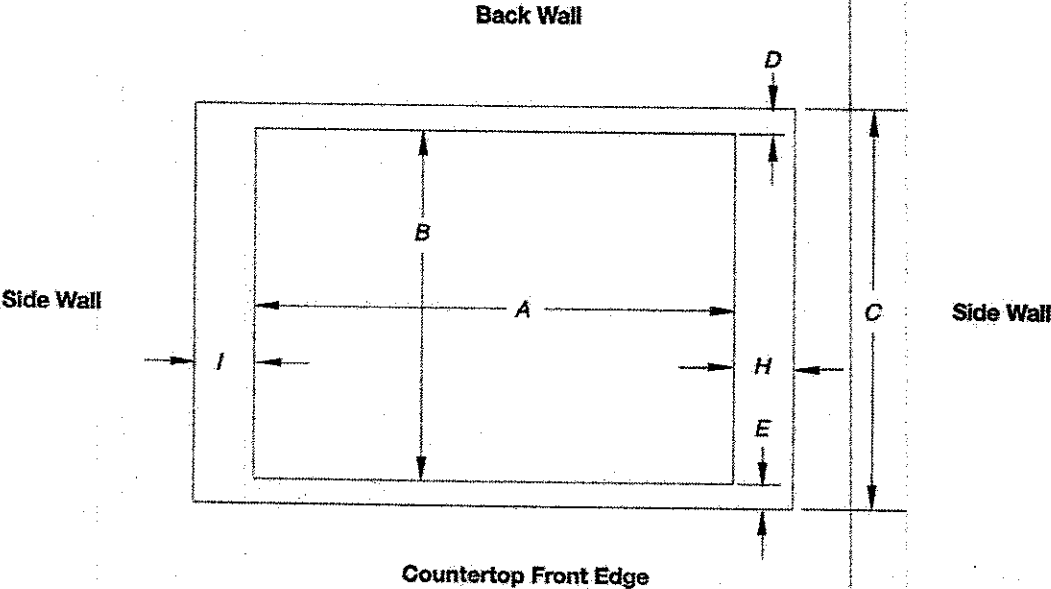

Cutout (Product Opening) Dimensions						
30" (76.2 cm) Models						
Models	A			B		
	Min	Recommended	Max	Min	Recommended	Max
KCGS550 and KCGS950	28 1/2" (72.4 cm)	28 7/8" (73.4 cm)	29 1/2" (74.3 cm)	19 1/2" (49.5 cm)	19 13/16" (50.2 cm)	20" (50.8 cm)
All Other 30" (76.2 cm) Models	28 1/2" (72.4 cm)	28 7/8" (73.4 cm)	29 1/2" (74.3 cm)	19" (48.3 cm)	19 1/2" (49.5 cm)	20" (50.8 cm)
36" (91.4 cm) Models						
KCGS556 and KCGS956	34 7/8" (88.4 cm)	35 1/8" (89.4 cm)	35 5/8" (90.3 cm)	19 1/2" (49.5 cm)	19 13/16" (50.2 cm)	20" (50.8 cm)
All Other 36" (91.4 cm) Models	33 7/8" (86.0 cm)	34 3/16" (87.0 cm)	35 1/4" (89.5 cm)	19" (48.3 cm)	19 1/2" (49.5 cm)	20" (50.8 cm)

Side Walls (Combustible Surfaces)	
Models	H and I
KCGS5 and KCGS9	H and I added together must be at least 48" (122.0 cm), with each side individually being at least 8" (20.3 cm).
KCGS350, KCGS356, MGC9536, WCG97US0, WCG97US6	H and I added together must be at least 48" (122.0 cm), with each side individually being at least 12" (30.5 cm).
All Other Models	Both have to be 8" (20.3 cm) or more.

Back Wall and Countertop Front Dimensions			
Models	C	D	E
KCGS550 and KCGS950	25" (63.5 cm)	2 7/8" (7.3 cm)	2 3/4" (6.9 cm)
All Other Models			3 1/2" (7.9 cm)

NOTES: After making the countertop cutout, some installations may require notching down the base cabinet side walls to clear the cooktop base. To avoid this modification, use a base cabinet with sidewalls wider than the cutout.

If cabinet has a drawer, a 4" (10.2 cm) depth clearance from the countertop to the top of the drawer (or other obstruction) in base cabinet is required. The drawer depth may need to be shortened to avoid interfering with the regulator.

IMPORTANT: If a built-in wall oven is to be installed below this cooktop, the grounded outlet and gas supply piping must be located in an adjacent cabinet.

This cooktop and its gas and electrical supply sources must be installed before the undercounter built-in wall oven is installed.

KitchenAid® ~~27" (68.6 cm)~~ and 30" (76.2 cm) Electric Built-In Microwave/Oven Combination

PRODUCT MODEL NUMBERS

~~KOCE500E~~

KOCE500E

~~KOCE500E~~

ELECTRICAL CONNECTION


If codes permit and a separate ground wire is used, it is recommended that a qualified electrical installer determine that the ground path and the wire gauge are in accordance with local codes. Check with a qualified electrical installer if you are not sure the oven is properly grounded.

This oven must be connected to a grounded metal, permanent wiring system.

Be sure that the electrical connection and wire size are adequate and in conformance with the National Electrical Code, ANSI/NFPA 70-latest edition or CSA Standards C22.1-94, Canadian Electrical Code, Part 1 and C22.2 No. 0-M91-latest edition, and all local codes and ordinances.

To properly install your oven, you must determine the type of electrical connection you will be using and follow the instructions provided for it here.

- Oven must be connected to the proper electrical voltage and frequency as specified on the model/serial/rating plate. See the following illustration.

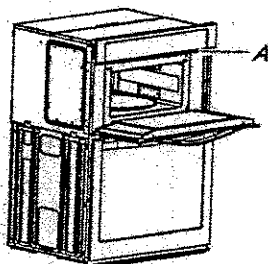

A. Model/serial/rating plate

- Models rated from 7.3 to 9.6 kW at 240 volts (5.4 to 7.4 kW at 208 volts) require a separate 40-amp circuit. Models rated at 4.8 kW and below at 240 volts (3.6 kW and below at 208 volts) require a separate 30-amp circuit.
- A circuit breaker is recommended.
- Connect directly to the fused disconnect (or circuit breaker box) through flexible, armored or nonmetallic sheathed, copper cable (with grounding wire). See "Make Electrical Connection" section.
- Flexible conduit from the oven should be connected directly to the junction box.
- Do not cut the conduit. The length of conduit provided is for serviceability of the oven.
- A UL listed or CSA approved conduit connector must be provided.
- If the house has aluminum wiring, follow the procedure below:
 - Connect a section of solid copper wire to the pigtail leads.
 - Connect the aluminum wiring to the added section of copper wire using special connectors and/or tools designed and UL listed for joining copper to aluminum.


Follow the electrical connector manufacturer's recommended procedure. Aluminum/copper connection must conform with local codes and industry accepted wiring practices.

For power requirements, refer to the following table.

Model	Voltage	Amperage (L1)*	Amperage (L2)*	Rating (W)
KOCE507E/KOCE500E	120/240	32	30	8000
KOCE507E/KOCE500E	120/208	30	28	6600


*Amperage values noted above are for information purposes only; the units are rated in watts.

PRODUCT DIMENSIONS

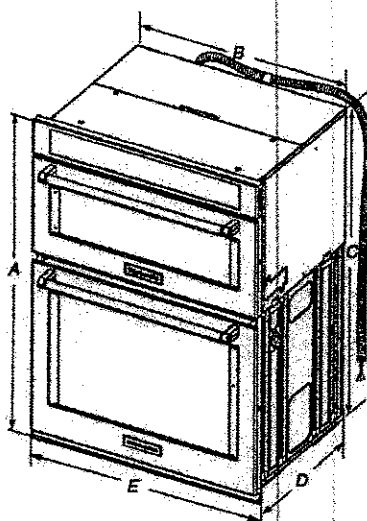

- 27" (68.6 cm) models**
- A. 42¹/₂" (108.0 cm) overall height
 - B. 23¹/₄" (59.1 cm) recessed width
 - C. 41" (104.1 cm) recessed height
 - D. 23¹/₄" (59.1 cm) max. recessed depth
 - E. 27" (68.6 cm) overall width
 - F. 48" (121.9 cm) flexible conduit length measured from the conduit clamp located at the rear of the oven. Do not remove the conduit clamp.
- 30" (76.2 cm) models**
- A. 42¹/₂" (108.0 cm) overall height
 - B. 28⁷/₈" (72.3 cm) recessed width
 - C. 41" (104.1 cm) recessed height
 - D. 23¹/₄" (59.1 cm) max. recessed depth
 - E. 30" (76.2 cm) overall width
 - F. 48" (121.9 cm) flexible conduit length measured from the conduit clamp located at the rear of the oven. Do not remove the conduit clamp.

Cabinet Dimensions

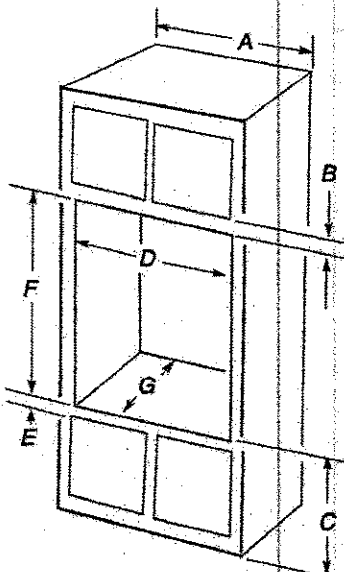

- 27" (68.6 cm) models**
- A. 27" (68.6 cm) min. cabinet width
 - B. 1" (2.5 cm) top of cutout to bottom of upper cabinet door
 - C. 19¹/₄" (48.9 cm) bottom of cutout to floor is recommended. 4"-19¹/₄" (10.2-48.9 cm) bottom of cutout to floor is acceptable.
 - D. 25¹/₂" (64.8 cm) cutout width
 - E. 1¹/₂" (3.8 cm) min. bottom of cutout to top of cabinet door
 - F. 41¹/₂" (105 cm)* recommended cutout height
 - G. 24" (60.7 cm) cutout depth
- 30" (76.2 cm) models**
- A. 30" (76.2 cm) min. cabinet width
 - B. 1" (2.5 cm) top of cutout to bottom
 - C. 19¹/₄" (48.9 cm) bottom of cutout to floor is recommended. 4"-19¹/₄" (10.2-48.9 cm) bottom of cutout to floor is acceptable.
 - D. 28¹/₂" (72.4 cm) cutout width
 - E. 1¹/₂" (3.8 cm) min. bottom of cutout
 - F. 41¹/₂" (105 cm)* recommended cutout
 - G. 24" (60.7 cm) cutout depth

* NOTE: The cabinet height can be between 41" (104.1 cm) and 41¹/₂" (105.6 cm) for microwave/oven combination.

Because Whirlpool Corporation includes a continuous commitment to improve our products, we reserve the right to change materials and specifications without notice.

Dimensions are for planning purposes only. For complete details, see installation instructions packed with product. Specifications subject to change without notice.

Ref. W10725683B
2/10/15

Wine Cellar


PRODUCT MODEL NUMBERS

KUWL204E	KUWL304E
KUWR204E	KUWR304E

Electrical: A 115 volt, 60 Hz., AC only, 15- or 20-amp fused, grounded electrical supply is required. It is recommended that a separate circuit serving only your wine cellar be provided. Use an outlet that cannot be turned off by a switch. Do not use an extension cord.


NOTE: Before performing any type of installation, clearing, or removing a light bulb, unplug wine cellar or disconnect power.

OPENING DIMENSIONS

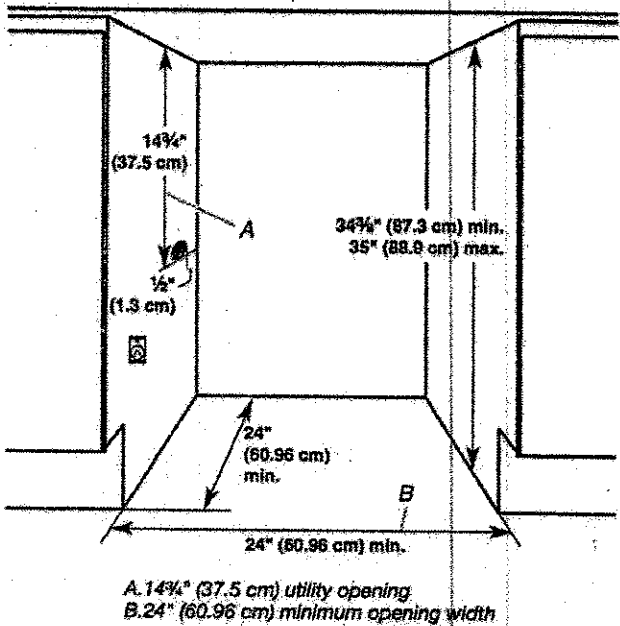

- Height dimensions are shown with the leveling legs extended to the minimum height. **NOTE:** When leveling legs are fully extended, add 5/8" (15 mm) to the height dimensions.
- If the floor of the opening is not level with the kitchen floor, shim the opening to make it level with the kitchen floor.

LOCATION REQUIREMENTS

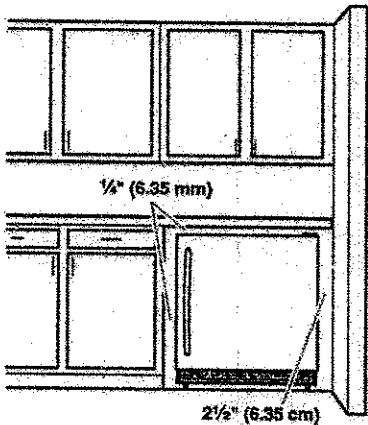

- For the wine cellar to be flush with the front of the base cabinets, remove any baseboards or moldings from the rear of the opening. See "Opening Dimensions" later in this section.
- It is recommended that you do not install the wine cellar near an oven, radiator, or other heat source.
- Do not install in a location where the temperature will fall below 55°F (13°C). For best performance, do not install the wine cellar behind a cabinet door or block the base grille.

PRODUCT MODEL NUMBERS

~~KVWB600D~~ **KVWB606D**

Electrical: A 120 volt, 60 Hz., AC only, 15-amp, fused electrical circuit is required.

VENTING METHODS

This canopy range hood is factory set for venting through the roof or through the wall.

A 6" (15.2 cm) round vent system is needed for installation (not included). The hood exhaust opening is 6" (15.2 cm) round.

NOTE: Flexible vent is not recommended. Flexible vent creates back pressure and air turbulence that greatly reduce performance.

Vent system can terminate either through the roof or wall. To vent through a wall, a 90° elbow is needed.


Rear Discharge

A 90° elbow may be installed immediately above the hood.

For Non-Vented (Recirculating) Installations

If it is not possible to vent cooking fumes and vapors to the outside, the hood can be used in the non-vented (recirculating) version, using a Recirculation Kit (which includes charcoal filters and a deflector). To order, see the "Assistance or Service" section.

Roof Venting Wall Venting Non-Vented (Recirculating)

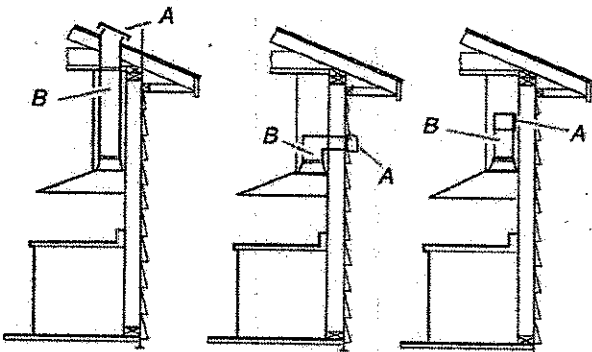

A. Roof cap
B. 6" (15.2 cm) round vent

A. Wall cap
B. 6" (15.2 cm) round vent

A. Diverter
B. 6" (15.2 cm) round vent

Calculating Vent System Length


To calculate the length of the system you need, add the equivalent feet (meters) for each vent piece used in the system.

Vent System

Vent Piece	6" (15.2 cm) Round	
45° elbow	2.5 ft (0.8 m)	
90° elbow	5.0 ft (1.5 m)	

Maximum equivalent vent length is 35 ft (10.7 m).


Example Vent System

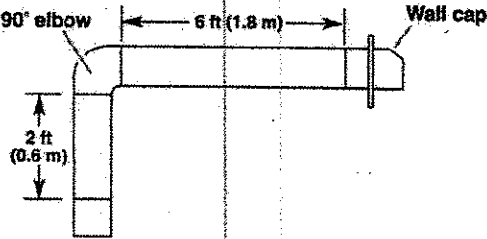

The following example falls within the maximum recommended vent length of 35 ft (10.7 m).

1 - 90° elbow	= 5.0 ft (1.5 m)
1 - wall cap	= 0.0 ft (0.0 m)
8 ft (2.4 m) straight	= 8.0 ft (2.4 m)
Length of system	= 13.0 ft (3.9 m)


PRODUCT DIMENSIONS

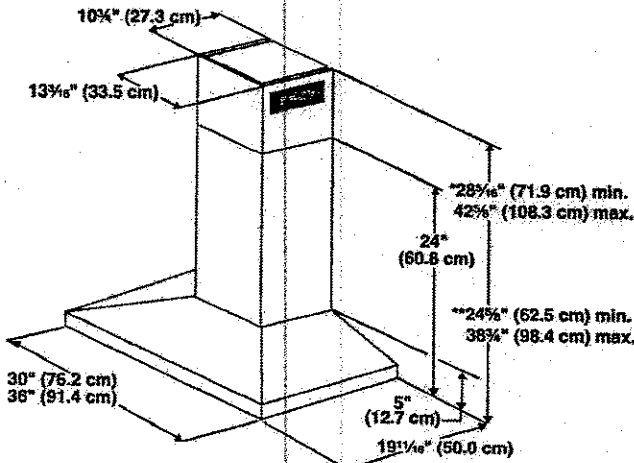

*For non-vented (recirculating) installations

**For vented installations

CABINET DIMENSIONS

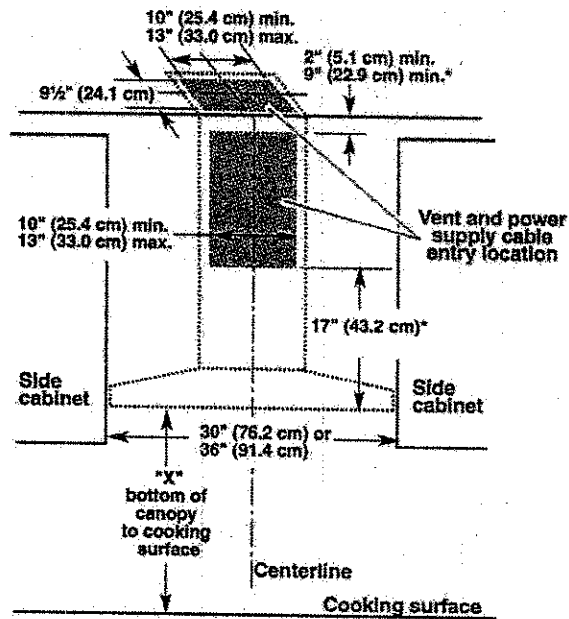

*For non-vented (recirculating) installations

IMPORTANT:

- Minimum distance "X": 24" (61.0 cm) from electric cooking surface.
- Minimum distance "X": 27" (68.6 cm) from gas cooking surfaces.
- Suggested maximum distance "X": 36" (91.4 cm)

The chimneys can be adjusted for different ceiling heights. See the following chart.

Vented Installations		
	Min. ceiling height	Max. ceiling height
Electric cooking surface	7' 1" (2.16 m)	9' 2" (2.79 m)
Gas cooking surface	7' 4" (2.23 m)	9' 2" (2.79 m)
Non-vented (recirculating) Installations		
	Min. ceiling height	Max. ceiling height
Electric cooking surface	7' 1" (2.16 m)	9' 6" (2.9 m)
Gas cooking surface	7' 4" (2.23 m)	9' 6" (2.9 m)

*NOTE: The range hood chimneys are adjustable and designed to meet varying ceiling or soffit heights depending on the distance "X" between the bottom of the range hood and the cooking surface. For higher ceilings, a Chimney Extension Kit is available from your dealer or an authorized parts distributor. The chimney extension replaces the chimney shipped with the range hood. To order, see the "Assistance or Service" section.



27" x 38.74" x 3...

Net Dimension (WxHxD)

103 kg

Net Weight

HIDE ALL SPECS

Washing Capacity

Washing Capacity (cu.ft)
5.2

Design

Body color
Black Stainless

Door
Add Wash

Panel Display
LED

Performance

Cycle time (min)
45

Energy Consumption (annual)
100

IMEF
2.8

IWF
5

Feature

AddWash
Yes

Spin Speed
1500

Cycle