

Brampton Encore - 47L - 2 - 28-2 Elev.A SIREN
CENTRAL VAC AND WIRING

Inv.1,375	1 - MASTER BEDROOM: INSTALL ROUGH-IN FOR EXTRA SECURITY KEY PAD, TO GO BY LIGHT SWITCH
Line21600	Note:
18May17 / 13Jul17	
Inv.1,375	1 - TELEPHONE AND CABLE ROUGH-IN LOCATIONS
Line21599	Note: **DELETE STANDARD PHONE IN KITCHEN** (NO CREDIT)
18May17 / 13Jul17	
Inv.1,375	1 - FAMILY ROOM: INSTALL CONDUIT PIPE- FOR TELEVISION- MUST SPECIFY LOCATION AND TERMINATION POINT
Line21603	Note:
18May17 / 13Jul17	

ELECTRICAL

Inv.1,375	1 - FAMILY ROOM: INSTALL 110V WALL RECEPTACLE ON DEDICATED CIRCUIT - ABOVE FIREPLACE FOR TV
Line21604	Note:
18May17 / 13Jul17	
Inv.1,375	1 - KITCHEN: INSTALL 110V WALL RECEPTACLE ON DEDICATED CIRCUIT - FOR MICROWAVE - MICROWAVE NOT INCLUDED, TO GO ABOVE STOVE
Line21632	Note:
18May17 / 13Jul17	

Exterior Colours

Inv.1,375	1 - EXTERIOR COLOUR PACKAGE 8
Line23351	Note:
18May17 / 13Jul17	

MISC.


Inv.1,375	1 - BONUS PACKAGE: \$1045.25 (INCLUDING TAXES) WORTH OF UPGRADES FROM GOLD PARK HOMES DÉCOR CENTRE IS BEING APPLIED TOWARD THE STRUCTURAL APPOINTMENT. PURCHASER HAS A REMAINING AMOUNT OF \$3954.75 (INCLUDING TAXES) TO BE USED TOWARD THE COLOUR APPOINTMENT
Line21726	Note:
18May17 / 13Jul17	
Inv.1,375	1 - Purchaser has attended a Structural appointment at the Decor Centre & has DECLINED any additional upgrades and accepts and acknowledges that there will be no further structural changes/additions/deletions to be made upon signing on May 24, 2017
Line21727	Note:
18May17 / 13Jul17	
Inv.1,375	1 - Purchasers are aware & accepts that ANY changes made to upgrades after signing this Purchasers Extra Form are subject to a minimum administration fee of \$500. PLUS a 10% holdback fee
Line21728	Note:
18May17 / 13Jul17	

Telephone — (T)
 Cable — (C)
 Electrical — (E)

The Siren


SEMI SERIES

Elevation A • 1,688 sq.ft.
 Elevation B • 1,677 sq.ft.
 Elevation C • 1,687 sq.ft.

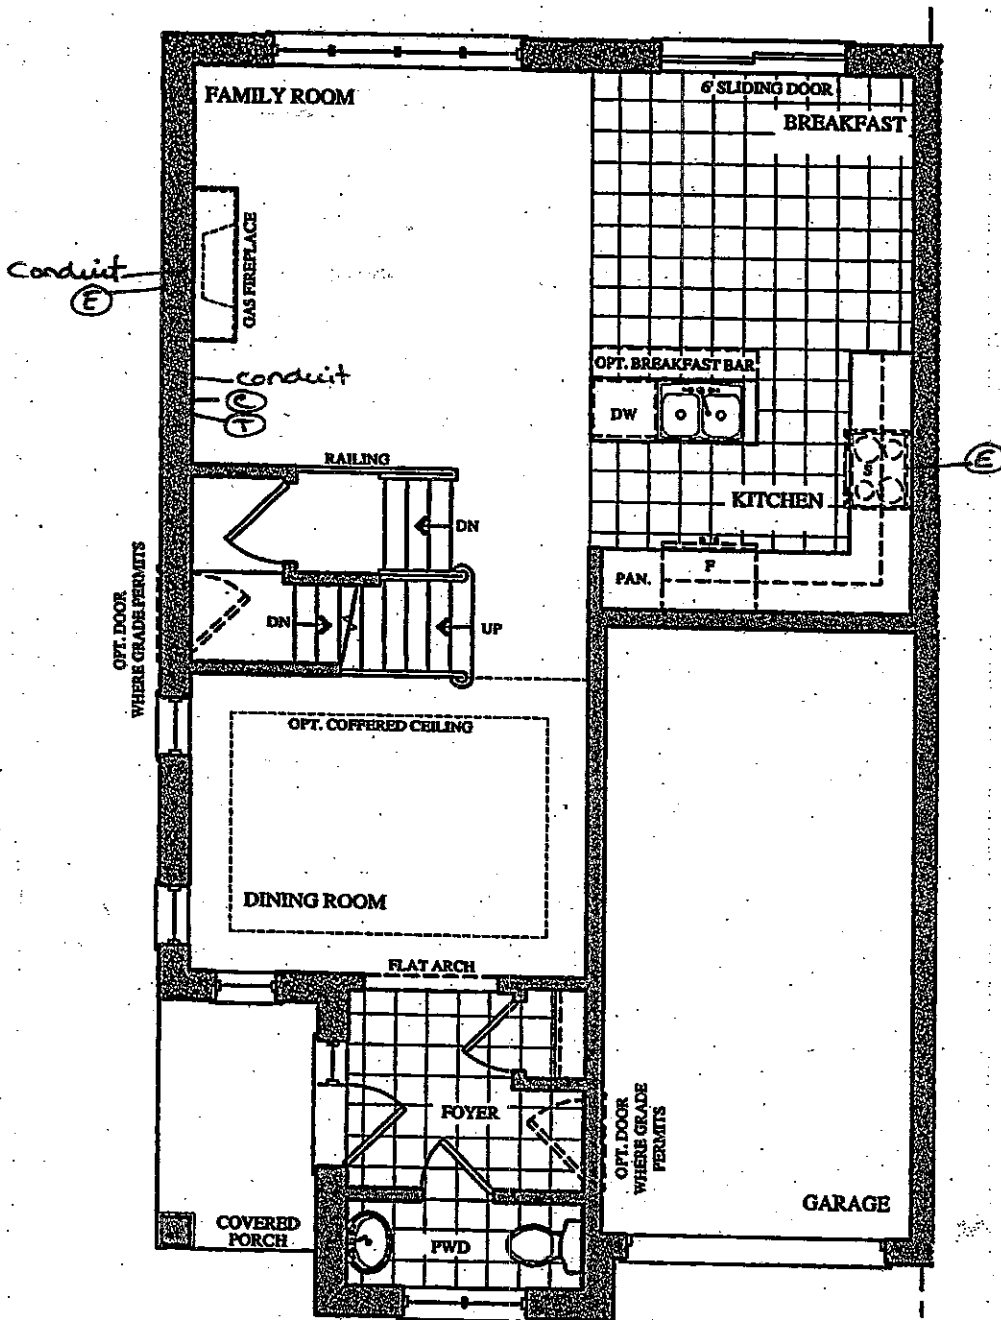

GROUND FLOOR PLAN
 ELEV. (A) & 'B'

Lot 47L
 May 18, 17

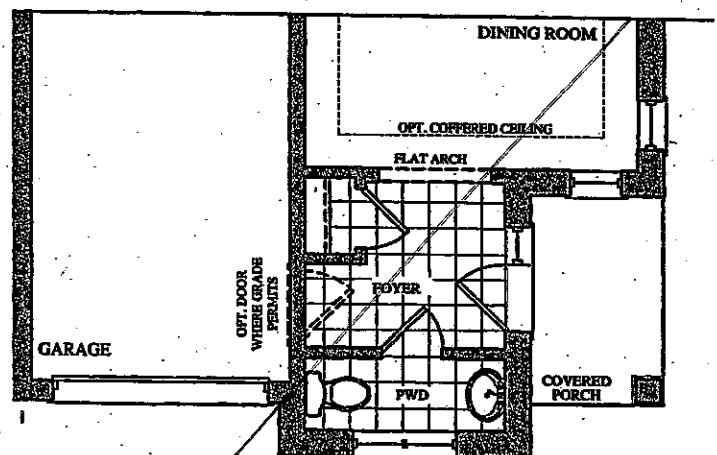

PART. GROUND FLOOR PLAN
 ELEV. 'C'

Telephone — (T)

Cable — (C)

Electrical — (E)


The Siren

SEMI SERIES


Elevation A • 1,688 sq.ft.

Elevation B • 1,677 sq.ft.


Elevation C • 1,687 sq.ft.

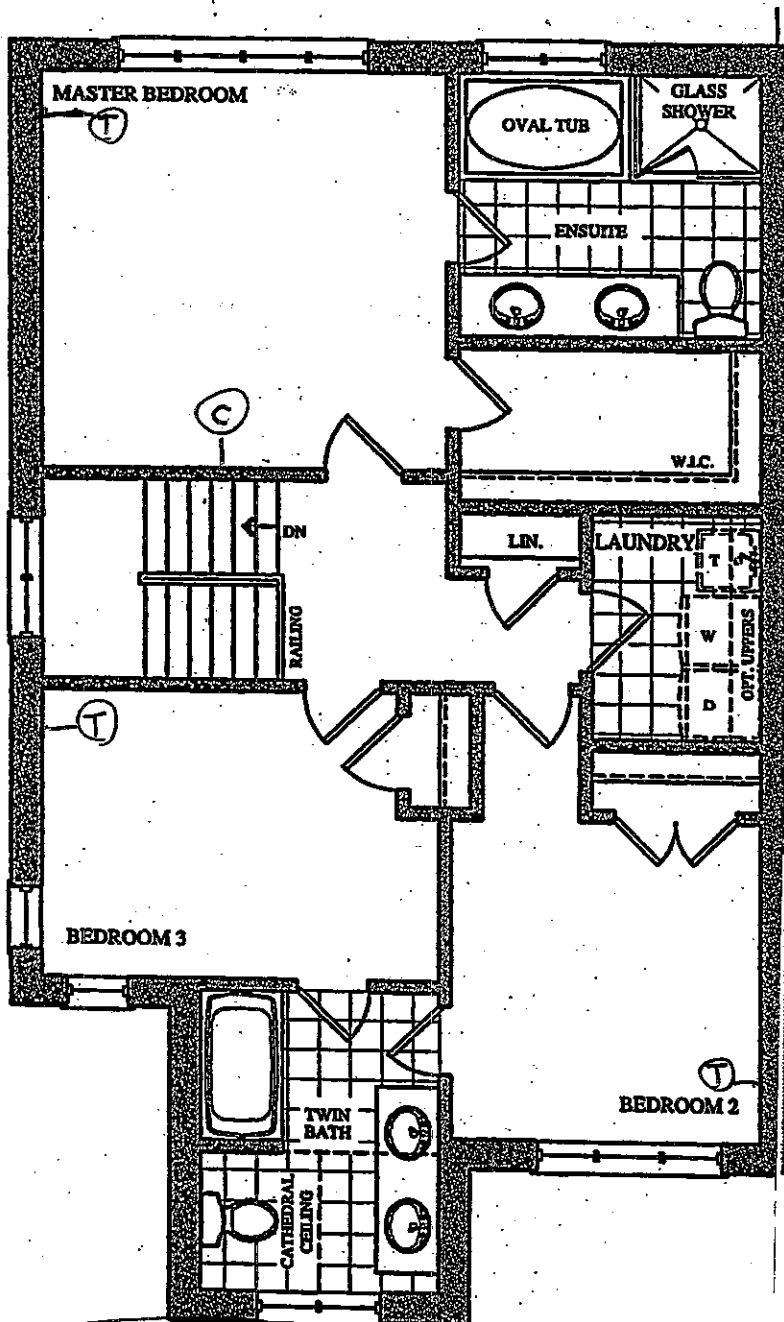

SECOND FLOOR PLAN
ELEV. 'A'

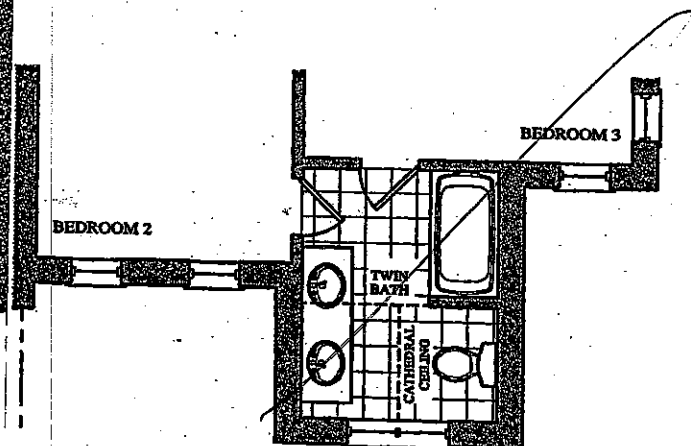

PART. SECOND FLOOR PLAN
ELEV. 'B'

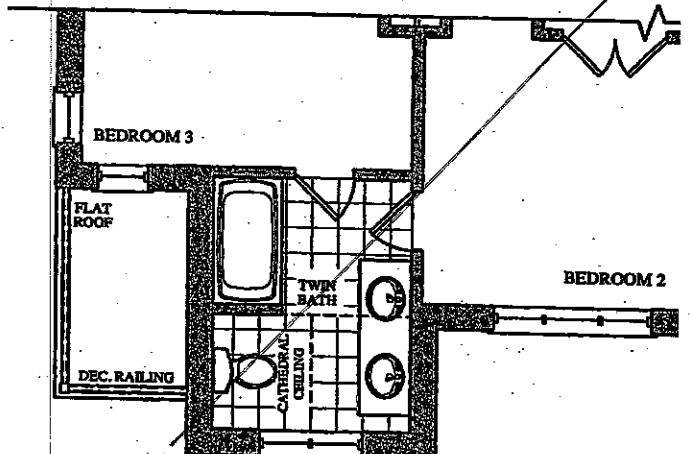

PART. SECOND FLOOR PLAN
ELEV. 'C'

Lot 47 L
May 18, 17




The Siren

SEMI SERIES

Elevation A • 1,688 sq.ft.

Elevation B • 1,677 sq.ft.

Elevation C • 1,687 sq.ft.

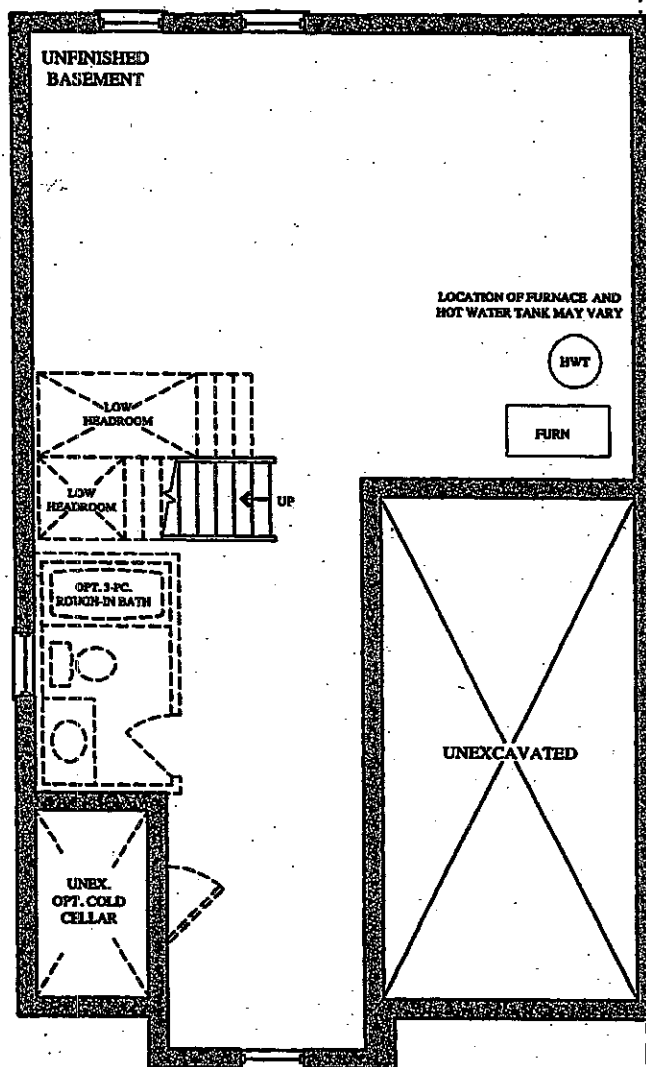

BASEMENT FLOOR PLAN
ELEV. 'A', 'B' & 'C'

Lot 47L
May 18, 17
○