

Brampton Encore - 19R - 2 - 28-2 Elev.CR SIREN
CENTRAL VAC AND WIRING

Inv.1,354	1 - UPPER HALL: ROUGH-IN FOR EXTRA SECURITY KEY PAD
Line21311	Note: See plan for location.
9May17 / 29Aug17	
Inv.1,354	1 - FAMILY ROOM: CONDUIT PIPE- FOR TELEVISION- LOCATE APPROX. 66" A.F.F. ABOVE FIREPLACE, TERMINATING BY CABLE OUTLET
Line21312	Note:
9May17 / 29Aug17	

CONCRETE AND DRAIN

Inv.1,354	1 - BASEMENT: BACKFLOW PREVENTER VALVE
Line21325	Note:
9May17 / 29Aug17	

ELECTRICAL

Inv.1,354	1 - FAMILY ROOM: 110V WALL RECEPTACLE ON NORMAL CIRCUIT- LOCATE APPROX. 66" A.F.F. ABOVE FIREPLACE FOR FUTURE TV
Line21313	Note:
9May17 / 29Aug17	
Inv.1,354	1 - KITCHEN: MOVE STANDARD CEILING LIGHT TO APPROX. CENTER ABOVE ISLAND
Line21314	Note:
9May17 / 29Aug17	
Inv.1,354	1 - KITCHEN: GAS LINE ROUGH - GROUND FLOOR (WITH REQUIRED ELECTRICAL) INCLUDE 110 V PLUG
Line23968	Note:
9May17 / 29Aug17	
Inv.1,354	1 - HUMIDIFIER: WB3 - 17 (UP TO 3,000 SQ.FT.)
Line23975	Note:
9May17 / 29Aug17	

Exterior Colours

Inv.1,354	1 - EXTERIOR PACKAGE 7
Line23966	Note:
9May17 / 29Aug17	

FRAMING

Inv.1,354	4 - MAIN FLOOR: FRAME MAIN FLOOR DOORS AT 96" - ADDED WITH THE ADDITION OF TALLER INTERIOR DOORS
Line21316	Note:
9May17 / 29Aug17	
Inv.1,354	1 - KITCHEN: UPGRADE VENTING FOR STOVE TO 8" PIPE EXTERIOR WALL
Line23969	Note:
9May17 / 29Aug17	

HVAC

Inv.1,354	1 - HUMIDIFIER: WB3 - 17 (UP TO 3,000 SQ.FT.)
Line21319	Note:
9May17 / 29Aug17	

Brampton Encore - 19R - 2 - 28-2 Elev.CR SIREN

Inv.1,354	1 - KITCHEN: GAS LINE ROUGH - GROUND FLOOR (WITH REQUIRED ELECTRICAL) INCLUDE 110 V PLUG
Line21318	Note:
9May17 / 29Aug17	
Inv.1,354	1 - KITCHEN: UPGRADE VENTING FOR STOVE TO 8" PIPE EXTERIOR WALL
Line21320	Note:
9May17 / 29Aug17	
Inv.1,354	1 - 2.0 TON A/C - Up to 2000sq.ft
Line21321	Note:
9May17 / 29Aug17	

INTERIOR TRIM AND DOORS

Inv.1,354	3 - MAIN FLOOR: STANDARD DOOR EXTENDED HEIGHT 96" (PRICE PER DOOR) MAIN FLOOR 3 STOREY MODELS --96"
Line21322	Note:
9May17 / 29Aug17	
Inv.1,354	1 - MAIN FLOOR: EXTENDED HEIGHT ARCHWAY (PRICE PER DOORWAY) -96"
Line21323	Note:
9May17 / 29Aug17	

MISC.

Inv.1,354	1 - GRADE DID NOT PERMIT- TO BE REFUNDED ON COLOUR SIDE DOOR- HOME TO EXTERIOR- AS PER PLAN AND GRADE PERMITTING
Line21315	Note:
9May17 / 29Aug17	
Inv.1,354	1 - REFUNDED- GRADE DID NOT PERMIT MAIN FLOOR: EXTENDED HEIGHT MAN DOOR (DOOR FROM GARAGE TO FOYER) - 96"
Line21324	Note:
9May17 / 29Aug17	
Inv.1,354	1 - Purchaser has attended an appointment at the Decor Centre & has DECLINED any additional upgrades and accepts and acknowledges that there will be no further changes/additions/deletions to be made upon signing on May 9 2017.
Line21327	Note:
9May17 / 29Aug17	
Inv.1,354	1 - BONUS PACKAGE: \$5,000.00 (INCLUDING TAXES) WORTH OF UPGRADES FROM GOLD PARK HOMES DÉCOR CENTRE IS BEING **DEFERRED** TO THE STRUCTURAL APPOINTMENT. PURCHASER HAS A REMAINING AMOUNT OF \$5000 (INCLUDING TAXES) TO BE USED TOWARD THE COLOUR APPOINTMENT.
Line21328	Note:
9May17 / 29Aug17	
Inv.1,354	1 - NO MANDOOR- GRADE DID NOT PERMIT
Line23971	Note:
9May17 / 29Aug17	

PLUMBING

Inv.1,354	1 - HUMIDIFIER: WB3 - 17 (UP TO 3,000 SQ.FT.)
Line23974	Note:
9May17 / 29Aug17	

WINDOWS - BASEMENT

Brampton Encore - 19R - 2 - 28-2 Elev.CR SIREN

Inv.1,354	2 - BASEMENT WINDOWS - UPGRADE EXISTING BASEMENT WINDOW TO 30 INCH X 24 INCH - MAY REQUIRE INSTALLATION OF WINDOW WELL
Line21326	Note: See plan for location.
9May17 / 29Aug17	



 DEIOR
 MAY 9 2017

The Siren

SEMI SERIES

Elevation A • 1,688 sq.ft.
 Elevation B • 1,677 sq.ft.
 Elevation C • 1,687 sq.ft.

No phone in Kitchen!

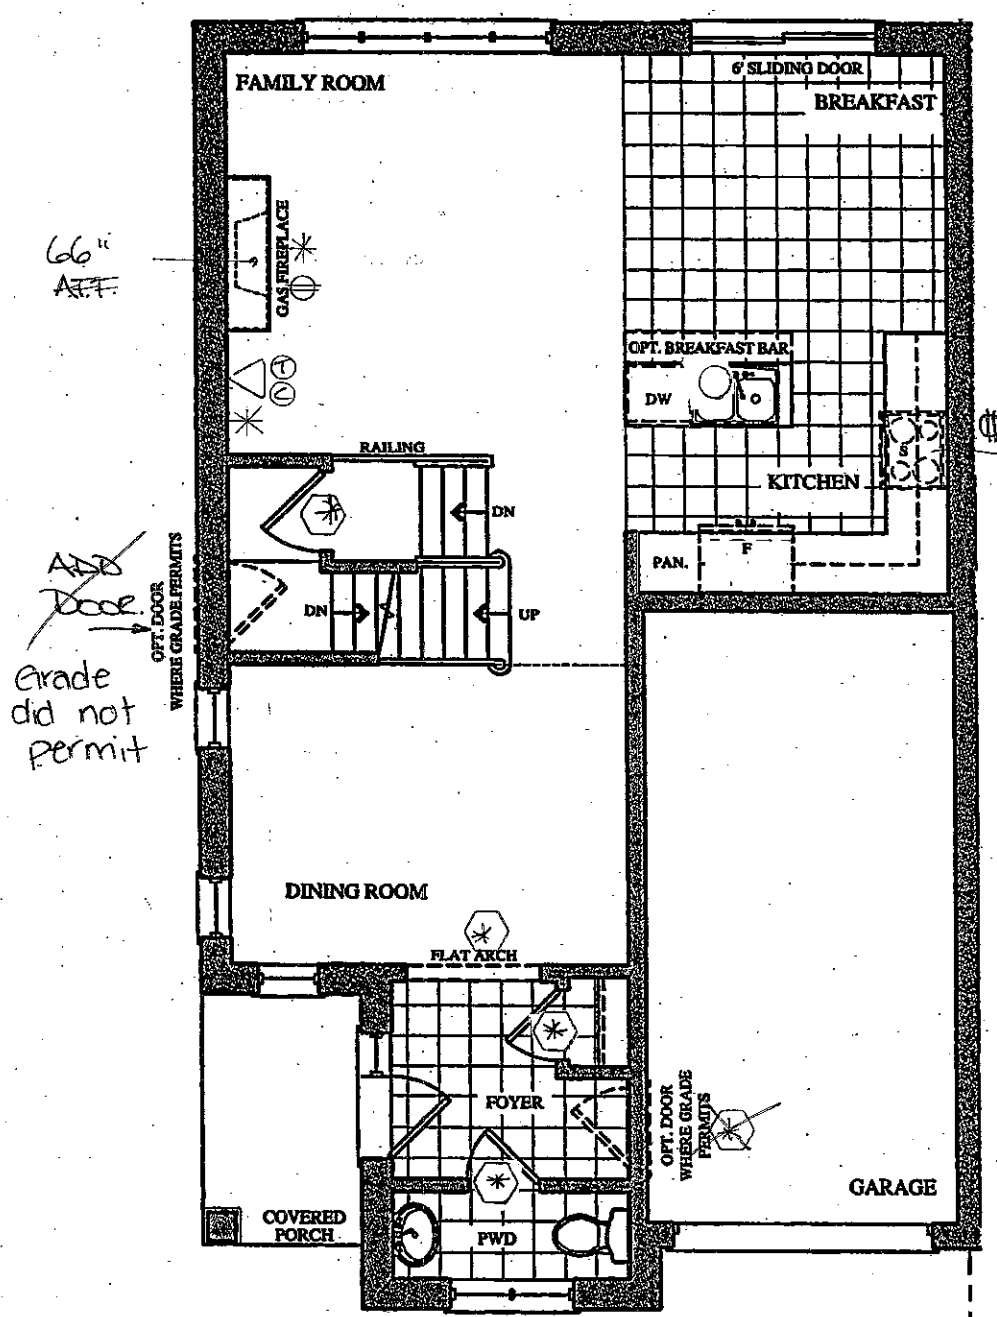


8" DUCT. + GAS LINE + 110V plug

LEGEND.

- MOVE STD CEILING FIXTURE
- ⊙ ELECT. OUTLET
- * CONDUIT
- ⊙ FRAME 96" HEIGHT (Grade did not permit)
- △ PHONE
- △ CABLE
- ⊗ KEYPAD ROUGH IN.

GROUND FLOOR PLAN
ELEV. 'A' & 'B'

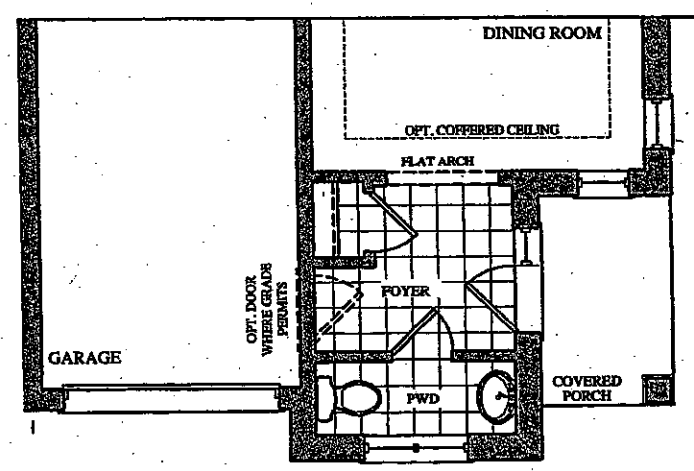


PART. GROUND FLOOR PLAN
ELEV. 'C'

The Siren


SEMI SERIES

Elevation A • 1,688 sq.ft.
Elevation B • 1,677 sq.ft.
Elevation C • 1,687 sq.ft.


BE 19R (NN)
MAY 9 2017

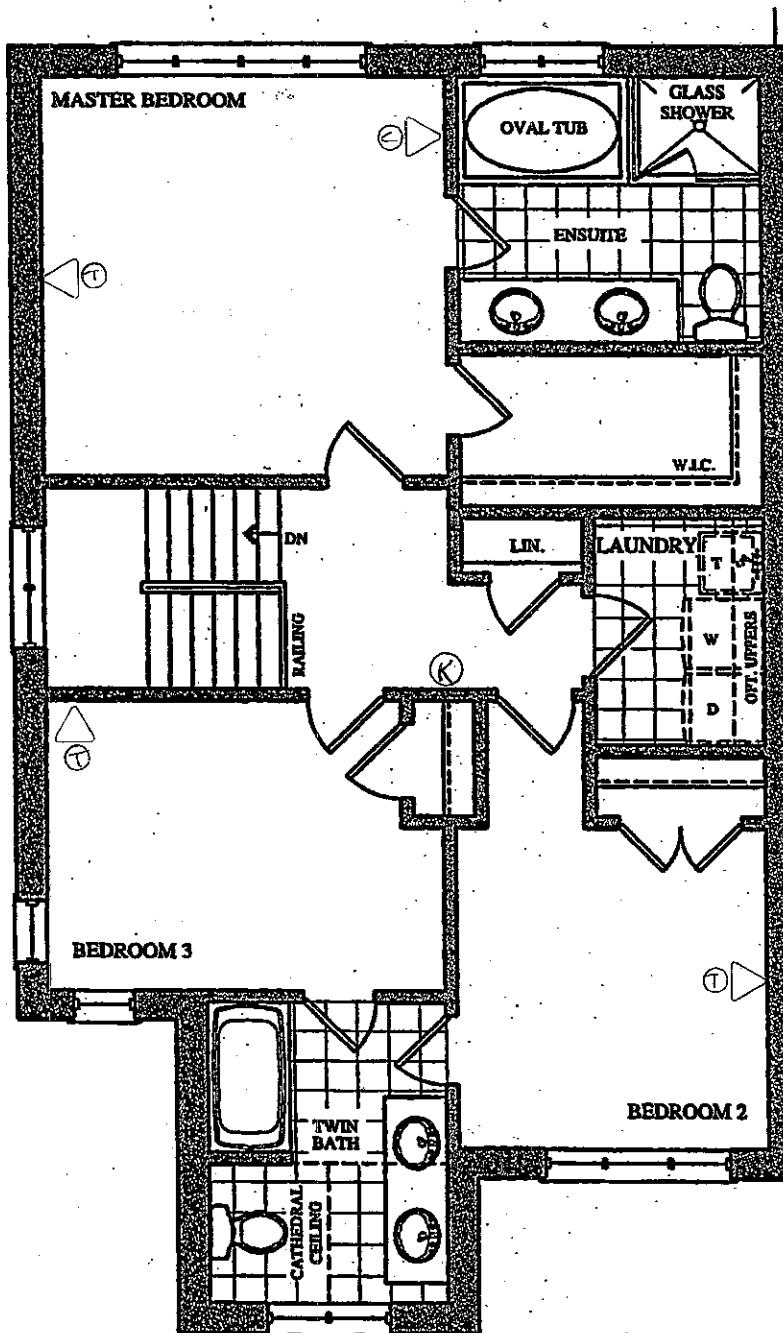

SECOND FLOOR PLAN
ELEV. 'A'

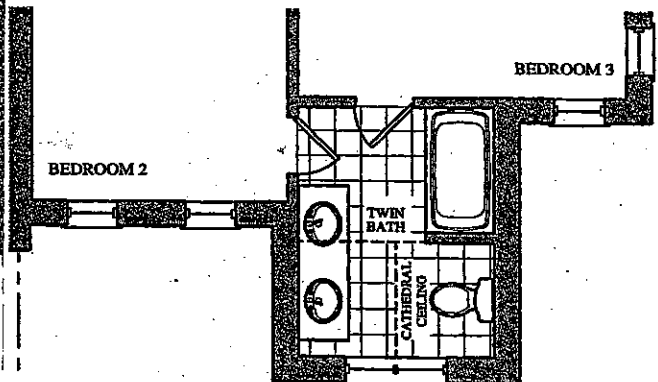

PART. SECOND FLOOR PLAN
ELEV. 'B'

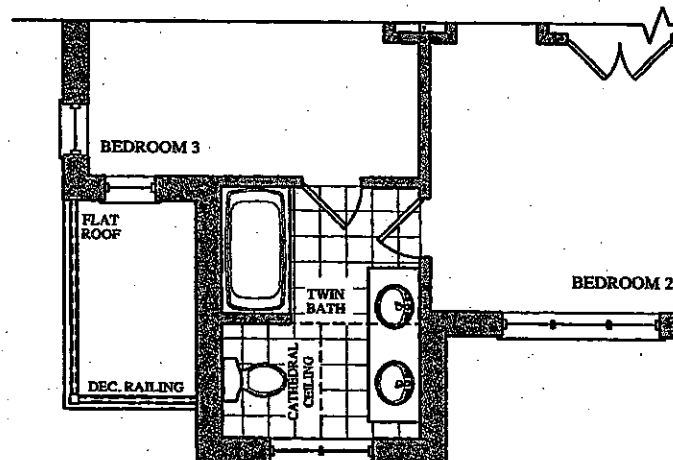

PART. SECOND FLOOR PLAN
ELEV. 'C'


The Siren

SEMI SERIES

BE-19R
May 9 2017



Elevation A • 1,688 sq.ft.
Elevation B • 1,677 sq.ft.
Elevation C • 1,687 sq.ft.

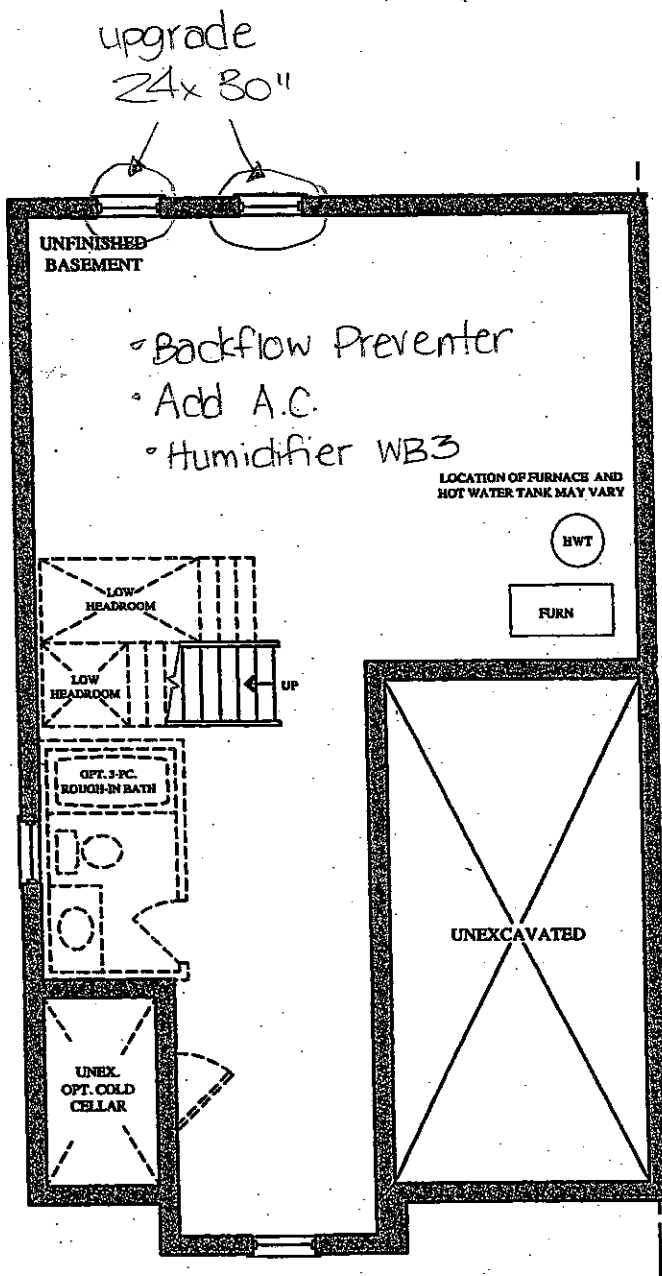

BASEMENT FLOOR PLAN
ELEV. 'A', 'B' & 'C'