

Brampton Encore - 158 - 2 - 38-8 Elev.B CORELLI OPT - GFA1

CENTRAL VAC AND WIRING

Inv.1,363	1 - FAMILY ROOM: CONDUIT PIPE- FOR TELEVISION- LOCATE APPROX. 66" A.F.F. TERMINATING BESIDE CABLE OUTLET. SEE PLAN FOR LOCATION
Line21451	Note:
15May17 / 29Aug17	

ELECTRICAL

Inv.1,363	1 - 110V WALL RECEPTACLE ON NORMAL CIRCUIT-MUST SPECIFY LOCATION
Line21452	Note:
15May17 / 29Aug17	

Inv.1,363	1 - KITCHEN: RELOCATE STANDARD CEILING LIGHT TO ABOVE ISLAND
Line21453	Note:
15May17 / 29Aug17	

Inv.1,363	1 - KITCHEN: ROUGH - IN CEILING OUTLET ON SAME SWITCH - DOES NOT INCLUDE FIXTURE -LOCATE ABOVE ISLAND, USE SAME SWITCH AS STANDARD
Line21454	Note:
15May17 / 29Aug17	

Exterior Colours

Inv.1,363	1 - EXTERIOR COLOUR PACKAGE 1
Line23978	Note:
15May17 / 29Aug17	

FRAMING

Inv.1,363	1 - MAIN FLOOR: *NOTE* FRAME MAIN FLOOR DOORS AND ARCHES AT 96"
Line21456	Note:
15May17 / 29Aug17	

Inv.1,363	1 - OPTIONAL GROUND FLOOR
Line23979	Note:
15May17 / 29Aug17	

HVAC

Inv.1,363	1 - REAR DECK:MOVE STANDARD BBQ LINE TO DECK OFF BREAKFAST AREA
Line21463	Note:
15May17 / 29Aug17	

INTERIOR TRIM AND DOORS

Inv.1,363	3 - MAIN FLOOR: STANDARD DOOR EXTENDED HEIGHT 96" (PRICE PER DOOR) MAIN FLOOR 3 STOREY MODELS - 96"
Line21458	Note:
15May17 / 29Aug17	

MISC.

Inv.1,363	1 - REFUNDED- GRADE DID NOT PERMIT SIDE DOOR- HOME TO EXTERIOR- AS PER PLAN AND GRADE PERMITTING
Line21455	Note:
15May17 / 29Aug17	

Brampton Encore - 158 - 2 - 38-8 Elev.B CORELLI OPT - GFA1

Inv.1,363	1 - Purchaser has attended an appointment at the Decor Centre & has DECLINED any additional upgrades and accepts and acknowledges that there will be no further changes/additions/deletions to be made upon signing on May 15 2017.
Line21460	Note:
15May17 / 29Aug17	
Inv.1,363	1 - Purchasers are aware & accepts that ANY changes made to upgrades after signing this Purchasers Extra Form are subject to a minimum administration fee of \$500. PLUS a 10% holdback fee.
Line21461	Note:
15May17 / 29Aug17	
Inv.1,363	1 - BONUS PACKAGE: \$15,000.00 (INCLUDING TAXES) WORTH OF UPGRADES FROM GOLD PARK HOMES DÉCOR CENTRE IS BEING APPLIED TOWARD THE STRUCTURAL APPOINTMENT. PURCHASER HAS A REMAINING AMOUNT OF \$8084.40 (INCLUDING TAXES) TO BE USED TOWARD THE COLOUR APPOINTMENT.
Line21462	Note:
15May17 / 29Aug17	

PLUMBING

Inv.1,363	1 - OPTIONAL GROUND FLOOR
Line23980	Note:
15May17 / 29Aug17	

PLUMBING FIXTURES

Inv.1,363	1 - MASTER ENSUITE: DELTA ARZO 3-FUNCTION SHOWER #T17T267/50570/T11867/R1100/R10000-UNBXHF (Chrome)
Line21459	Note:
15May17 / 29Aug17	

WINDOWS AND DOORS



Inv.1,363	1 - MANDOOR GARAGE TO HOUSE- GRADE PERMITS
Line23981	Note:
15May17 / 29Aug17	

BE2-158
MAY 15 2017
(25) (AS)

Cor
38' SE


Elevation A • 3,878 sq.ft. | Elevation B • 3,878 sq.ft.

MOVE STD
BBQ to
HERE.

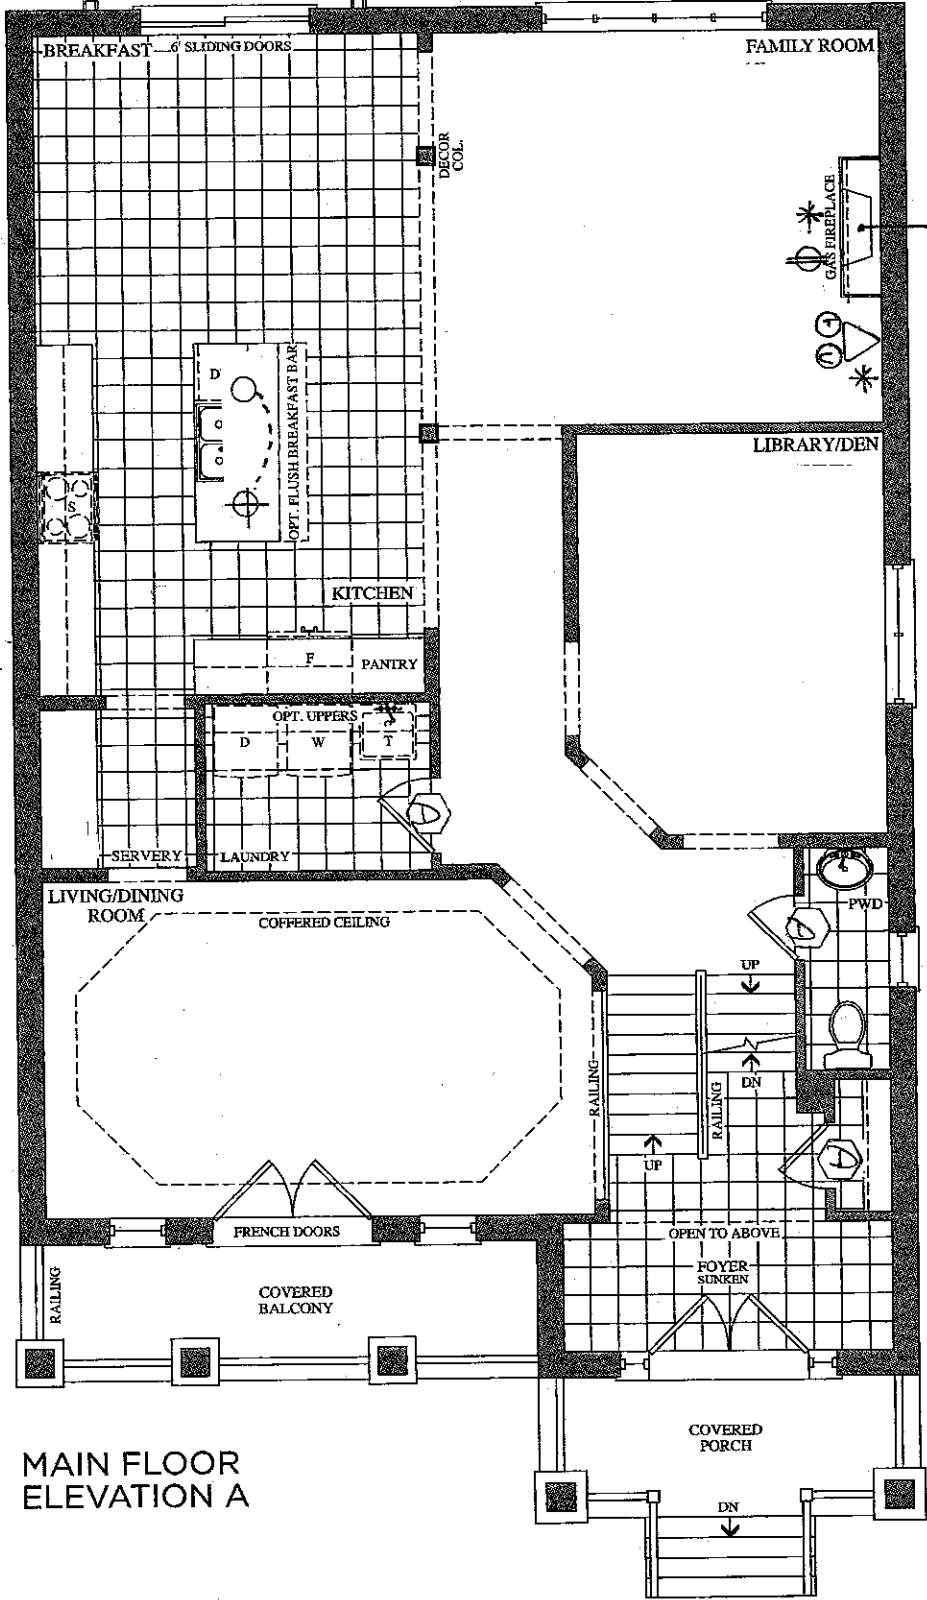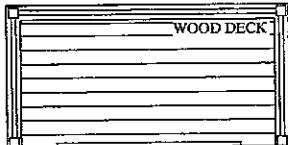

LEGEND.



- STD LIGHT
- ⊕ COFFERED CEILING OUTLET
- ⊕ ELEC. OUTLET
- * CONDUIT
- ⬡ 96" DOOR.
- △ Ⓟ PHONE
- △ Ⓢ CABLE

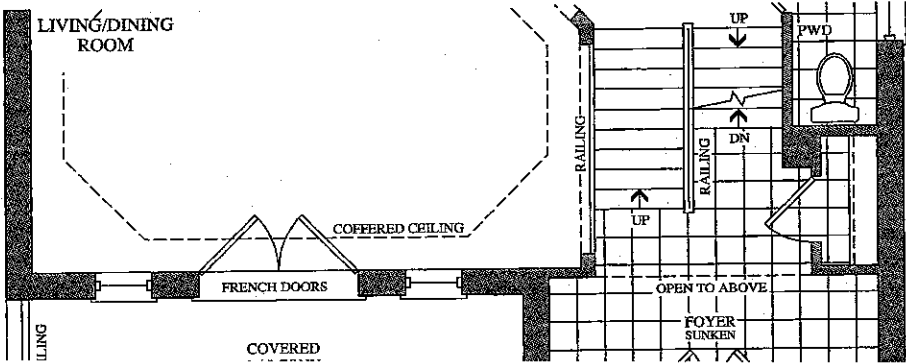

BE2-158
MAY 15 2017


(JH) (AS)

Elevation A • 3,878 sq.ft. | Elevation B • 3,878 sq.

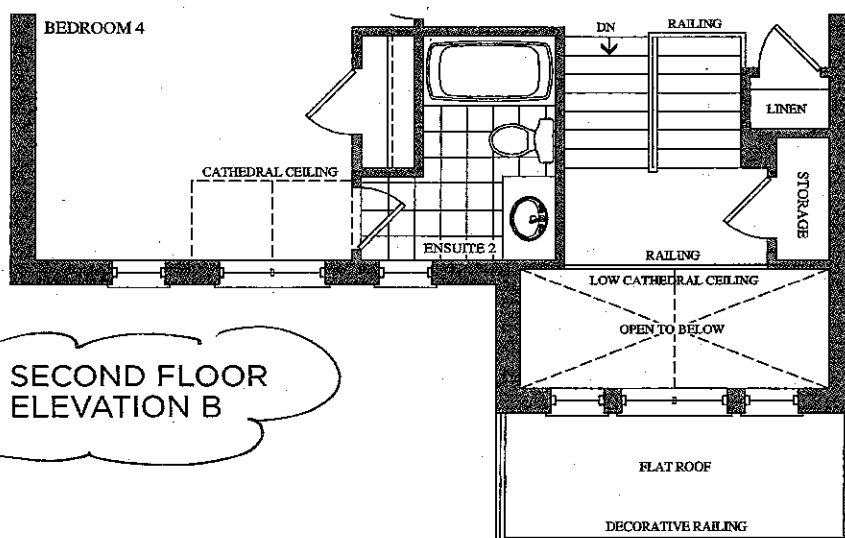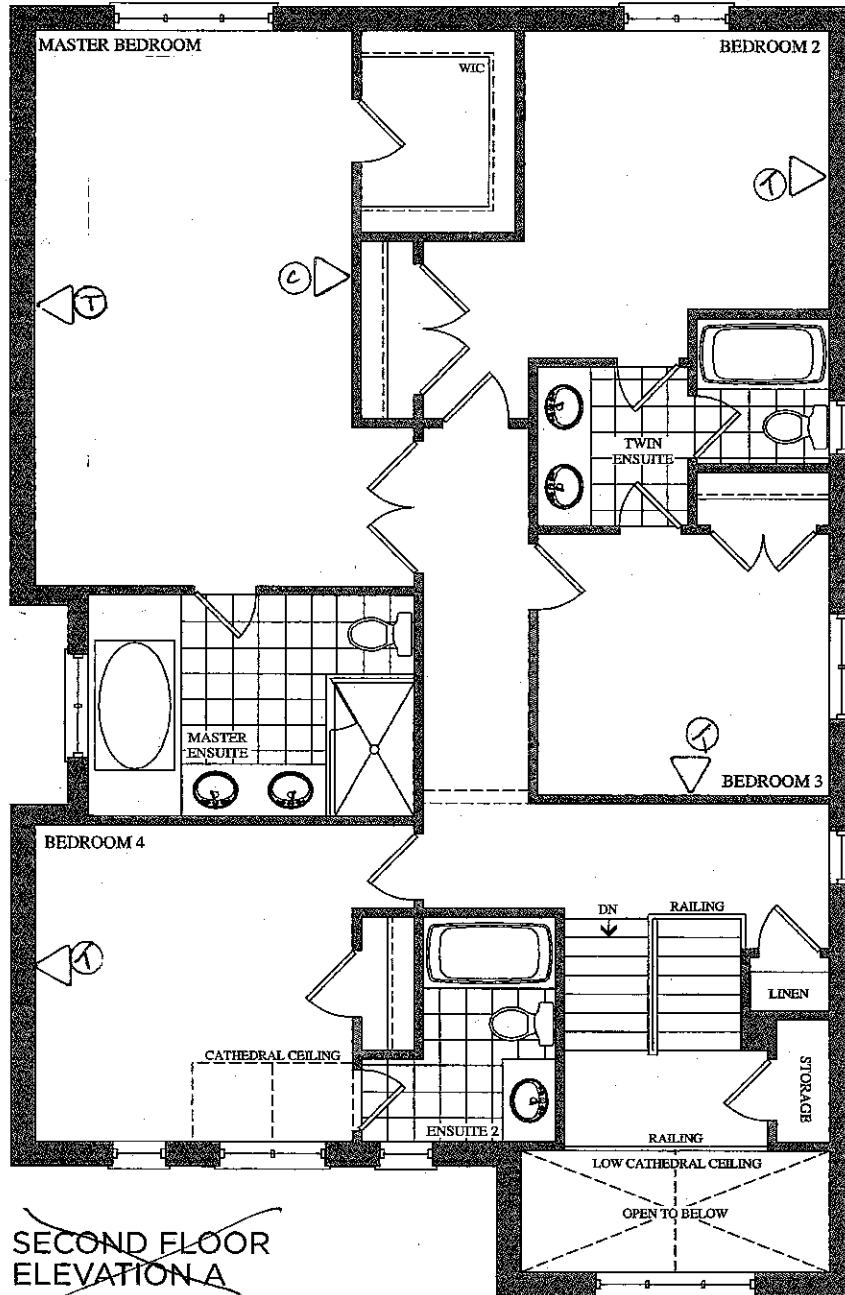


BE2-158
MAY 15 2017
(2.3) (A5)

Elevation A • 3,878 sq.ft. | Elevation B • 3,878 sq.ft.

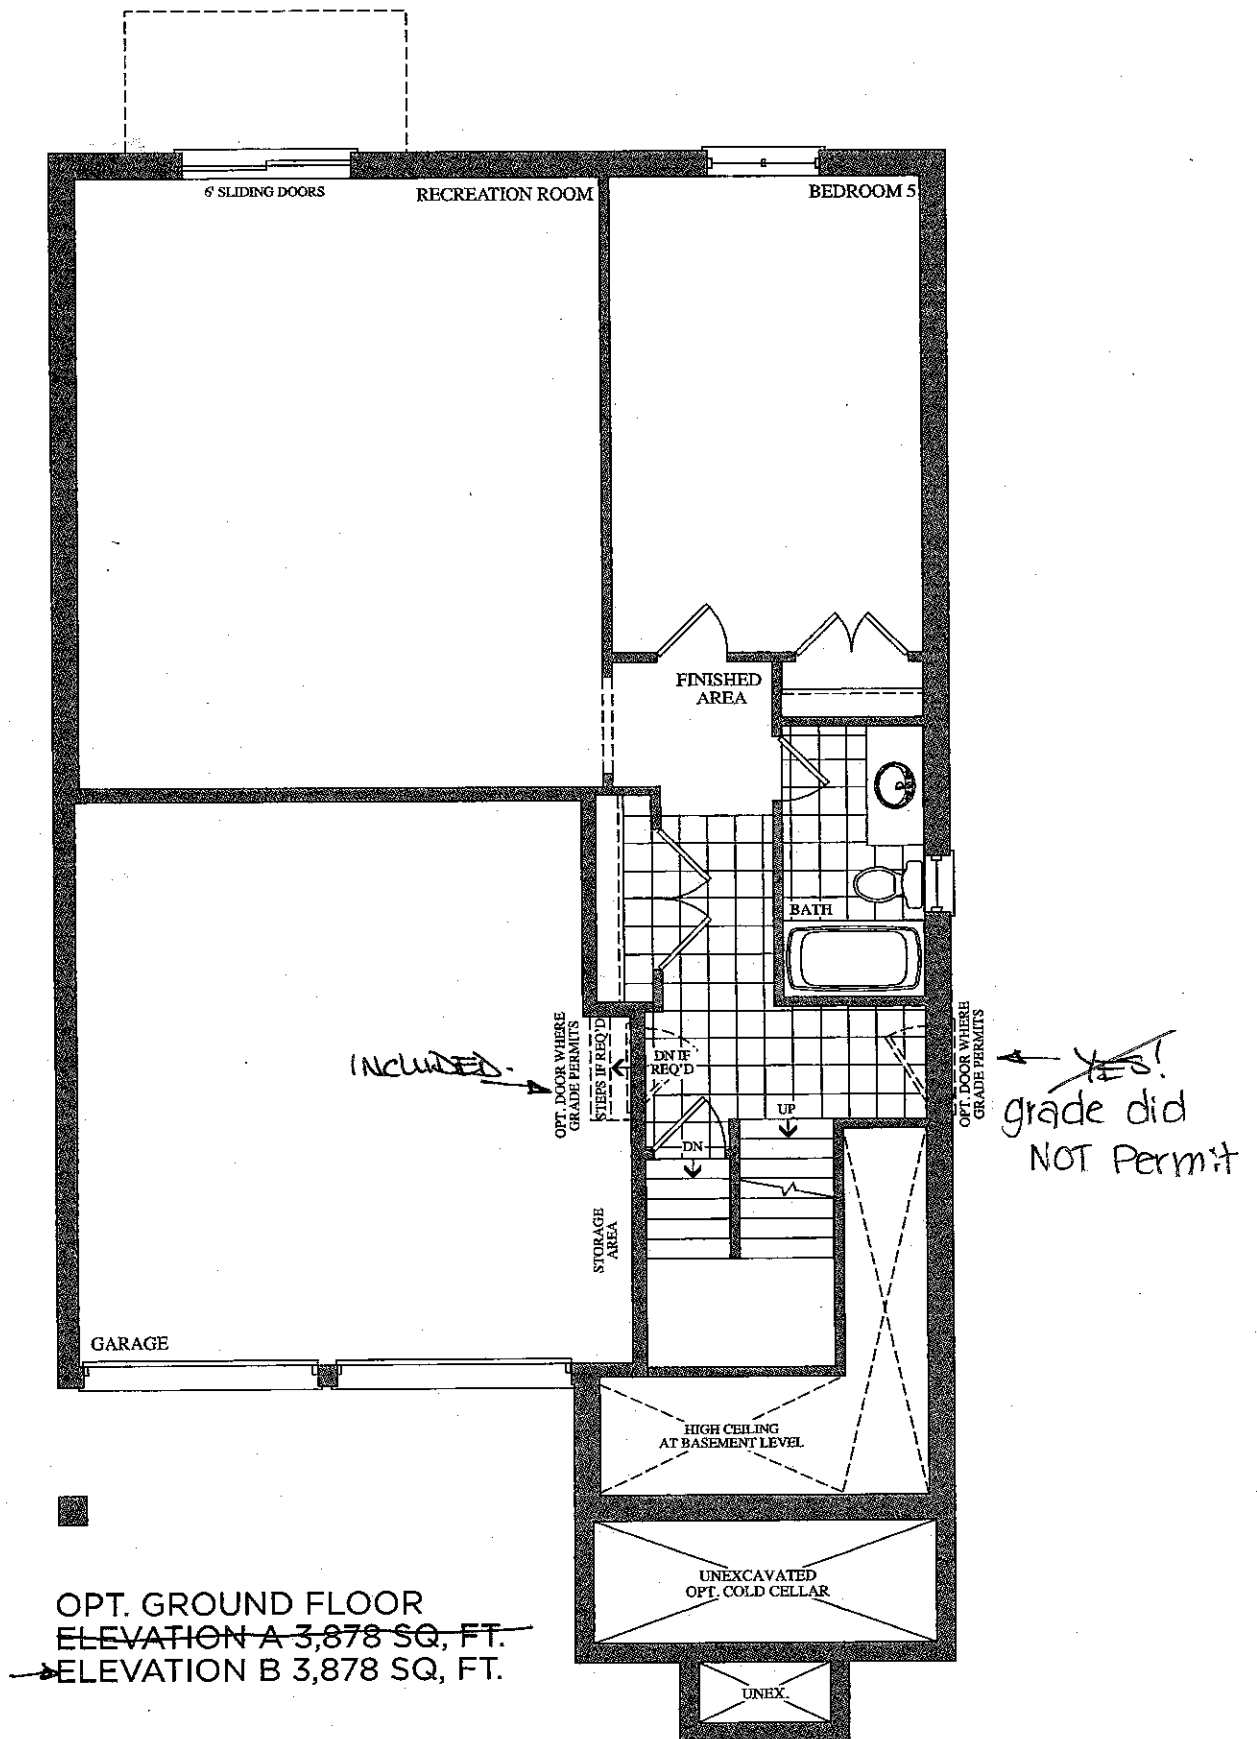

BE2-158
MAY 15 2017 J.S. AS



Elevation A • 3,878 sq.ft. | Elevation B • 3,878

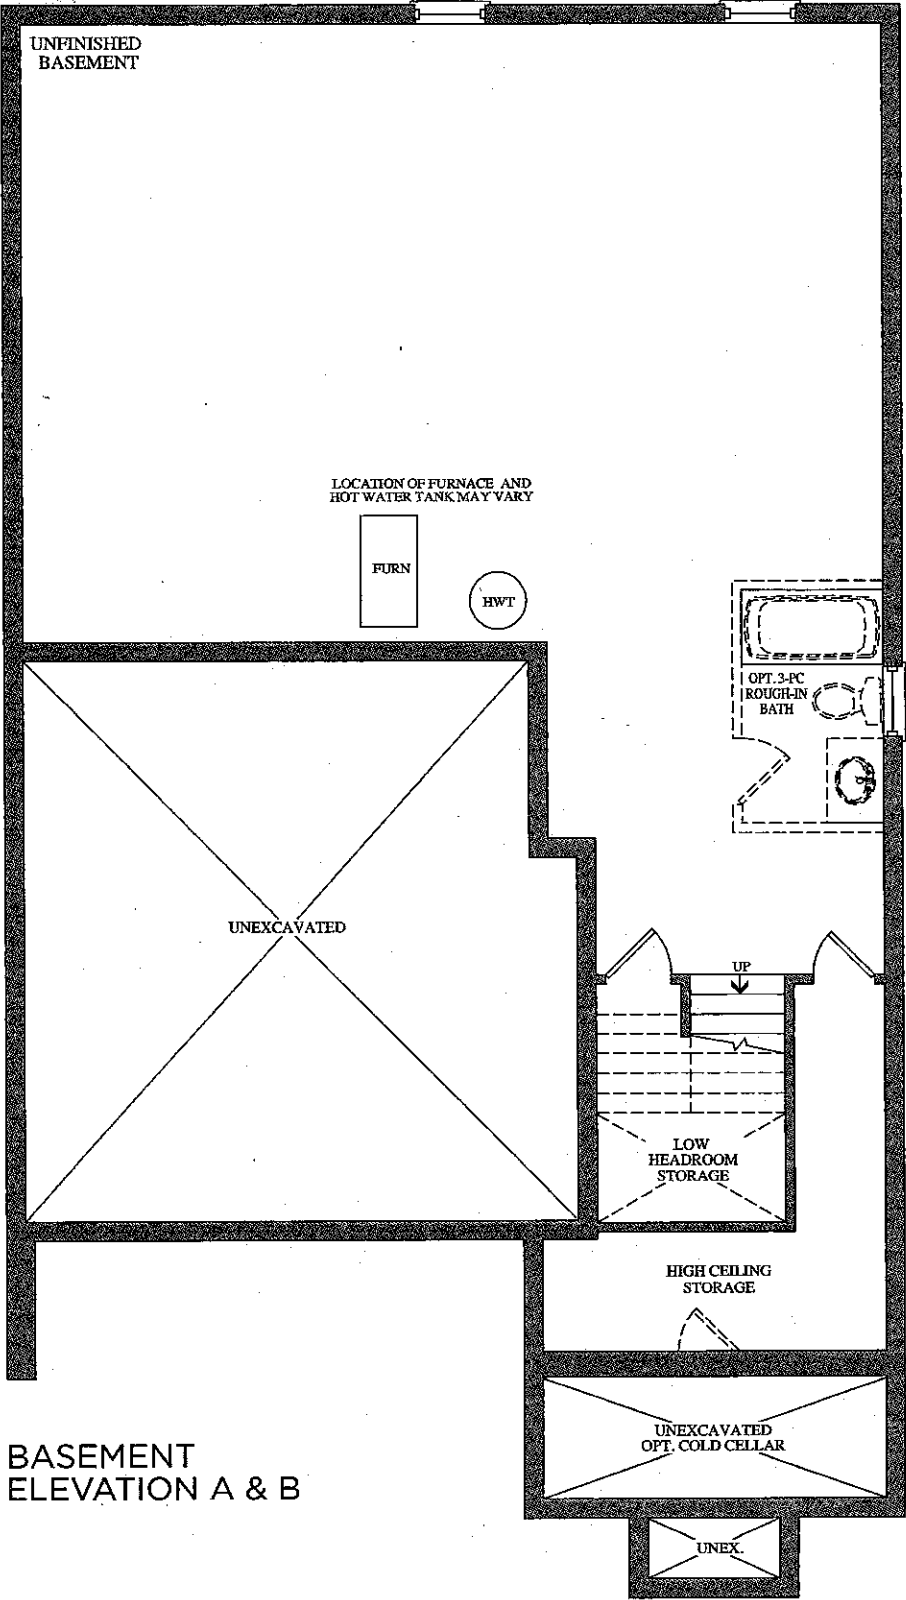

BASEMENT
ELEVATION A & B

Arzo TempAssure 3 Function Shower System

#T17T267/50570//T11867/R1100/R10000-UNBXHF (chrome)

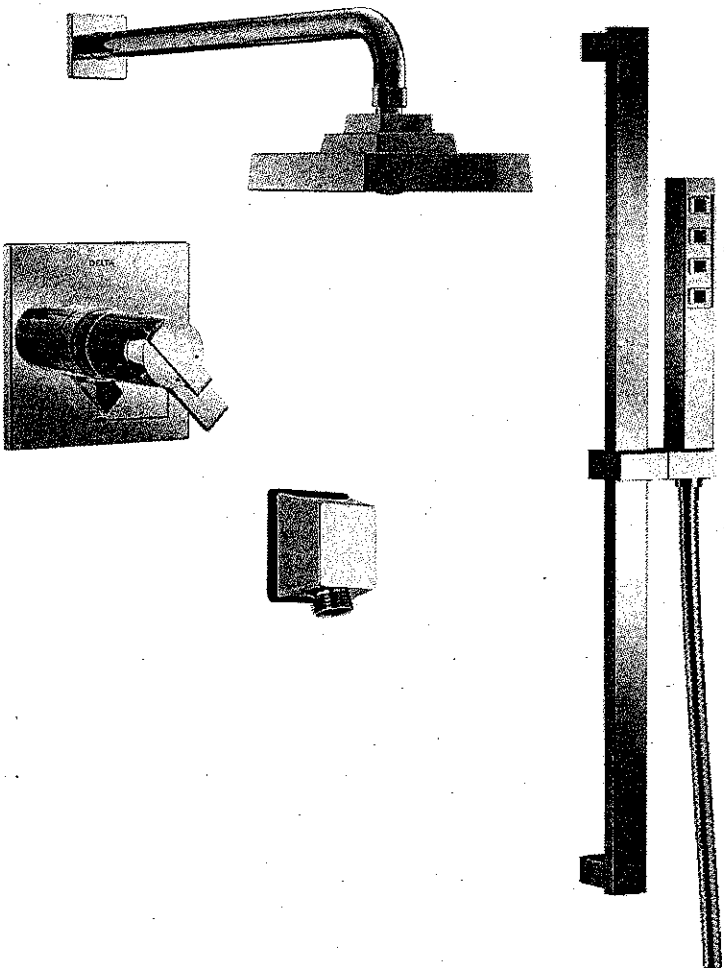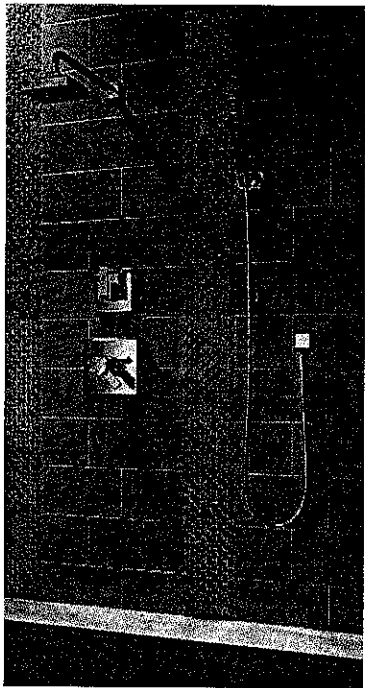

LOT # 2-158	
ROOM: MASTER ENSUITE	SIGNATURE: (J.S.)
DATE: MAY 15 2017	SIGNATURE: (AS)