

Brampton Encore - 1 - 1 - 38-8 Elev.B CORELLI OPT - GFA1 AND SFA4 CORNER
CENTRAL VAC AND WIRING

Inv.1,403	1 - TELEPHONE AND CABLE ROUGH-IN LOCATIONS
Line21947	Note:
30May17 / 13Jul17	
Inv.1,403	1 - KITCHEN: INSTALL VAC PAN UNDER KITCHEN SINK
Line21948	Note:
30May17 / 13Jul17	
Inv.1,403	1 - FAMILY ROOM: INSTALL CONDUIT PIPE- FOR TELEVISION- MUST SPECIFY LOCATION AND TERMINATION POINT
Line21949	Note:
30May17 / 13Jul17	
Inv.1,403	1 - SMART ETHERNET PACKAGE- 4 LOCATIONS, SEE SKETCH
Line21951	Note:
30May17 / 13Jul17	

DRYWALL

Inv.1,403	1 - GROUND FLOOR: INSTALL SMOOTH CEILINGS - (3-Story Design) GROUND FLOOR
Line21952	Note:
30May17 / 13Jul17	
Inv.1,403	1 - SECOND FLOOR: INSTALL SMOOTH CEILINGS - (2-Story Design) SECOND FLOOR
Line21953	Note:
30May17 / 13Jul17	

ELECTRICAL

Inv.1,403	1 - FAMILY ROOM: INSTALL 110V WALL RECEPTACLE ON DEDICATED CIRCUIT -ABOVE FIREPLACE FOR FUTURE TV
Line21950	Note:
30May17 / 13Jul17	
Inv.1,403	1 - KITCHEN: INSTALL 110V WALL RECEPTACLE ON DEDICATED CIRCUIT - FOR MICROWAVE - MICROWAVE NOT INCLUDED
Line21954	Note:
30May17 / 13Jul17	
Inv.1,403	1 - KITCHEN: INSTALL 220V WALL RECEPTICAL ON DEDICATED CIRCUIT- FOR 4 WIRE BUILT-IN WALL OVEN - MUST SPECIFY LOCATION
Line21955	Note:
30May17 / 13Jul17	
Inv.1,403	1 - GARAGE: INSTALL 110V WALL RECEPTACLE ON NORMAL CIRCUIT-MUST SPECIFY LOCATION. IN ADDITION TO STANDARD GIVEN
Line21963	Note:
30May17 / 13Jul17	
Inv.1,403	1 - KITCHEN: INSTALL GAS LINE ROUGH - MAIN FLOOR- (3-STOREY MODELS) FOR STOVE. INCLUDES 110 V PLUG
Line23317	Note:
30May17 / 13Jul17	

Exterior Colours

Inv.1,403	1 - EXTERIOR COLOUR PACKAGE 6
Line23316	Note:
30May17 / 13Jul17	

Brampton Encore - 1 - 1 - 38-8 Elev.B CORELLI OPT - GFA1 AND SFA4 CORNER FORMING

Inv.1,403	1 - EXTERIOR: INSTALL SIDE DOOR- HOME TO EXTERIOR- AS PER PLAN AND GRADE PERMITTING
Line21957	Note:
30May17 / 13Jul17	

FRAMING

Inv.1,403	1 - GARAGE: INSTALL MANDOOR - GARAGE TO HOUSE- AS PER PLAN AND GRADE PERMITTING
Line21958	Note:
30May17 / 13Jul17	
Inv.1,403	1 - MAIN FLOOR: INSTALL THREE (X3) STANDARD DOOR EXTENDED HEIGHT 96" (PRICE PER DOOR) MAIN FLOOR 3 STOREY MODELS
Line23320	Note:
30May17 / 13Jul17	

HVAC

Inv.1,403	1 - KITCHEN: INSTALL GAS LINE ROUGH - MAIN FLOOR- (3-STOREY MODELS) FOR STOVE. INCLUDES 110 V PLUG
Line21956	Note:
30May17 / 13Jul17	
Inv.1,403	1 - BASEMENT: INSTALL 4.0 TON AIR CONDITIONER
Line21960	Note:
30May17 / 13Jul17	

INTERIOR TRIM AND DOORS

Inv.1,403	3 - MAIN FLOOR: INSTALL THREE (X3) STANDARD DOOR EXTENDED HEIGHT 96" (PRICE PER DOOR) MAIN FLOOR 3 STOREY MODELS
Line21962	Note:
30May17 / 13Jul17	

MISC.

Inv.1,403	1 - ELECTRICAL FOR APPLIANCES: *PLEASE NOTE: PRICE ABOVE MAY CHANGE. PURCHASER(S) TO PROVIDE PROPER APPLIANCE SPECIFICATIONS TO PRICE APPLICABLE ELECTRICAL ACCORDINGLY
Line21964	Note:
30May17 / 13Jul17	
Inv.1,403	1 - Purchaser has attended a Structural appointment at the Decor Centre & has DECLINED any additional upgrades and accepts and acknowledges that there will be no further structural changes/additions/deletions to be made upon signing on May 30, 2017
Line21965	Note:
30May17 / 13Jul17	
Inv.1,403	1 - Purchasers are aware & accepts that ANY changes made to upgrades after signing this Purchasers Extra Form are subject to a minimum administration fee of \$500. PLUS a 10% holdback fee
Line21966	Note:
30May17 / 13Jul17	
Inv.1,403	1 - BONUS PACKAGE: \$10,000.00 (INCLUDING TAXES) WORTH OF UPGRADES FROM GOLD PARK HOMES DÉCOR CENTRE IS BEING APPLIED TOWARD THE STRUCTURAL APPOINTMENT. PURCHASER HAS A REMAINING AMOUNT OF \$00 (INCLUDING TAXES) TO BE USED TOWARD THE COLOUR APPOINTMENT
Line21967	Note:
30May17 / 13Jul17	

PLUMBING

Brampton Encore - 1 - 1 - 38-8 Elev.B CORELLI OPT - GFA1 AND SFA4 CORNER

Inv.1,403	1 - KITCHEN: INSTALL ROUGH-IN - WATERLINE FOR FRIDGE
Line21961	Note:
30May17 / 13Jul17	

WINDOWS - BASEMENT

Inv.1,403	2 - BASEMENT: INSTALL TWO (X2) BASEMENT WINDOWS - UPGRADE EXISTING BASEMENT WINDOW TO 30 INCH X 24 INCH - MAY REQUIRE INSTALLATION OF WINDOW WELL
Line21959	Note:
30May17 / 13Jul17	



WINDOWS AND DOORS

Inv.1,403	1 - EXTERIOR: INSTALL SIDE DOOR- HOME TO EXTERIOR- AS PER PLAN AND GRADE PERMITTING
Line23318	Note:
30May17 / 13Jul17	
Inv.1,403	1 - GARAGE: INSTALL MANDOOR - GARAGE TO HOUSE- AS PER PLAN AND GRADE PERMITTING
Line23319	Note:
30May17 / 13Jul17	

Telephone — ① - cat 6
Cable — ②
Electrical — ③

The
Corelli
38' SERIES

Elevation A • 3,878 sq.ft. | Elevation B • 3,878 sq.ft.

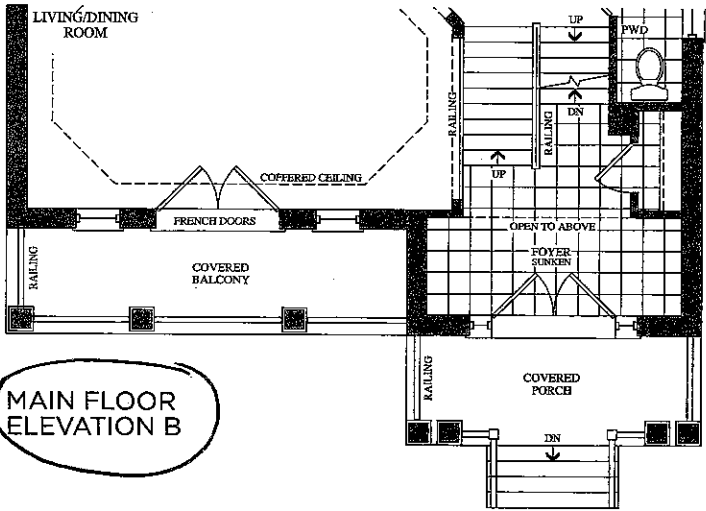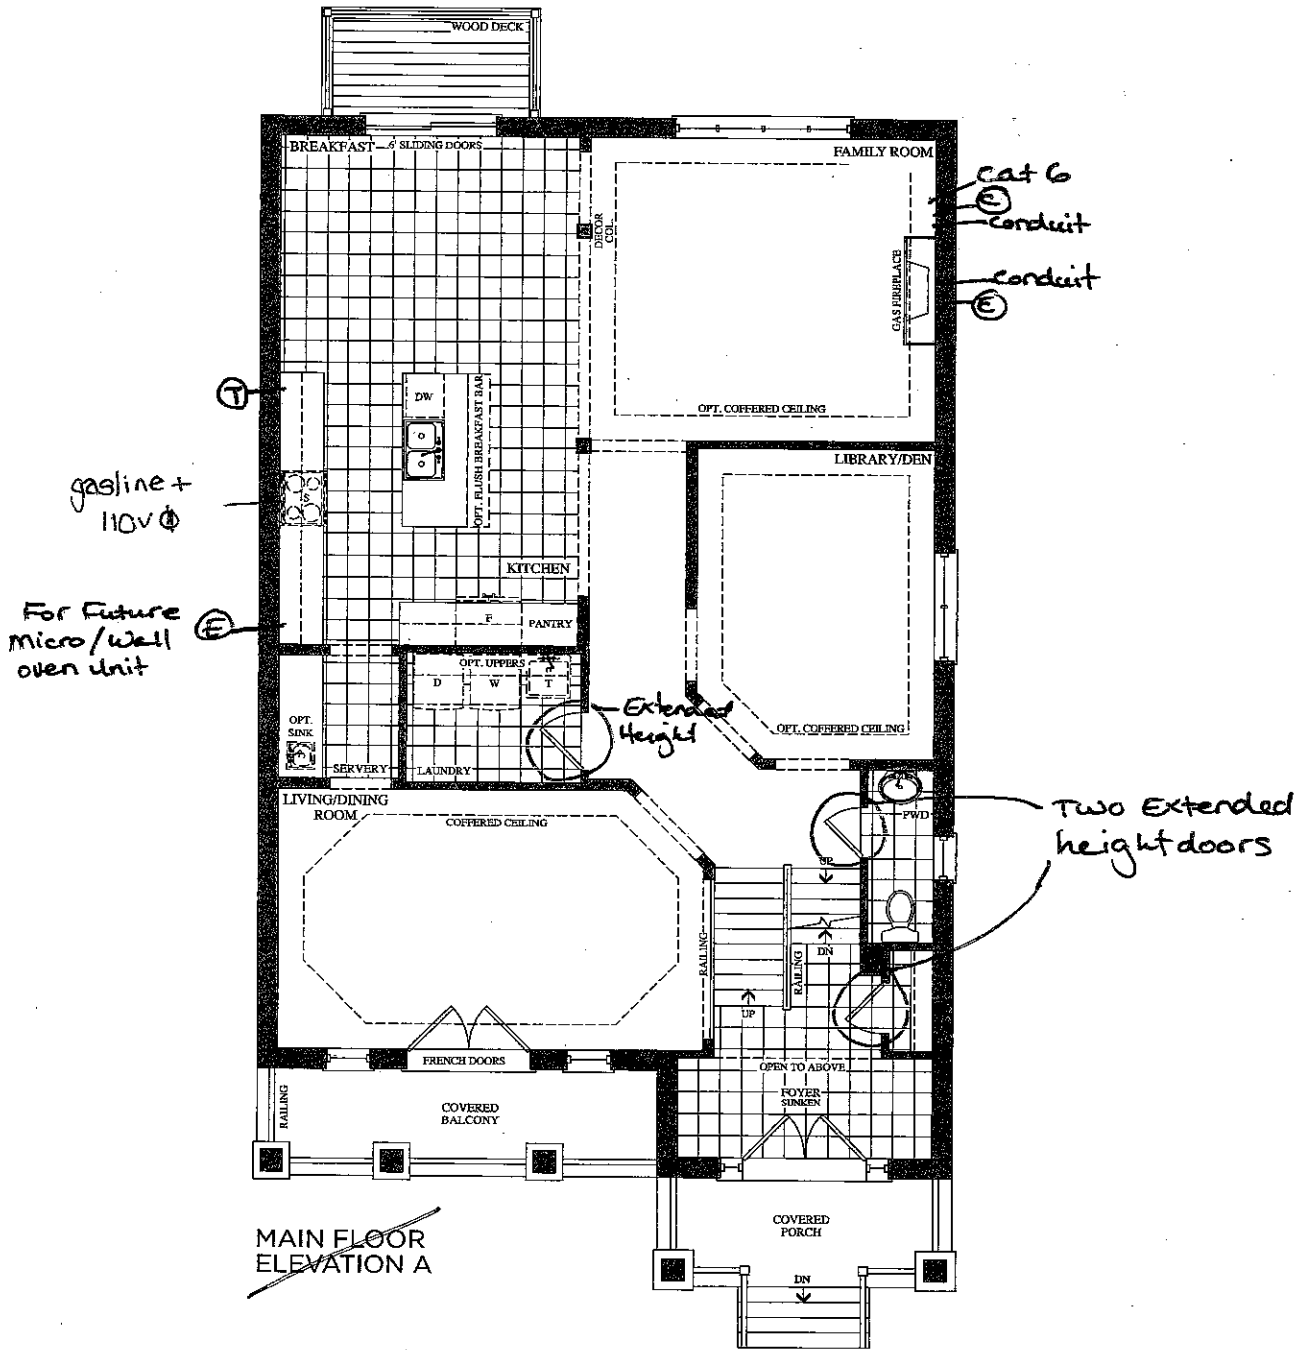

Lot 1
May 30, 17
②
th



Telephone — (T) cat 6
Cable — (C)

encore
BRAMPTON

The
Corelli
38' SERIES

Elevation A • 3,878 sq.ft. | Elevation B • 3,878 sq.ft.

smooth ceilings

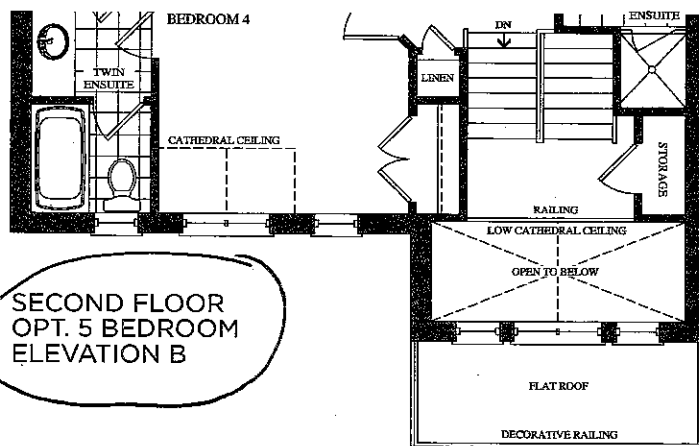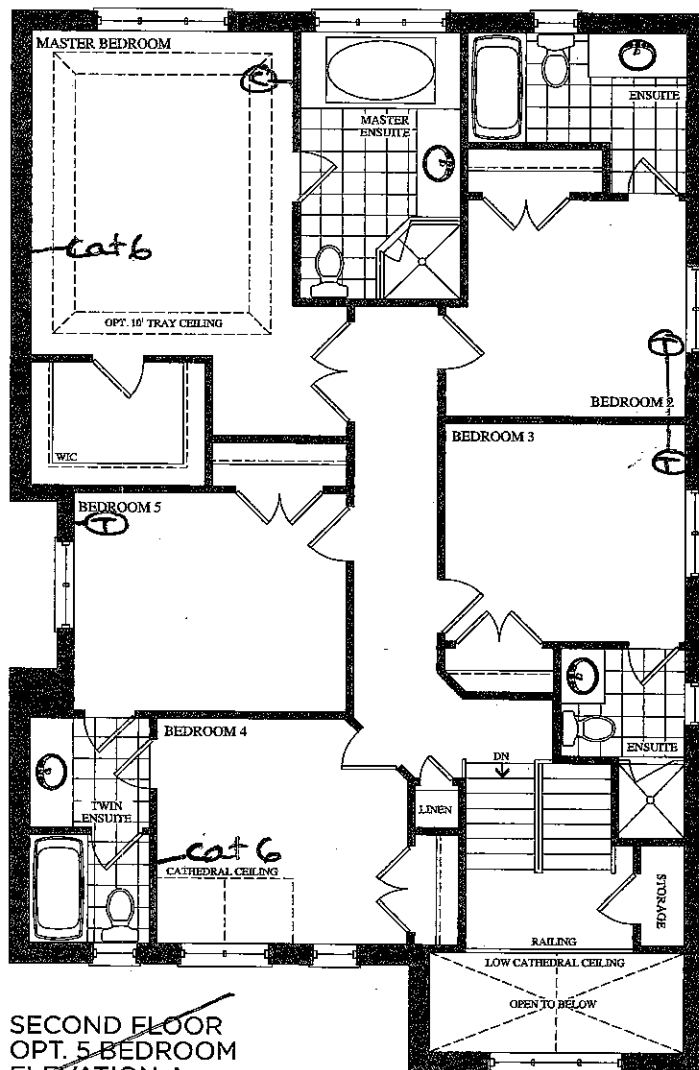

Lot 1
May 30, 17

(9)

M

Telephone — (T)


encore
BRAMPTON

The Corelli

38' SERIES

Elevation A • 3,878 sq.ft. | Elevation B • 3,878 sq.ft.

smooth ceilings.

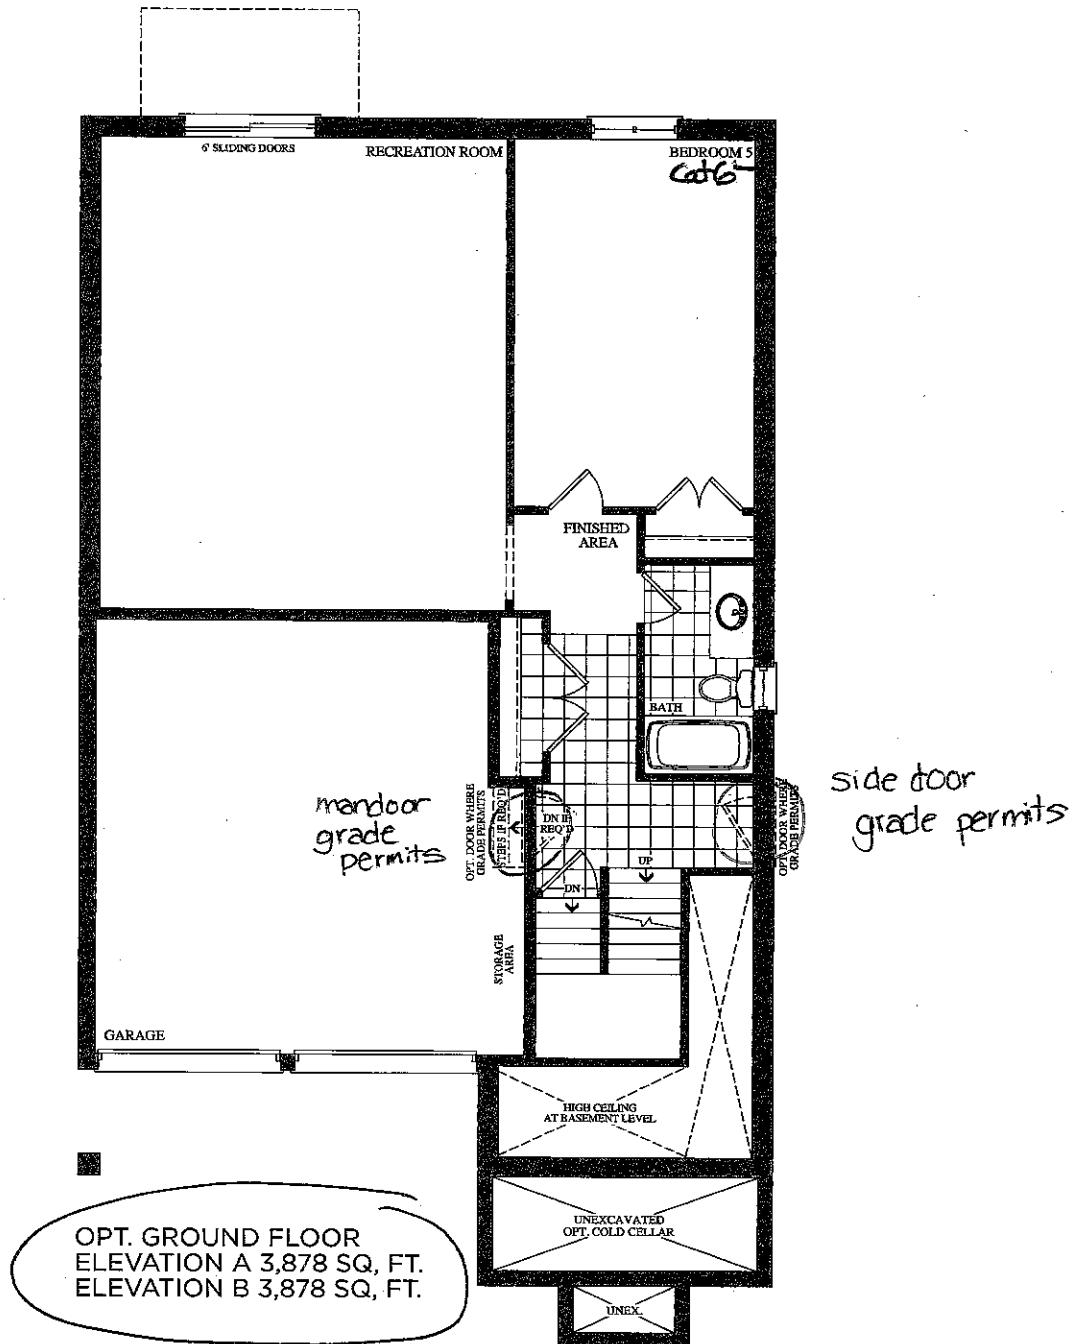

Lot 1
May 30, 17


(9)
M

Prices, figures, illustrations, sizes, features and finishes are subject to change without notice. E.&O.E. Areas and dimensions are approximate and actual usable floor space may vary from the stated area. Layout may be reverse of the unit purchased. E. & O.E.

GOLDPARK
HOMES

BSMNT WINDOWS
2 x 30"x24"

Elevation A • 3,878 sq.ft. | Elevation B • 3,878 sq.ft.

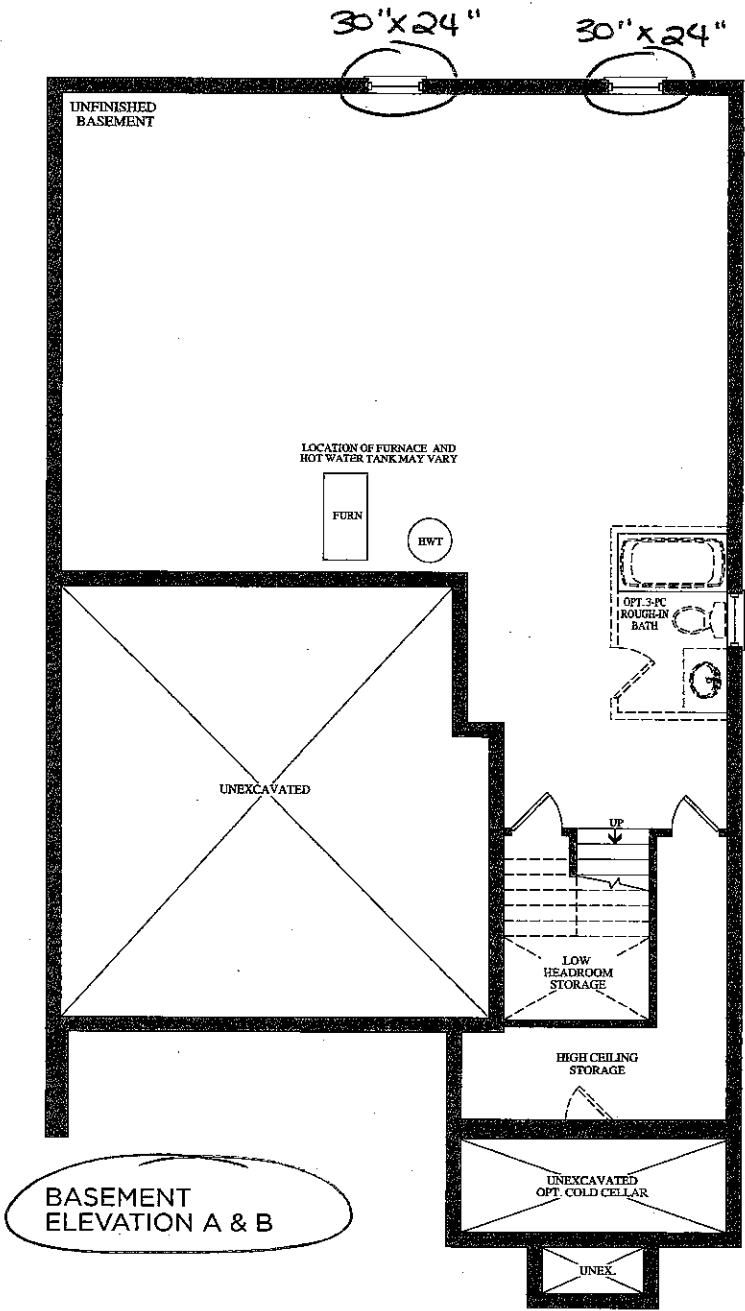

Lot 1
May 30, 17
91
W