

Brampton Encore - 19L - 2 - 28-2 Elev.CL SIREN Corner

CENTRAL VAC AND WIRING

Inv.1,381	1 - FAMILY ROOM: INSTALL CONDUIT PIPE- FOR TELEVISION- MUST SPECIFY LOCATION AND TERMINATION POINT
Line21670	Note:
23May17 / 13Jul17	
Inv.1,381	1 - TELEPHONE AND CABLE LOCATION SKETCH
Line21669	Note:
23May17 / 13Jul17	

CONCRETE AND DRAIN

Inv.1,381	1 - BASEMENT: INSTALL ROUGH-IN - 3PC BASEMENT ROUGH-IN
Line21678	Note:
23May17 / 13Jul17	
Inv.1,381	1 - BASEMENT: INSTALL BACKFLOW PREVENTER VALVE
Line21687	Note:
23May17 / 13Jul17	

ELECTRICAL

Inv.1,381	1 - FAMILY ROOM: INSTALL 110V WALL RECEPTACLE ON DEDICATED CIRCUIT - ABOVE FIREPLACE FOR TV
Line21671	Note:
23May17 / 13Jul17	
Inv.1,381	1 - KITCHEN: INSTALL 110V WALL RECEPTACLE ON DEDICATED CIRCUIT - FOR MICROWAVE - MICROWAVE NOT INCLUDED. TO GO ABOVE STOVE
Line21672	Note:
23May17 / 13Jul17	
Inv.1,381	4 - KITCHEN: INSTALL FOUR (X4) POT LIGHTS: 4 INCH LED POT LIGHT - (INTERIOR) -EACH
Line21673	Note:
23May17 / 13Jul17	
Inv.1,381	1 - FAMILY ROOM: INSTALL SIX (X6) POT LIGHTS: 4 INCH LED POT LIGHTS - (INTERIOR) -EACH
Line21674	Note:
23May17 / 13Jul17	
Inv.1,381	1 - KITCHEN: INSTALL UPGRADE TO DIMMER SWITCH - ONE UNIT- MUST PROVIDE LOCATION FOR POT LIGHTS IN KITCHEN
Line21675	Note:
23May17 / 13Jul17	
Inv.1,381	1 - FAMILY ROOM: - INSTALL UPGRADE TO DIMMER SWITCH - ONE UNIT- MUST PROVIDE LOCATION FOR POT LIGHTS IN FAMILY ROOM
Line21676	Note:
23May17 / 13Jul17	
Inv.1,381	1 - KITCHEN: RELOCATE STANDARD FIXTURE IN KITCHEN TO GO ABOVE ISLAND. SEE SKETCH
Line21677	Note:
23May17 / 13Jul17	

Exterior Colours

Inv.1,381	1 - EXTERIOR COLOUR PACKAGE 7
Line23338	Note:
23May17 / 13Jul17	

Brampton Encore - 19L - 2 - 28-2 Elev.CL SIREN Corner

FORMING

Inv.1,381	1 - EXTERIOR: INSTALL SIDE DOOR- HOME TO EXTERIOR- AS PER PLAN AND GRADE PERMITTING
Line21685	Note:
23May17 / 13Jul17	

FRAMING

Inv.1,381	1 - GRADE DOES NOT PERMIT DO NOT INSTALL MANDOOOR- APPLIED BY HEAD OFFICE
Line21680	Note:
23May17 / 13Jul17	

MISC.

Inv.1,381	1 - BONUS PACKAGE: \$8164.25 (INCLUDING TAXES) WORTH OF UPGRADES FROM GOLD PARK HOMES DÉCOR CENTRE IS BEING APPLIED TOWARD THE STRUCTURAL APPOINTMENT. PURCHASER HAS A REMAINING AMOUNT OF \$6835.75 (INCLUDING TAXES) TO BE USED TOWARD THE COLOUR APPOINTMENT
Line21688	Note:
23May17 / 13Jul17	
Inv.1,381	1 - Purchaser has attended a Structural appointment at the Decor Centre & has DECLINED any additional upgrades and accepts and acknowledges that there will be no further structural changes/additions/deletions to be made upon signing on May 23, 2017.
Line21689	Note:
23May17 / 13Jul17	
Inv.1,381	1 - Purchasers are aware & accepts that ANY changes made to upgrades after signing this Purchasers Extra Form are subject to a minimum administration fee of \$500. PLUS a 10% holdback fee
Line21690	Note:
23May17 / 13Jul17	

PLUMBING

Inv.1,381	1 - BASEMENT: INSTALL BACKFLOW PREVENTER VALVE
Line23335	Note:
23May17 / 13Jul17	
Inv.1,381	1 - BASEMENT: INSTALL ROUGH-IN - 3PC BASEMENT ROUGH-IN
Line23337	Note:
23May17 / 13Jul17	

WINDOWS AND DOORS


Inv.1,381	1 - EXTERIOR: INSTALL SIDE DOOR- HOME TO EXTERIOR- AS PER PLAN AND GRADE PERMITTING
Line23336	Note:
23May17 / 13Jul17	

Telephone — (T)
 Cable — (C)
 Electrical — (E)

The Siren


SEMI SERIES

Elevation A • 1,688 sq.ft.
 Elevation B • 1,677 sq.ft.
 Elevation C • 1,687 sq.ft.

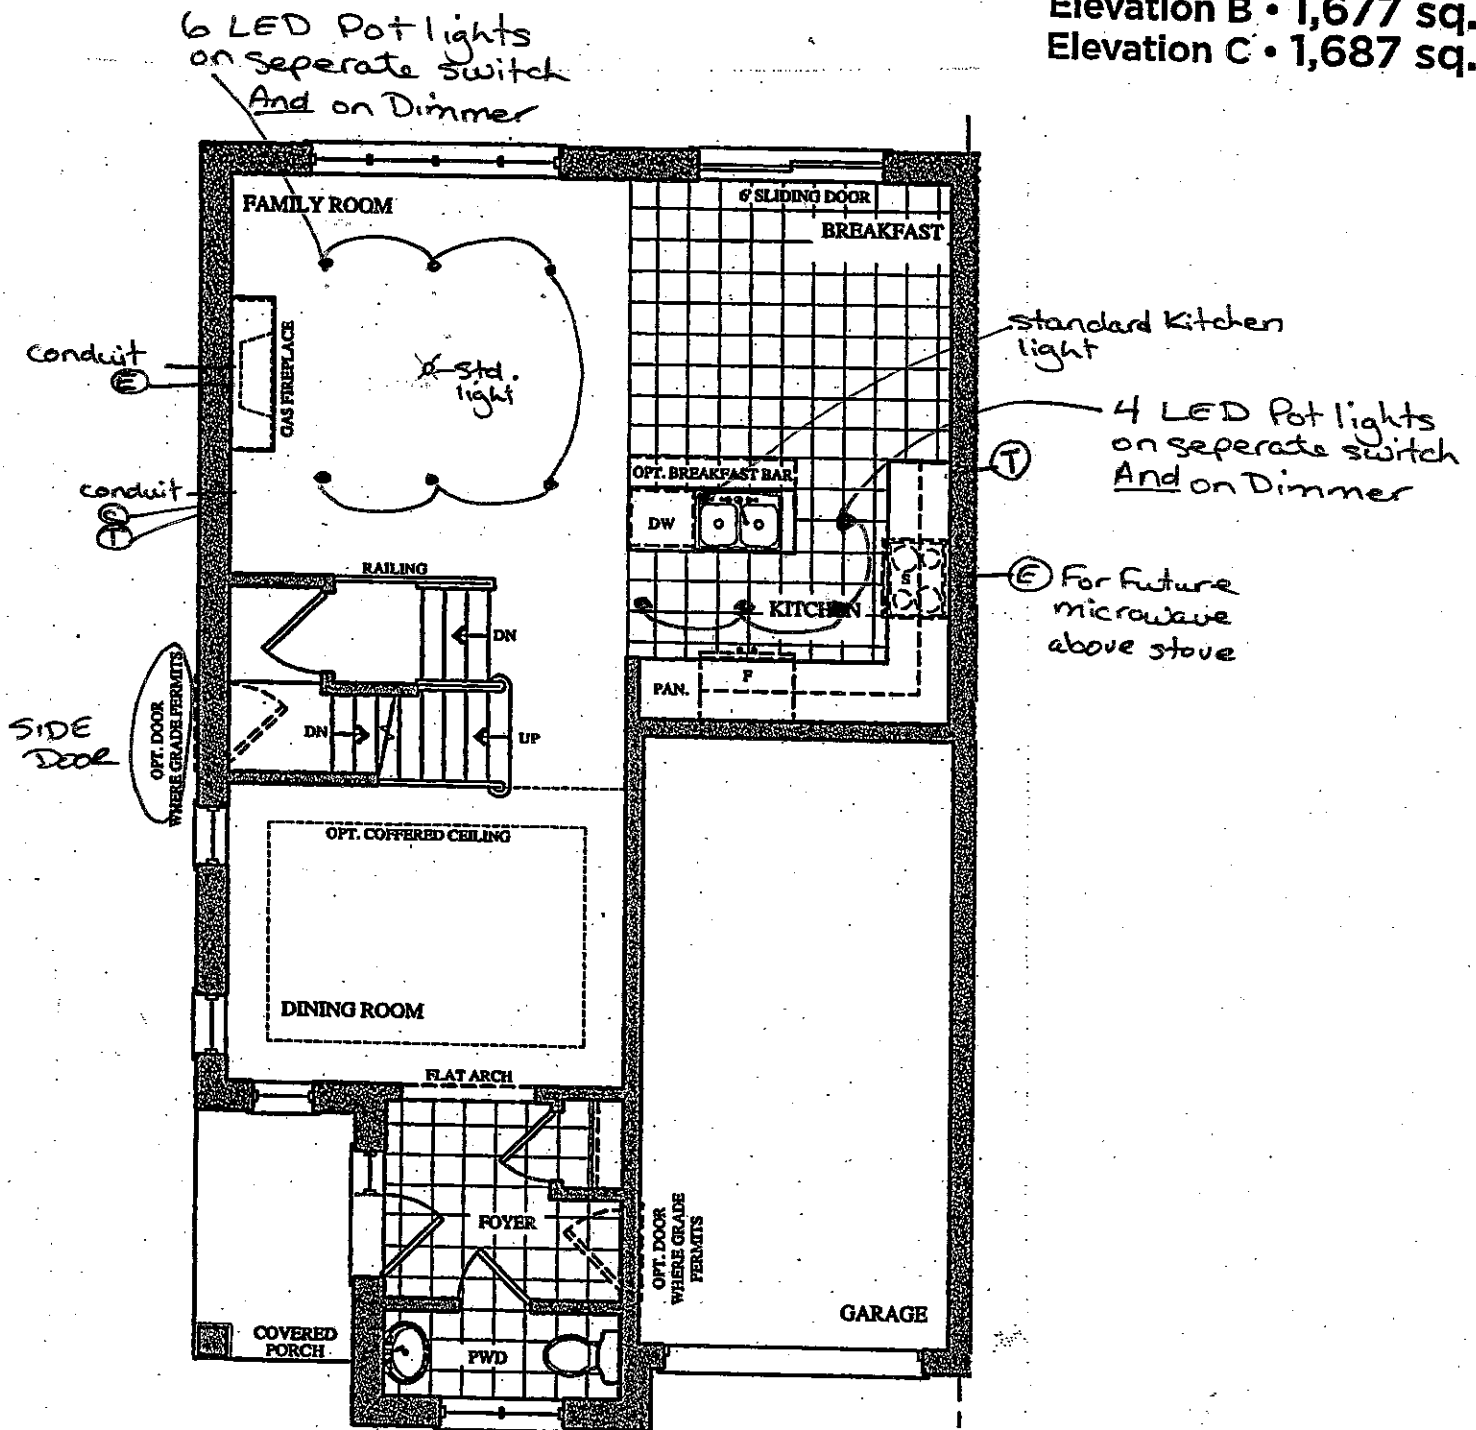

GROUND FLOOR PLAN
 ELEV. 'A' & 'B'

Lot 19L
 May 23, 17
 (C) (B)

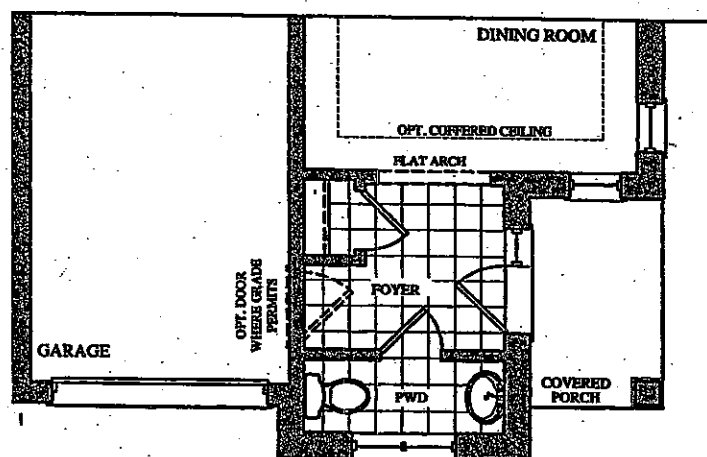


PART. GROUND FLOOR PLAN
 ELEV. 'C'

Telephone — (T)
 Cable — (C)


The Siren

SEMI SERIES

Elevation A • 1,688 sq.ft.
 Elevation B • 1,677 sq.ft.
 Elevation C • 1,687 sq.ft.

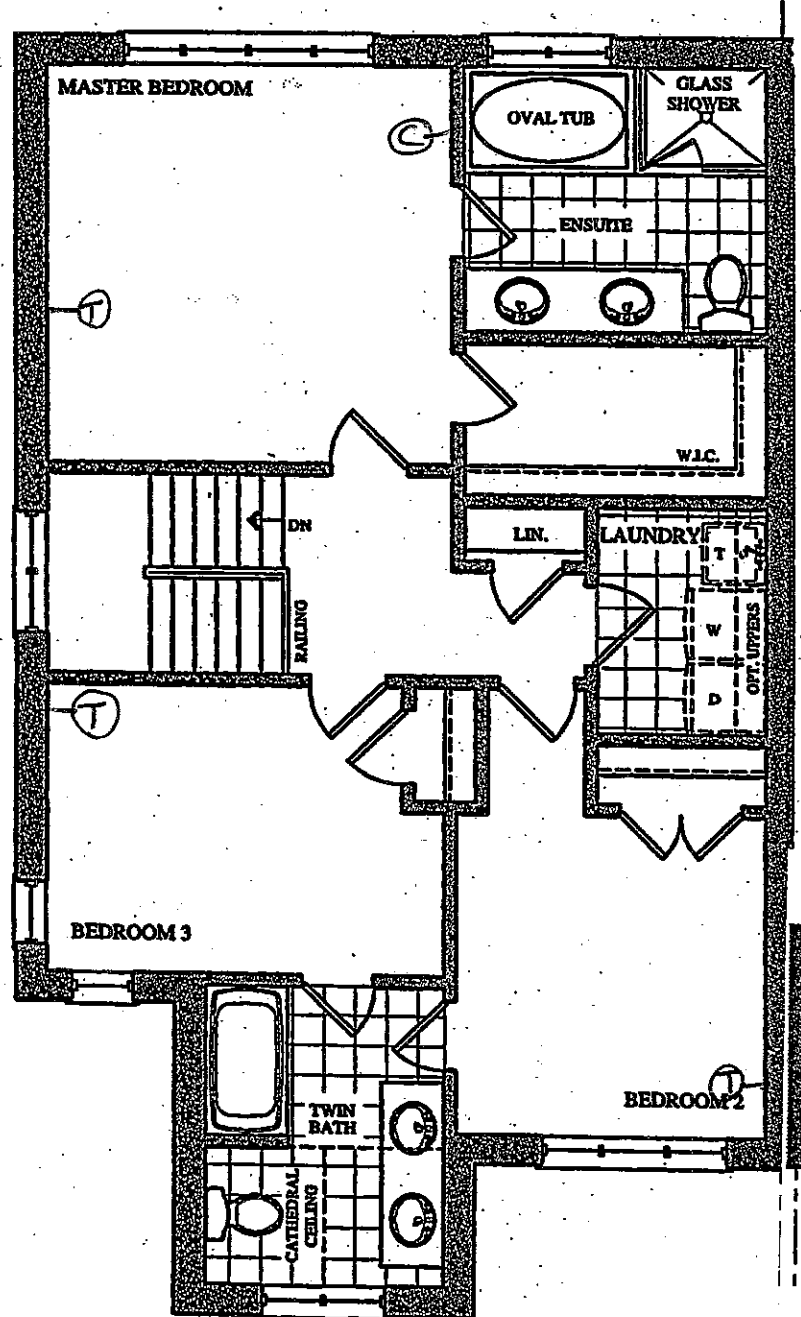


SECOND FLOOR PLAN
 ELEV. 'A'

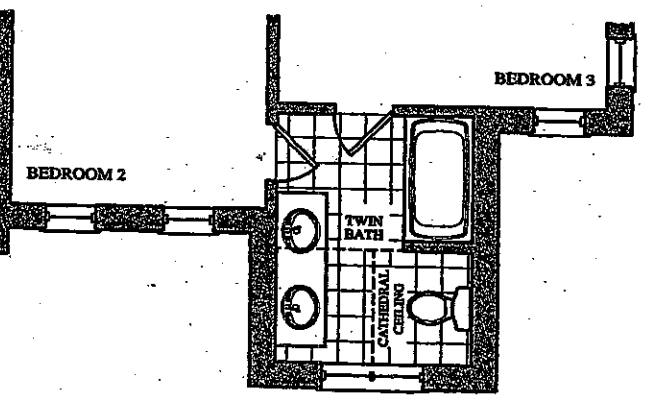

PART. SECOND FLOOR PLAN
 ELEV. 'B'

Lot 19L
 May 23, 17

(CS) (PG)

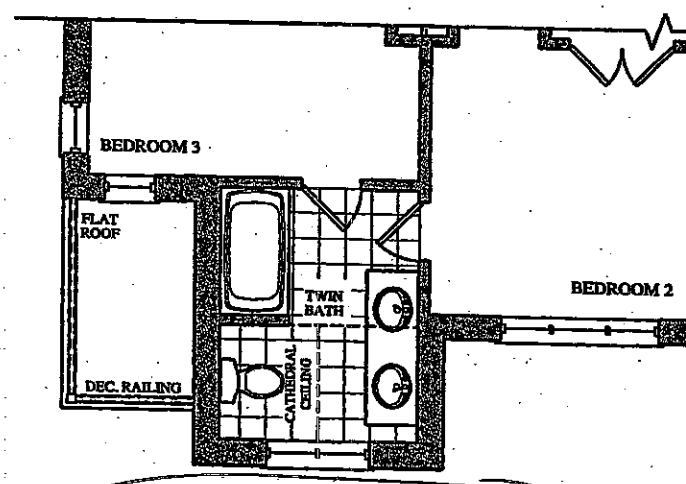


PART. SECOND FLOOR PLAN
 ELEV. 'C'

The Siren

SEMI SERIES

Elevation A • 1,688 sq.ft.
 Elevation B • 1,677 sq.ft.
 Elevation C • 1,687 sq.ft.

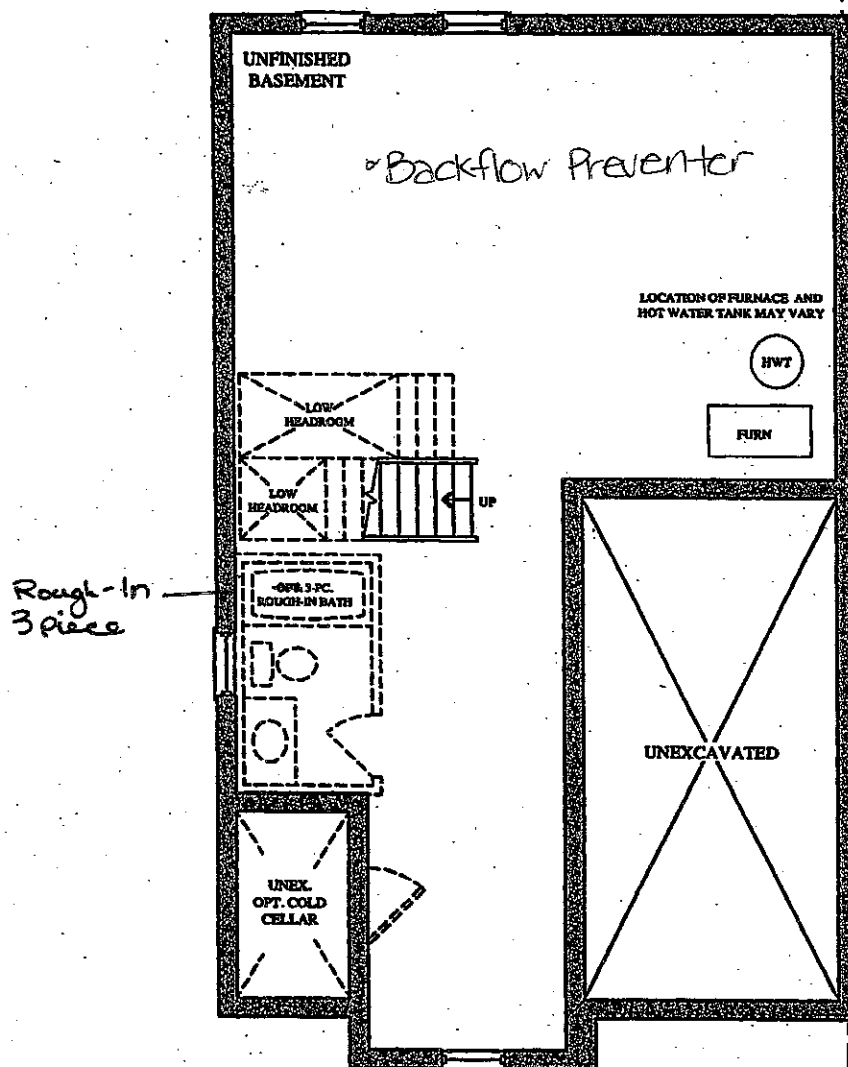

BASEMENT FLOOR PLAN
 ELEV. 'A', 'B' & 'C'

Lot 19L
 May 23, 17

(B)

(B)