

Brampton Encore - 2 - 2 - 38-6 Elev.B SCARLATTI OPT - OPTG

CENTRAL VAC AND WIRING

Inv.1,373	1 - GREAT ROOM: CONDUIT PIPE- FOR TELEVISION- LOCATE APPROX. 66" A.F.F. ABOVE FIREPLACE, TERMINATING BY CABLE. SEE PLAN FOR LOCATION.
Line21552	Note:
18May17 / 22Sep17	

CONCRETE AND DRAIN

Inv.1,373	1 - ROUGH-IN - 3PC BASEMENT ROUGH-IN
Line21570	Note:
18May17 / 22Sep17	

ELECTRICAL

Inv.1,373	1 - GREAT ROOM: 110V WALL RECEPTACLE ON NORMAL CIRCUIT - LOCATE ABOVE FIREPLACE, APPROX. 66" A.F.F.
Line21550	Note:
18May17 / 22Sep17	

Inv.1,373	1 - LIVING ROOM: ROUGH - IN CEILING OUTLET & SWITCH (WITH COVER PLATE) - DOES NOT INCLUDE FIXTURE - SEE PLAN FOR LOCATION
Line21555	Note:
18May17 / 22Sep17	

Inv.1,373	1 - LIVING ROOM: POT LIGHT: 4 INCH HALOGEN POT LIGHT - 440 WH- PRICED PER LIGHT- 1-9 POTLIGHTS
Line21556	Note:
18May17 / 22Sep17	

Inv.1,373	1 - LIVING ROOM: SINGLE POLE SWITCH FOR POTLIGHT
Line21557	Note:
18May17 / 22Sep17	

Inv.1,373	1 - LIVING ROOM: POT LIGHT: 4 INCH HALOGEN POT LIGHT - 440 WH- PRICED PER LIGHT- 1-9 POTLIGHTS
Line21558	Note:
18May17 / 22Sep17	

Inv.1,373	1 - GREAT ROOM: SINGLE POLE SWITCH FOR POTLIGHT
Line21559	Note:
18May17 / 22Sep17	

Inv.1,373	1 - DINING ROOM: POT LIGHT: 4 INCH HALOGEN POT LIGHT - 440 WH- PRICED PER LIGHT- 1-9 POTLIGHTS
Line21560	Note:
18May17 / 22Sep17	

Inv.1,373	1 - DINING ROOM: SINGLE POLE SWITCH FOR POTLIGHT
Line21561	Note:
18May17 / 22Sep17	

Inv.1,373	1 - KITCHEN: 240V WALL RECEPTICAL ON DEDICATED CIRCUIT- FOR 4 WIRE BUILT-IN WALL OVEN - SEE PLAN FOR LOCATION
Line21562	Note:
18May17 / 22Sep17	

Inv.1,373	1 - KITCHEN: ROUGH - IN CEILING OUTLET & SWITCH (WITH COVER PLATE) - DOES NOT INCLUDE FIXTURE - LOCATE ABOVE ISLAND, SEE PLAN FOR LOCATION
Line21563	Note:
18May17 / 22Sep17	

Brampton Encore - 2 - 2 - 38-6 Elev.B SCARLATTI OPT - OPTG

Inv.1,373	1 - KITCHEN: ROUGH - IN CEILING OUTLET ON SAME SWITCH - DOES NOT INCLUDE FIXTURE - LOCATE ABOVE ISLAND, USE SAME SWITCH AS OTHER ROUGH-IN ABOVE ISLAND. SEE PLAN FOR LOCATION.
Line21564	Note:
18May17 / 22Sep17	
Inv.1,373	1 - KITCHEN: RELOCATE FRIDGE, SEE PLAN FOR NEW LOCATION
Line24153	Note:
18May17 / 22Sep17	
Inv.1,373	1 - KITCHEN: GAS LINE ROUGH COMPLETE WITH REQUIRED ELECTRICAL 110V PLUG-MAIN FLOOR
Line24155	Note:
18May17 / 22Sep17	

Exterior Colours

Inv.1,373	1 - EXTERIOR COLOUR PACKAGE 7
Line24159	Note:
18May17 / 22Sep17	

FRAMING

Inv.1,373	1 - KITCHEN: RELOCATE FRIDGE, SEE PLAN FOR NEW LOCATION
Line21565	Note:
18May17 / 22Sep17	
Inv.1,373	1 - MANDOOR GARAGE TO HOUSE- GRADE PERMITS
Line24158	Note:
18May17 / 22Sep17	

HVAC

Inv.1,373	1 - KITCHEN: GAS LINE ROUGH COMPLETE WITH REQUIRED ELECTRICAL 110V PLUG-MAIN FLOOR
Line21566	Note:
18May17 / 22Sep17	

KITCHEN AND BATH CABINETRY

Inv.1,373	1 - KITCHEN: RELOCATE FRIDGE, SEE PLAN FOR NEW LOCATION
Line24154	Note:
18May17 / 22Sep17	

MISC.

Inv.1,373	1 - GRADE DOES NOT PERMIT SIDE DOOR- HOME TO EXTERIOR- TO BE REFUNDED ON PE:
Line21569	Note:
18May17 / 22Sep17	
Inv.1,373	1 - Purchaser has attended an appointment at the Decor Centre & has DECLINED any additional upgrades and accepts and acknowledges that there will be no further changes/additions/deletions to be made upon signing on May 18 2017.
Line21580	Note:
18May17 / 22Sep17	
Inv.1,373	1 - Purchasers are aware & accepts that ANY changes made to upgrades after signing this Purchasers Extra Form are subject to a minimum administration fee of \$500. PLUS a 10% holdback fee.
Line21581	Note:
18May17 / 22Sep17	

Brampton Encore - 2 - 2 - 38-6 Elev.B SCARLATTI OPT - OPTG

Inv.1,373	1 - BONUS PACKAGE: \$10,000.00 (INCLUDING TAXES) WORTH OF UPGRADES FROM GOLD PARK HOMES DÉCOR CENTRE IS BEING APPLIED TOWARD THE STRUCTURAL APPOINTMENT. PURCHASER HAS A REMAINING AMOUNT OF \$112.50 (INCLUDING TAXES) TO BE USED TOWARD THE COLOUR APPOINTMENT.
Line21582	Note:
18May17 / 22Sep17	

PLUMBING

Inv.1,373	1 - KITCHEN: ROUGH-IN - WATERLINE FOR FRIDGE
Line21568	Note:
18May17 / 22Sep17	


WINDOWS AND DOORS



Inv.1,373	1 - MANDOOR GARAGE TO HOUSE- GRADE PERMITS
Line24157	Note:
18May17 / 22Sep17	


mm (5)

38' SERIES

Elevation B • 3,578 sq.ft.

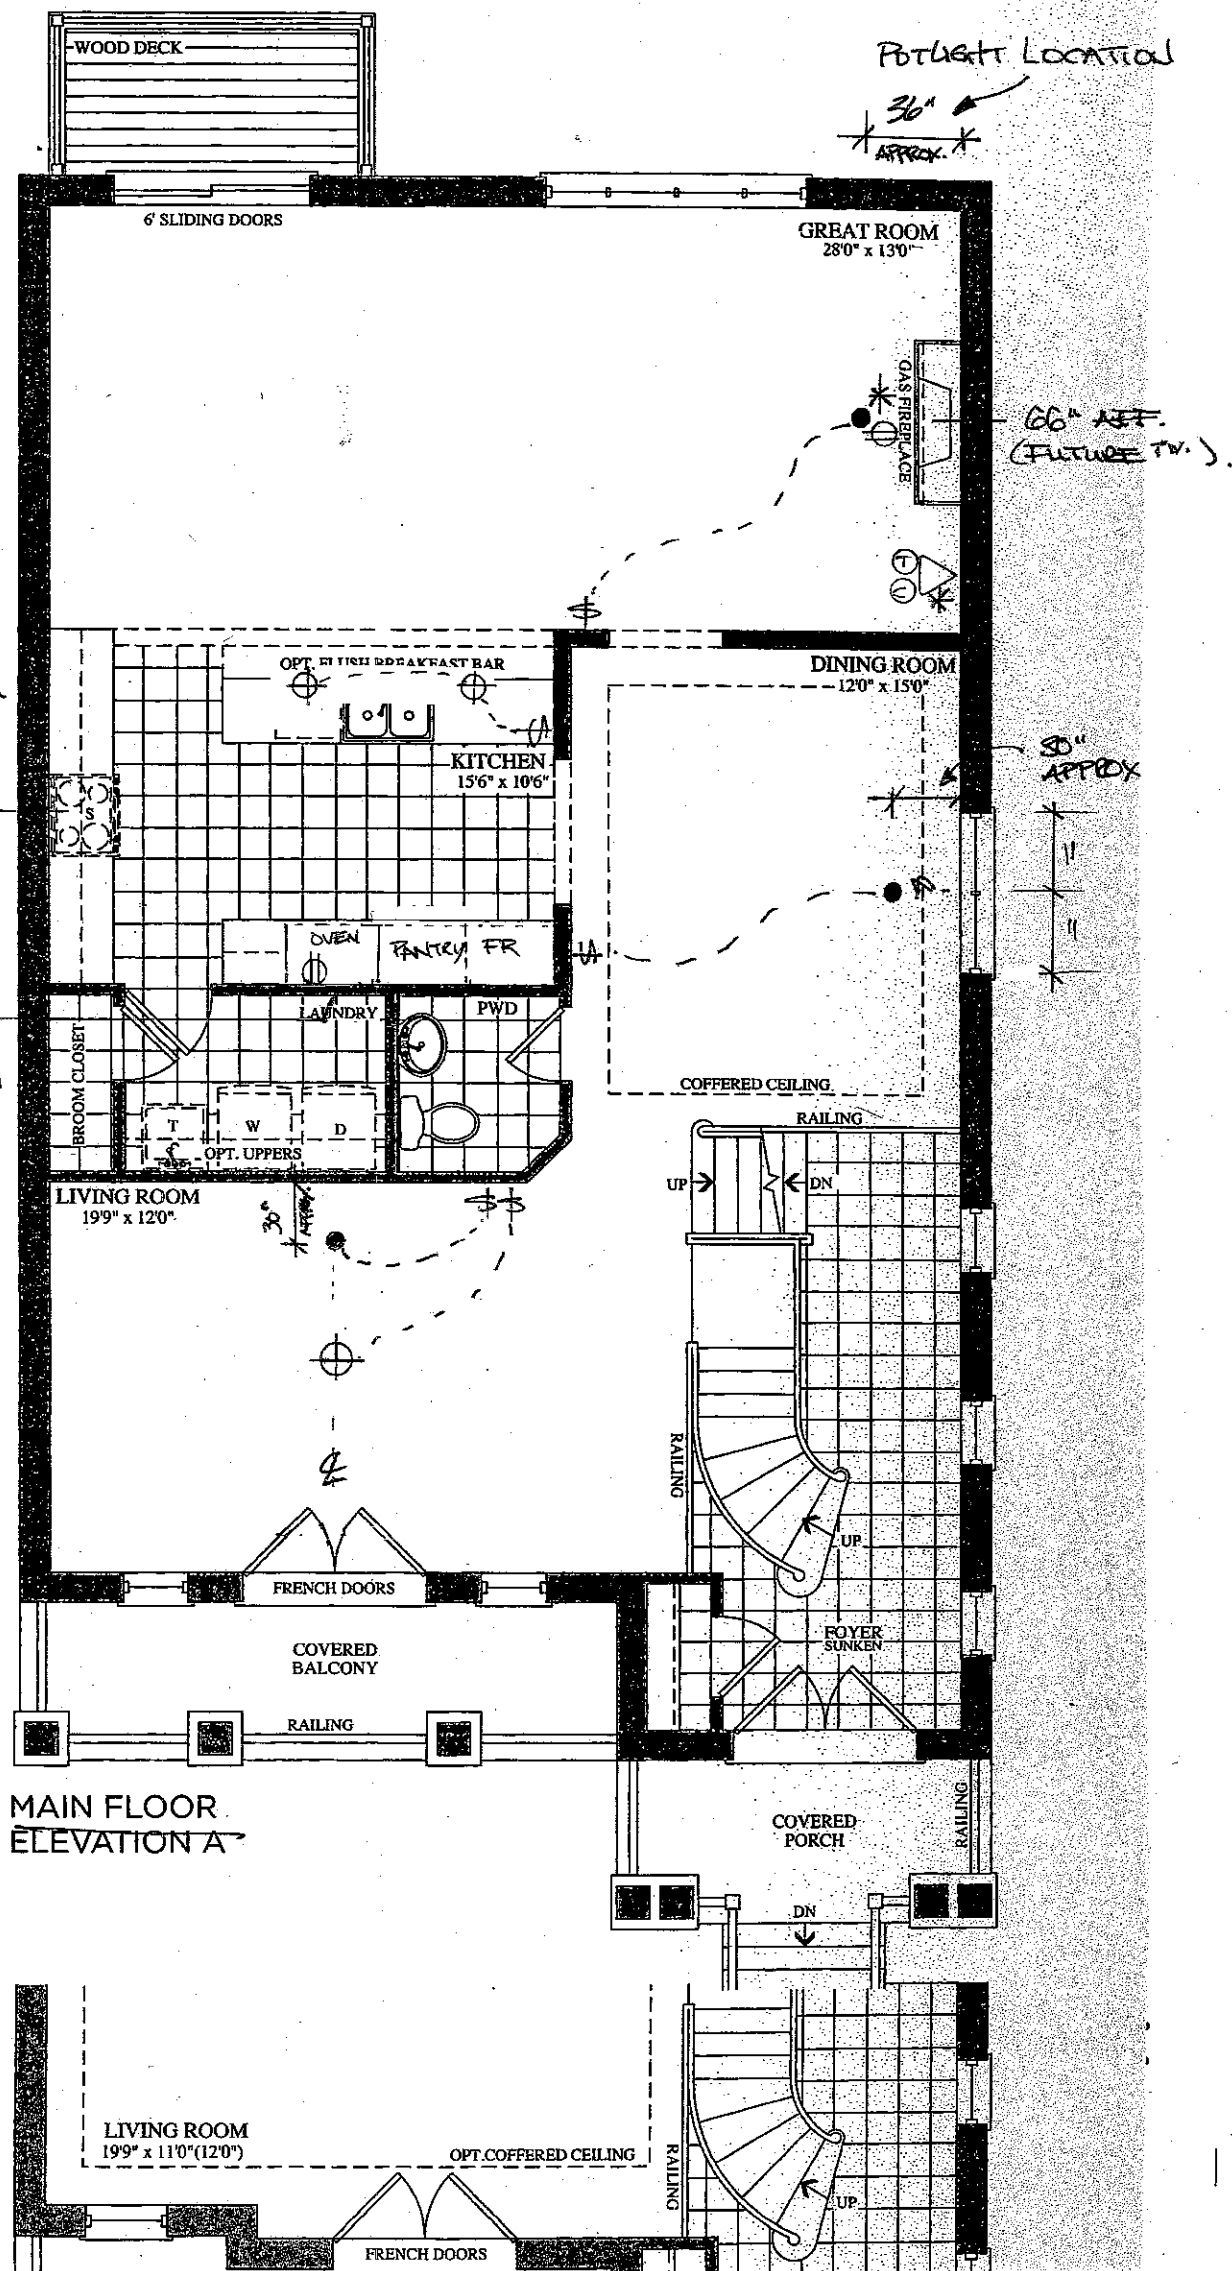

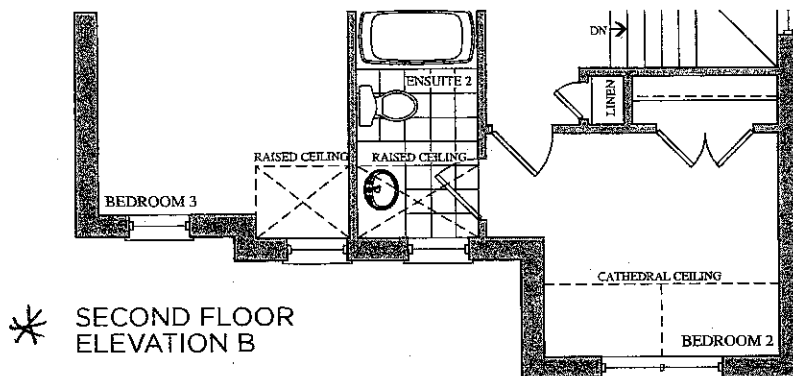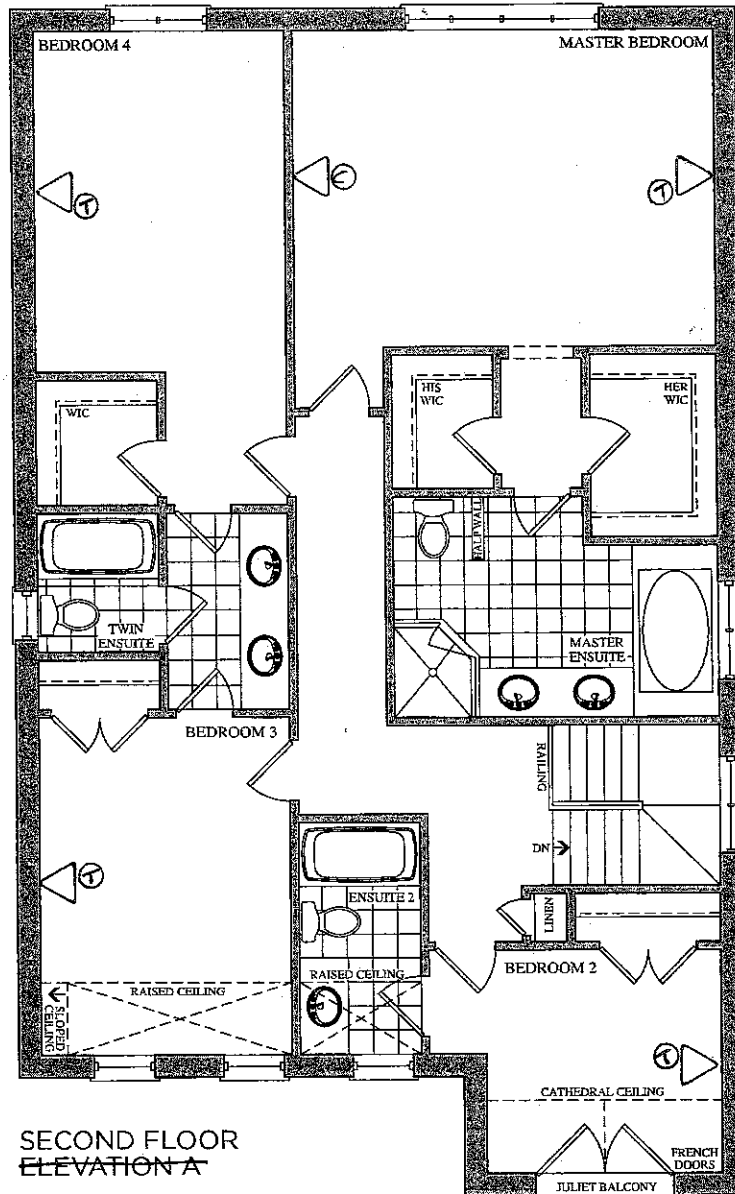

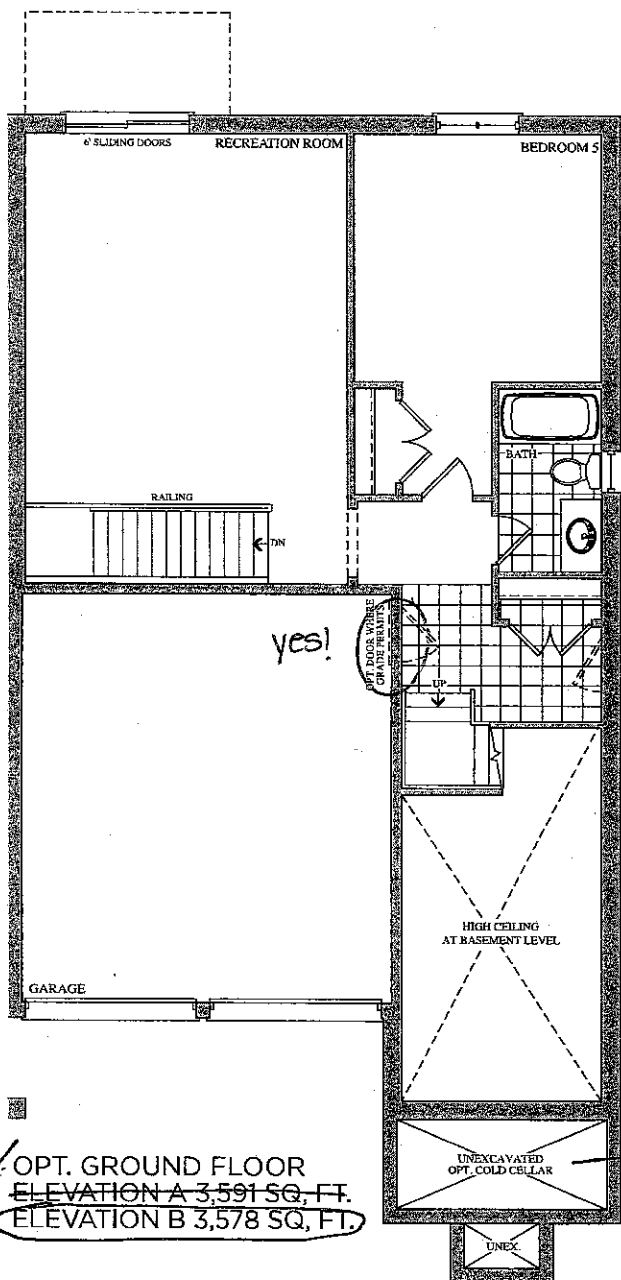

GOLDPARK
HOMES


BEZ-2.
MAY 18 2017

111


111

The
Scarlatti
38' SERIES

Elevation A • 3,591 sq.ft. Elevation B • 3,578 sq.ft.

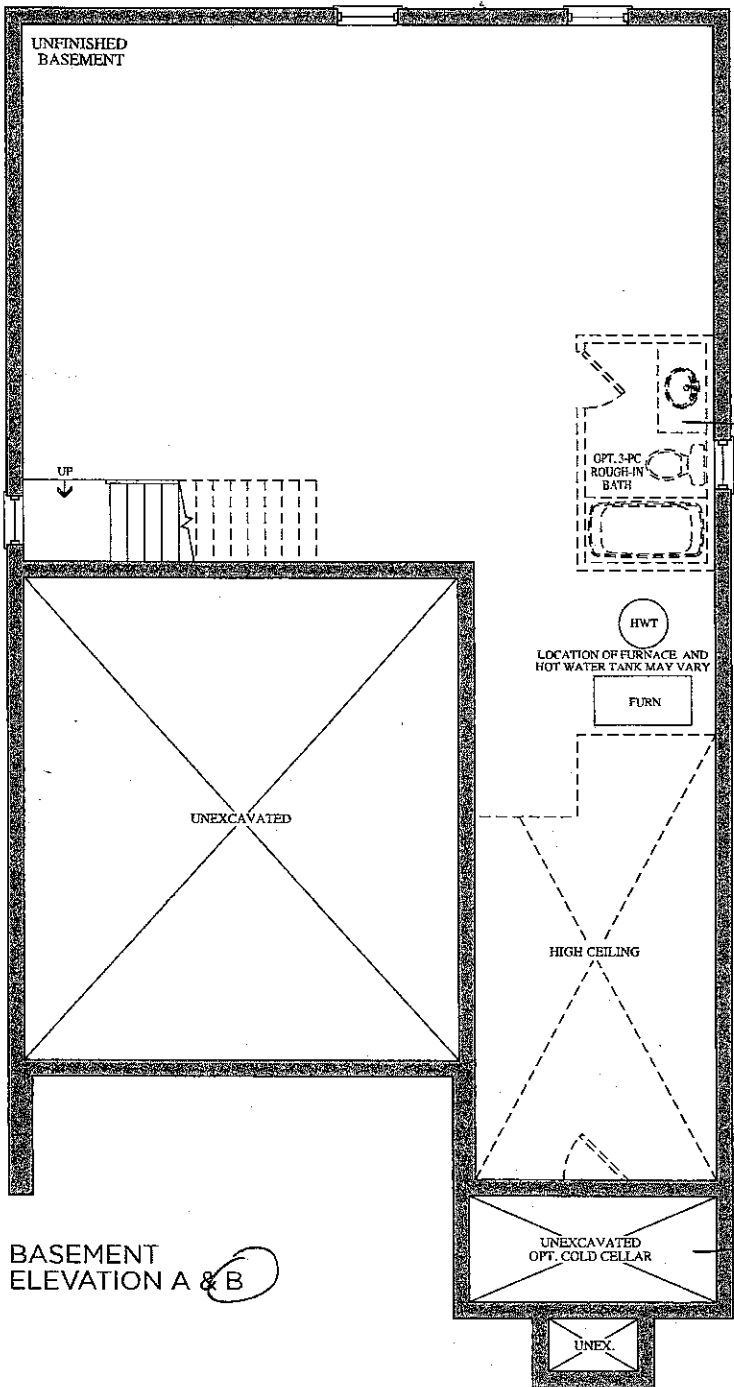

BASEMENT
ELEVATION A & B

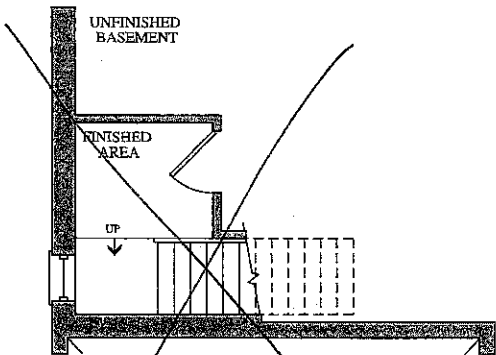

OPT. BASEMENT
ELEVATION A & B

Prices, figures, illustrations, sizes, features and finishes are subject to change without notice. E.&O.E. Areas and dimensions are approximate and actual usable floor space may vary from the stated area. Layout may be reverse of the unit purchased. E. & O.E.