



CONSTRUCTION SUMMARY

Brampton Encore - 47R - 2 - 28-2 Elev.B Siren

CENTRAL VAC AND WIRING

Inv.1,455	1 - FAMILY ROOM: CONDUIT PIPE- FOR TELEVISION- LOCATE ABOVE FIREPLACE, APPROX. 66" A.F.F., TERMINATING BESIDE CABLE - SEE PLAN FOR LOCATION
Line22755	Note:
26Jun17 / 26Sep17	

CONCRETE AND DRAIN

Inv.1,455	1 - BASEMENT: ROUGH-IN - 3PC BASEMENT ROUGH-IN
Line22783	Note:
26Jun17 / 26Sep17	

ELECTRICAL

Inv.1,455	1 - FAMILY ROOM: 110V WALL RECEPTACLE ON NORMAL CIRCUIT- LOCATE APPROX. 66" A.F.F. ABOVE FIREPLACE
Line22756	Note:
26Jun17 / 26Sep17	

Inv.1,455	1 - KITCHEN: RELOCATE STANDARD CEILING LIGHT TO ABOVE ISLAND. SEE PLAN FOR LOCATION
Line22759	Note:
26Jun17 / 26Sep17	

Inv.1,455	1 - KITCHEN: ROUGH - IN CEILING OUTLET ON SAME SWITCH - DOES NOT INCLUDE FIXTURE - LOCATE ABOVE ISLAND, USE SAME SWITCH AS STANDARD LIGHT
Line22760	Note:
26Jun17 / 26Sep17	

Inv.1,455	1 - KITCHEN: GAS LINE ROUGH - 2ND FLOOR- (2-STOREY MODELS) INCLUDES 110v ELECTRICAL
Line24185	Note:
26Jun17 / 26Sep17	

Exterior Colours

Inv.1,455	1 - EXTERIOR COLOUR PACKAGE 8
Line24183	Note:
26Jun17 / 26Sep17	

FRAMING

Inv.1,455	1 - KITCHEN: UPGRADE VENTING FOR STOVE TO 8" PIPE EXTERIOR WALL
Line24186	Note:
26Jun17 / 26Sep17	

GARAGE DOORS

Inv.1,455	1 - GARAGE DOOR OPENER *BELT DRIVE*- WITH 1 REMOTE- PRICE IS PER DOOR
Line22764	Note:
26Jun17 / 26Sep17	

HVAC

Inv.1,455	1 - KITCHEN: GAS LINE ROUGH - 2ND FLOOR- (2-STOREY MODELS) INCLUDES 110v ELECTRICAL
Line22757	Note:
26Jun17 / 26Sep17	

Brampton Encore - 47R - 2 - 28-2 Elev.B Siren

Inv.1,455	1 - KITCHEN: UPGRADE VENTING FOR STOVE TO 8" PIPE EXTERIOR WALL
Line22758	Note:
26Jun17 / 26Sep17	

MISC.

Inv.1,455	1 - GRADE DOES NOT PERMIT SIDE DOOR- HOME TO EXTERIOR- DO NOT INSTALL CREDIT TO BE ISSUED ON PE:
Line22761	Note:
26Jun17 / 26Sep17	

Inv.1,455	1 - Purchaser has attended an appointment at the Decor Centre & has DECLINED any additional upgrades and accepts and acknowledges that there will be no further changes/additions/deletions to be made upon signing on June 26 2017.
Line22765	Note:
26Jun17 / 26Sep17	

Inv.1,455	1 - Purchasers are aware & accepts that ANY changes made to upgrades after signing this Purchasers Extra Form are subject to a minimum administration fee of \$500. PLUS a 10% holdback fee.
Line22766	Note:
26Jun17 / 26Sep17	

Inv.1,455	1 - BONUS PACKAGE: \$15,000.00 (INCLUDING TAXES) WORTH OF UPGRADES FROM GOLD PARK HOMES DÉCOR CENTRE IS BEING APPLIED TOWARD THE STRUCTURAL APPOINTMENT. PURCHASER HAS A REMAINING AMOUNT OF \$5965.65 (INCLUDING TAXES) TO BE USED TOWARD THE COLOUR APPOINTMENT.
Line22767	Note:
26Jun17 / 26Sep17	

WINDOWS - BASEMENT

Inv.1,455	2 - BASEMENT WINDOWS - UPGRADE EXISTING BASEMENT WINDOW TO 30 INCH X 16 INCH
Line22762	Note:
26Jun17 / 26Sep17	


Inv.1,455	2 - BASEMENT WINDOWS - UPGRADE EXISTING BASEMENT WINDOW TO 30 INCH X 24 INCH - MAY REQUIRE INSTALLATION OF WINDOW WELL
Line22763	Note:
26Jun17 / 26Sep17	

BEZ-47R
JUNE 26 2017 (AS)

The Siren

SEMI SERIES


Elevation A • 1,688 sq.ft.
Elevation B • 1,677 sq.ft.
Elevation C • 1,687 sq.ft.

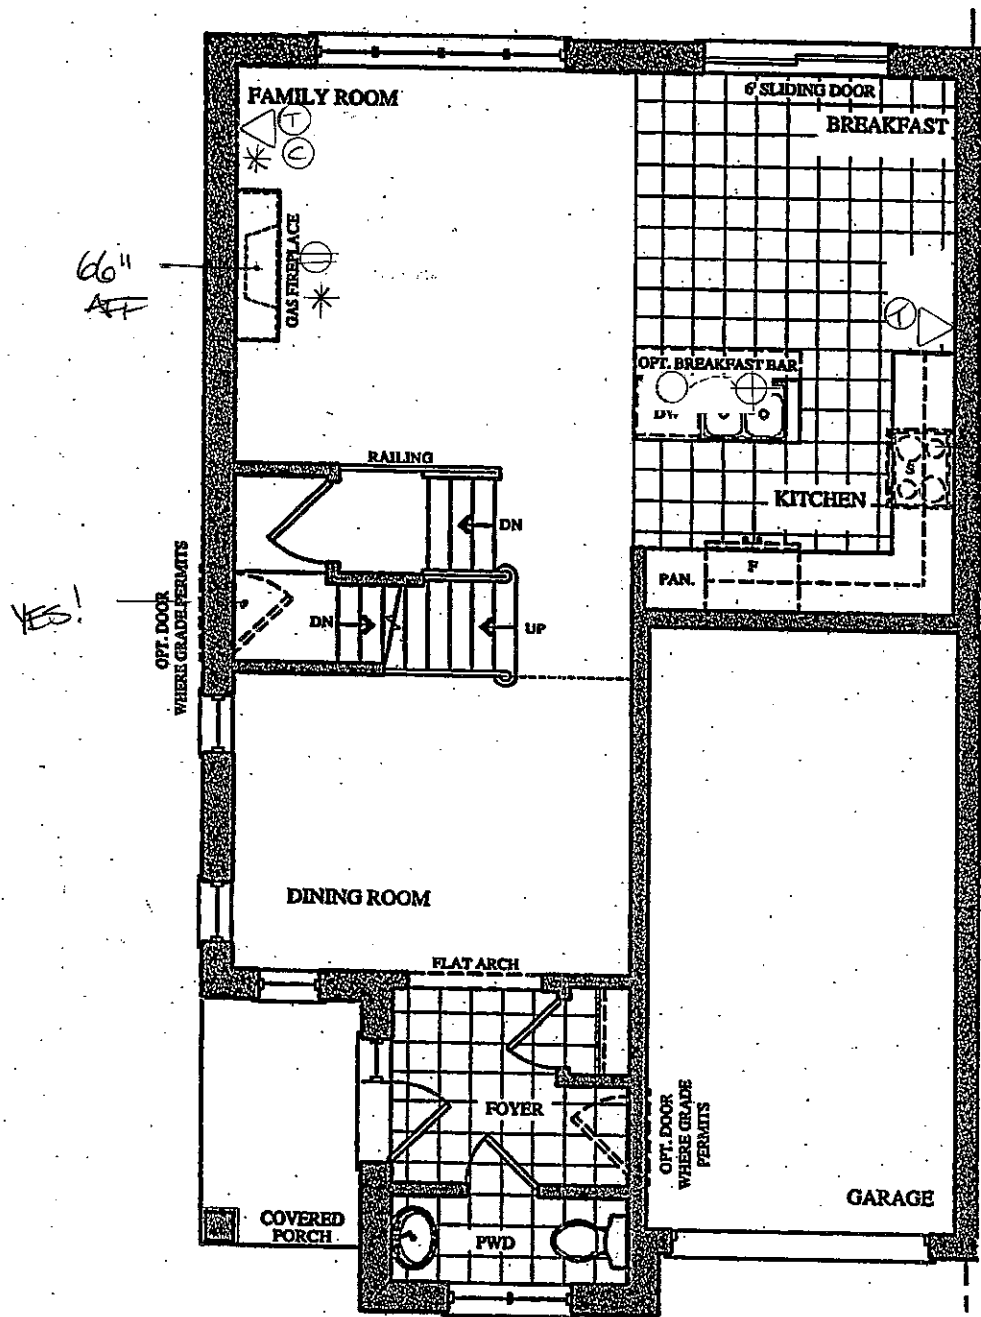

GROUND FLOOR PLAN
ELEV. 'A' & 'B'

LEGEND

- GAS LINE + 110V
8" DUCT
- △ R/IN.
- CABLE
- ⊙ ELECTRICAL OUTLET
- * CONDUIT
- STD CEILING LIGHT
- ⊙ CAPPED CEILING R/IN.

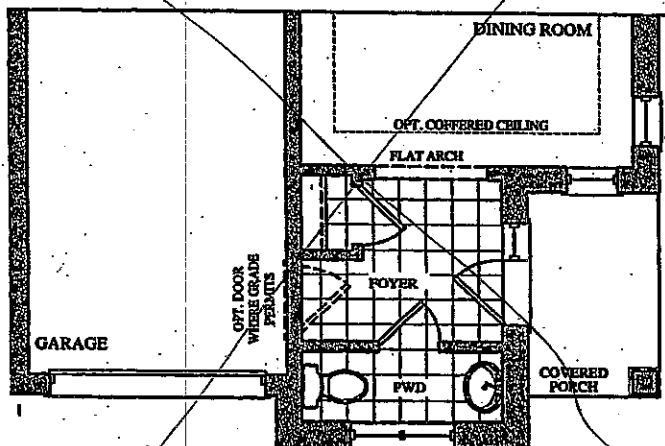

PART. GROUND FLOOR PLAN
ELEV. 'C'


BE2-47R
JUNE 26 2017

AS


The Siren

SEMI SERIES


Elevation A • 1,688 sq.ft.
Elevation B • 1,677 sq.ft.
Elevation C • 1,687 sq.ft.

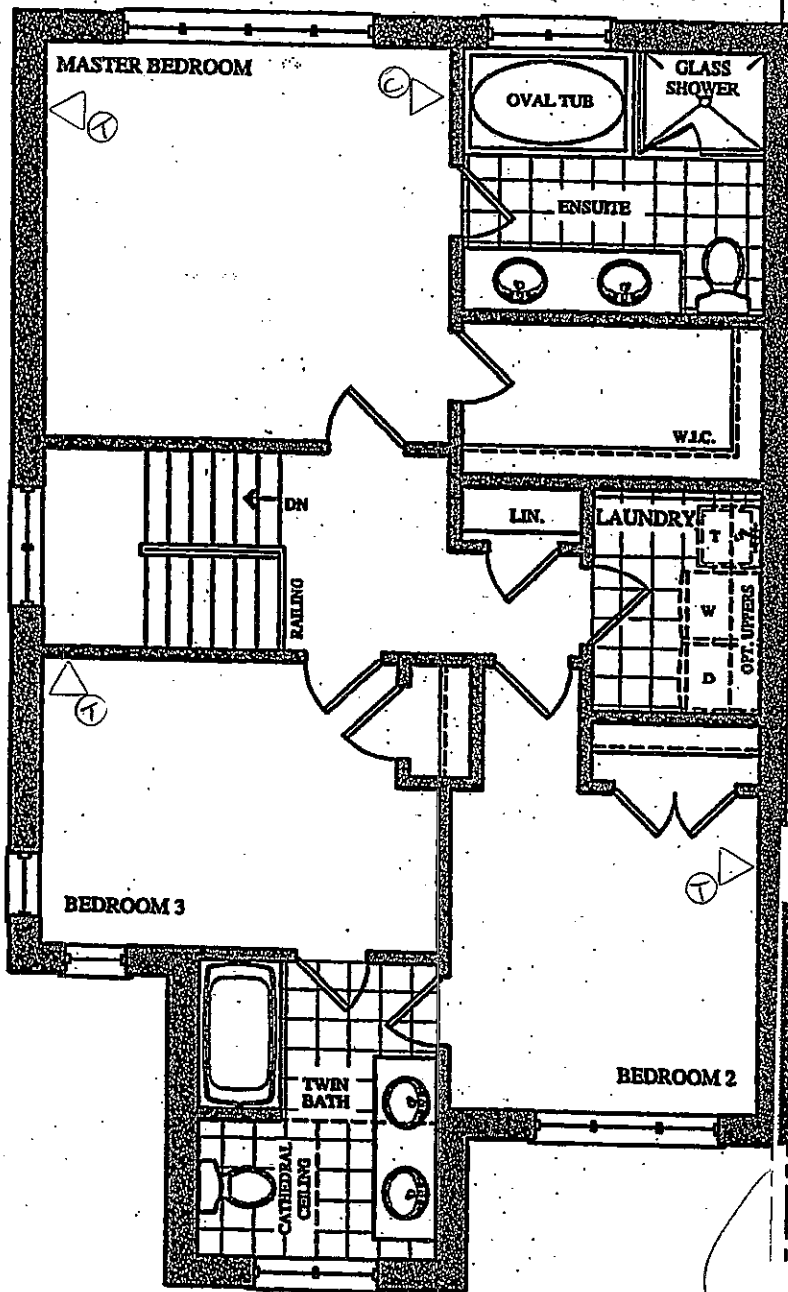

~~SECOND FLOOR PLAN
ELEV. 'A'~~

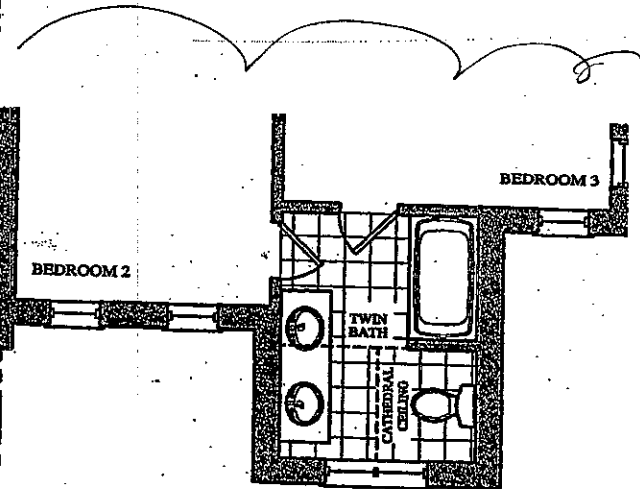

PART. SECOND FLOOR PLAN
ELEV. 'B'

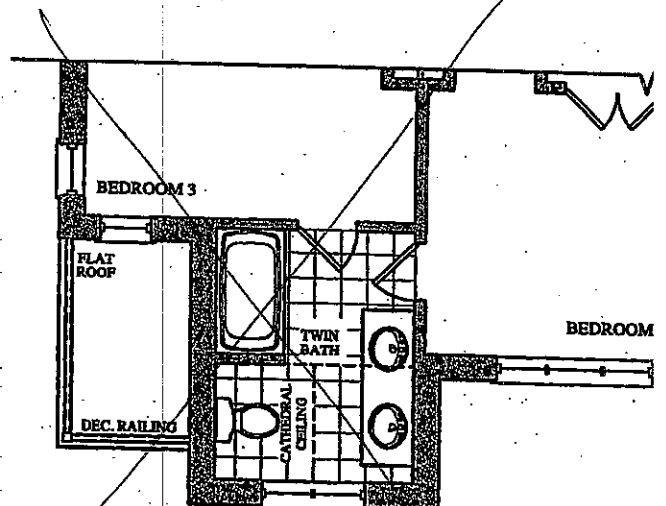

PART. SECOND FLOOR PLAN
ELEV. 'C'

BE2-47R
JUNE 26 2017 (AS)

The Siren

SEMI SERIES

Elevation A • 1,688 sq.ft.
→ Elevation B • 1,677 sq.ft.
Elevation C • 1,687 sq.ft.

