

Brampton Encore - 7L - 2 - 28-4 Elev.C ROSSINI OPT - OPT 4

CENTRAL VAC AND WIRING

Inv.1,351	1 - TELEPHONE AND CABLE ROUGH-IN LOCATION
Line21282	Note:
8May17 / 26Sep17	
Inv.1,351	1 - FAMILY ROOM: INSTALL CONDUIT PIPE- FOR TELEVISION- ABOVE FIREPLACE
Line21283	Note:
8May17 / 26Sep17	

ELECTRICAL

Inv.1,351	1 - FAMILY ROOM: INSTALL 110V WALL RECEPTACLE ON DEDICATED CIRCUIT - ABOVE FIREPLACE FOR TV
Line21284	Note:
8May17 / 26Sep17	
Inv.1,351	1 - LIVING ROOM: INSTALL ADDITIONAL STANDARD FIXTURE ON SAME SWITCH AS SWITCH CONTROLLED RECEPTICLE
Line21285	Note:
8May17 / 26Sep17	

Exterior Colours

Inv.1,351	1 - EXTERIOR COLOUR PACKAGE #9
Line24221	Note:
8May17 / 26Sep17	

FRAMING

Inv.1,351	1 - GARAGE: INSTALL MANDOOR ROUGH-IN- OPTION ONLY AVAILABLE IF GRADE DOES NOT PERMIT - APPLIED BY HEAD OFFICE
Line21288	Note:
8May17 / 26Sep17	

MISC.

Inv.1,351	1 - DO NOT INSTALL SIDE DOOR- HOME TO EXTERIOR- GRADE DOES NOT PERMIT
Line21287	Note:
8May17 / 26Sep17	
Inv.1,351	1 - BONUS PACKAGE: \$3683.80 (INCLUDING TAXES) WORTH OF UPGRADES FROM GOLD PARK HOMES DÉCOR CENTRE IS BEING APPLIED TOWARD THE STRUCTURAL APPOINTMENT. PURCHASER HAS A REMAINING AMOUNT OF \$2316.20 (INCLUDING TAXES) TO BE USED TOWARD THE COLOUR APPOINTMENT
Line21289	Note:
8May17 / 26Sep17	
Inv.1,351	1 - Purchaser has attended a Structural appointment at the Decor Centre & has DECLINED any additional upgrades and accepts and acknowledges that there will be no further structural changes/additions/deletions to be made upon signing on May 8, 2017
Line21290	Note:
8May17 / 26Sep17	
Inv.1,351	1 - Purchasers are aware & accepts that ANY changes made to upgrades after signing this Purchasers Extra Form are subject to a minimum administration fee of \$500. PLUS a 10% holdback fee.
Line21291	Note:
8May17 / 26Sep17	

WINDOWS - BASEMENT

Brampton Encore - 7L - 2 - 28-4 Elev.C ROSSINI OPT - OPT 4

Inv.1,351	2 - BASEMENT: INSTALL TWO (X2) BASEMENT WINDOWS - UPGRADE EXISTING BASEMENT WINDOW TO 30 INCH X 24 INCH - MAY REQUIRE INSTALLATION OF WINDOW WELL
Line21286	Note:
8May17 / 26Sep17	

WINDOWS AND DOORS


Inv.1,351	1 - GARAGE: INSTALL MANDOOR ROUGH-IN- OPTION ONLY AVAILABLE IF GRADE DOES NOT PERMIT - APPLIED BY HEAD OFFICE
Line24225	Note:
8May17 / 26Sep17	

Telephone — (T)
 Cable — (C)
 Electrical — (E)

The Rossini


SEMI SERIES

Elevation A • 1,911 sq.ft.
 Elevation B • 1,902 sq.ft.
 Elevation C • 1,966 sq.ft.
 Elevation D • 1,971 sq.ft.

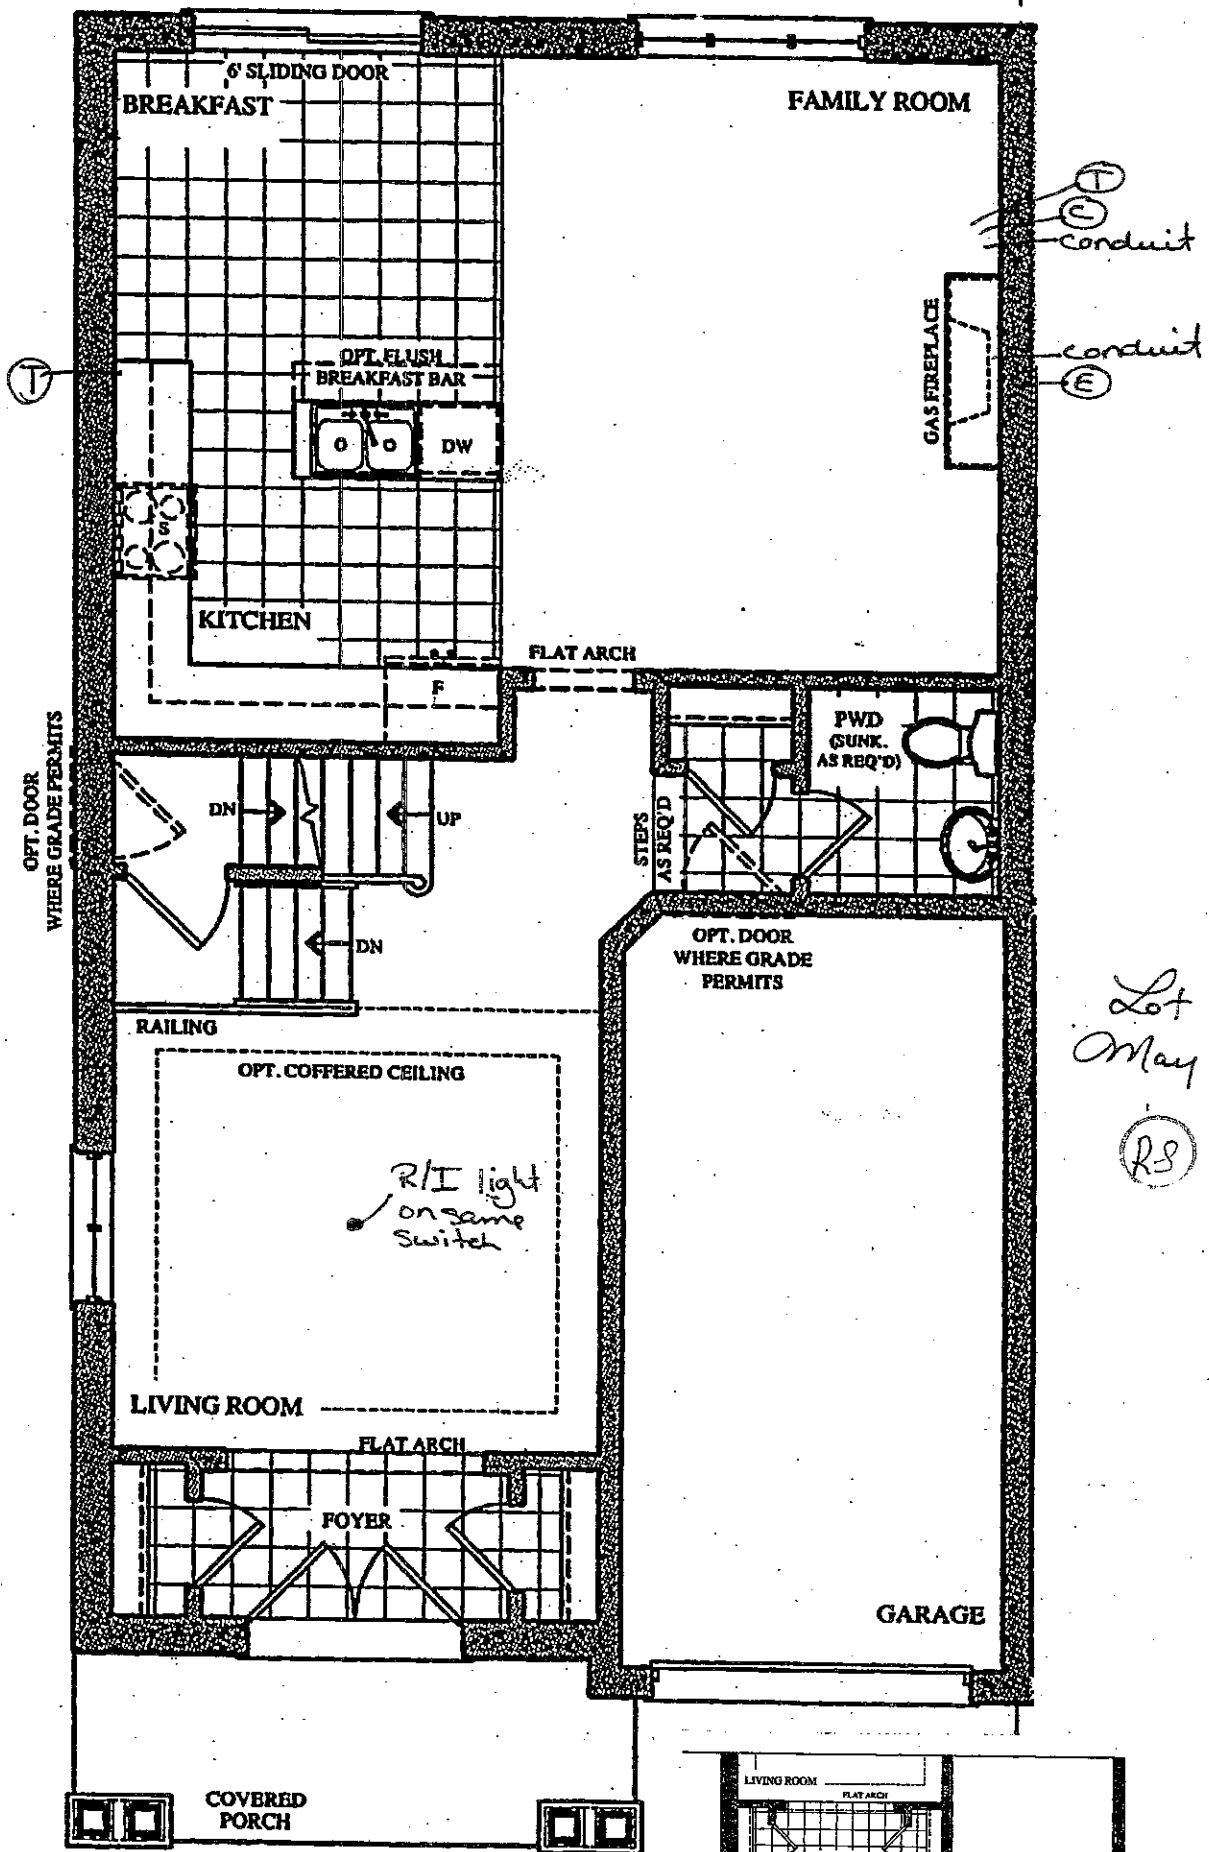


Lot 7L
 May 8, 17
 (RS) (J)


GROUND FLOOR PLAN
 ELEV. 'A' & 'B'

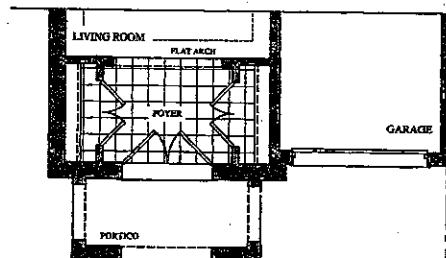

PART. GROUND FLOOR PLAN
 ELEV. 'C' & 'D'

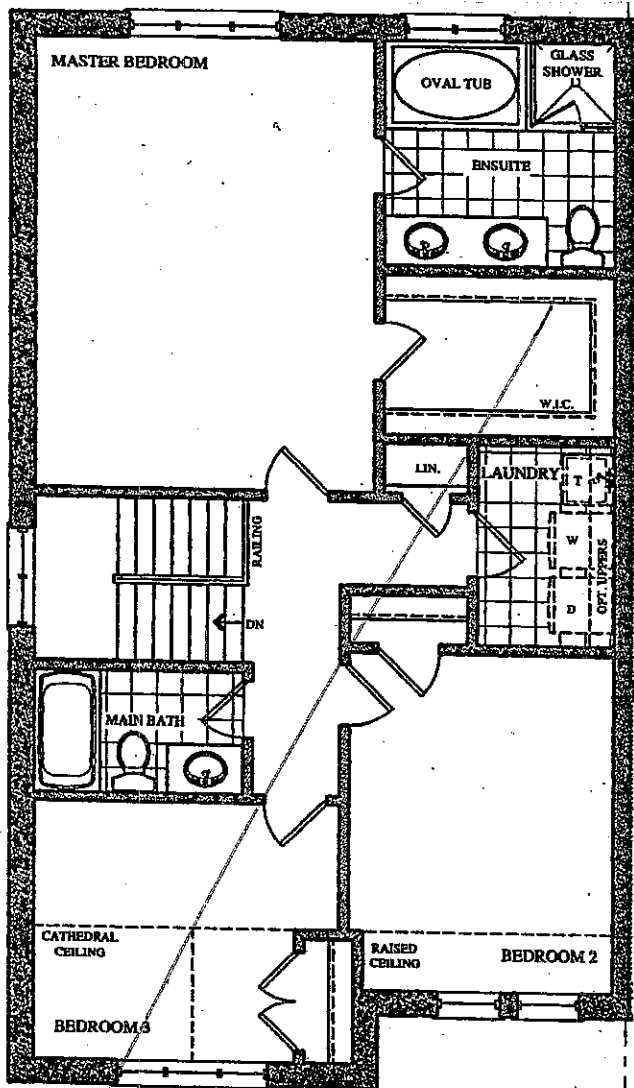

SECOND FLOOR PLAN
ELEV. 'A'

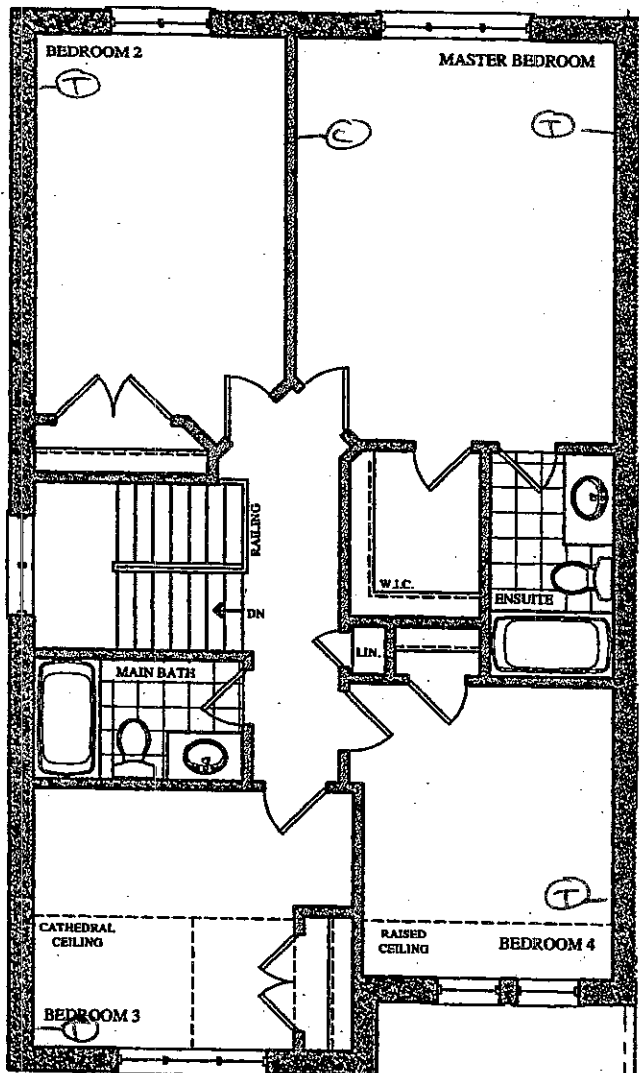


OPT. SECOND FLOOR PLAN
ELEV. 'A'


Telephone — (T)
Cable — (C)

The Rossini SEMI SERIES


Elevation A • 1,911 sq.ft.
Elevation B • 1,902 sq.ft.
Elevation C • 1,966 sq.ft.
Elevation D • 1,971 sq.ft.

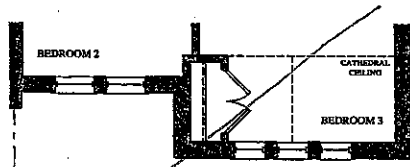


PART. SECOND FLOOR PLAN
ELEV. 'B'

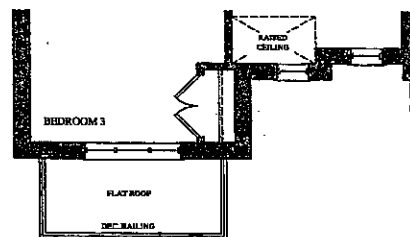


PART. SECOND FLOOR PLAN
ELEV. 'C'

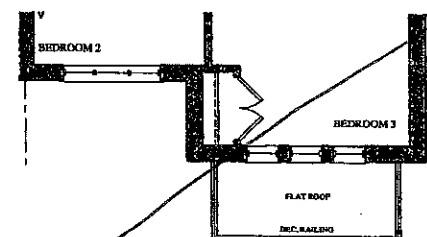


PART. SECOND FLOOR PLAN
ELEV. 'D'

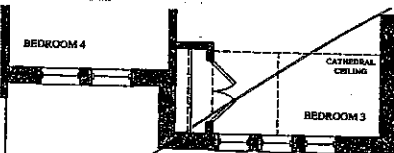

PART. OPT. SECOND FLOOR PLAN
ELEV. 'B'

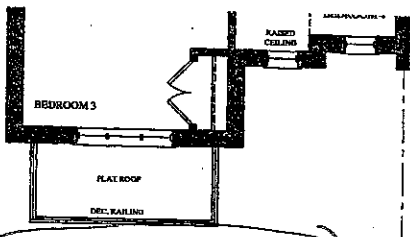

PART. OPT. SECOND FLOOR PLAN
ELEV. 'C'

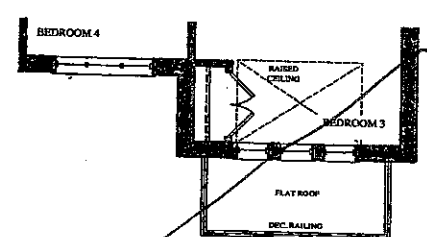


PART. OPT. SECOND FLOOR PLAN
ELEV. 'D'

Lot 7 L
May 8, 17
(RS) (Jo)

THE Rossini SEMI SERIES

BSMNT WINDOWS
2 x 30" x 24"


Elevation A • 1,911 sq.ft.
Elevation B • 1,902 sq.ft.
Elevation C • 1,966 sq.ft.
Elevation D • 1,971 sq.ft.

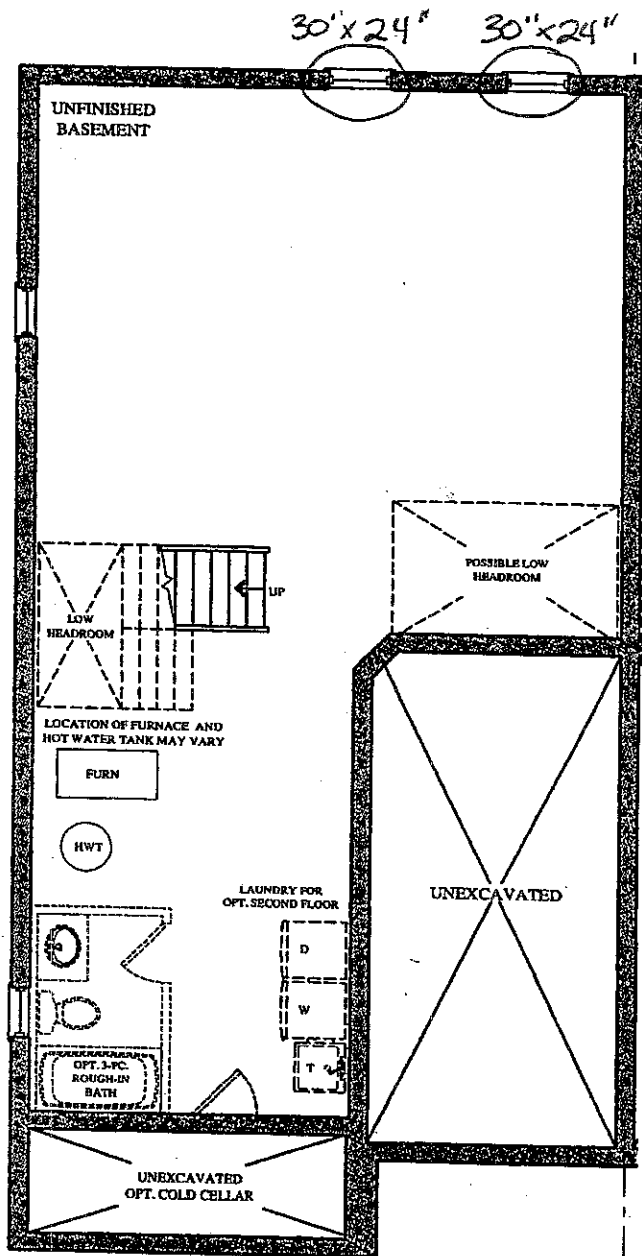

BASEMENT FLOOR PLAN
ELEV. 'A' & 'B'

Lot 7L
May 8, 17

RS JK

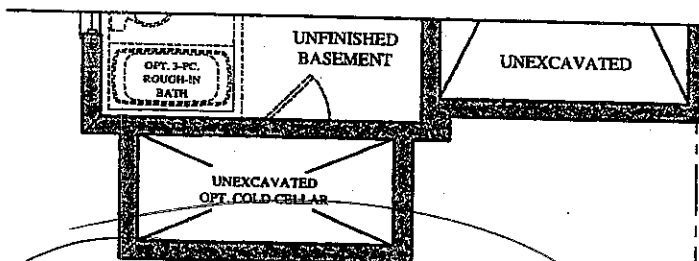

PART. BASEMENT FLOOR PLAN
ELEV. 'C' & 'D'