

**Brampton Encore - 6R - 2 - 28-6 Elev.B BERLIO OPT - OPT 4**

**CENTRAL VAC AND WIRING**

Inv.1,378	1 - UPPER HALL: ROUGH-IN FOR EXTRA SECURITY KEY PAD
Line21635	Note:
23May17 / 26Sep17	
Inv.1,378	1 - FAMILY ROOM: CONDUIT PIPE- FOR TELEVISION- LOCATE APPROX. 66" A.F.F. ABOVE FIREPLACE, TERMINATING NEXT TO CABLE. SEE PLAN FOR LOCATION.
Line21636	Note:
23May17 / 26Sep17	

**ELECTRICAL**

Inv.1,378	1 - FAMILY ROOM: 110V WALL RECEPTACLE ON NORMAL CIRCUIT-LOCATE APPROX. 66" A.F.F. ABOVE FIREPLACE.
Line21637	Note:
23May17 / 26Sep17	
Inv.1,378	1 - KITCHEN: MOVE STANDARD CEILING LIGHT TO ABOVE ISLAND, SEE PLAN FOR LOCATION.
Line21641	Note:
23May17 / 26Sep17	
Inv.1,378	1 - KITCHEN: ROUGH - IN CEILING OUTLET ON SAME SWITCH - DOES NOT INCLUDE FIXTURE - LOCATE ABOVE ISLAND, USE SAME SWITCH AS STANDARD CEILING LIGHT
Line21642	Note:
23May17 / 26Sep17	

**FORMING**

Inv.1,378	1 - SIDE DOOR- HOME TO EXTERIOR- AS PER PLAN AND GRADE PERMITTING
Line21651	Note:
23May17 / 26Sep17	

**FRAMING**

Inv.1,378	1 - MAIN FLOOR: FRAME MAIN FLOOR DOORS AND ARCHES AT 96" - ADDED WITH THE ADDITION OF TALLER INTERIOR DOORS
Line21643	Note:
23May17 / 26Sep17	
Inv.1,378	1 - KITCHEN: UPGRADE VENTING FOR STOVE TO 8" PIPE EXTERIOR WALL
Line24218	Note:
23May17 / 26Sep17	

**HVAC**

Inv.1,378	1 - KITCHEN: UPGRADE VENTING FOR STOVE TO 8" PIPE EXTERIOR WALL
Line21639	Note:
23May17 / 26Sep17	

**INTERIOR TRIM AND DOORS**

Inv.1,378	3 - MAIN FLOOR: EXTENDED HEIGHT ARCHWAY (PRICE PER DOORWAY) -96"
Line21644	Note:
23May17 / 26Sep17	

**MISC.**

**Brampton Encore - 6R - 2 - 28-6 Elev.B BERLIO OPT - OPT 4**

Inv.1,378	1 - Purchaser has attended an appointment at the Decor Centre & has DECLINED any additional upgrades and accepts and acknowledges that there will be no further changes/additions/deletions to be made upon signing on May 23 2017.
Line21647	Note:
23May17 / 26Sep17	
Inv.1,378	1 - Purchasers are aware & accepts that ANY changes made to upgrades after signing this Purchasers Extra Form are subject to a minimum administration fee of \$500. PLUS a 10% holdback fee.
Line21648	Note:
23May17 / 26Sep17	
Inv.1,378	1 - BONUS PACKAGE: \$5,000.00 (INCLUDING TAXES) WORTH OF UPGRADES FROM GOLD PARK HOMES DÉCOR CENTRE IS BEING APPLIED TOWARD THE STRUCTURAL APPOINTMENT. PURCHASER HAS A REMAINING AMOUNT OF \$0.00 (INCLUDING TAXES) TO BE USED TOWARD THE COLOUR APPOINTMENT.
Line21649	Note:
23May17 / 26Sep17	

**WINDOWS AND DOORS**


Inv.1,378	1 - SIDE DOOR- HOME TO EXTERIOR- AS PER PLAN AND GRADE PERMITTING
Line24219	Note:
23May17 / 26Sep17	
Inv.1,587	1 - DO NOT SUPPLY OR INSTALL MANDOOR- GRADE DOES NOT PERMIT
Line24220	Note:
26Sep17 / 26Sep17	

BEZ-6R  
MAY 23 2017

15

The  
Berlio  
SEMI SERIES

- Elevation A • 2,047 sq.ft.
- Elevation B • 2,037 sq.ft.
- Elevation C • 2,037 sq.ft.
- Elevation D • 2,047 sq.ft.

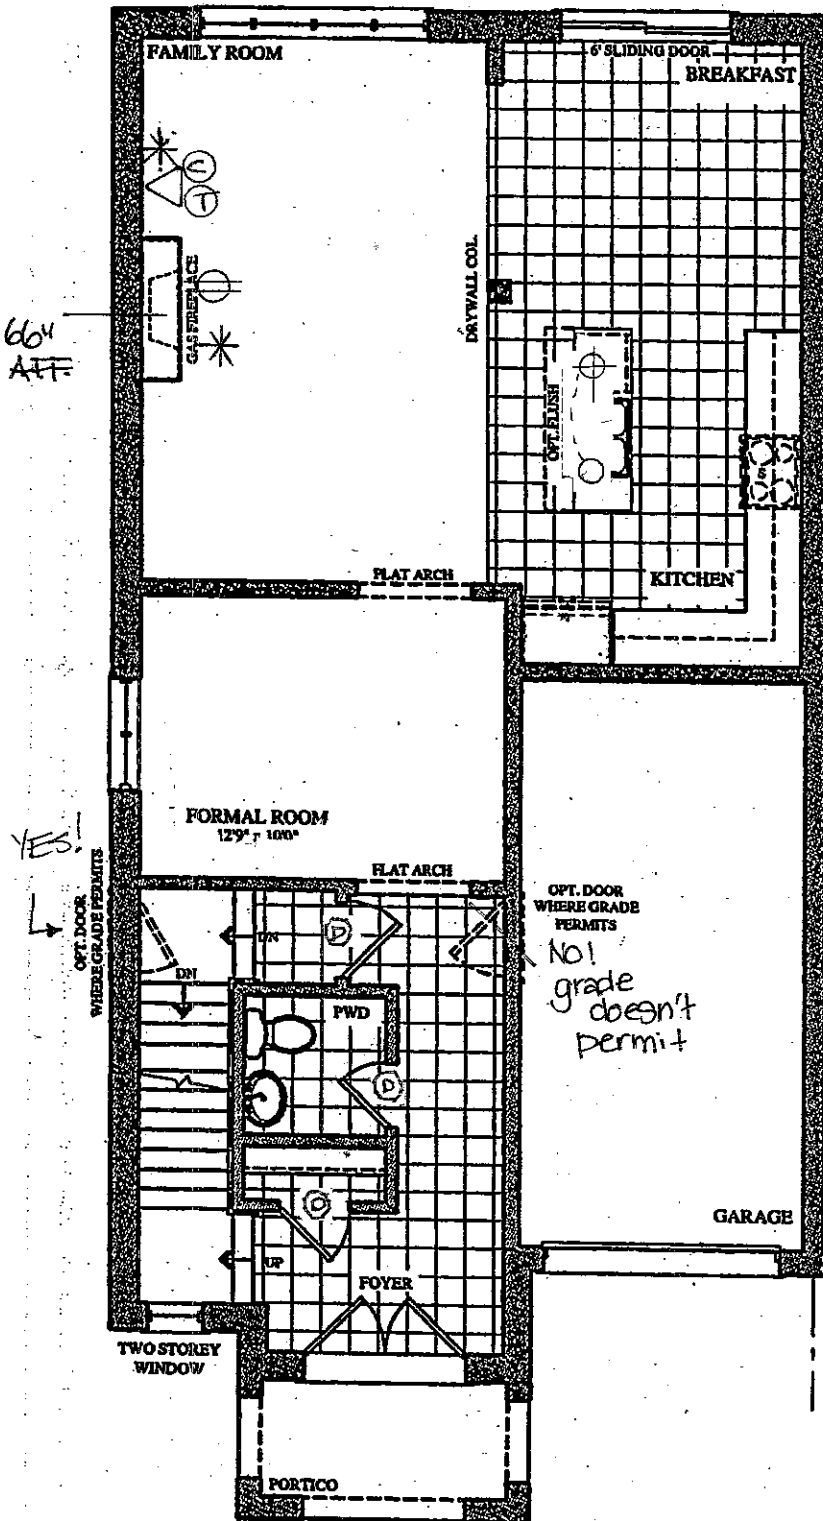


GROUND FLOOR PLAN  
ELEV. 'A' & 'B'

No PHONE  
in Kitchen.

8" vent

96" taller doors

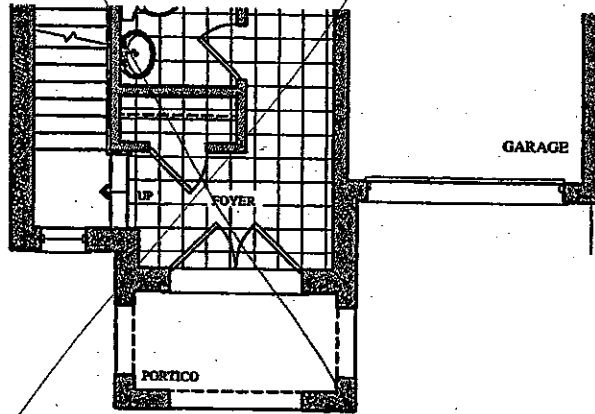









PART. GROUND FLOOR PLAN  
ELEV. 'C' & 'D'

BE2-6R  
MAY 23 2017

# The Berlio

## SEMI SERIES

Elevation A • 2,047 sq.ft.  
Elevation B • 2,037 sq.ft.  
Elevation C • 2,037 sq.ft.  
Elevation D • 2,047 sq.ft.

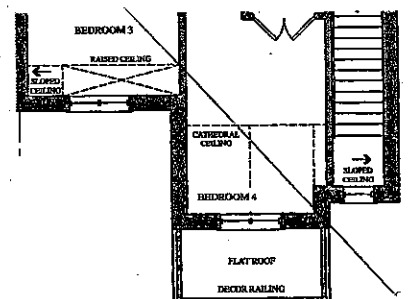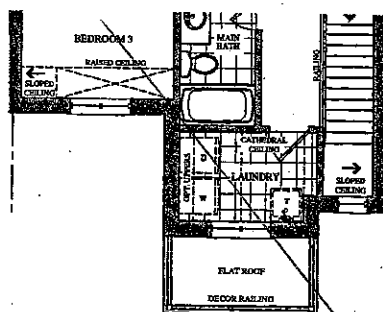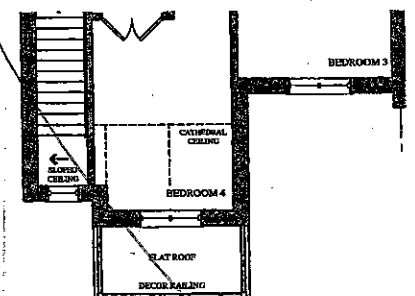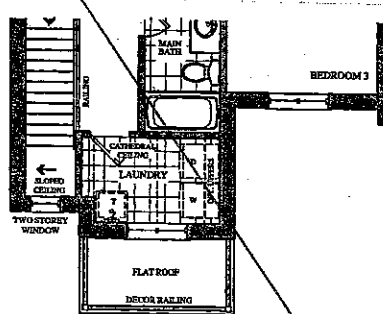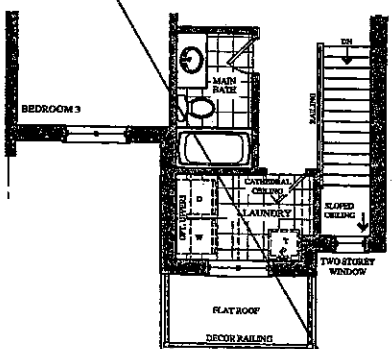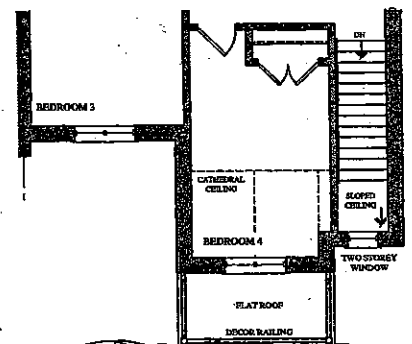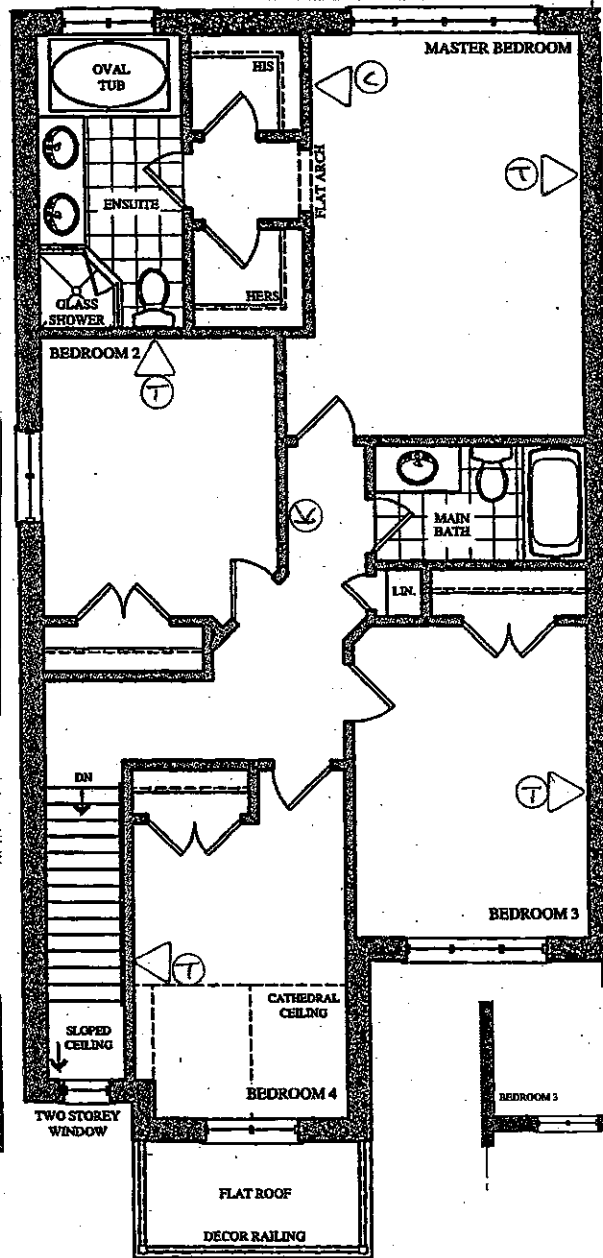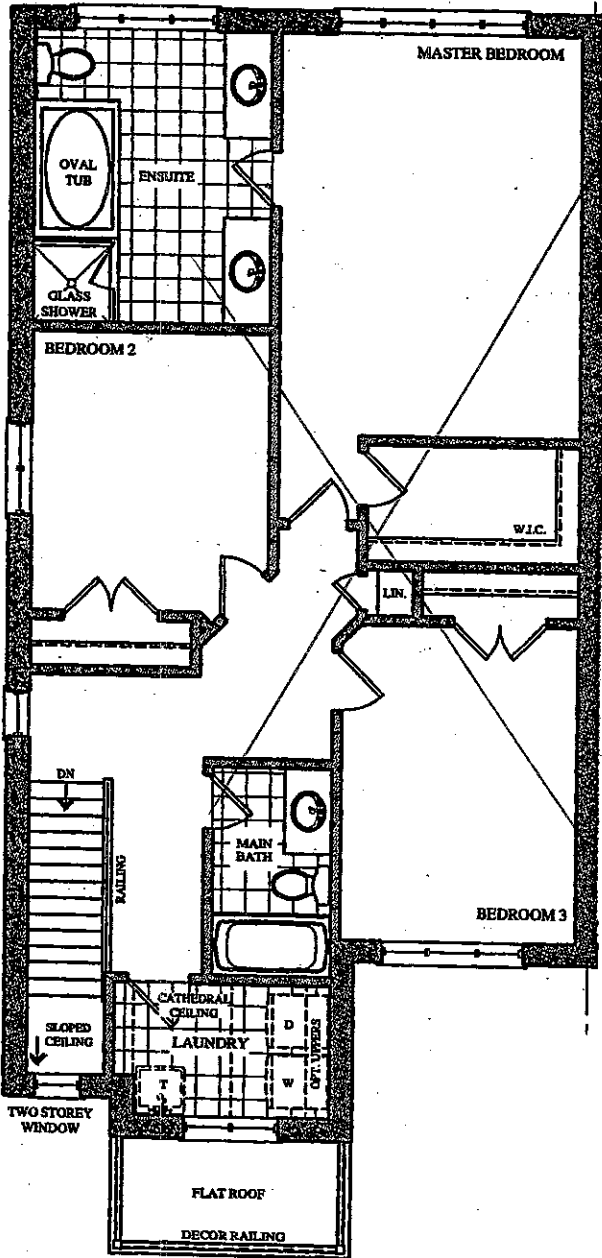


BE2-6R  
MAY 23 2017



The  
**Berlio**  
SEMI SERIES

- Elevation A • 2,047 sq.ft.
- Elevation B • 2,037 sq.ft.
- Elevation C • 2,037 sq.ft.
- Elevation D • 2,047 sq.ft.

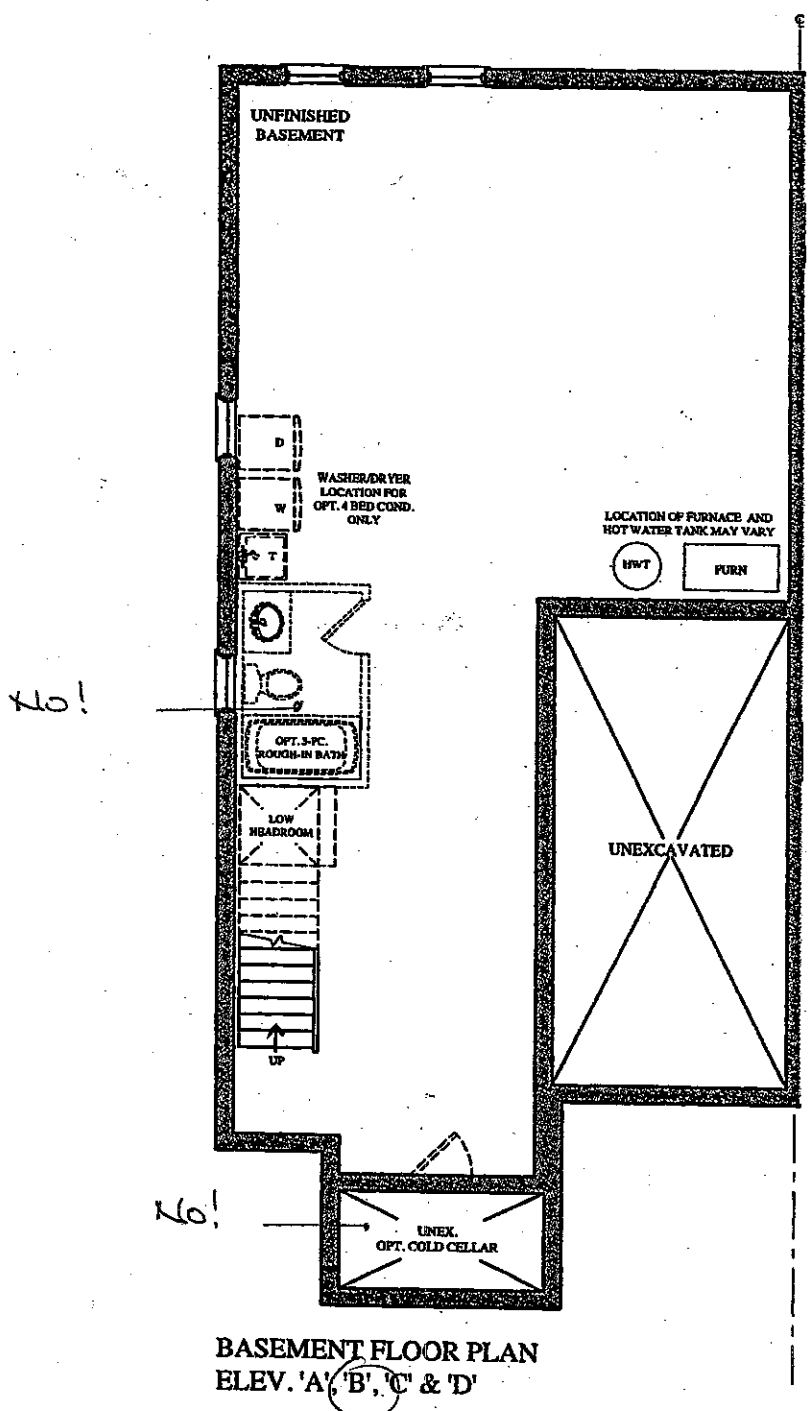

Prices, figures, illustrations, sizes, features and finishes are subject to change without notice. Areas and dimensions are approximate and actual usable floor space may vary from the stated area. Layout may be reverse of the unit purchased. E. & O.E.

**GOLDPARK**  
WORTH MORE™